






X KEY
Front Elevation NTS

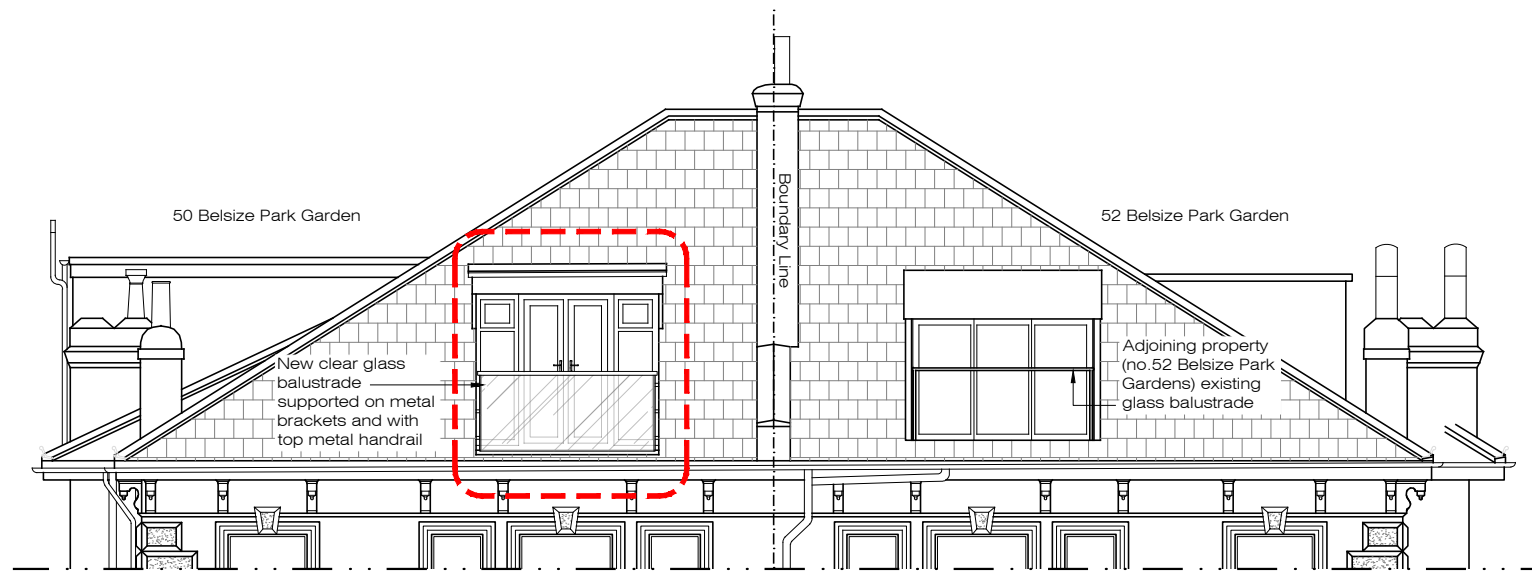


X PROPOSED
Front Elevation 1:100@A3

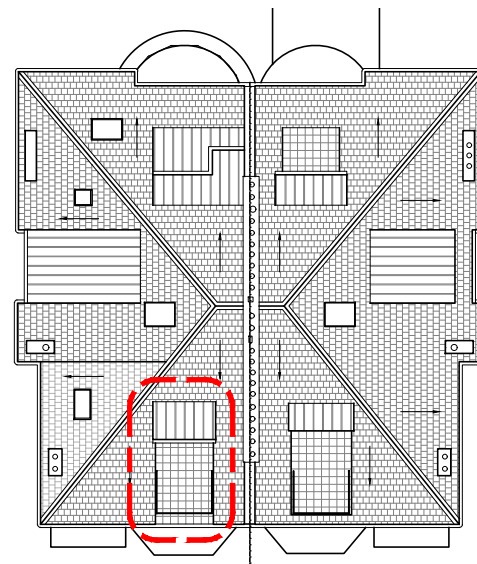

X KEY
Roof Plan NTS

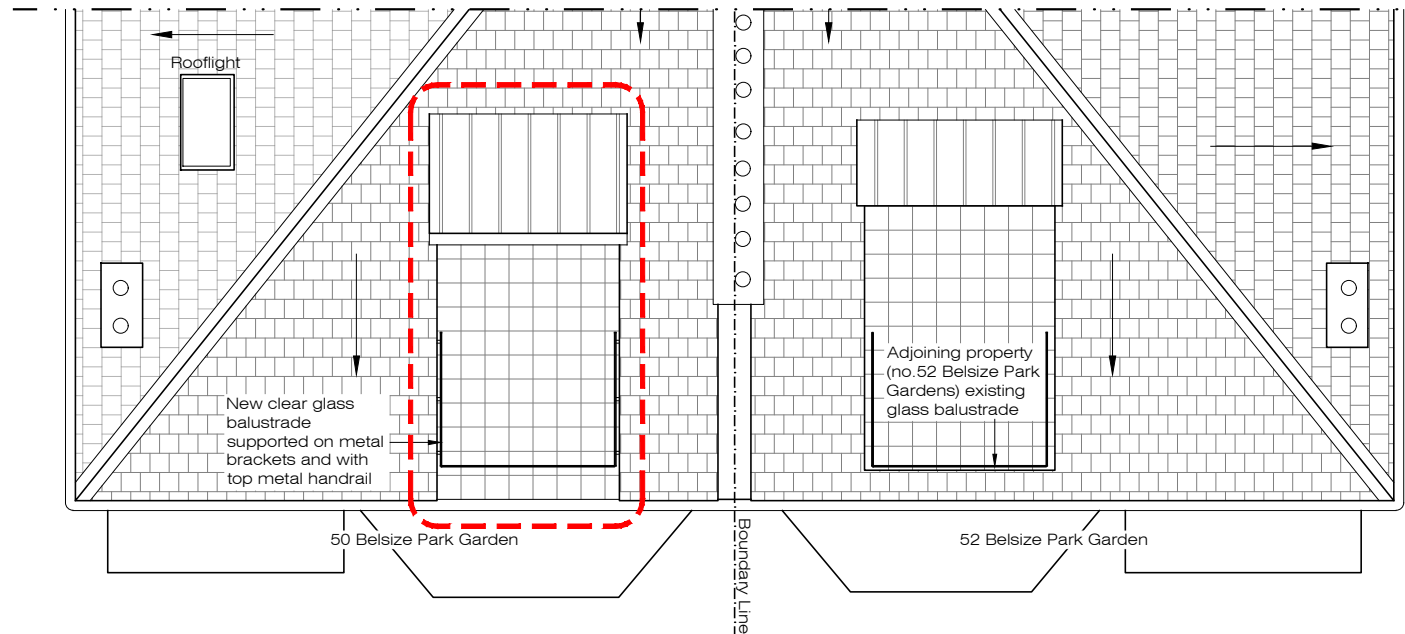

X PROPOSED
Roof Plan 1:100@A3

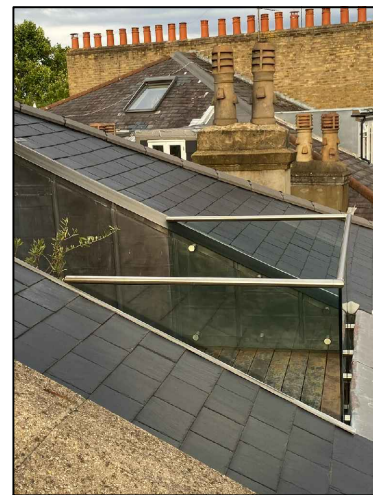

Pictures of other properties with similar balustrades on Belsize Park Gardens



Ground Floor Office
33 Belsize Lane
London NW3 5AS
Office: +44 (0) 207 431 9014
info@xularchitecture.co.uk
www.xularchitecture.co.uk

PLEASE NOTE:

- All dimensions to be checked on site before fabrication.
- Contractor to refer to engineers drawings before proceeding with works.
- All drawings and designs are covered by design right (intellectual property), and may not be distributed, copied or issued without written permission by the Architect.
- All design concepts are the sole property of the Architect and no adaptations, reproductions or copies may be made without written permission of the Architect.
- These drawings are subject to any variation required or recommendation by any statutory authority, or for the better carrying out of the works.
- Samples to be provided by contractor for XUL Architecture's approval.
- All finishes to XUL Architecture's satisfaction.
- All drawings to be approved by XUL Architecture prior to construction.

ADDITIONAL NOTE:

Issue key:	Project Address	Issue For:
Information (I)	50 Belsize Park Gardens, NW3 4ND	PLANNING
Planning (P)	Scale 1:100@A3	PROPOSED
Tender (T)	Rev. Date 28.07.20	Roof Plan & Front Elevation
Construction (C)	Drawn TP	Dwg. No. PA-01 Rev. P-00
As Built (B)	Checked SS	Project Number 19175