


2 LEVEL 10 - CANOPY AXONOMETRIC

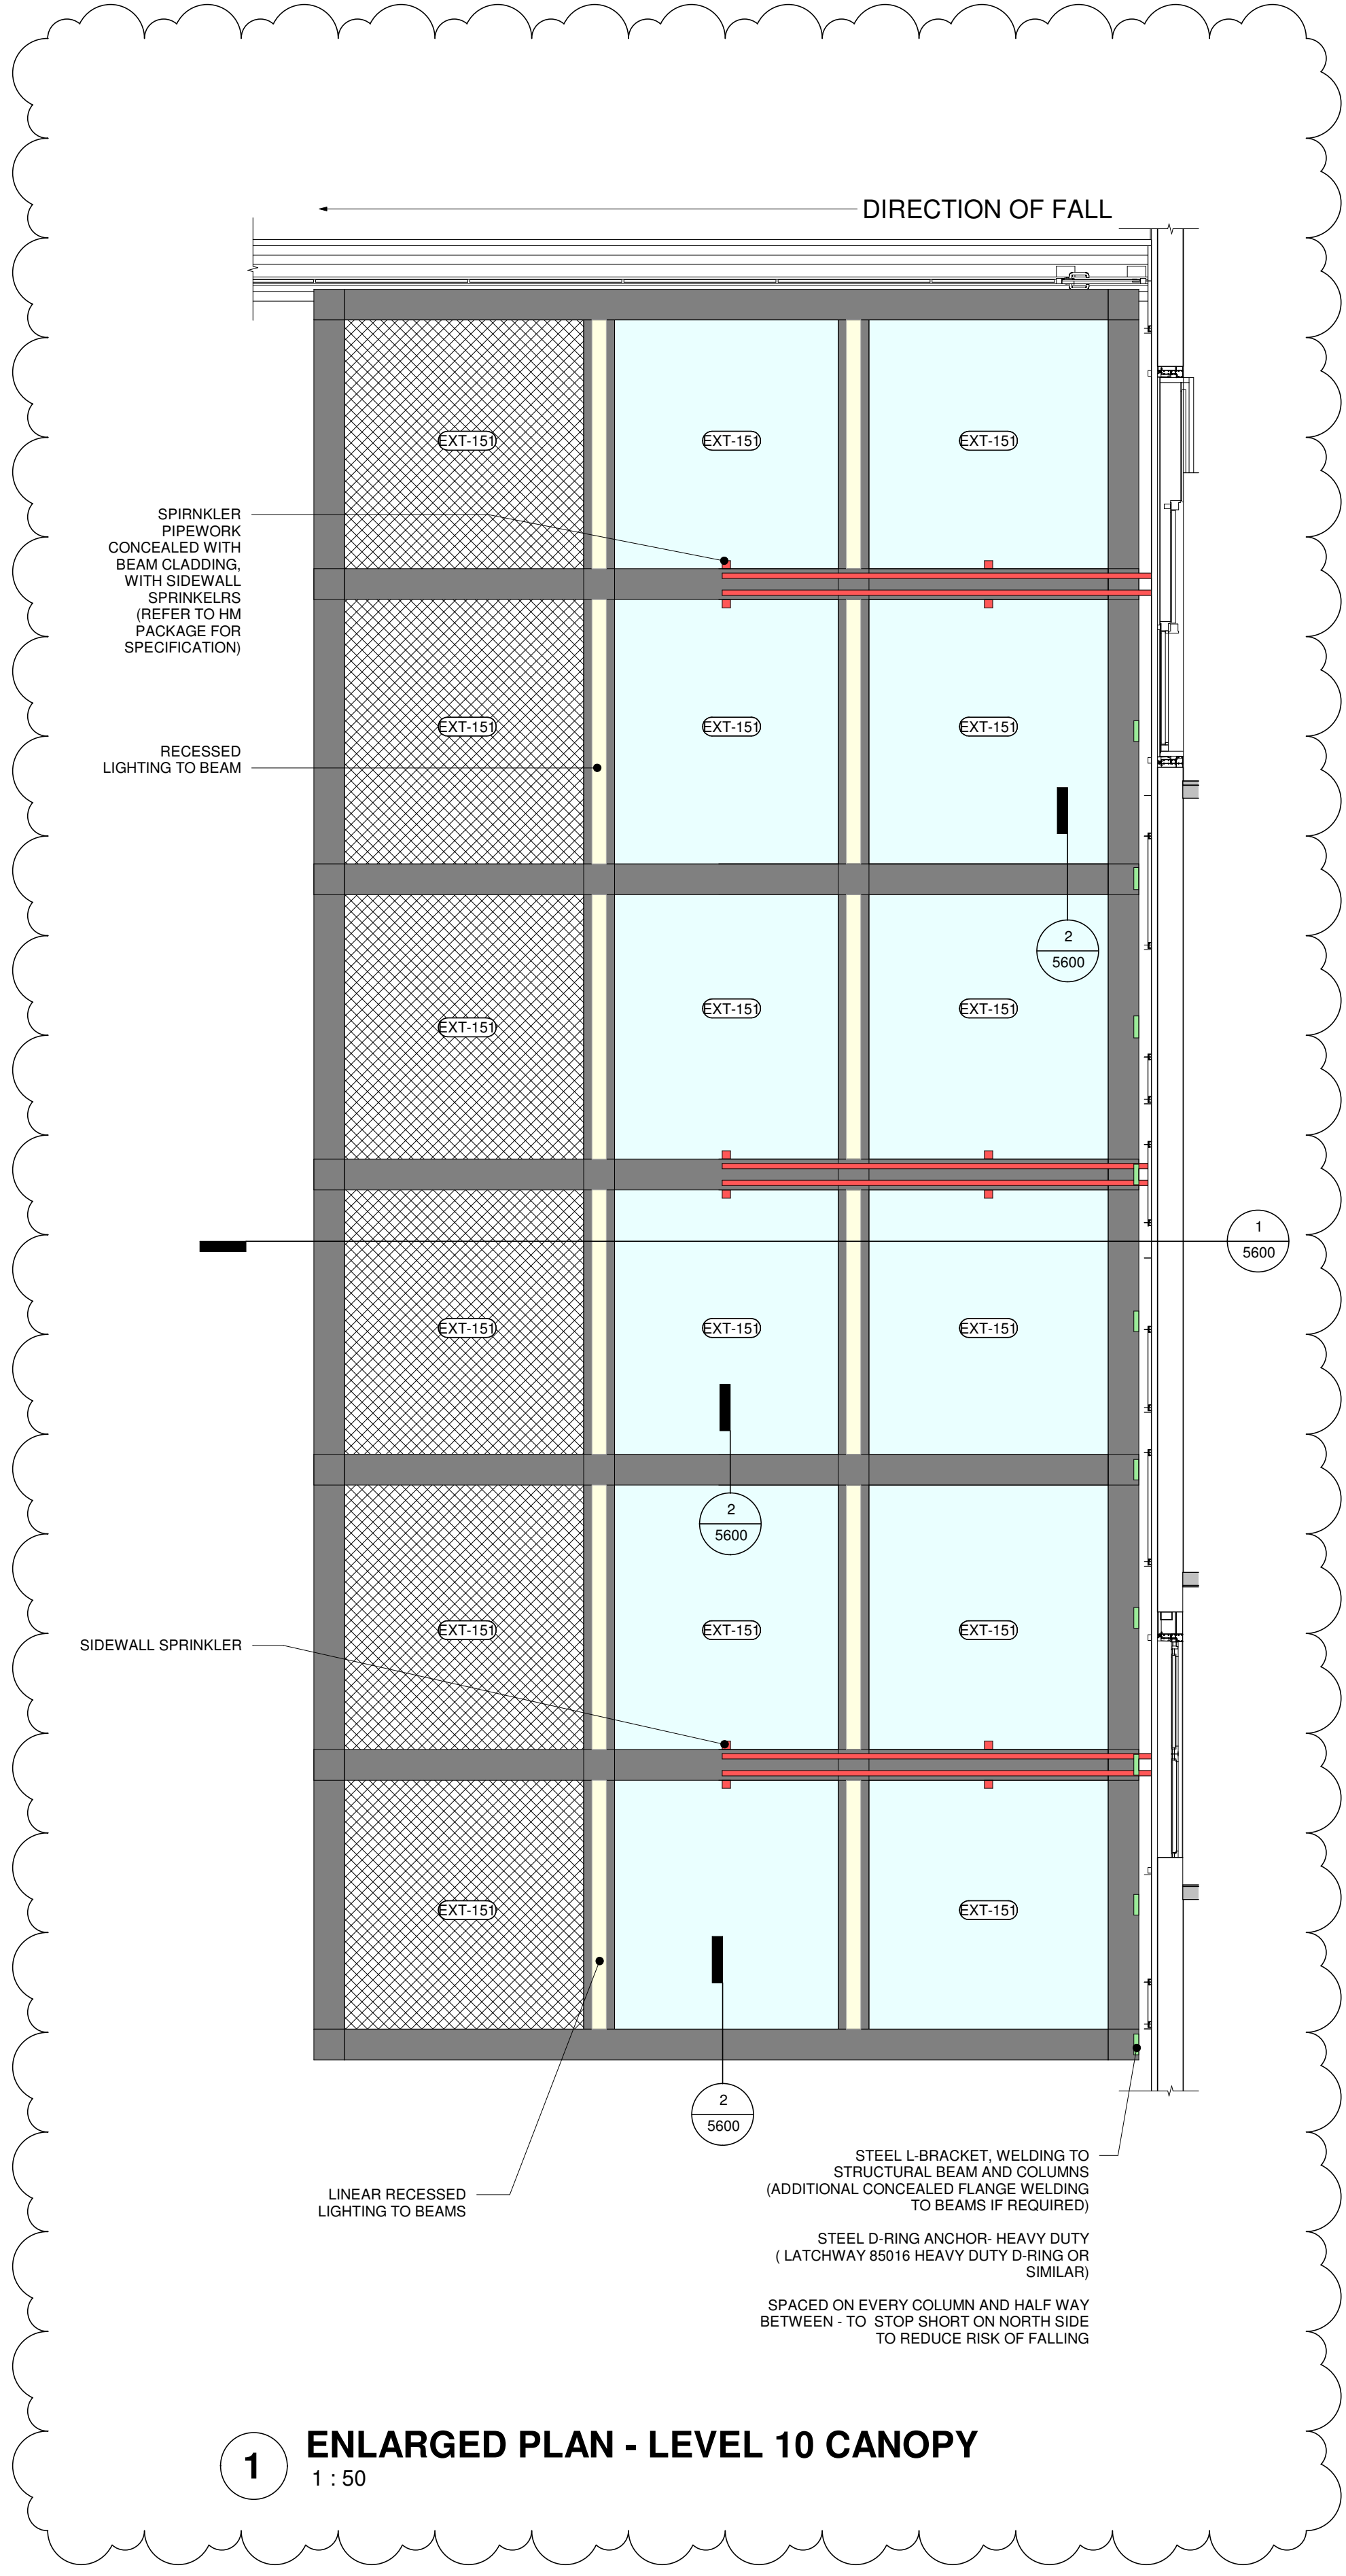

1 ENLARGED PLAN - LEVEL 10 CANOPY
1 : 50

Drawing Status	
Information	
Approval	
Tender	
Contract	
Record Drawing	
Key Diagram	
Notes	
GENERAL NOTES	
• FOR COMPLETE DESIGN INFORMATION, INCLUDING DETAILS AND SPECIFICATIONS FOR THE CANOPY, PLEASE REFER TO THE RAMBOLL STAGE 3 TENANT FITOUT GUIDE FOR NIKE	
T3	10.07.20 STAGE 4 INTERM SUBMISSION SB NK
T2	01.05.20 STAGE 3 TENDER SUBMISSION SB NK
T1	24.04.20 STAGE 3 DRAFT TENDER SUBMISSION SB NK
Rev	Date Description By Chk
bdg	
Client: NIKE WORKPLACE DESIGN & CONNECTIVITY	
Project: NIKE - LONDON HQ KINGS CROSS S1 HANDYSIDE STREET	
Title: LEVEL 10 - CANOPY	
Scale: 1 : 50 @A1	Date: 04/23/20
Drawn By: SB	Checked By: MJ
Drawing No: 0676_BDG_XX_110_DR_A_3033 Revision:	
East Studio Riverside Walk, Sea Containers, 18 Upper ground, London SE1 9PD Tel 020 7559 7400 E: info@bdg-a-d.com W: www.bdg-a-d.com	
NOTE: Dimensions are not to be scaled from this drawing except for planning application purposes only. Contractors must verify all dimensions before commencing. Construction coordination is the responsibility of the principle contractor. Any variations or discrepancies to be reported to BDG architecture+design. Manufacturing drawings are to be provided for approval by BDG architecture+design for all bespoke items. This drawing is the property of BDG architecture+design and terms & conditions apply. Full terms & conditions are available on request.	