


1 Window Type 1
New Window in existing opening


Double glazed painted timber sash window.
 New window in existing opening. Existing opening dimensions to be confirmed on site.
 NBS L10/250
Min U-Value: 1.5W/m2K

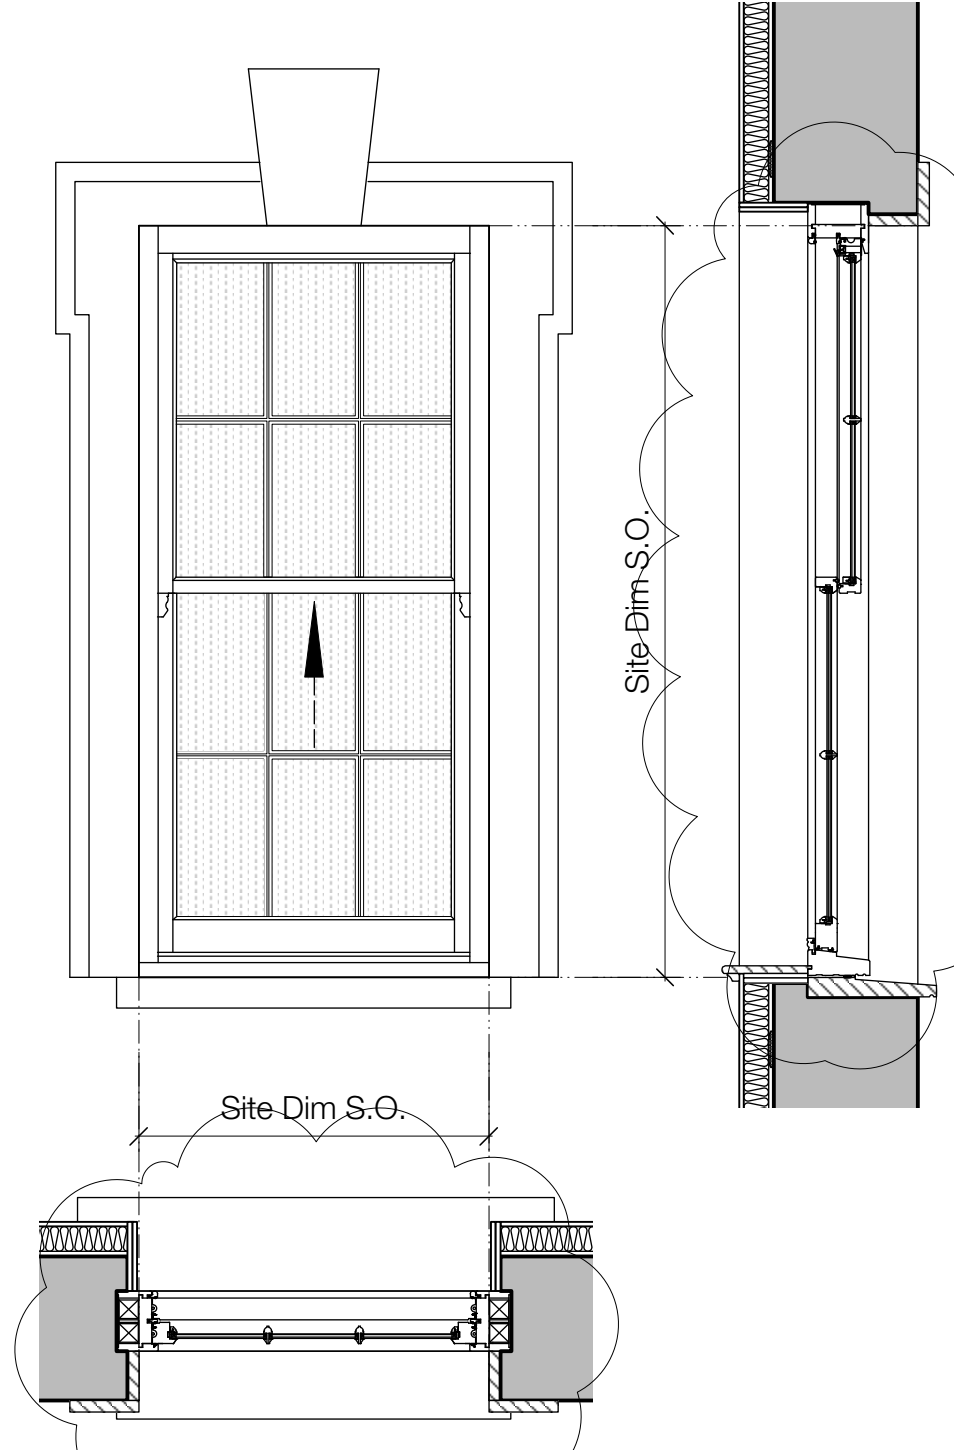

Window type applicable to: **W1-01, W1-02**

2 Window Type 2
New Window in existing opening


Double glazed painted timber sash window.
 New window in existing opening. Existing opening dimensions to be confirmed on site.
 NBS L10/250
Min U-Value: 1.5W/m2K

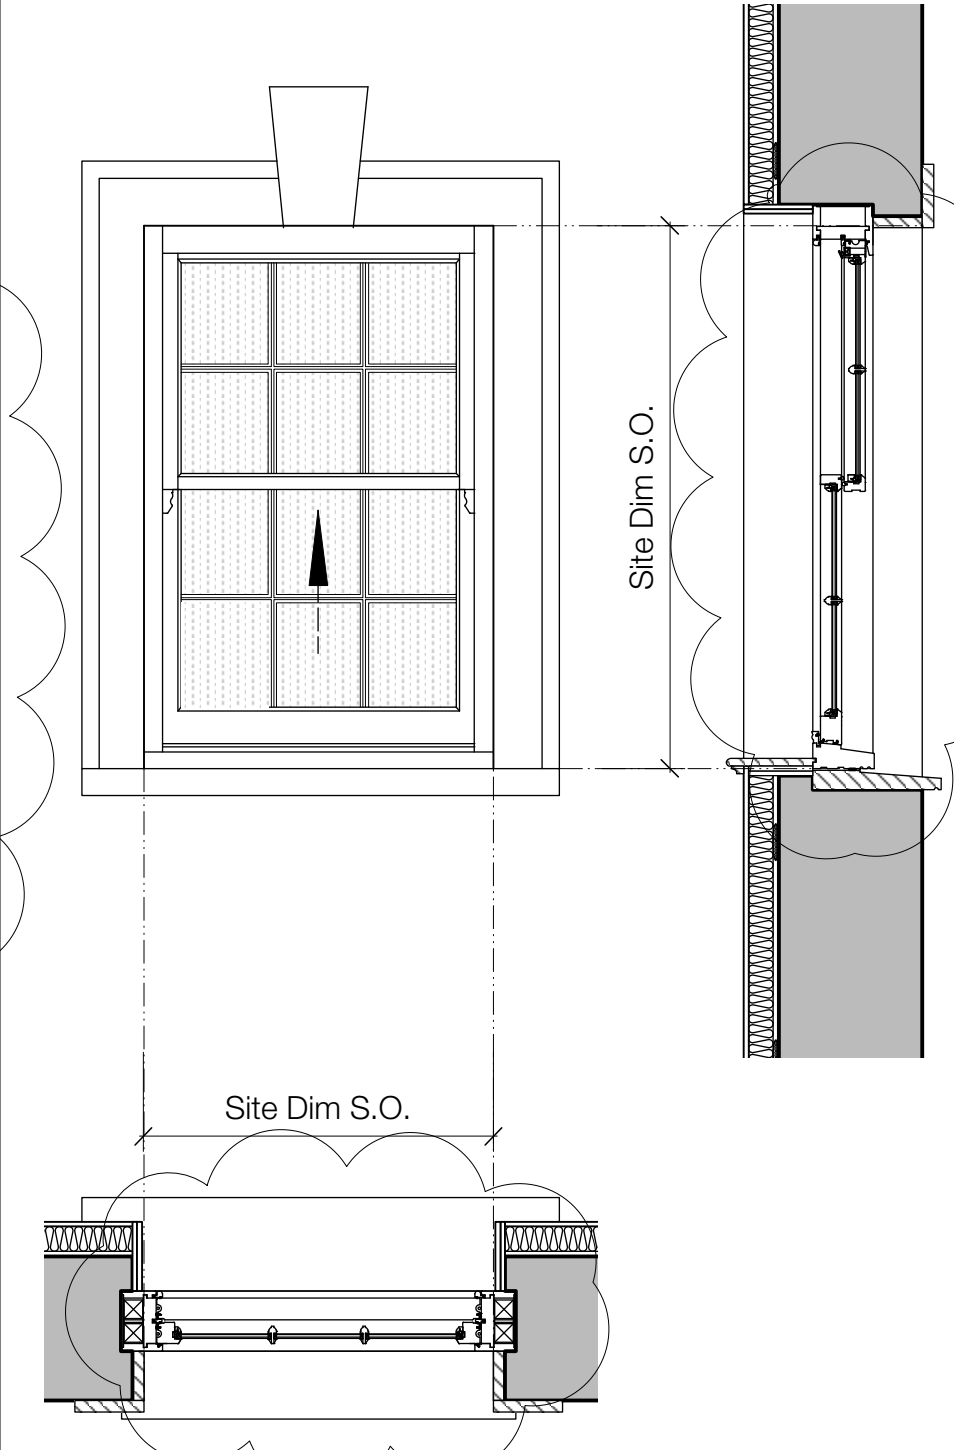

Window type applicable to: **W2-01, W2-02**

3 Window Type 3
New Window in existing opening

Double glazed painted timber sash window.
 New window in existing opening. Existing opening dimensions to be confirmed on site.
 NBS L10/250
Min U-Value: 1.5W/m2K

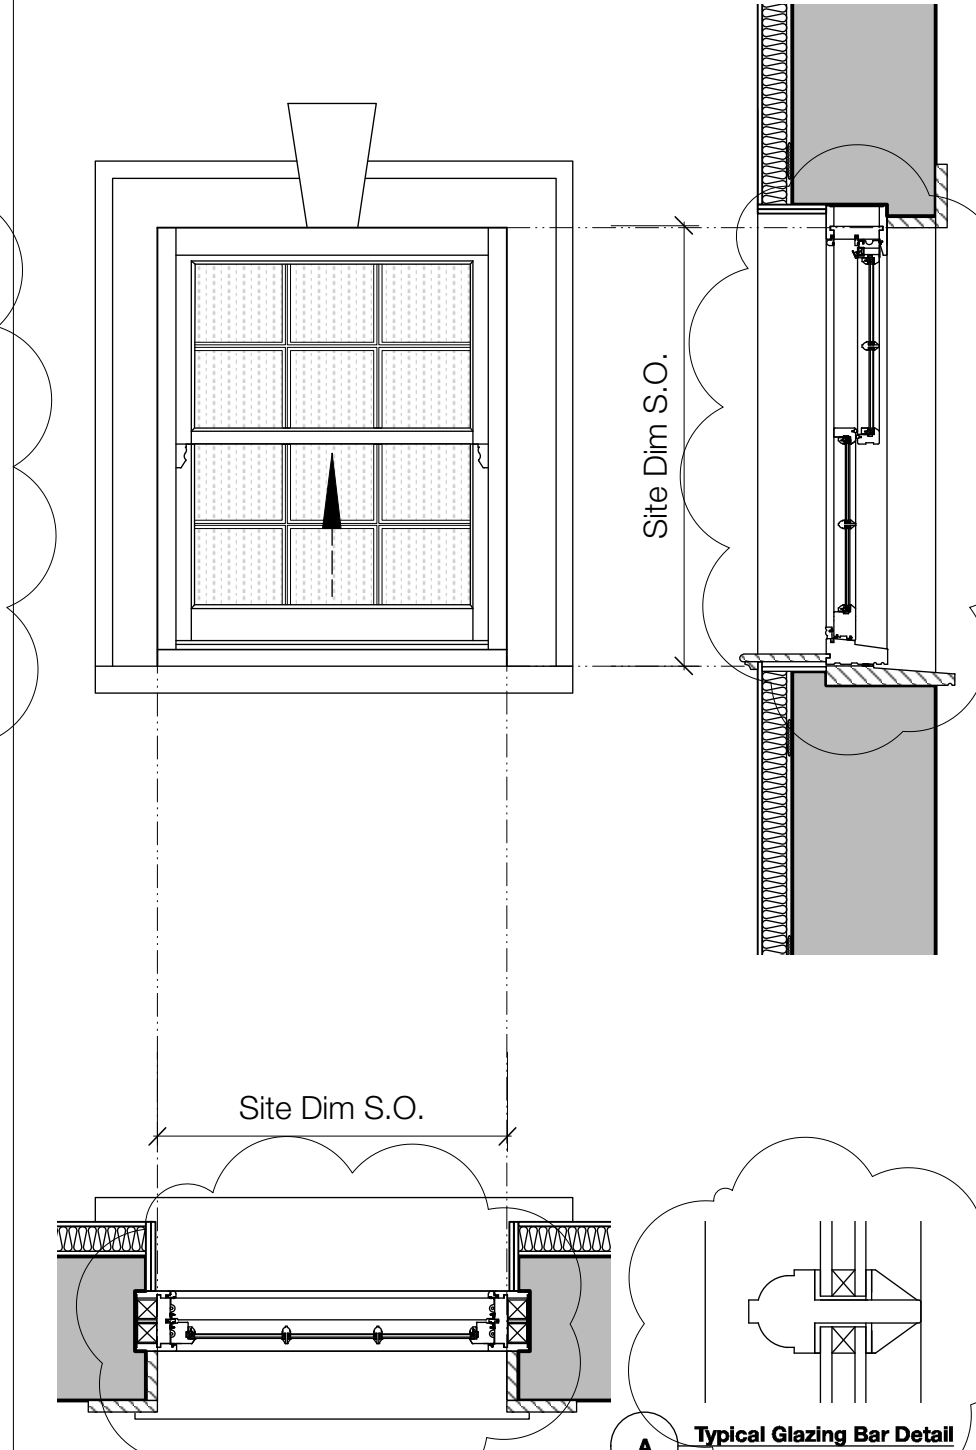

Window type applicable to: **W3-01, W3-02**

- GENERAL NOTES**
- This drawing is the copyright of Haines Phillips Architects.
 - Do not scale from this drawing. Use figured dimensions only.
 - This drawing must not be used for land transfer purposes, or for construction purposes unless accompanied by an Architect's Instruction.

DRAWING ISSUE STATUS

ISSUE	STATUS	COMMENT
P	PRELIMINARY	For comment and review
PL	PLANNING	Planning/Listed Building Application
BR	BUILDING REGS	Building Regs Application
T	TENDER	For pricing purposes only
C	CONSTRUCTION	For procurement & construction
FC	FINAL CONSTRUCTION	Record drawings on completion
L	LEGAL	Conveyancing or other legal purposes

REVISIONS

REV	DATE	NOTES
C1	19/07/19	Construction issue
C2	04/12/19	Sash window glazing bar details revised

HAINES PHILLIPS ARCHITECTS

Tankerton Works
 12 Argyle Walk
 London WC1H 8HA
 020 7833 9324
 020 7837 2864
 office@hainesphillips.co.uk

JOB TITLE
 9 Goodge Street,
 London W1T 2PE
DRAWING TITLE
 Window Types - Sheet 1

DRAWN **DATE** **SCALE**
 CB Feb 2018 1:20@A3
JOB NR **DRAWING - ISSUE - REVISION**
 3931 DA411-C-2