



REVISIONS		
Rev.	Date	By

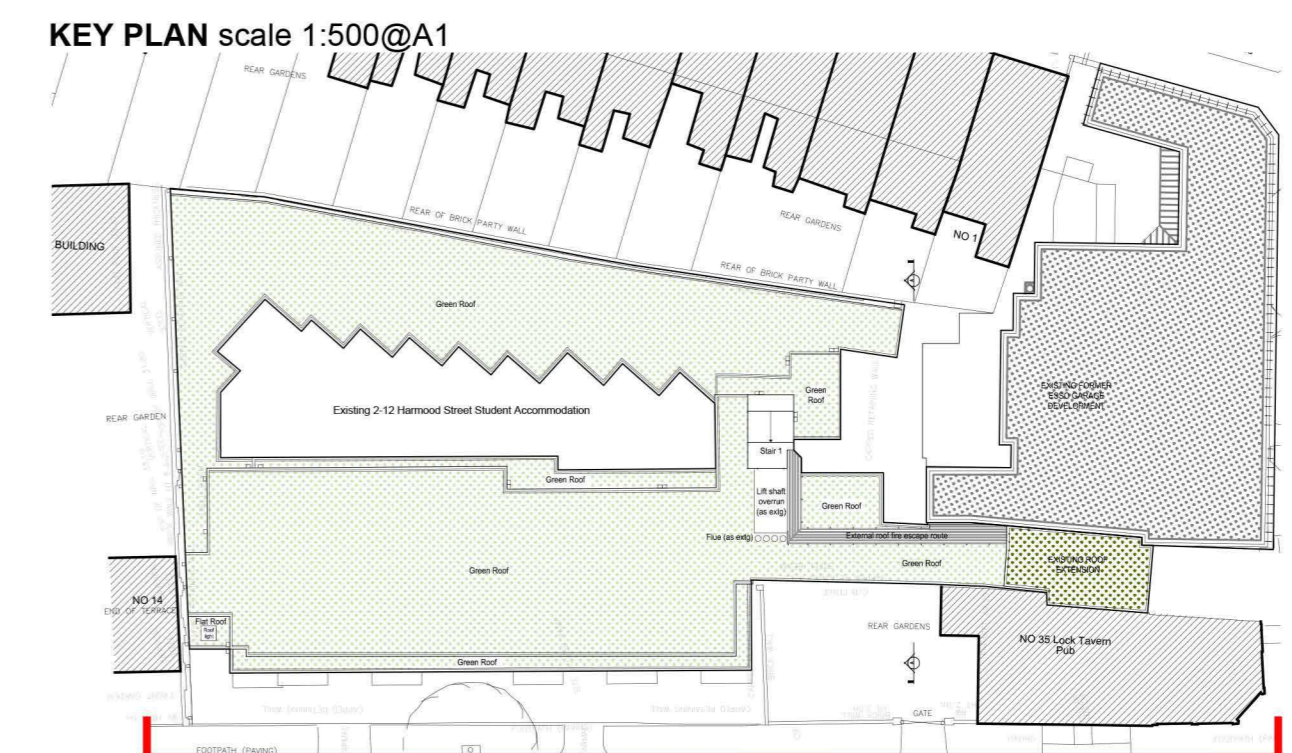

Harmond Street Elevation as built

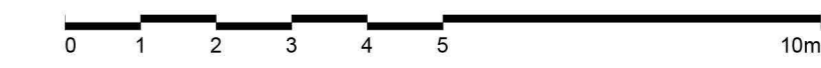

PLANNING APPLICATION

ALL DIMENSIONS TO BE CHECKED ON SITE
WORK TO FIGURED DIMENSIONS ONLY
REPORT DISCREPANCIES TO THE ARCHITECT
AT ONCE BEFORE PROCEEDING

Contemporary Design Solutions

46 Great Marlborough Street
London
W1F 7JW
Telephone: 020 7494 0000 Fax: 020 7494 4944

Client
HALLMARK PROPERTY GROUP

Project Title
2x studio units
at 4th Floor of Stay Club Camden
34 Chalk Farm Road
London NW1 8AJ

Drawing Title
Harmond Street Elevation as built

Scale: 1:100@A1 Date: September 2020
Drawn: MR Checked: CT
Drawing No.: 2002920A(GA)411 Rev.:

PLOT DATE - 9/14/2020 10:44 AM