


Chalk Farm Rd Street Elevation as built



PLANNING APPLICATION

ALL DIMENSIONS TO BE CHECKED ON SITE WORK TO FIGURED DIMENSIONS ONLY REPORT DISCREPANCIES TO THE ARCHITECT AT ONCE BEFORE PROCEEDING

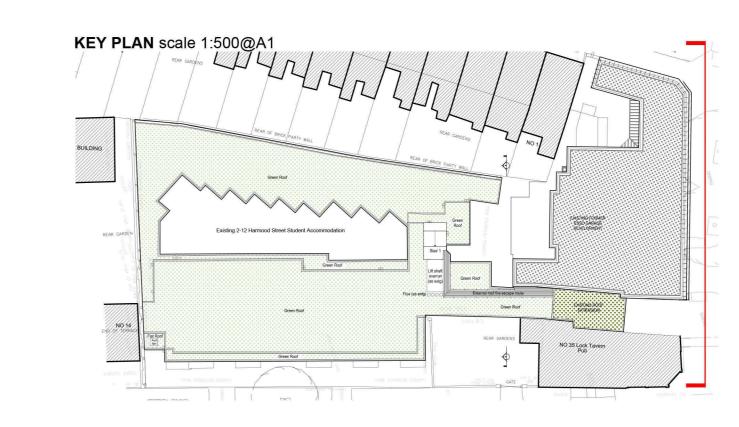

London W1F 7JW

HALLMARK PROPERT GROUP

at 4th Floor of Stay Club London

34 Chalk Farm Road LONDON NW1 8AJ

Drawing Title

As Built Chalk Farm Road Elevation

Date September 2020 Checked 200920-A(SO)401

CAD plot date: 14 September 2020 10:50:56