





FRONT ELEVATION 1:100

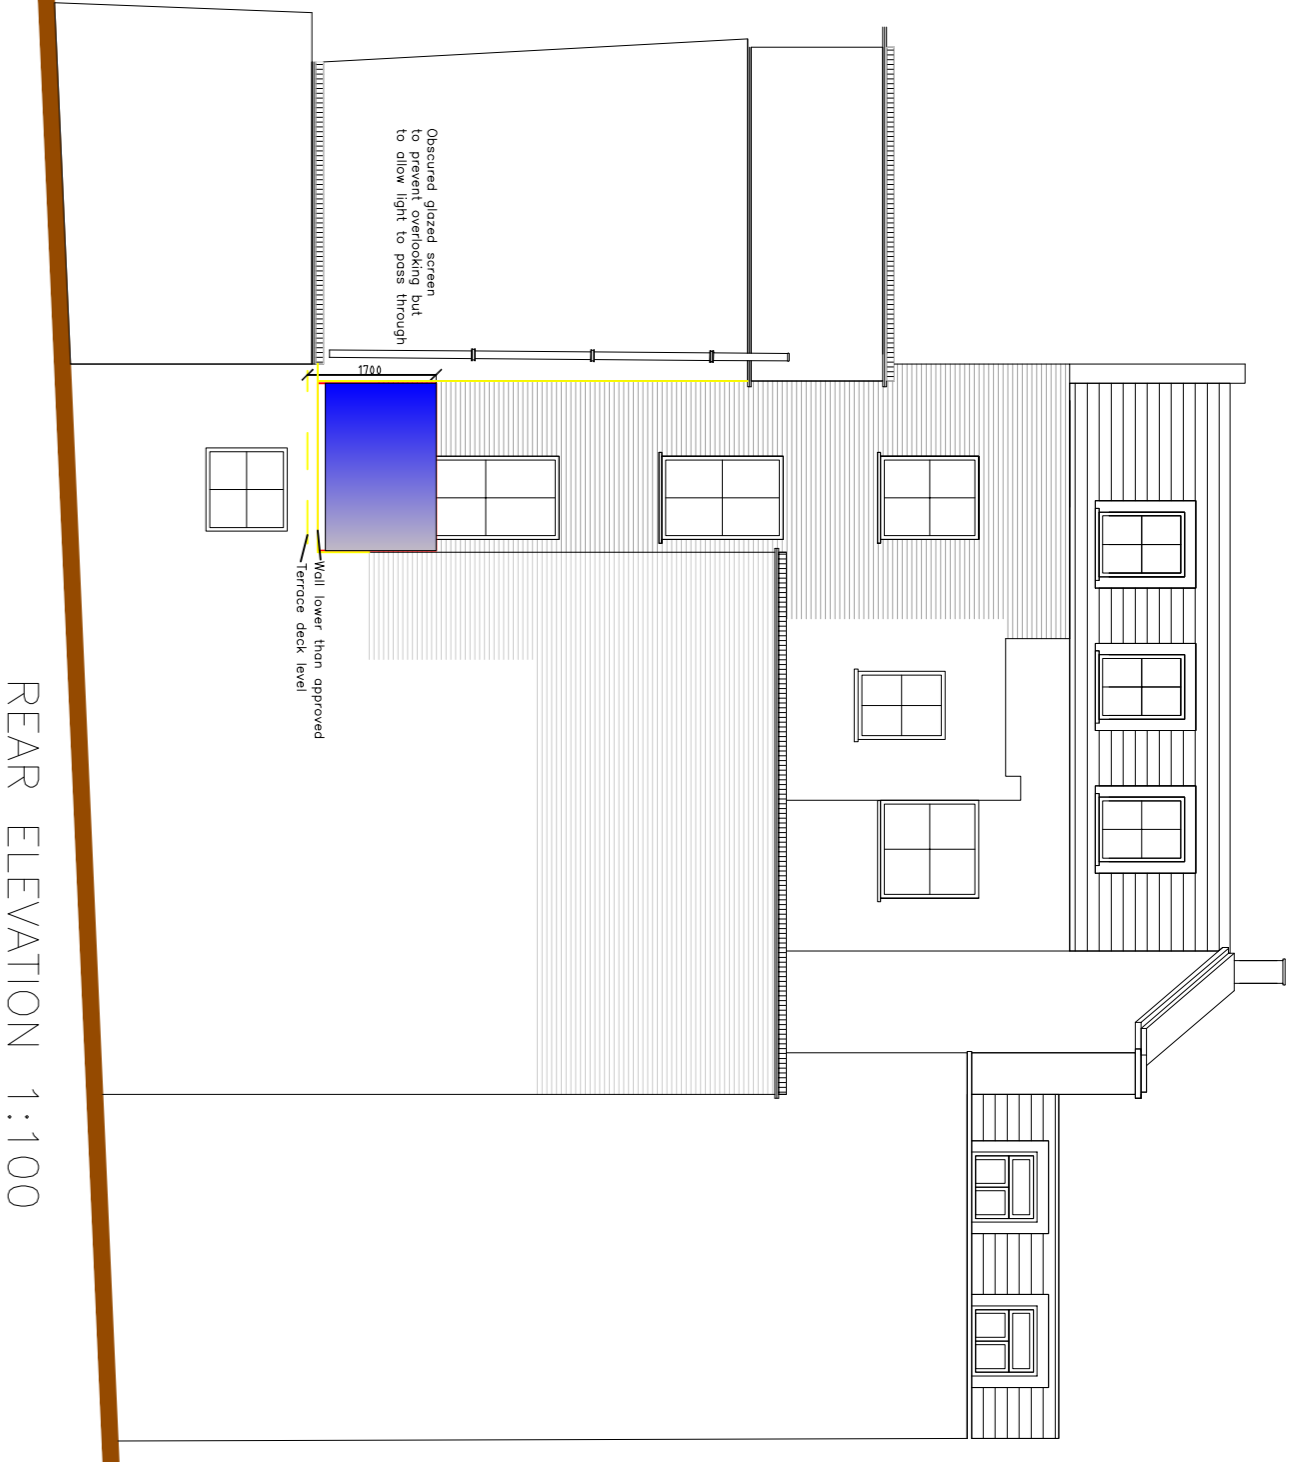


REAR ELEVATION 1:100




SECTION / SIDE ELEVATION 1:100

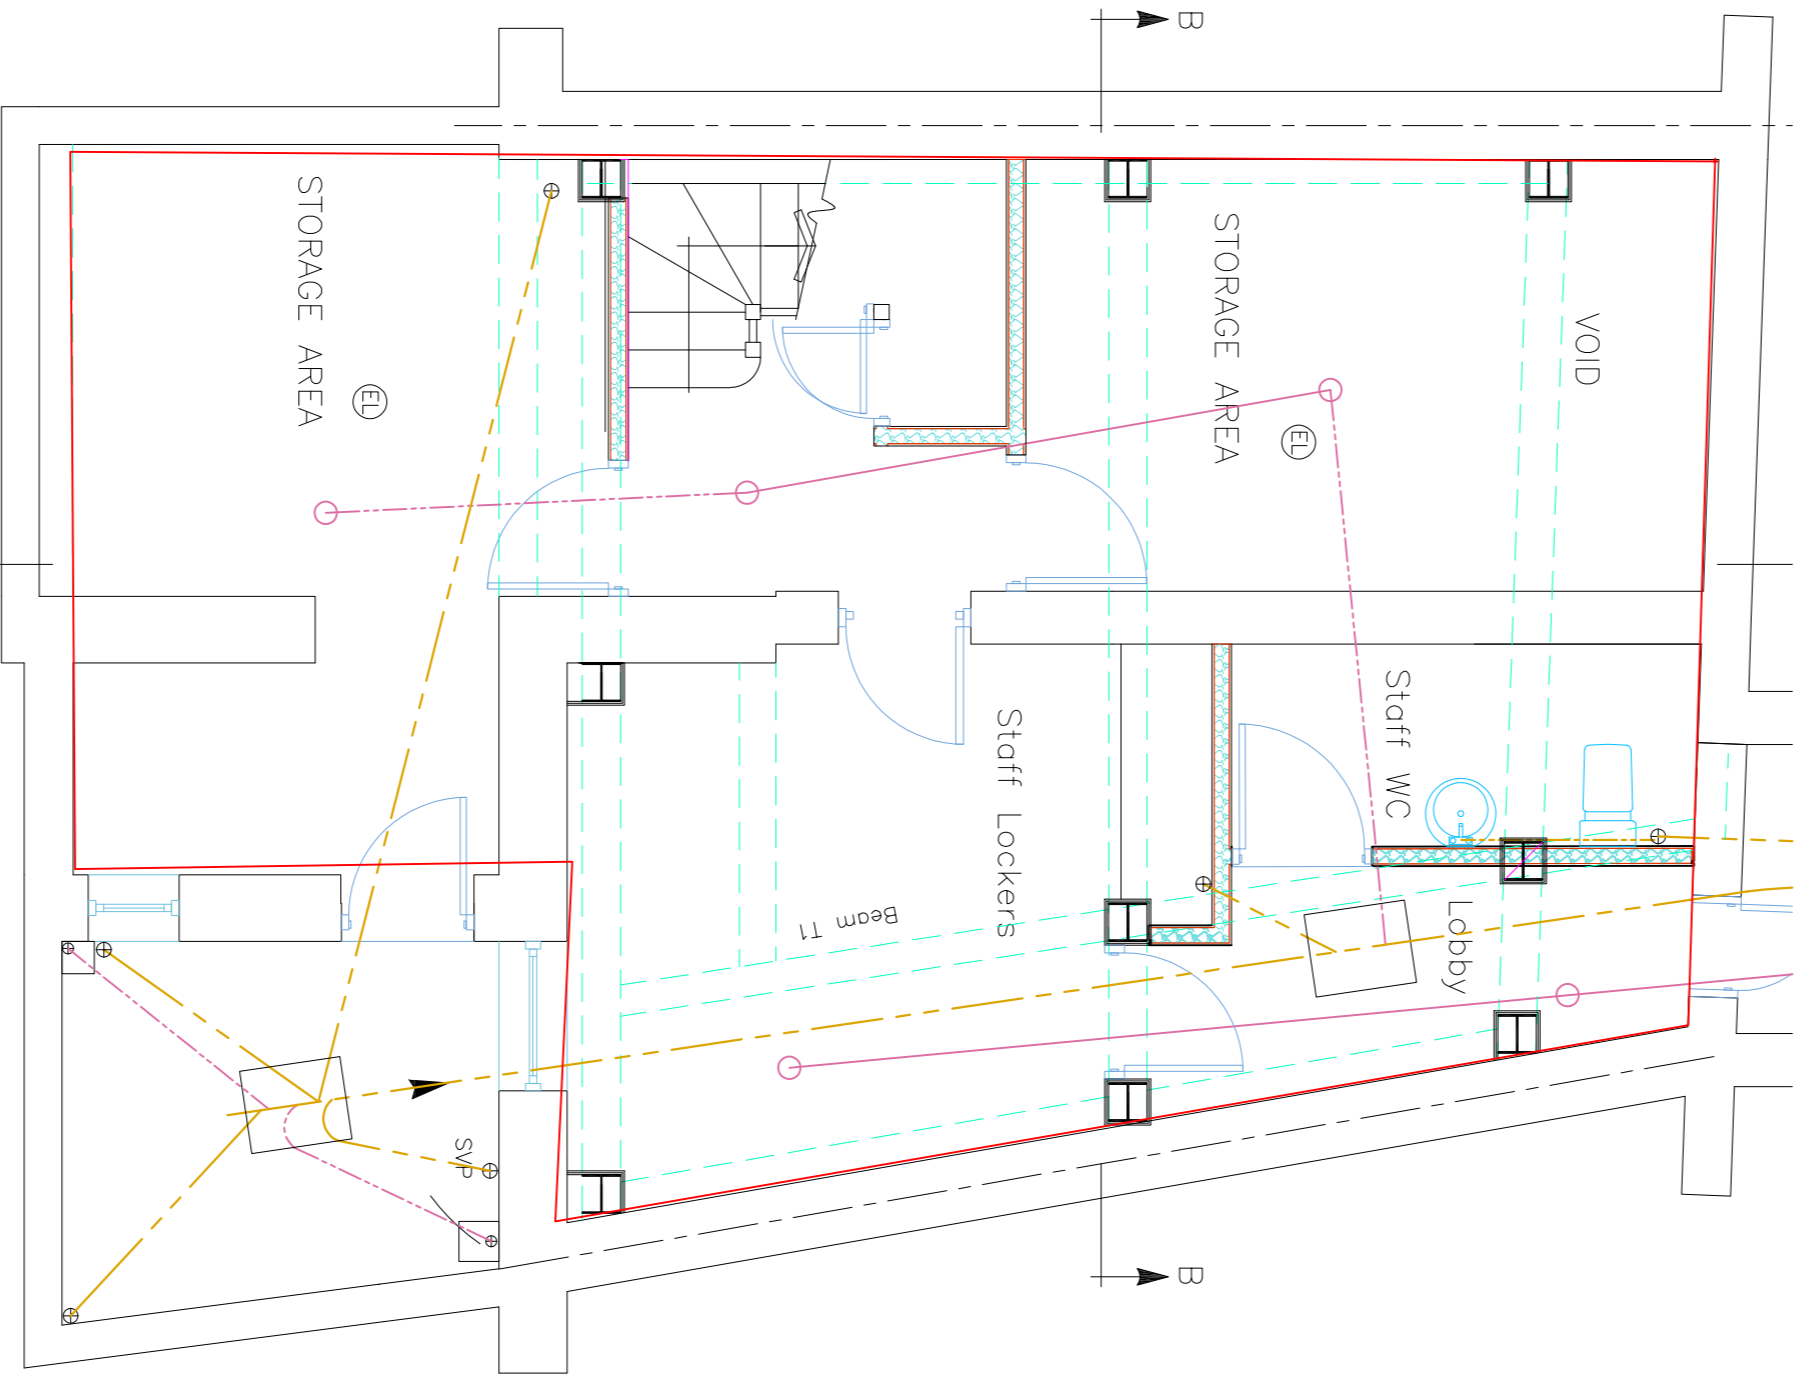

BASEMENT PLAN 1:50

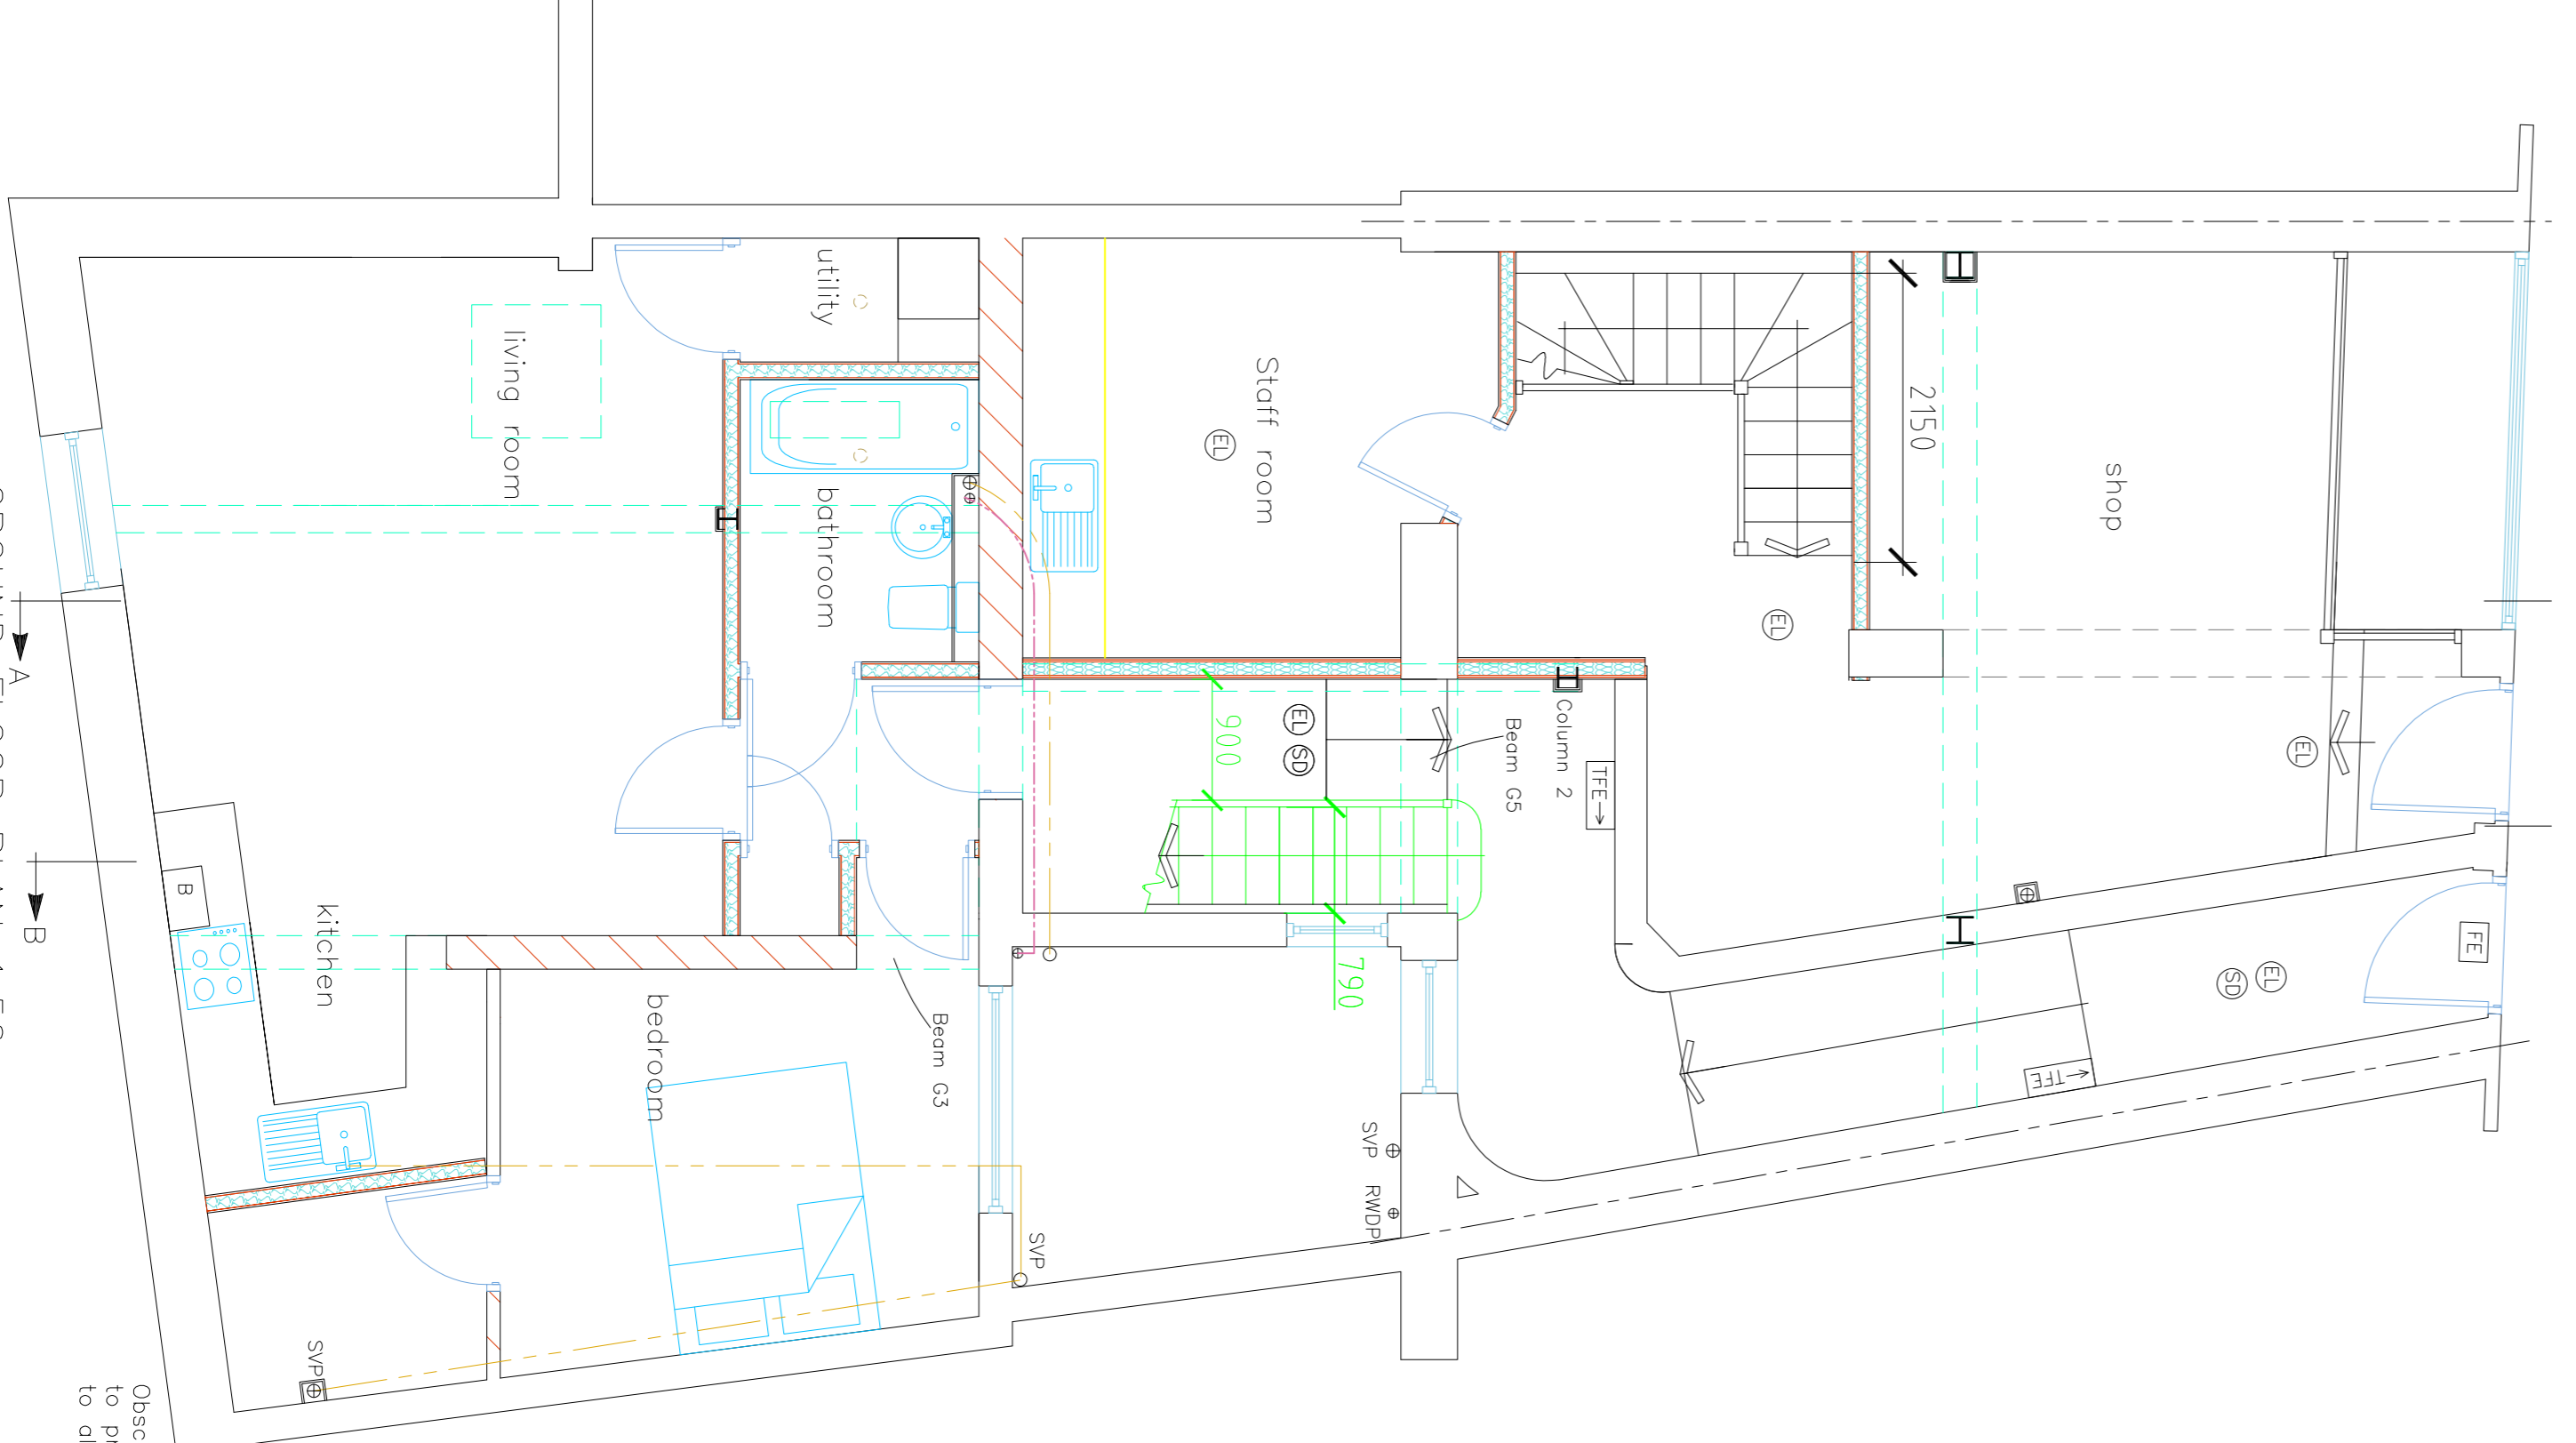

GROUND FLOOR PLAN 1:50

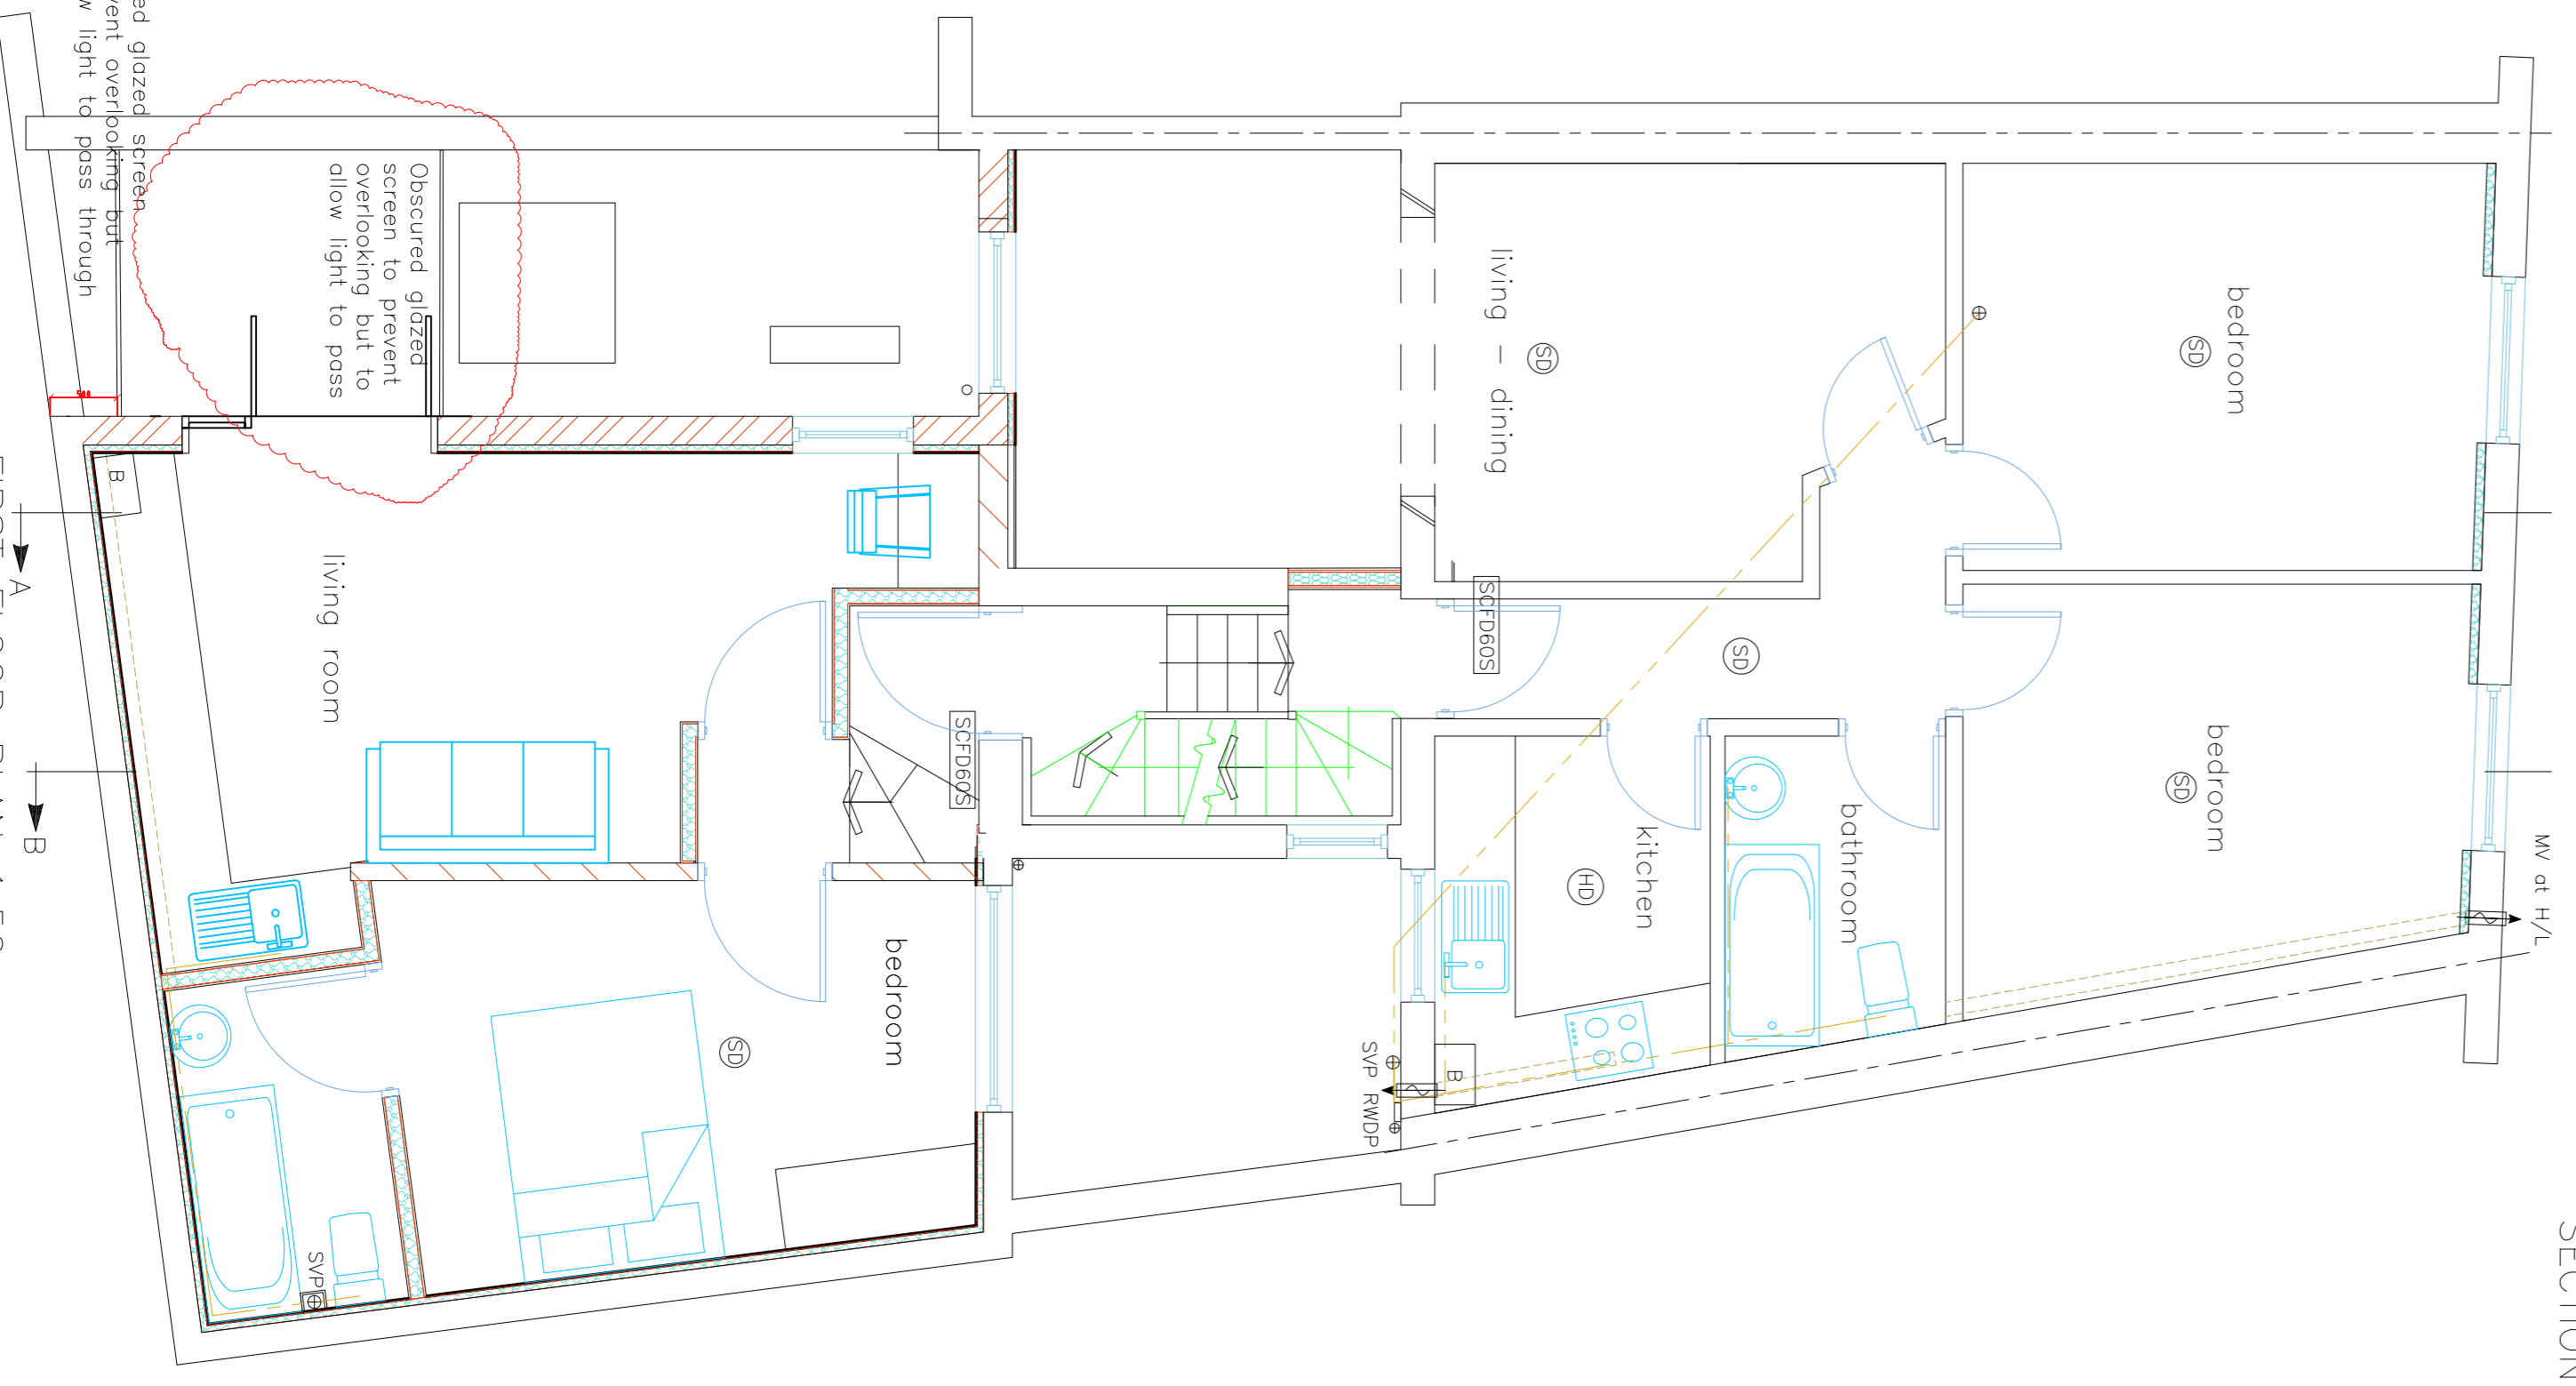

FIRST FLOOR PLAN 1:50

Notes: All doors must be opened on site and not locked from this drawing.

© Copyright

E	24.8.20	Balcony Rev	CEC
D	17.7.20	Balcony Rev	CEC
C	5.9.20	Balcony Rev	ALC
B	5.9.20	Balcony Rev	ALC

Simon Hands and Associates
Chartered Surveyors & Architects
12 Redlip Road
Middlesbrough
TS6 9DN
Tel: 020 8575 5959
Fax: 020 8575 8866
email: enquiries@simonhands.co.uk

Client: **Fabrizio Indalcato**
Job Title: **Proposed Works at 129 Kings Cross Road London WC1X 9BJ**

Drawing Title: **AS CONSTRUCTED PLANS & ELEVATIONS**

Scale: 1:50 1:100	Sheet Size: A1
Date: 25/10/19	Drawn By: CEC
Job No: 2019161	Rev: E