

Rev N°	Description	Drawn by	Date
A	Bar & Back of House amendments	RW	26/06/14
B	Revisions following site survey	RW	15/07/14
C	New dishwasher layout 600mm fridge 1000mm pastry	CS	29/07/14
D	Furniture added for A.Stanley Joiners	CS	01/08/14
E	Furniture legend added	CS	11/08/14

**Notes**

This drawing represents a performance guide upon which the contractor/subcontractor must base his/her working drawings & details. Include all necessary tolerances prior to manufacture and installation

Contractor to must undertake a full survey of the area to establish all dimensions & ensure accurate setting out.

Advise on suitability of all details shown to ensure structural stability, ease and economy of construction

Refer to digital master artwork in regard to all graphic work shown

**AS BUILT**

**bedrock**  
 Bedrock Design Consultants Ltd  
 2nd Floor, 39 Gold Street, Northampton,  
 NN1 1RA  
 T 01604 250002  
 F 01604 250003  
 info@bedrockdesign.co.uk

Client  
**Caffe Nero**


Project  
**Holborn**

Description  
**External Seating**

Scale      Drawn by      Date  
 1:75@A3      CA      23/03/17

Drawing N°      Revision  
 CN640 - 100      E

This drawing is the copyright of Bedrock Design Consultants Ltd. This drawing cannot be copied, reproduced, retained or disclosed to any unauthorised person without prior permission in writing from the designer.

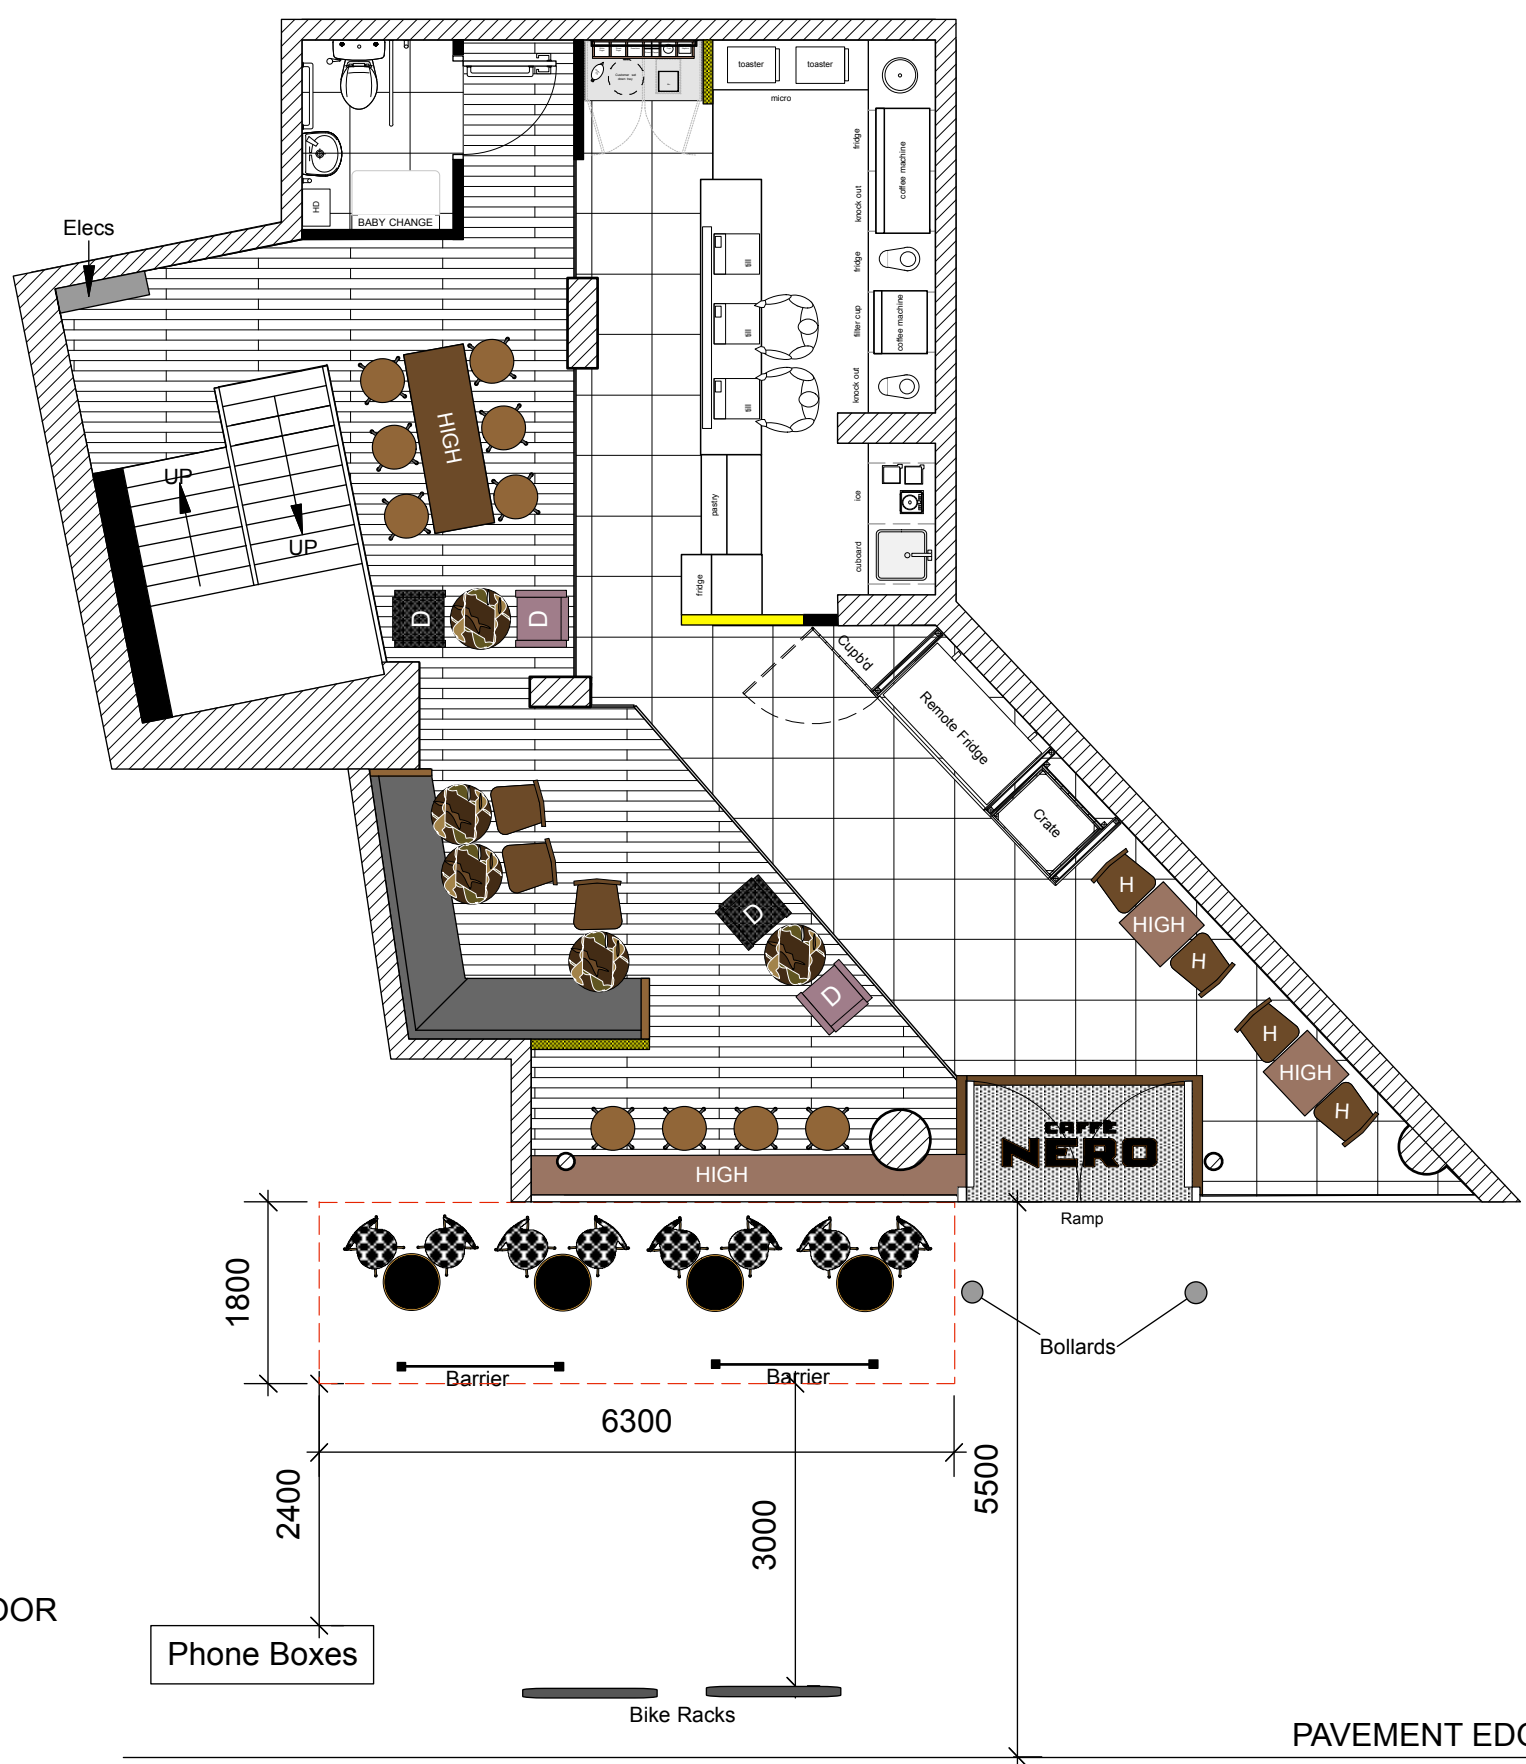

**GROUND FLOOR**  
 24 Seats

Phone Boxes

Bike Racks

PAVEMENT EDGE