

Notes

- 1. Smoke Outlet From Basement.
- 2. Sign.
- 3. Bollard.
- 4. Bike Stand.
- 5. Lamp Post.

Furniture legend

 **Pret outdoor seating: 8no.**
External aluminium frame
(black) and teak slatted chair

 **square tables: 2no.**
External 500x500mm black
Trespa 12mm thick table top
with aluminium base



**note: external furniture to be
brought into store outside of
trading hours**



exterior chairs and tables:



seating barriers:

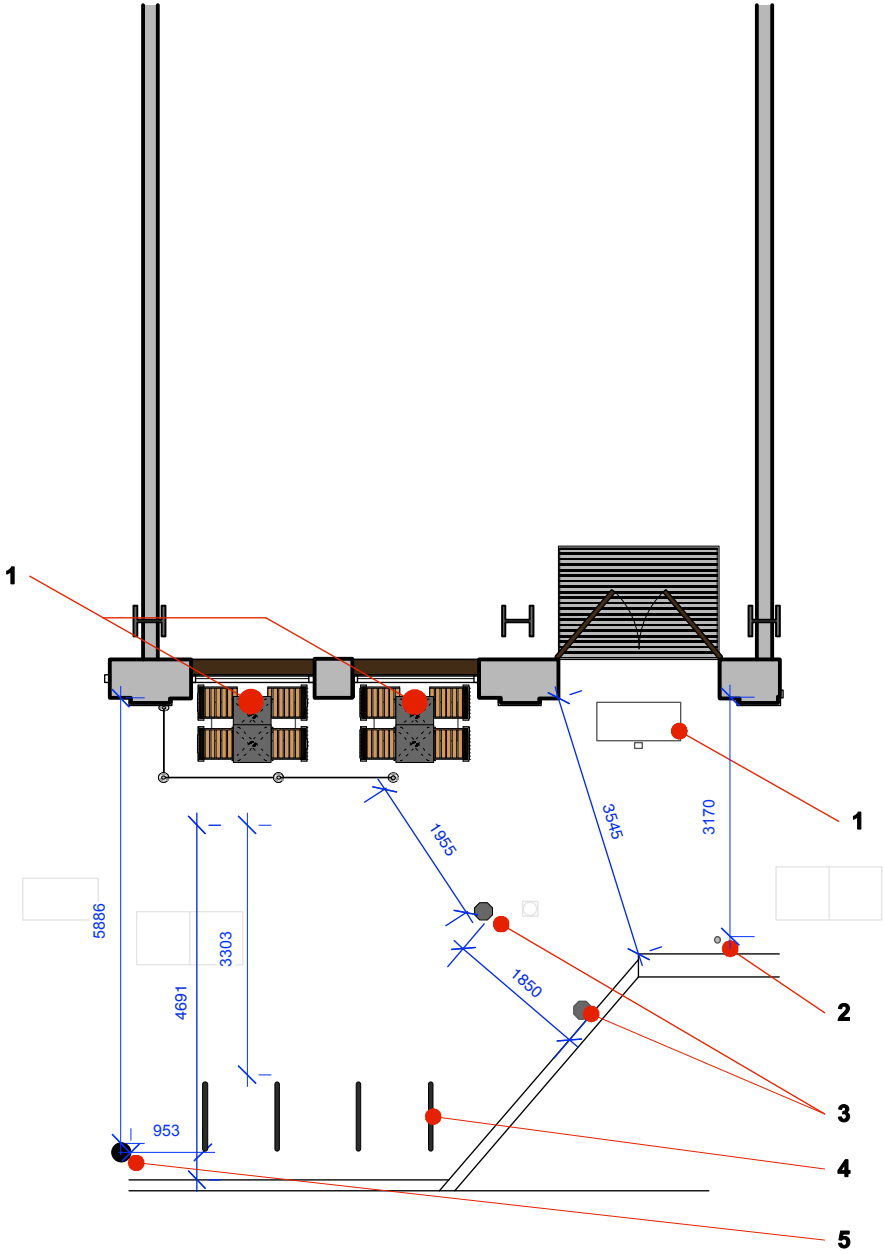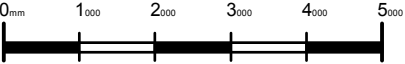

As Built

★ PRET A MANGER ★

1 Hudson Place, London, SW1V 1PZ

Site :
125 High Holborn

Page Title:
External furniture layout

Revision Note:
A: More Dimension added

Drawing No. HHB-Pret-01

Revised Date: 07.02.15 Revised No. A

Drawn Date: 19.12.14 Drawn By: FS

Scale: 1:100 @ A3

THIS DRAWING IS NOT TO BE SCALED
Figured dimensions only to be used. This drawing is subject to and protected by the provision of the copyrights acts. Any discrepancies or queries to be notified immediately. All dimensions to be verified on site

© PRET A MANGER (EUROPE) LTD 2004