

SUMMARY OF ACCOMMODATION.



FLOOR.	SECOND	FIRST	SECOND
Number of flatlets.	8	8	8
TOTAL NO. of FLATLETS.			24.

KEY to PLANS.

U.S.	APPROX. AREA	REMARKS
6. LIVING ROOM	167.6 sq. ft.	
8A. BED. RECESS	49 sq. ft.	
6. KITCHEN	57-78 sq. ft.	
6. FURS BATH	22.7 sq. ft.	access to porch from corridor
8. BATHROOM	45 sq. ft.	
B. HALL	47.5 sq. ft.	even includes couple sq. for entrance to CLUB. entrance
APPROX TOTAL AREA - 378.75 sq. ft.		

D/A. INTERIOR OF FLAT. 24'-9" x 15'-4"

D/A. INTERIOR of FLAT. 24'-9" x 15'-4".

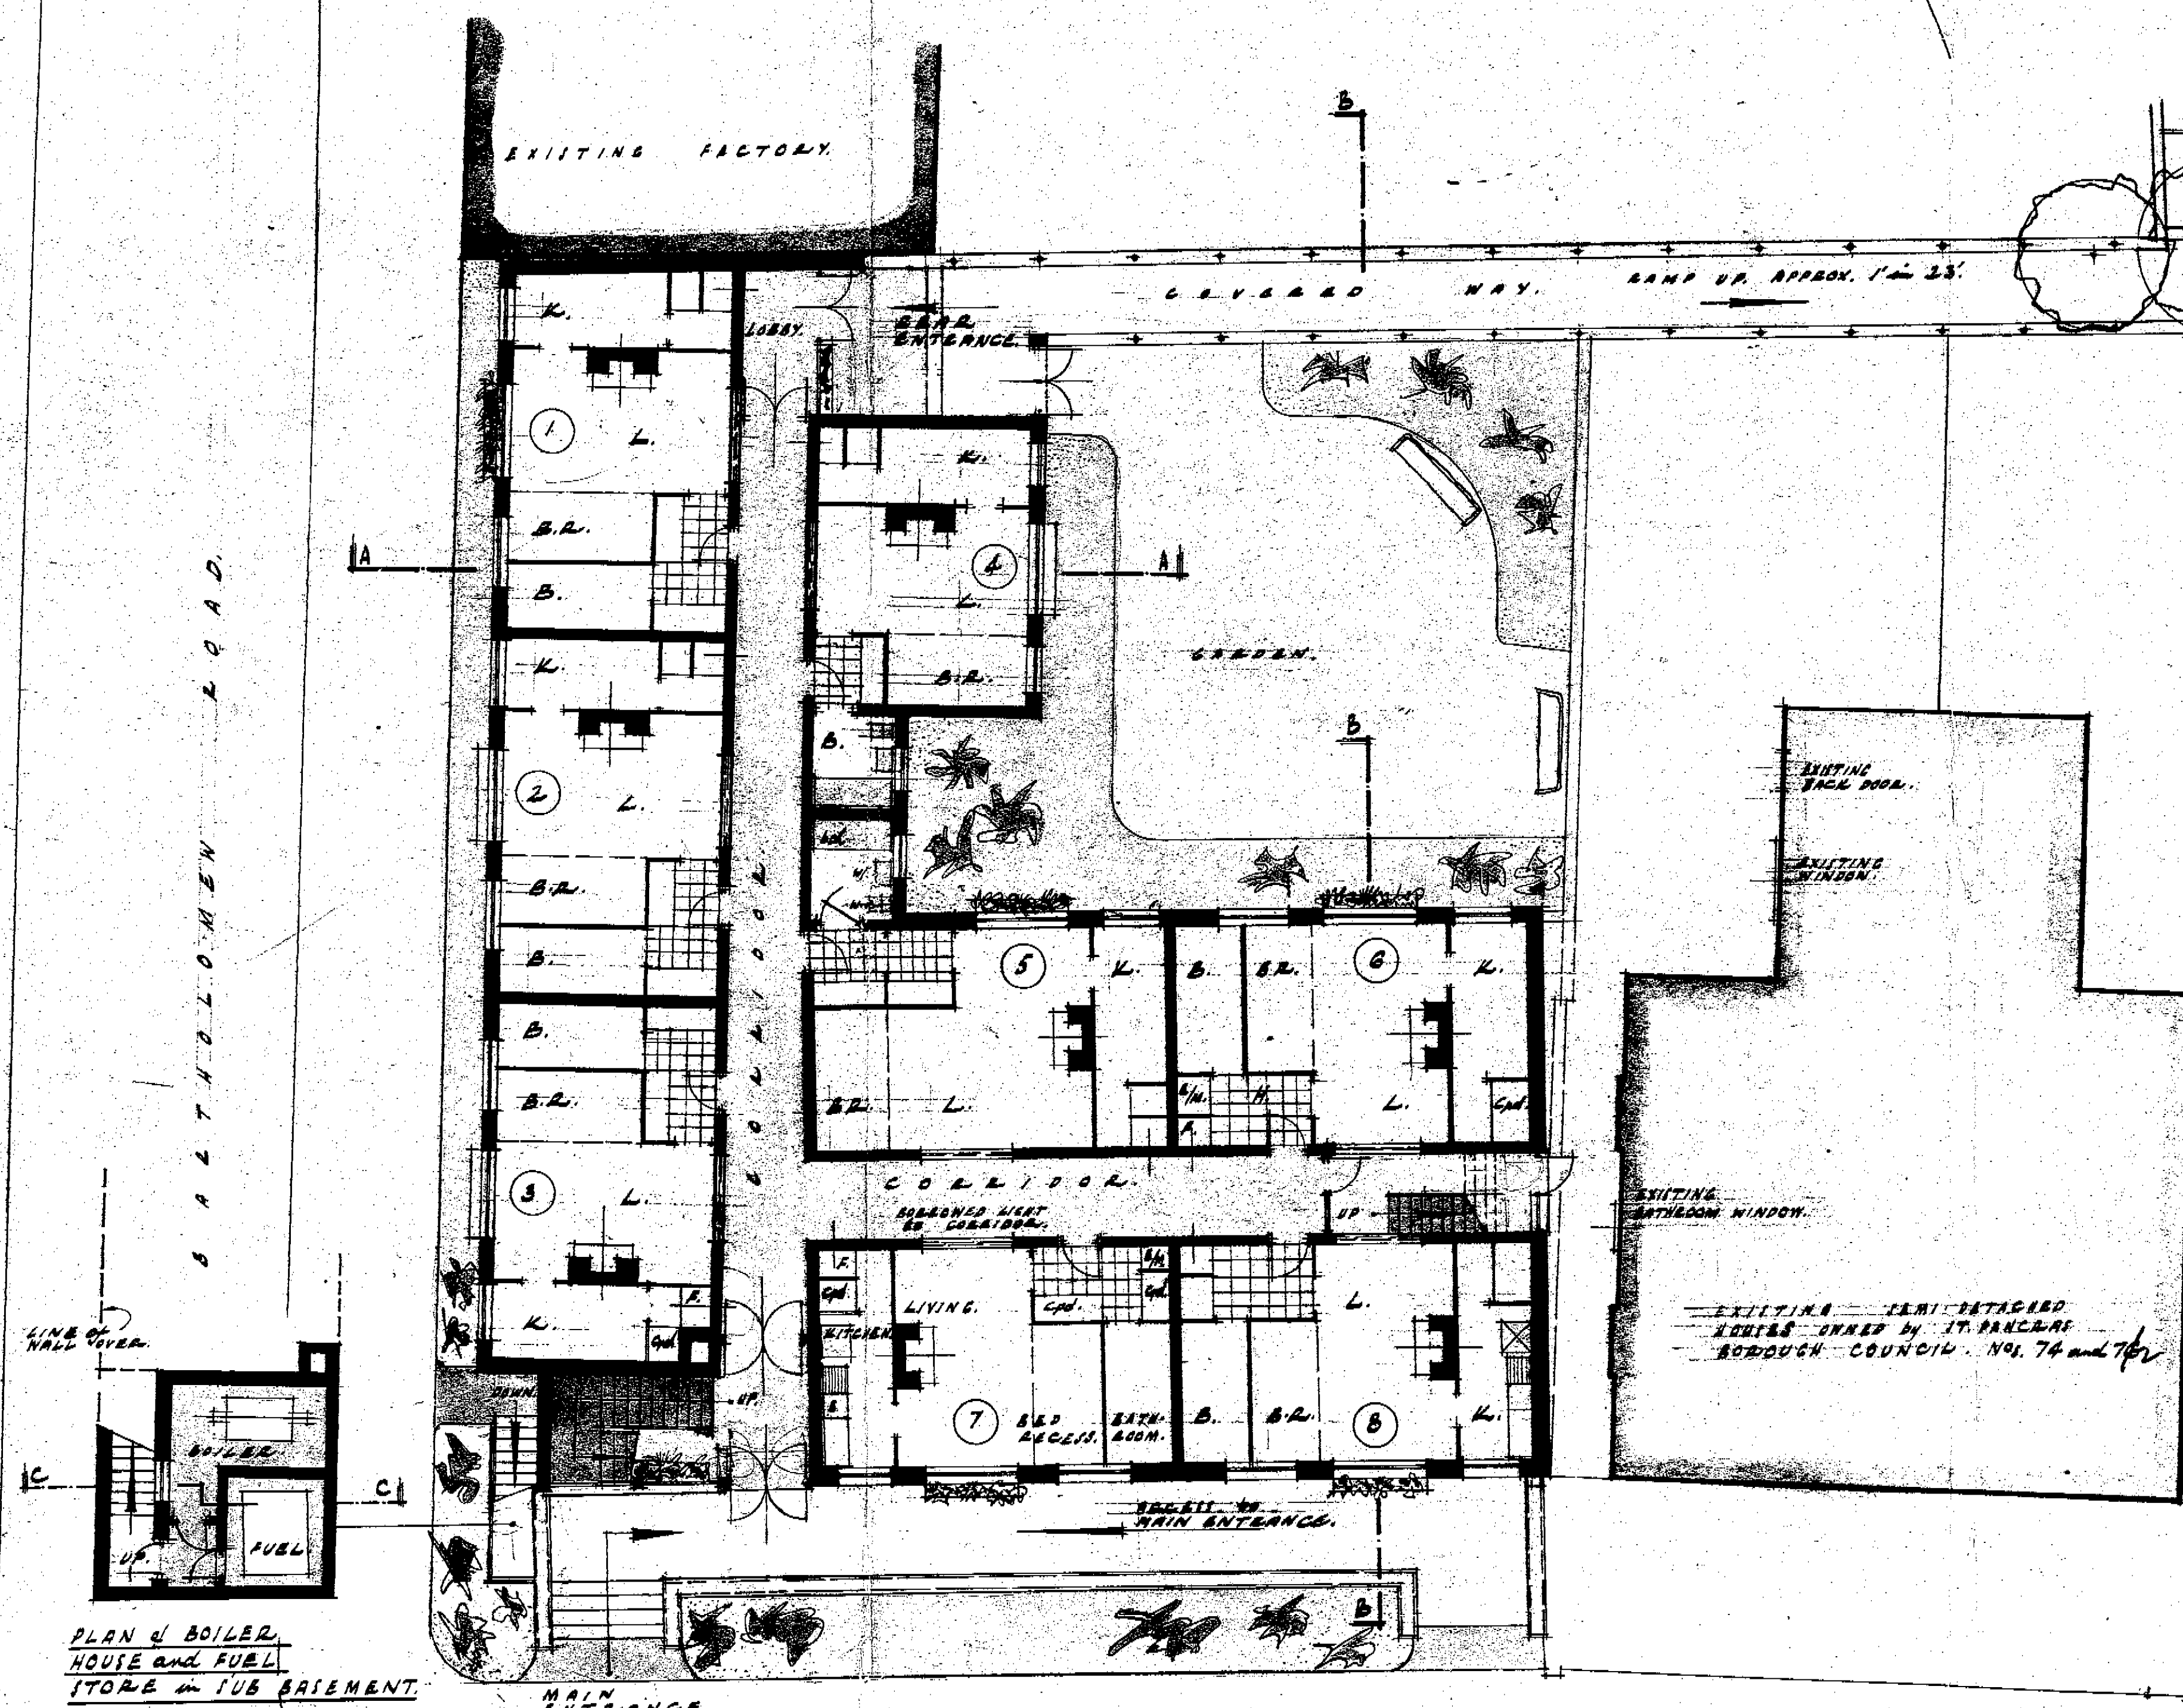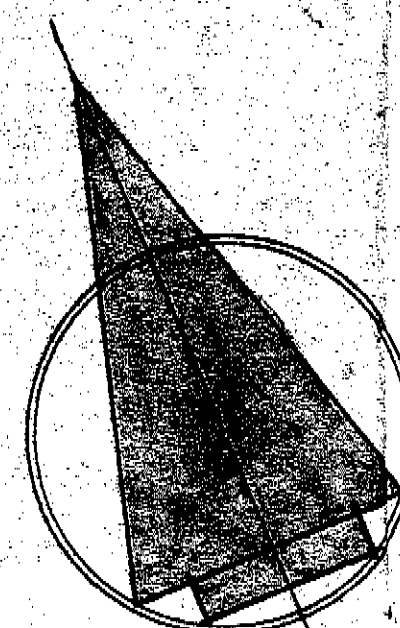

TYPICAL FIRST and SECOND FLOOR PLANS

N.B.
THE FLAT PLANS ARE
ALL SIMILAR TO THE
GROUND FLOOR.

Details of Tank born
added in red-ink.
27/8/57.
Prin. A. Hoops


GROUND FLOOR PLAN
Scale. 8 ft. to an inch.

DRAWING NUMBER 180/12A
SCALE 8ft to an inch
DATE JUNE 1959
DESIGN G. W. H. Hogg


DISENEY CREICENT METROPOLITAN BOROUGH of IT PANORAS.
SKETCH DESIGN IN OLD PEOPLES FLATLETS. SHEET I.

THOMAS LOTHROP, F.A.I.C.A. A.I.C.S. A.M.A.S.
CHARTERED ARCHITECT & SURVEYOR
TOWN PLANNING CONSULTANT.
10, MANCHESTER SQUARE, W.I.

9257
27 JUL 1959

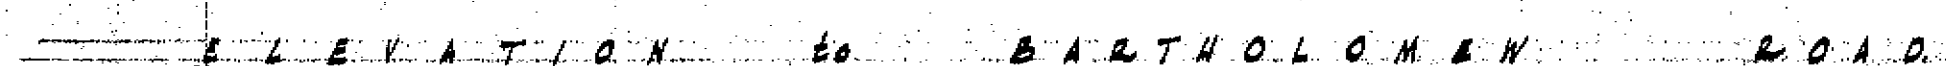



KEY to MATERIALS.	
	facing bricks, London.
	clerks to match greenwood.
	approved rendering.
	facing tiles.

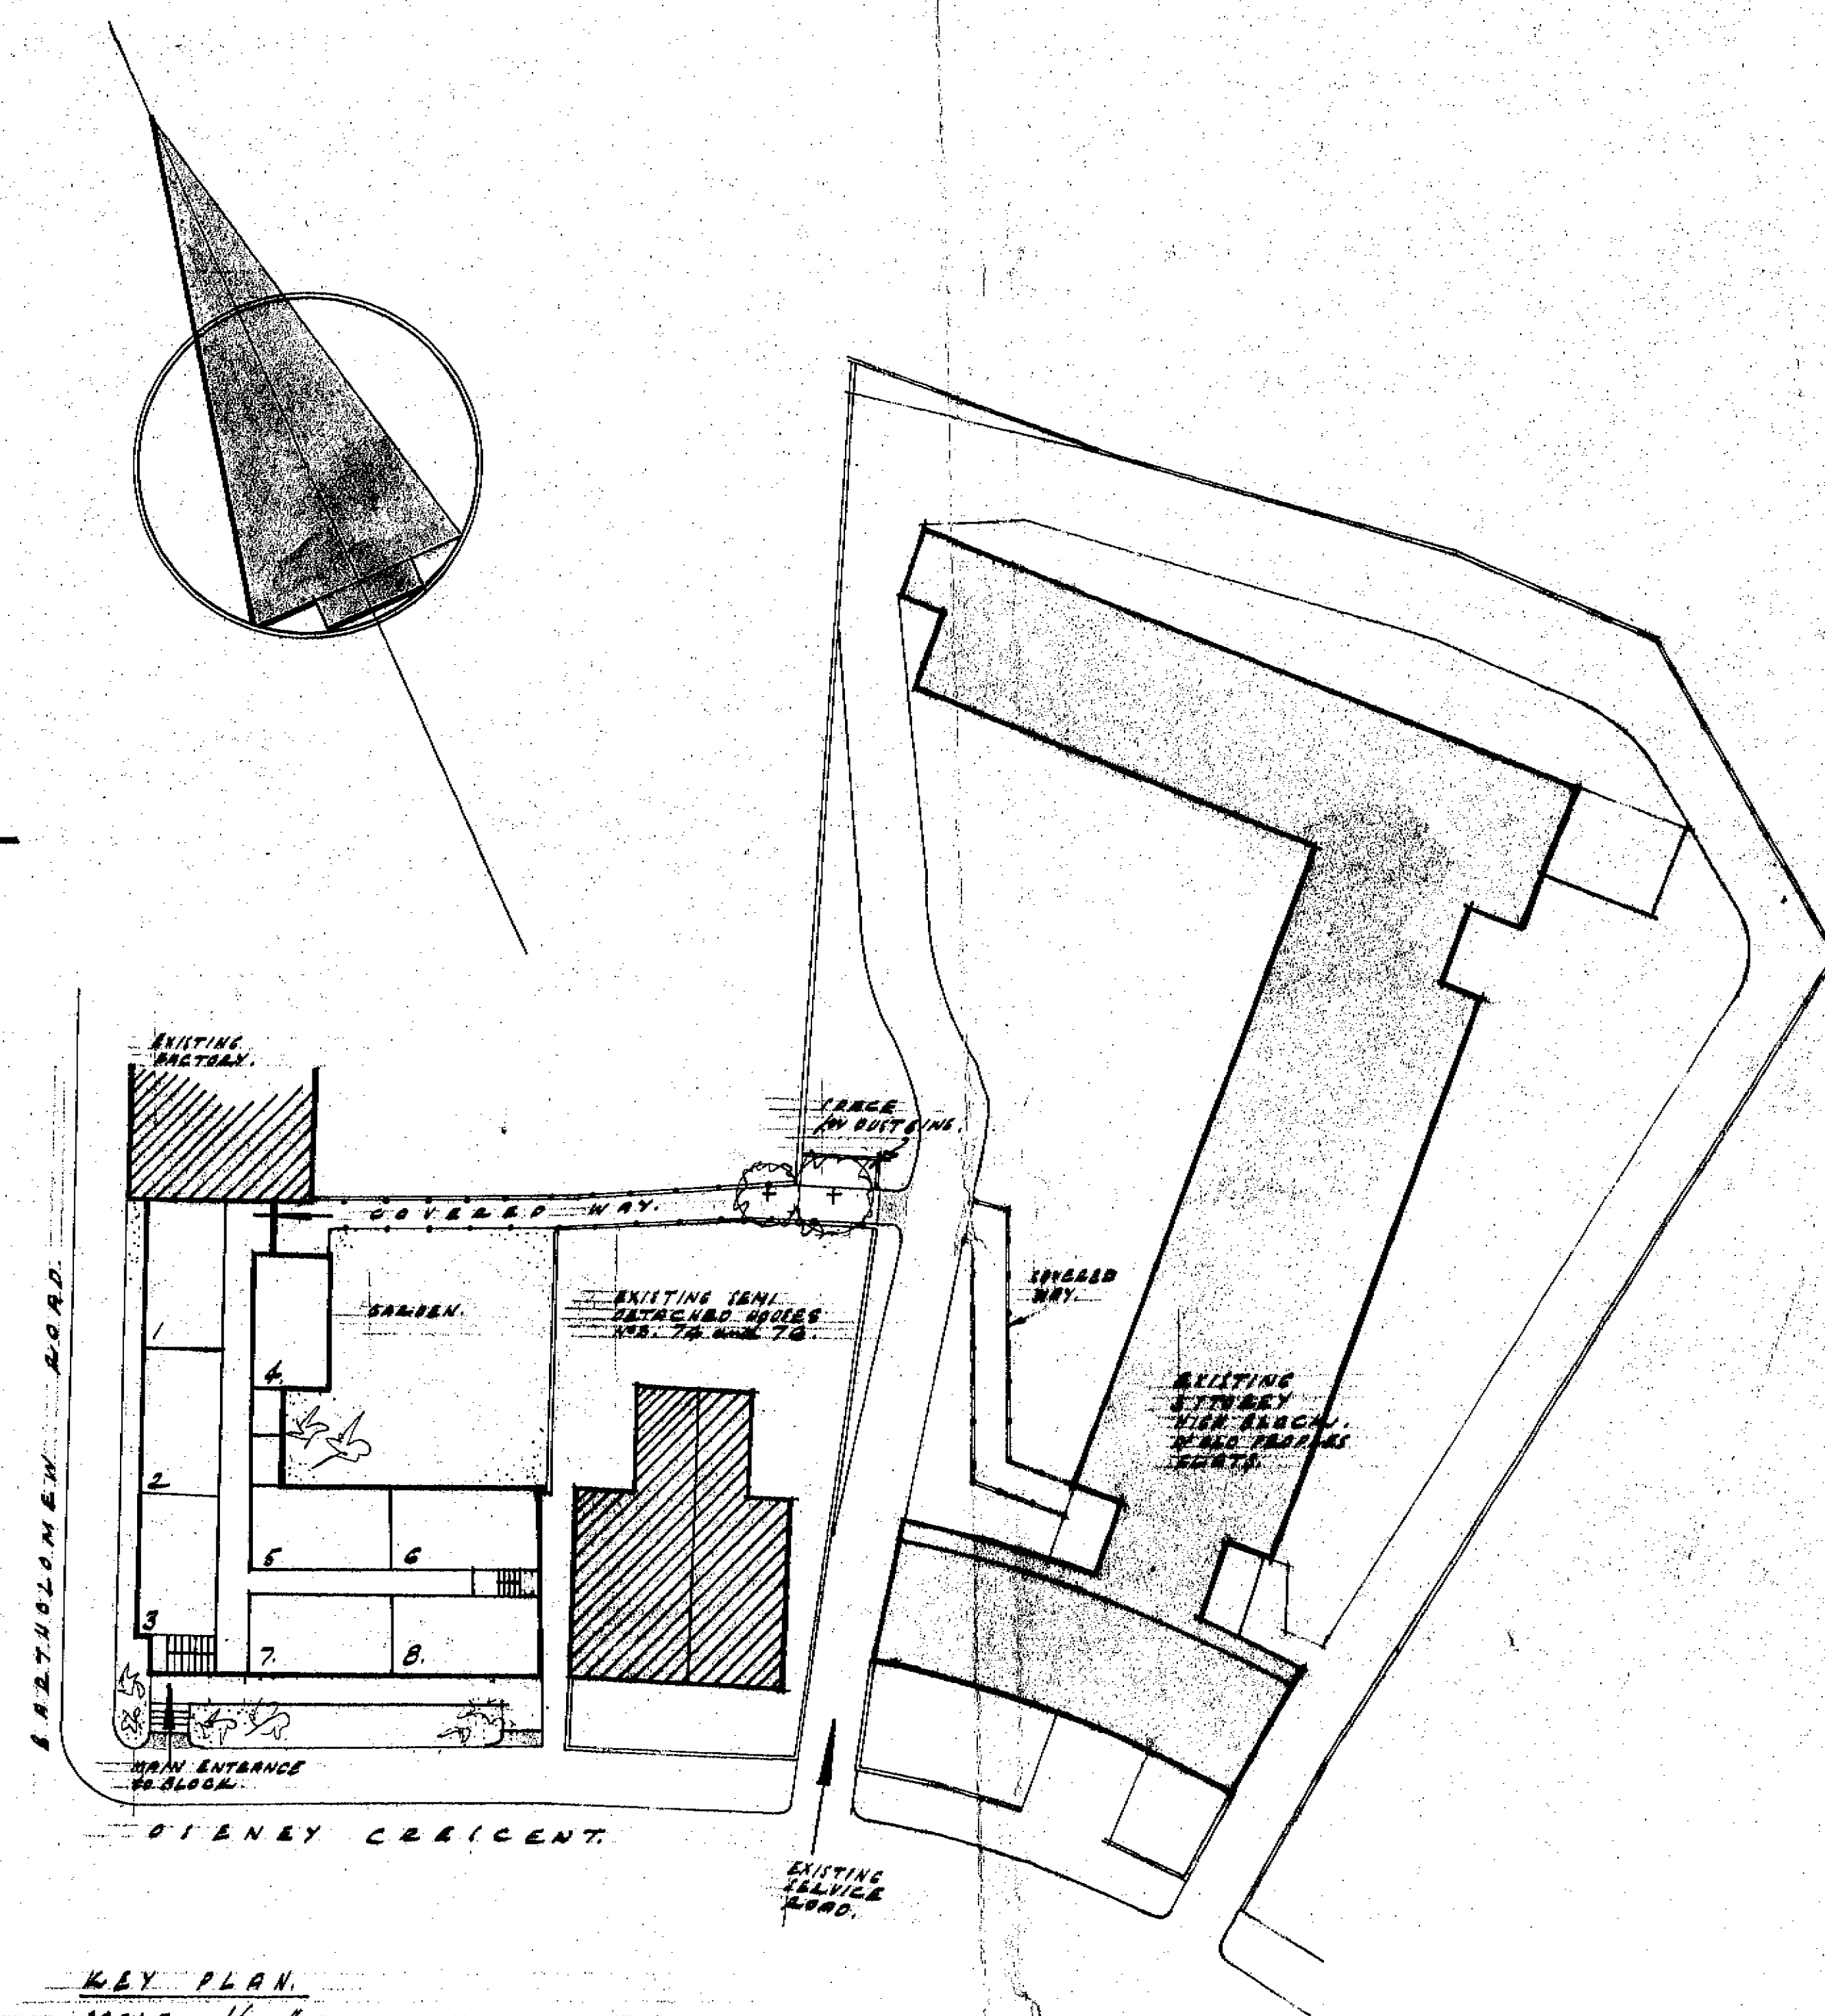


KEY PLAN.
SCALE: 1/24"

0 J E N E Y C R E I C E N T M E T R O P O L I T A N B O R O U G H o f S T . P A N C R A S .
I K E T C H D E S I G N / n O L D P E O P L E S F L A T L E T S . S H E E T . 2 .

THOMAS SIDTHOLP, F.R.I.B.A. F.R.I.C.E.
A.M.A.I.A.
CHARTERED ARCHITECT & SURVEYOR
TOWN PLANNING CONSULTANT,
10, MANCHESTER SQUARE, W.1.

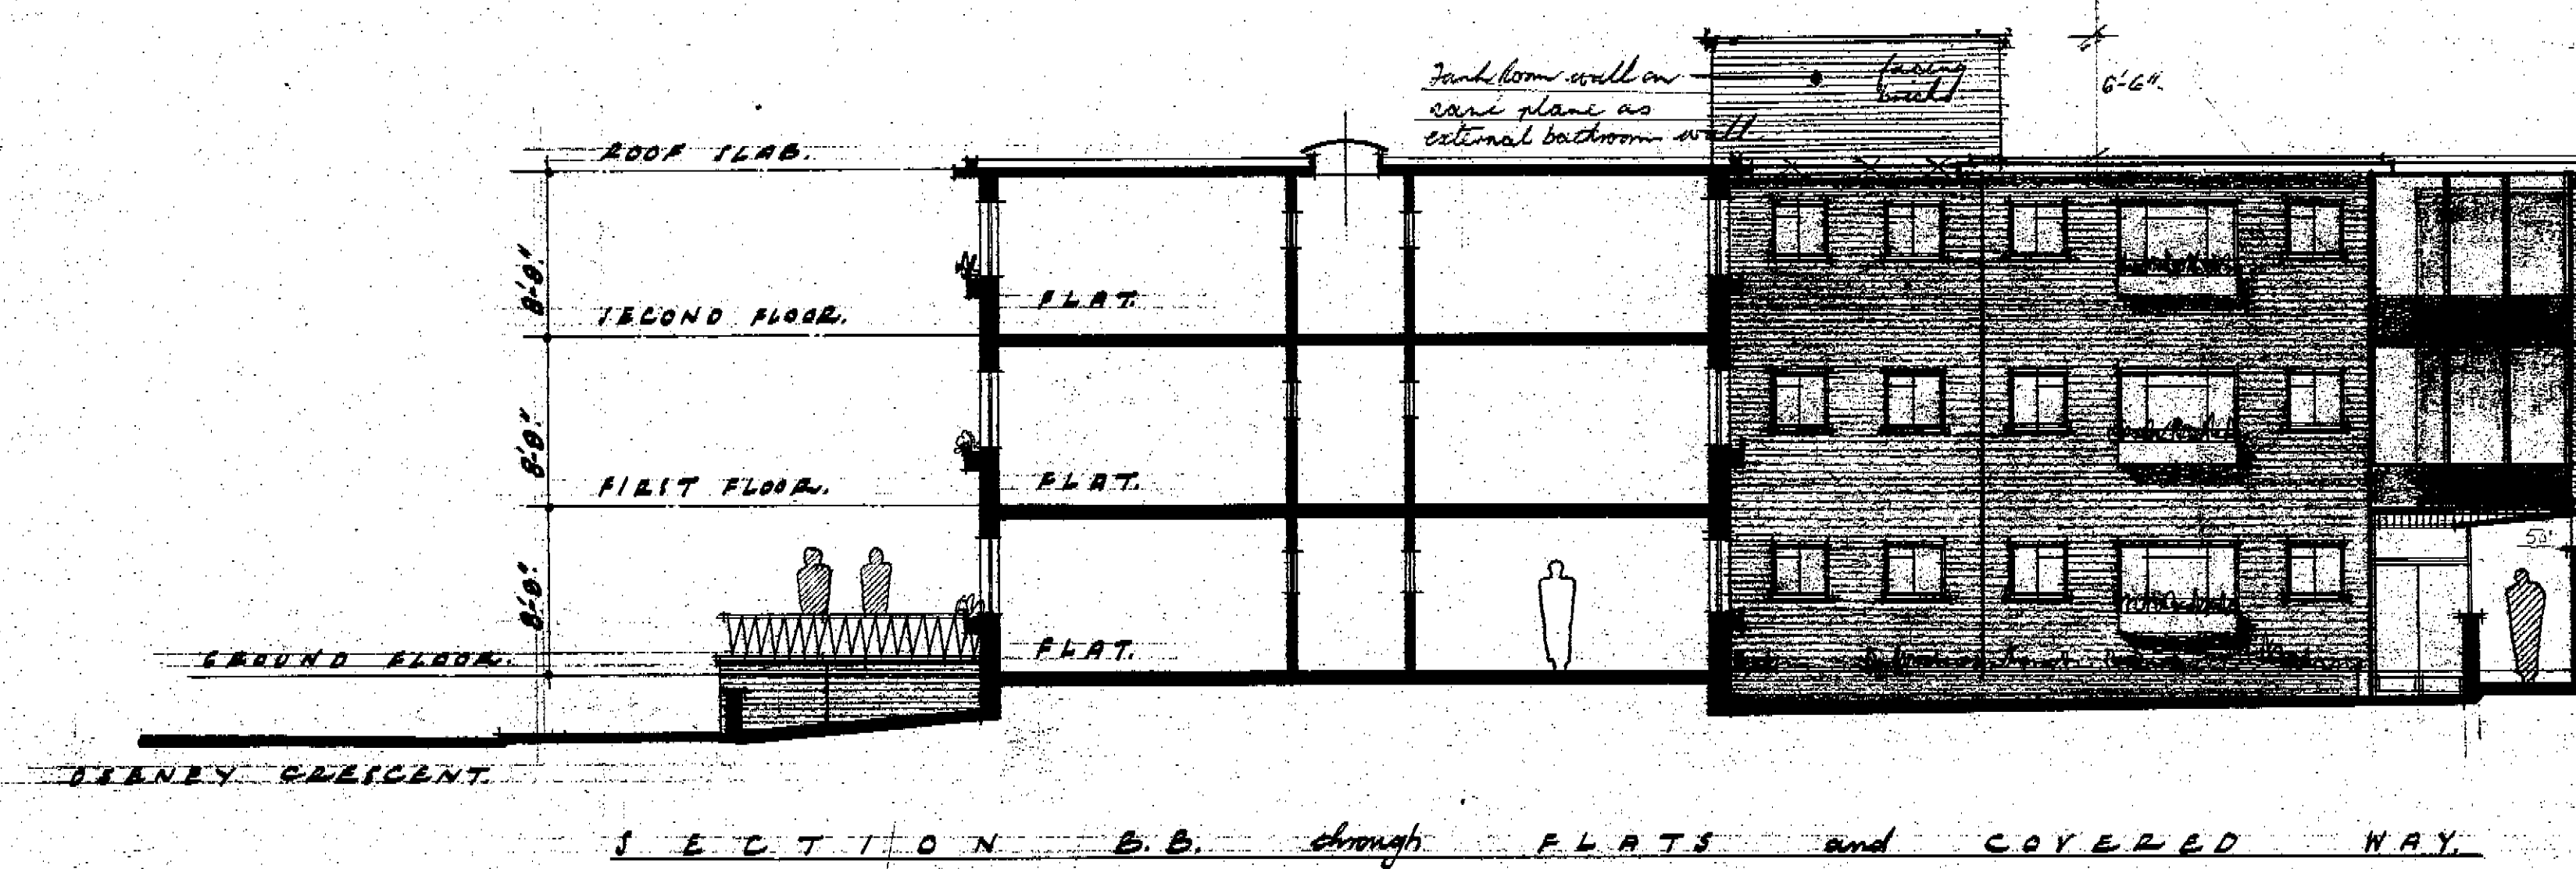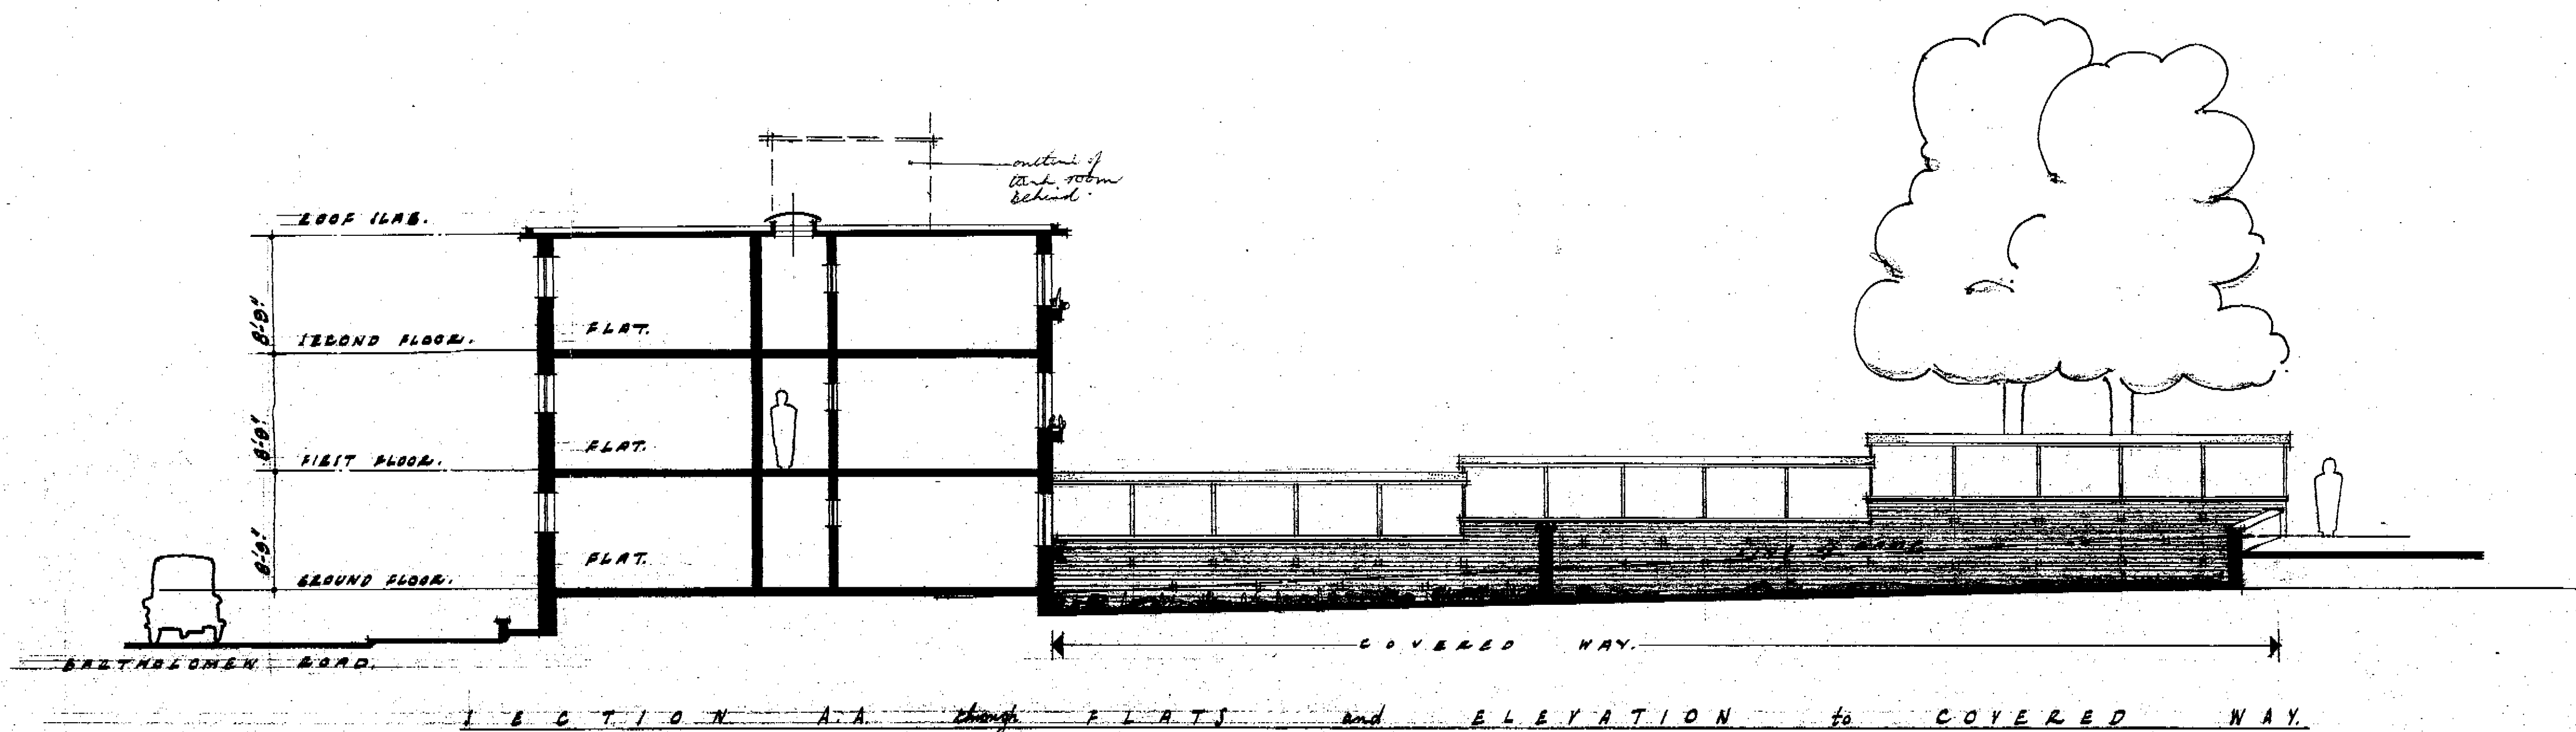

DATUM: 102.5' finished floor.

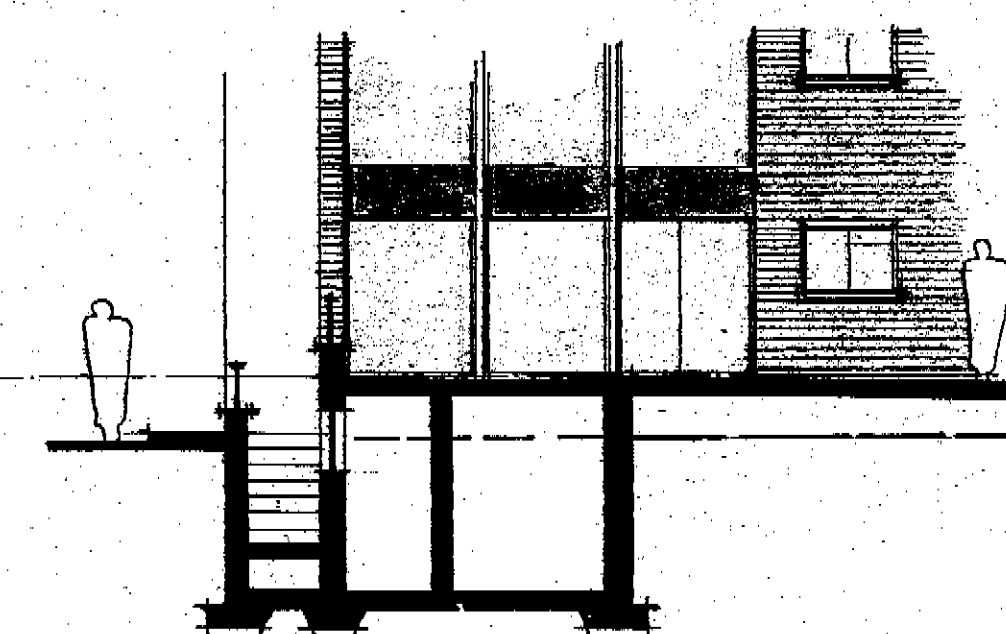

Detail of tank room added in red ink. 27/9/59. [Signature]


KEY TO MATERIALS.	
[Pattern]	facing bricks, London stock
[Pattern]	exposed rendering
[Pattern]	facing tiles

DRAWING NUMBER: 180/16.
DATE: 8th to 10th week.
DATE: JULY 1960.
DRAWN BY: [Signature]


DIENLY CRESCENT, METROPOLITAN BOROUGH of ST PANCRAS.
SKETCH DESIGN for OLD PEOPLES FLATLETS. SHEET 3.

THOMAS FOTHERGILL, FRIBA, AMPTD.
19/60.
CHARTEDED ARCHITECT & SURVEYOR.
TOWN PLANNING CONSULTANT.
10, MANCHESTER SQUARE, W.1.

9257
27 JUL 1960

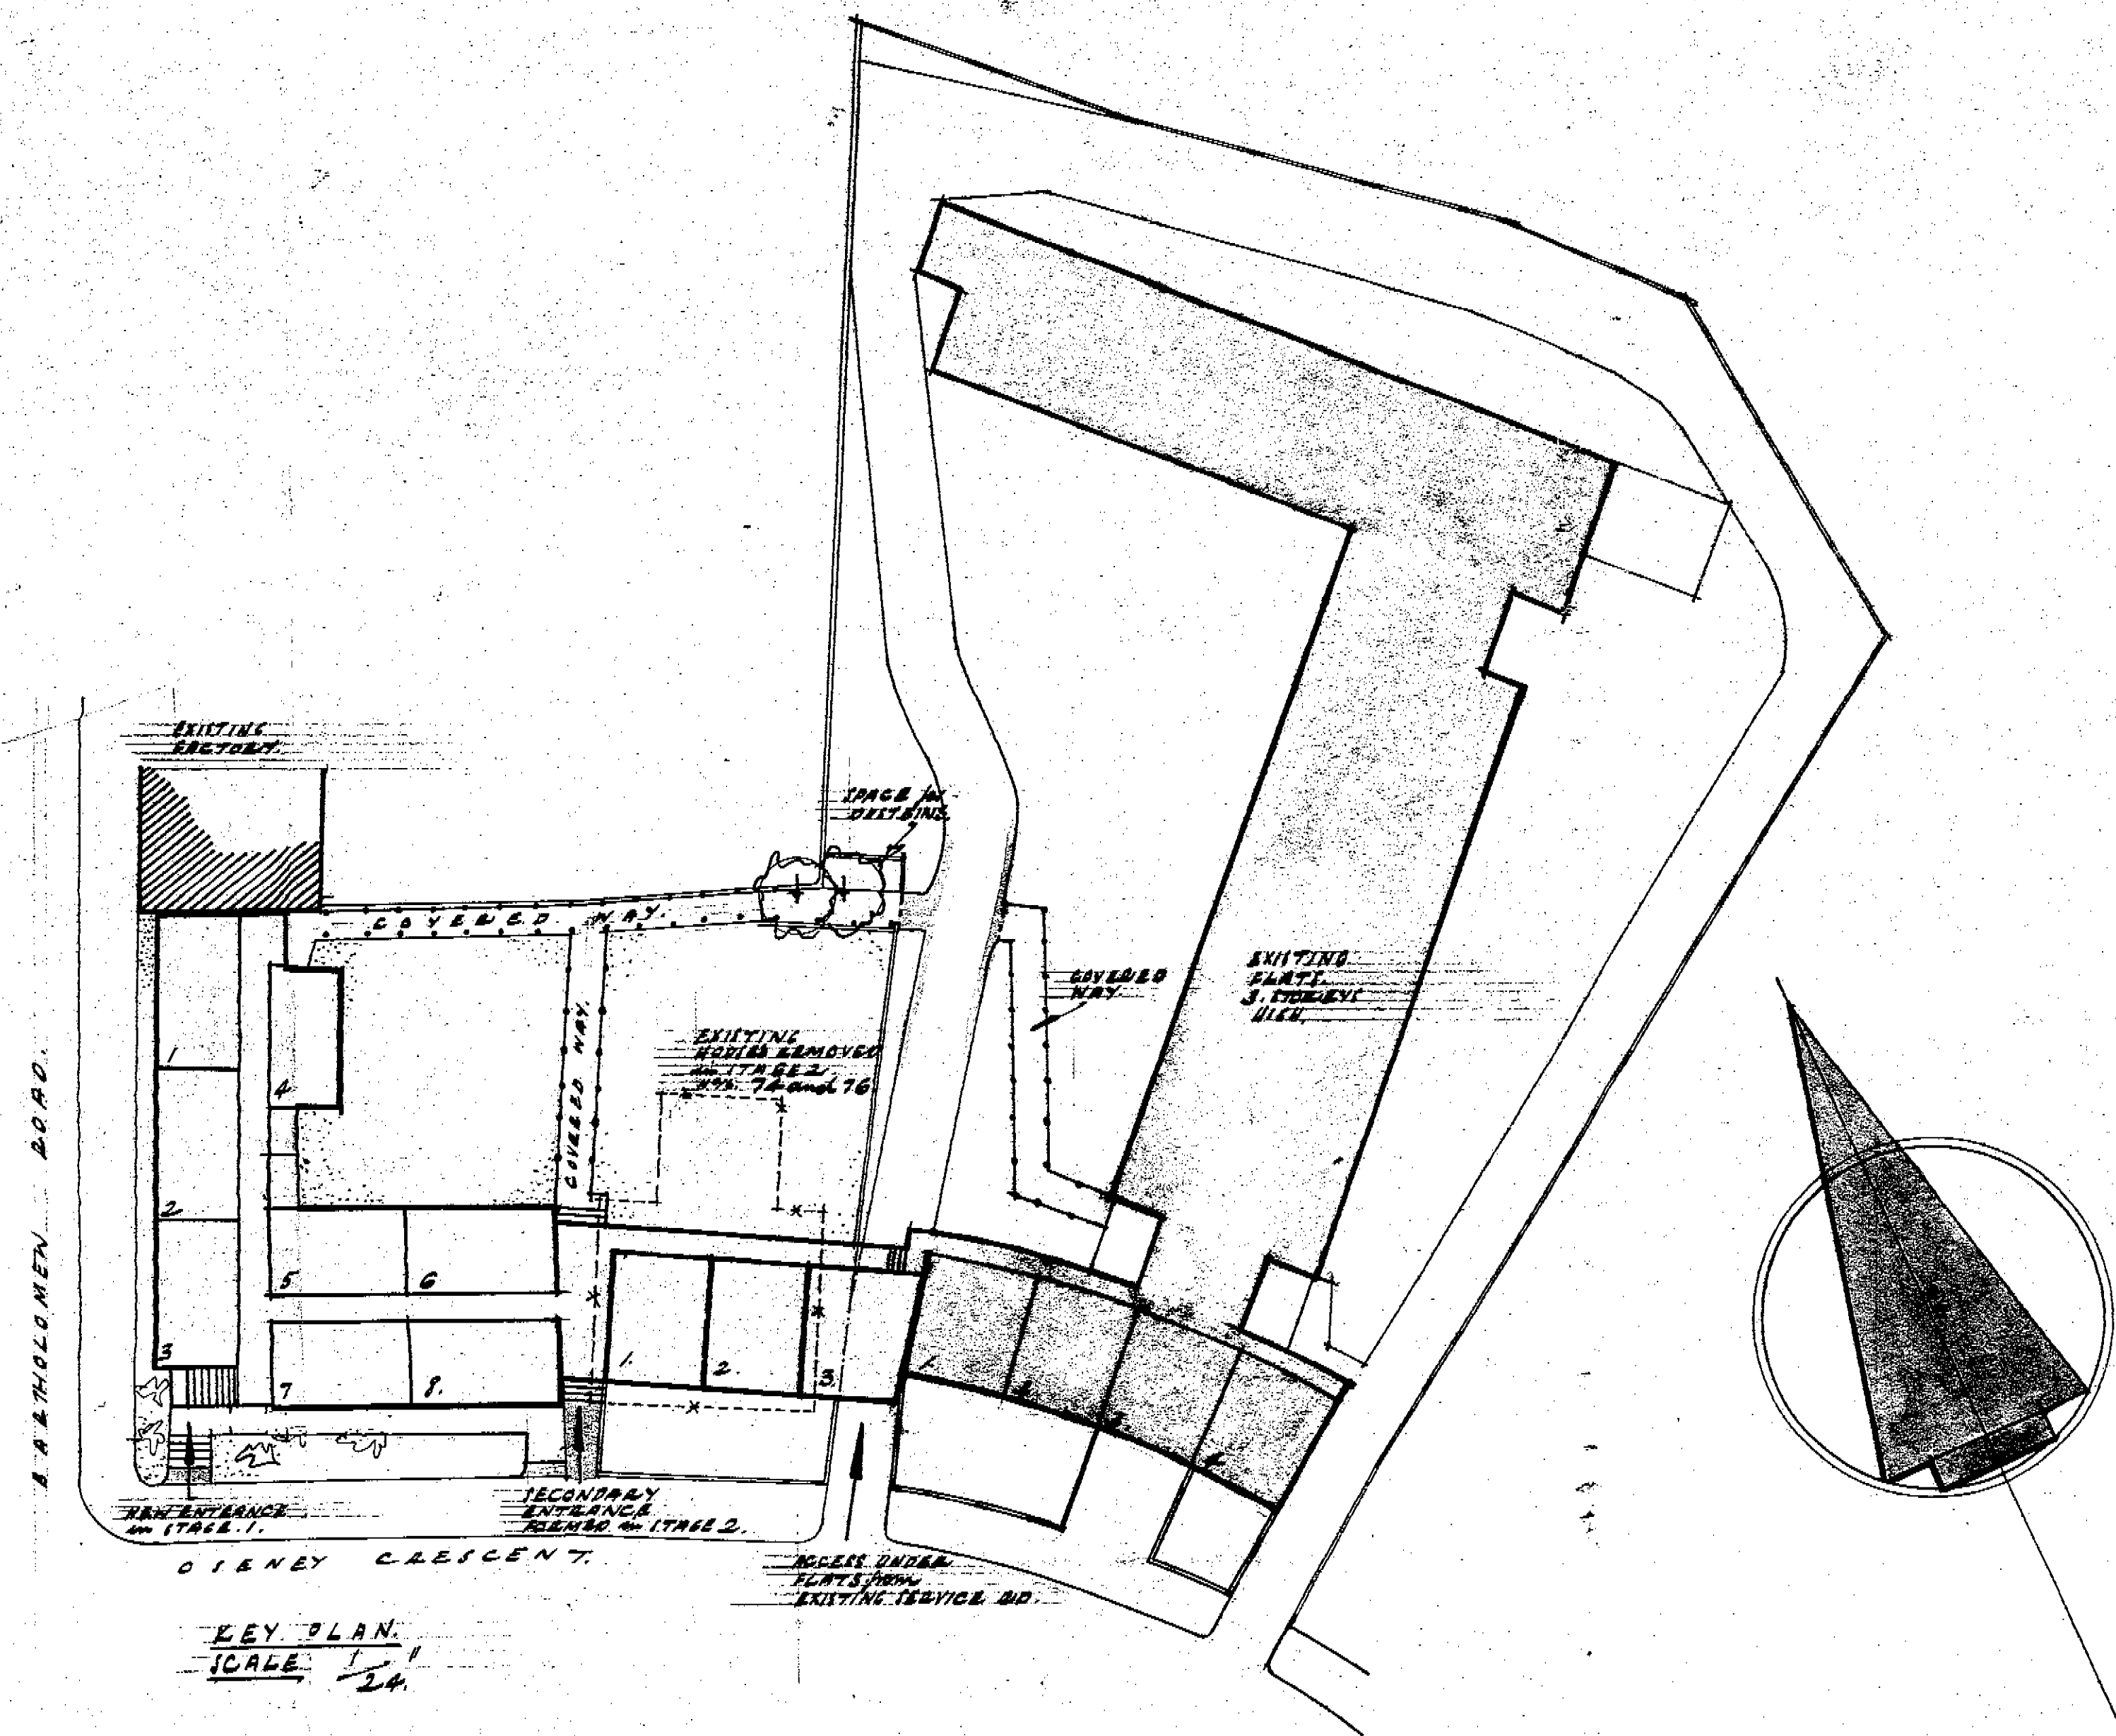

KEY TO BLOCK PLAN.		
REMARKS.	PARTS.	
Existing building comprising 3 floors old people's dwellings.		
STAGE 1. Demolishing 3 floors old people's dwellings.	2A	
STAGE 2. Demolishing 3 floors old people's dwellings and building new block.	B	

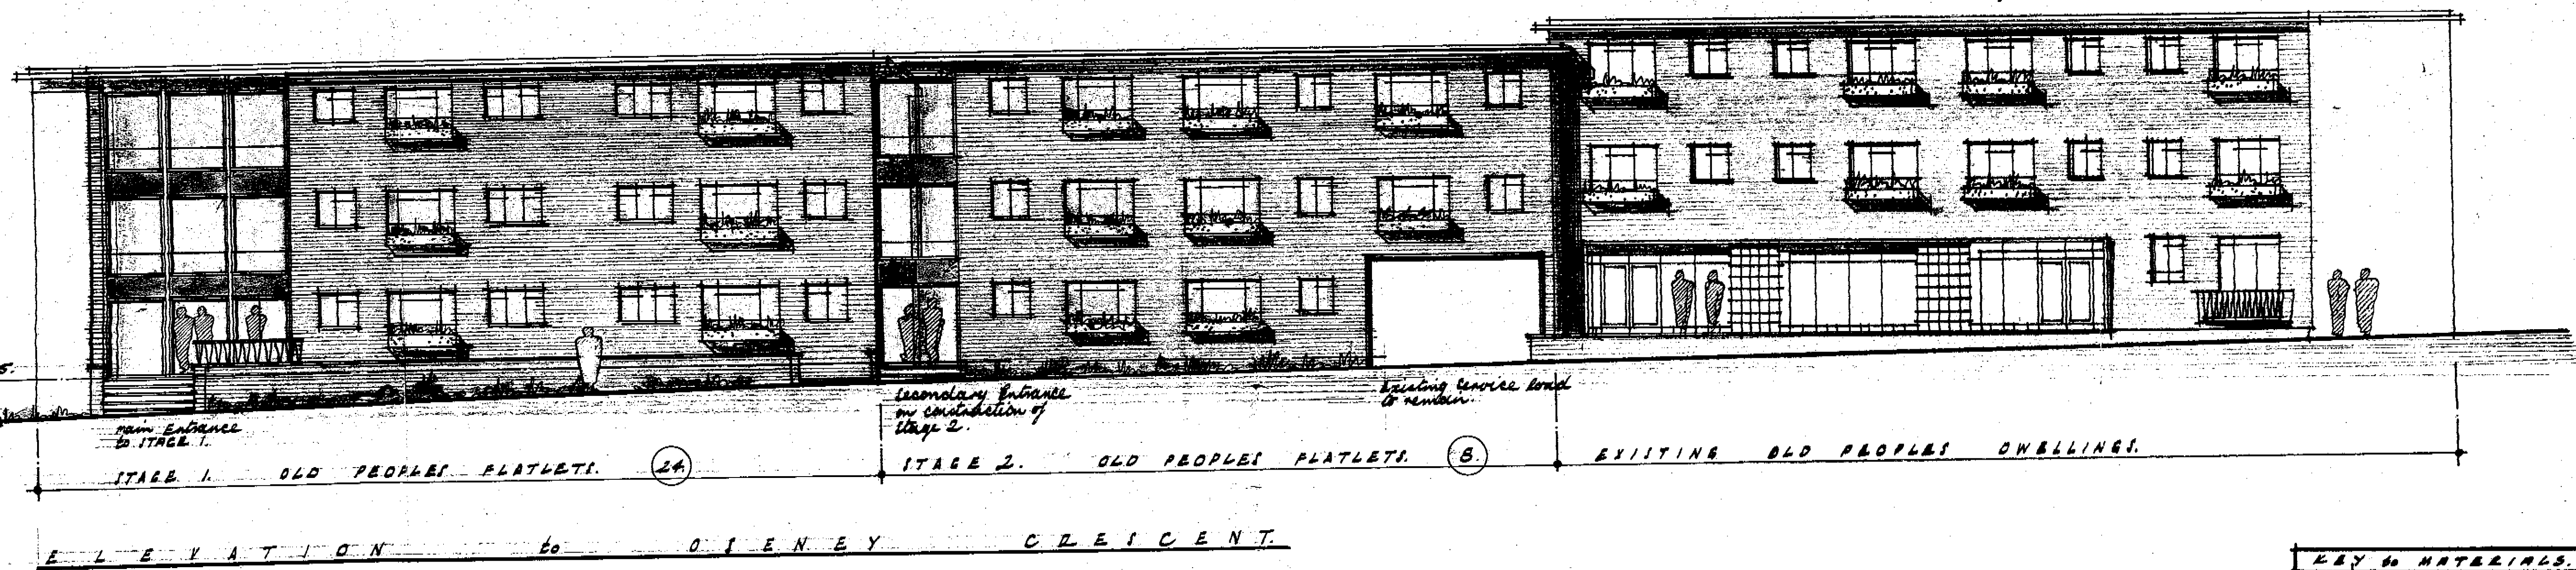

KEY TO MATERIALS.	
Facing bricks to match existing.	
Approved rendering.	
Facing tiles.	

DRAWING NUMBER. 180/14A.
 SCALES. 8 1/4 and 2 1/4" to 1".
 DATE. JUNE. 1959.
 DRAWN BY. G. A. King.

OSNEY CRESCENT METROPOLITAN BOROUGH of ST. PANCRAS.
 SKETCH DESIGN for OLD PEOPLE'S FLATLETS. POSSIBLE FUTURE DEVELOPMENT. SHEET 1.

THOMAS (10THOR) ADLER, ARCHT.
 A.M.P.A.
 CHARTERED ARCHITECT & INTERIOR
 PLANNING CONSULTANT
 10 MANCHESTER SQUARE, W.1.

9257
 27 JUN 1959