


PROPOSED
Side Elevation
1:100@A3

52 Belsize Park Garden

No other proposed changes than
the side dormer extension.

Similar approved application at
75 Belsize Park Garden
Application Ref: 2016/5500/P

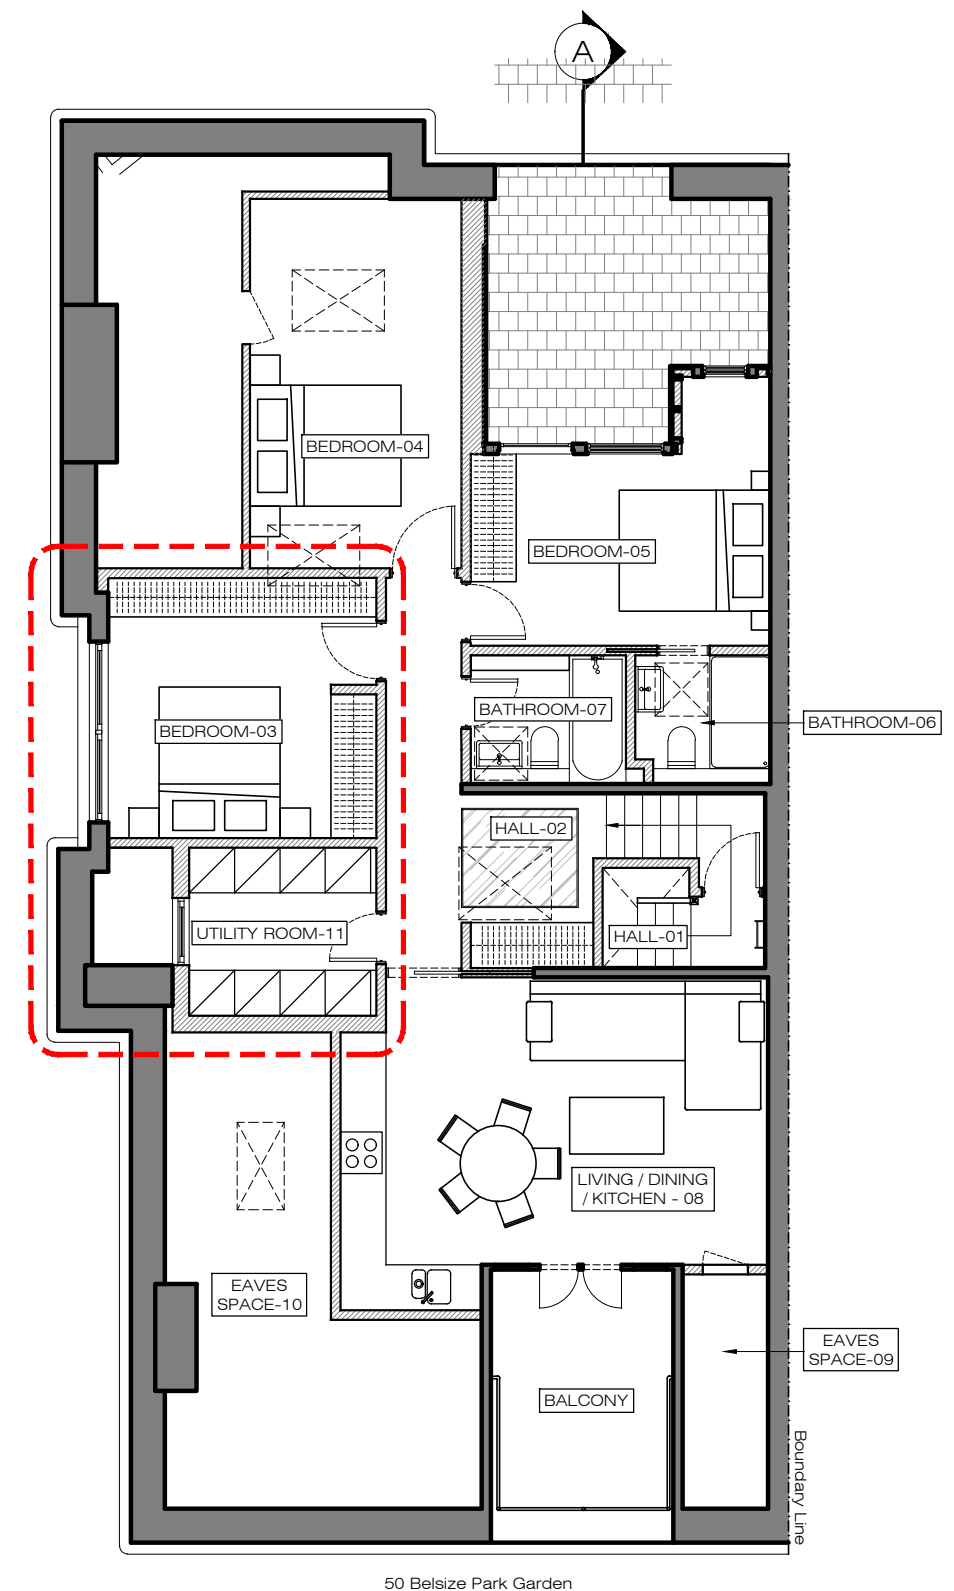

PROPOSED
Third Floor Plan
1:100@A3

50 Belsize Park Garden



Ground Floor Office
33 Belsize Lane
London NW3 5AS
Office: +44 (0) 207 431 9014
info@xularchitecture.co.uk
www.xularchitecture.co.uk

PLEASE NOTE:

- All dimensions to be checked on site before fabrication,
- Contractor to refer to engineers drawings before proceeding with works.
- All drawings and designs are covered by design right (intellectual property), and may not be distributed, copied or issued without written permission by the Architect.
- All design concepts are the sole property of the Architect and no adaptations, reproductions or copies may be made without written permission of the Architect.
- These drawings are subject to any variation required or recommendation by any statutory authority, or for the better carrying out of the works.
- Samples to be provided by contractor for XUL Architecture's approval.
- All finishes to XUL Architecture's satisfaction.
- All drawings to be approved by XUL Architecture prior to construction.

ADDITIONNAL NOTE:

Issue key:

Information (I)
Planning (P)
Tender (T)
Construction (C)
As Built (B)

Project Address
50 Belsize Park Gardens, NW3 4ND

Issue For:
PLANNING

Scale 1:100@A3

Rev. Date 12.10.20

Drawn TP

Checked SS

PROPOSED

3rd Floor Plan & Side Elevation

Dwg. No. PA-01

Rev. P-01

Project Number

19175