



DELTA BRAVO GROUP LTD NOTES:
 Proposed plans & elevations have been prepared on the basis of drawings: 0620-SD-13358 produced by Site Vision Surveys Ltd and provided by T4 to Delta Bravo Ltd.
 Delta Bravo Ltd accept no liability for the accuracy or completeness of the original drawings. "As-built" unit must be checked against the drawings prior to any works.
 Delta Bravo Group Ltd copyright. This drawing shall not be reproduced without express written permission from DBG.
 Delta Bravo Group accept no responsibility or liability for drawing alterations carried out by others and have not checked such alterations.
 This drawing shall not be scaled to ascertain any dimensions.
 Asbestos survey required prior to commencement.
 Contractor/Structural Engineer to confirm load bearing walls.

BUILDING IN CONSERVATION AREA

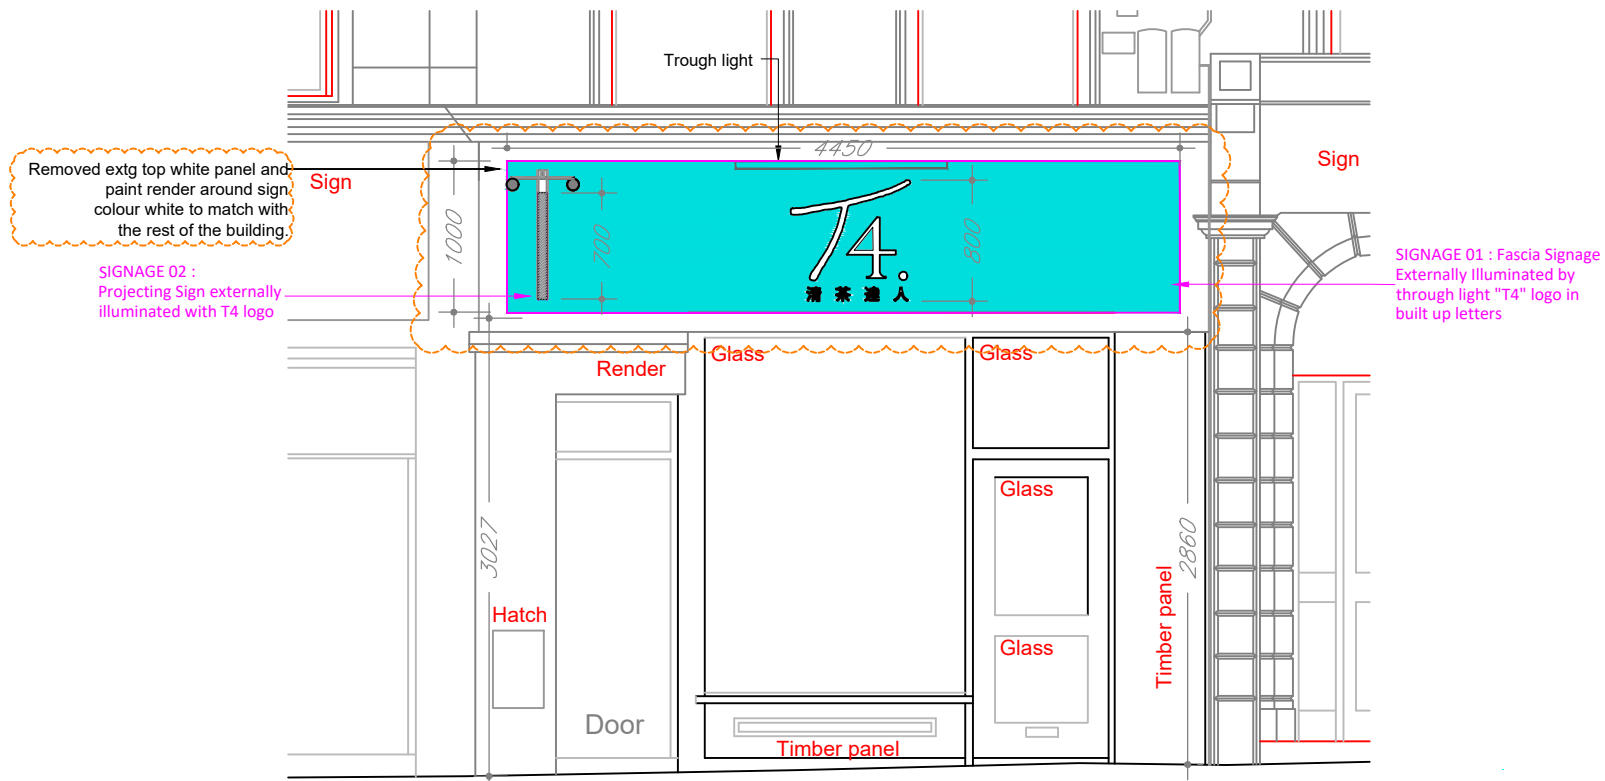


FRONT ELEVATION
 SCALE 1:25@A1 / 1:50@A3

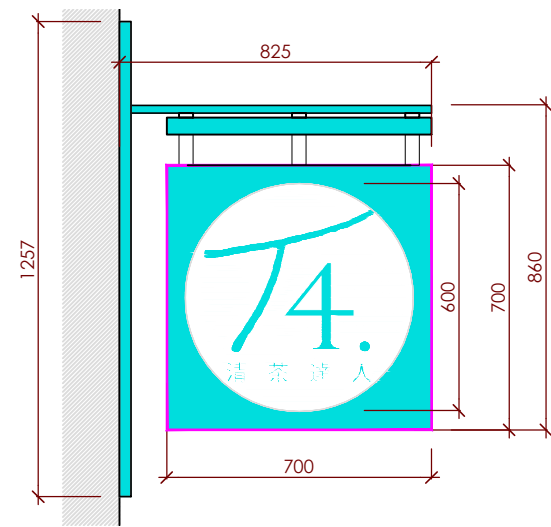

S2 PROJECTING SIGN
 EXTERNALLY ILLUMINATED PROJECTING SIGN
 Scale 1:10@A1 / 1:20@A3

- Double sided projecting sign.
- Project sign case constructed from folded aluminium panels 50mm wide extruded aluminium framework.
- Polyester powder coated PPC finish in Pantone 3265C
- White Acrylic circular logo to each side.
- Hanging bracket all finished in Pantone 3265C
- External illuminated slimline troughlight with LED lighting. Maximum luminance 200 candelas/m².
- All cabling and Fixing details to be concealed.
- All finishes to be sealed and weathered.

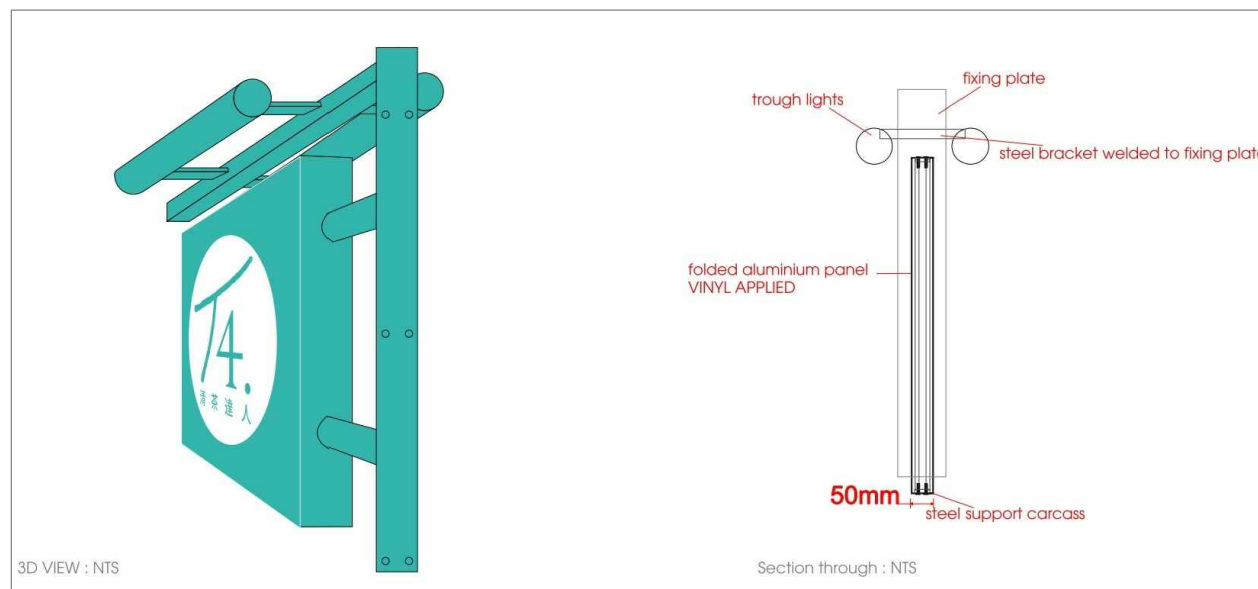

REV	AMENDMENT	DATE
C	Fascia sign centered to leave render around it as requested.	15.10.20
B	Removed timber panel and reduce size of fascia sign.	13.10.20
A	Added timber panel around fascia sign to reduce sign size as req by PO.	12.10.20

NOTES:
 CONTRACTORS MUST VERIFY ALL DIMENSIONS ON SITE BEFORE COMMENCEMENT OF ANY WORK OR PREPARING MANUFACTURING DRAWINGS
 ANY DISCREPANCIES ON THIS DRAWING ARE TO BE NOTIFIED TO THE DESIGNER IMMEDIATELY

DELTA BRAVO LIMITED
 DESIGN • CONSTRUCTION • SHOPFITTING • PROJECT MANAGEMENT

Academy House
 London Road
 Camberley
 Surrey
 GU15 3HL

CLIENT	T4		
PROJECT	Unit 1A Parkway, Camden LONDON, NW1 7PG		
TITLE	PROPOSED PROJECTING SIGN		
SCALE @ A1	DRAWN BY	DATE	
1:25 / 1:10	M W	09.09.20	
DRAWING No	REVISION		
DB468- SG02	C		

