


Rev	Date
Q	15.09.20
P	10.09.20
O	04.09.2020
N	19.08.20
M	24.07.20
L	21.07.20
K	12.02.20
J	29.01.20
I	19.12.19
H	13.08.19
G	19.06.19
F	26.02.19
E	12.02.19
D	29.11.18
C	15.08.18
B	13.07.18
A	10.07.18
-	06.07.18

For Information
Issued only for purpose indicated
This drawing is to be read in conjunction with all consultants information.
All dimensions to be checked on site. Do not scale, except for planning purposes.
This drawing is protected by copyright.
JOB NUMBER 212
JOB TITLE Klein 2 7 Rosecroft Avenue, NW3 7QA
DRAWING TITLE ground floor proposed
SCALE: 1:50@A3
DATE: July 2018
DRAWING NO. A/02/101
REV Q

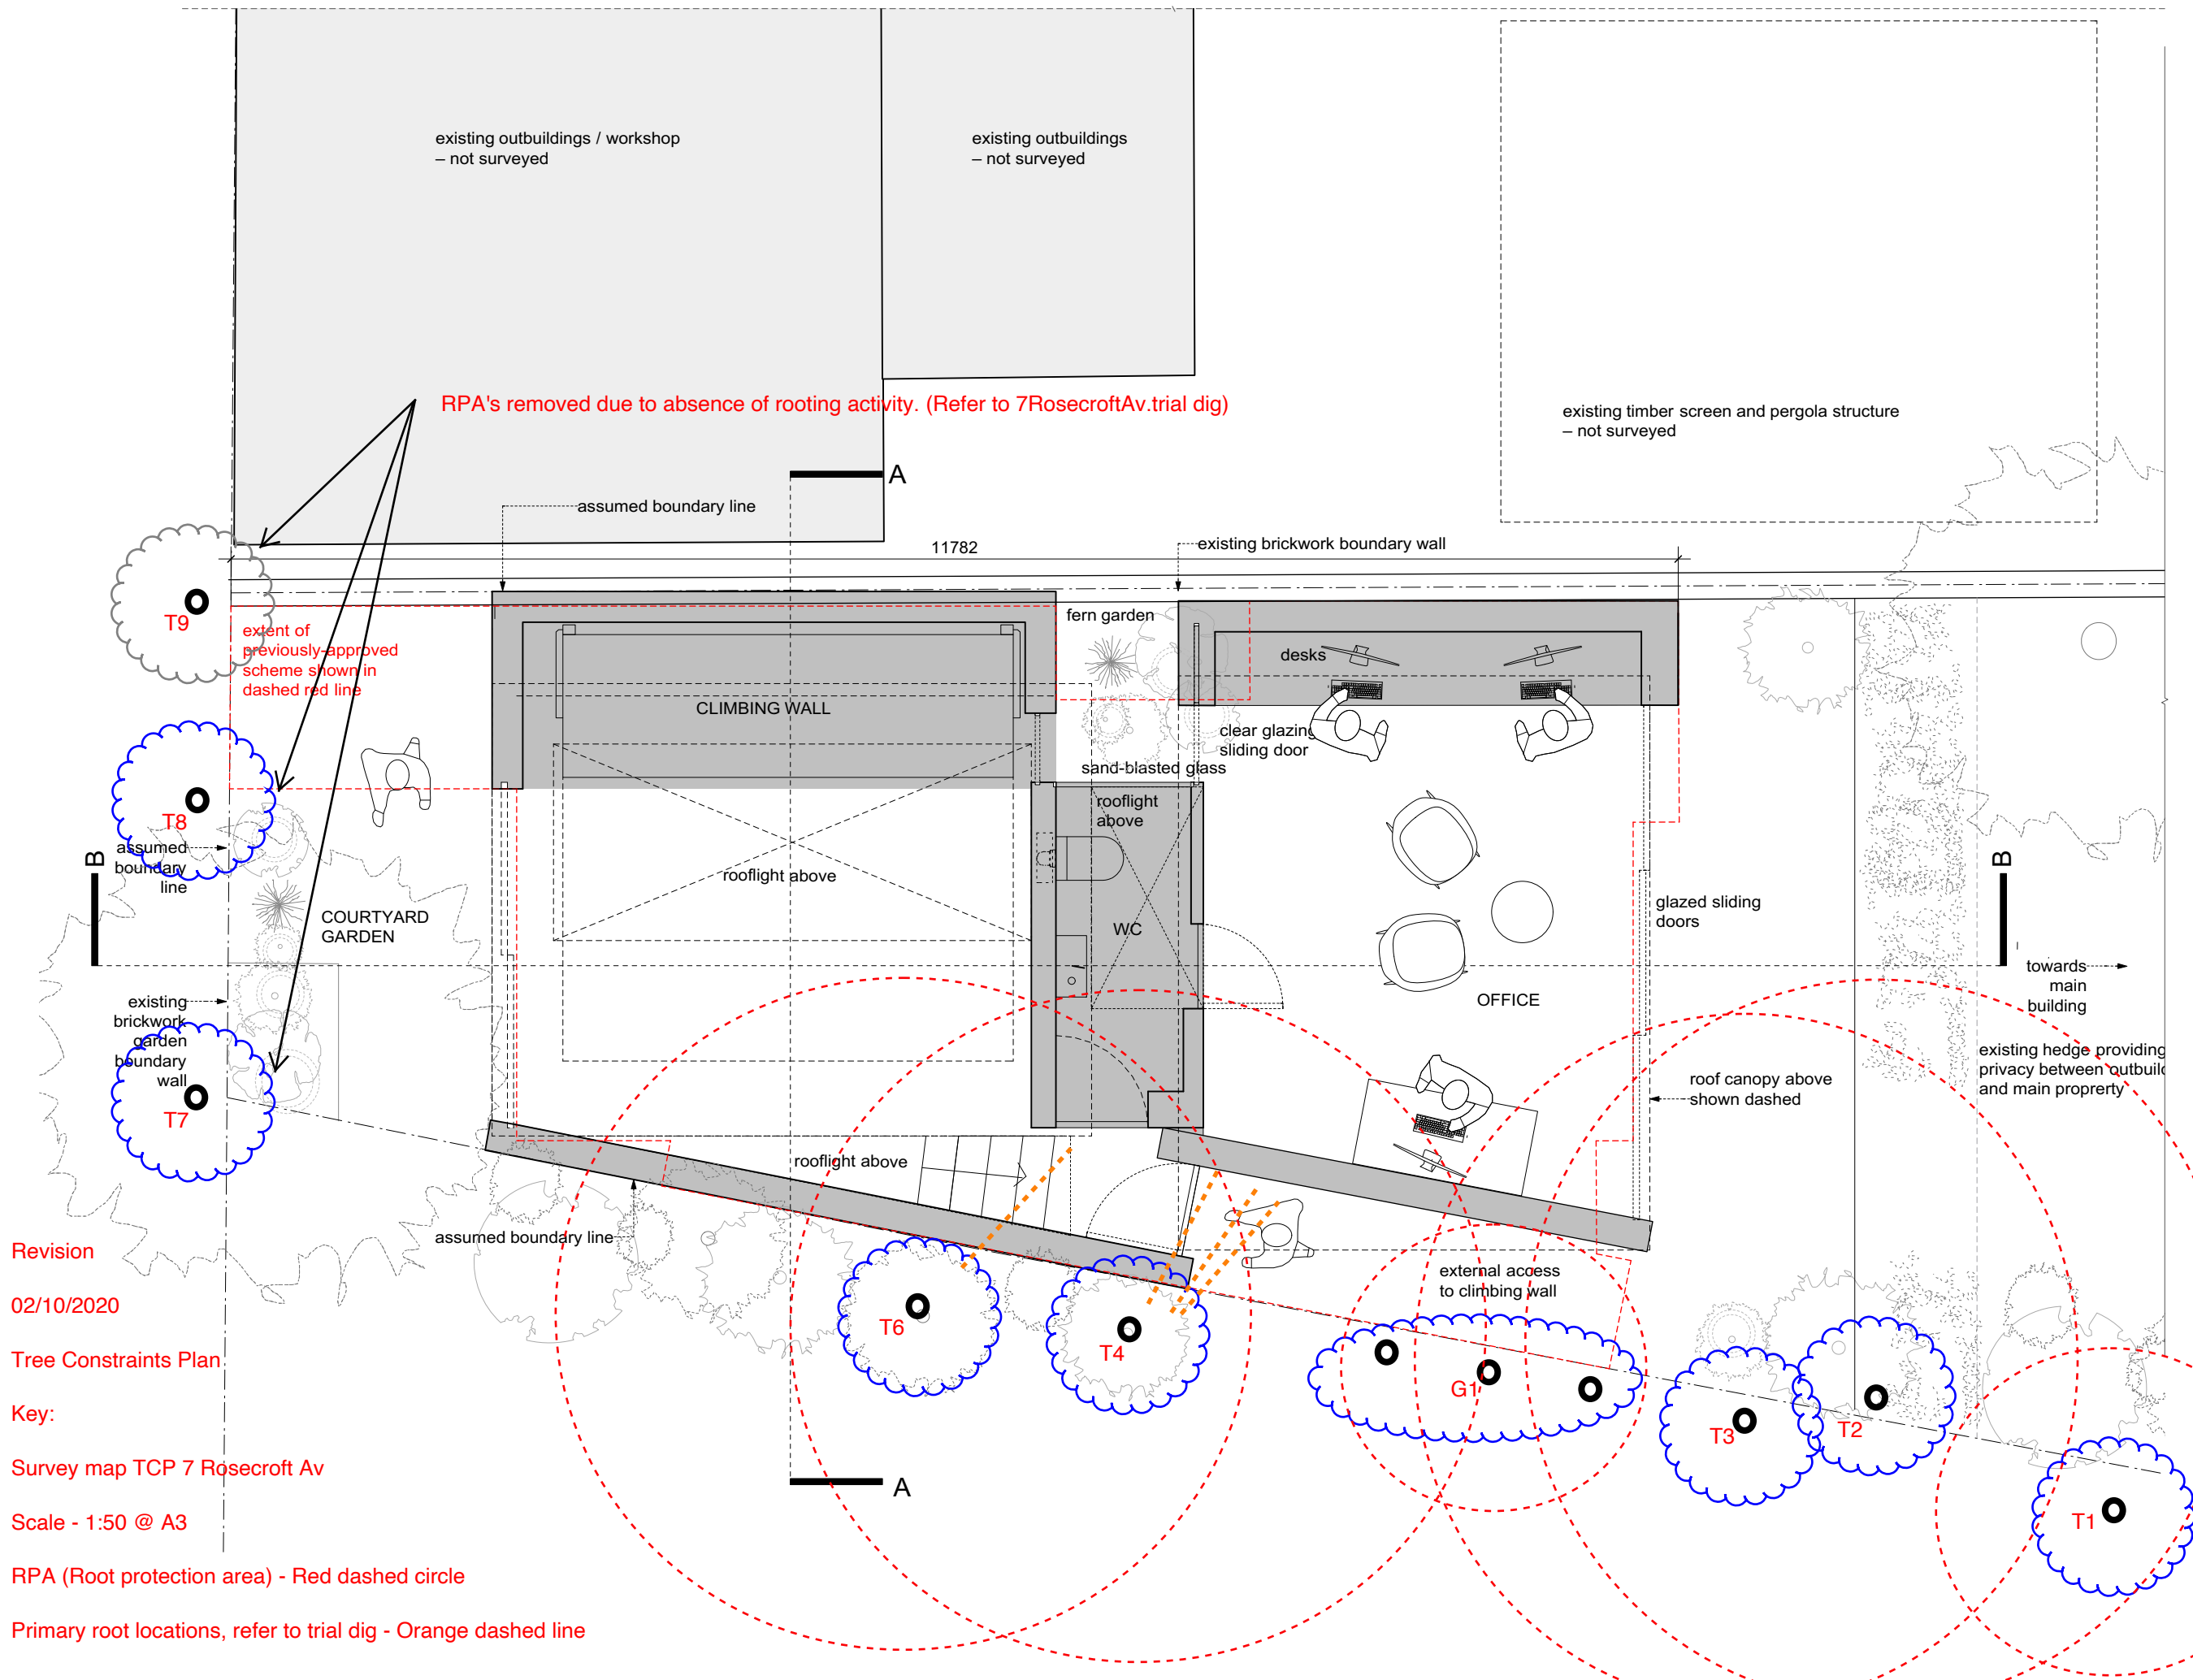

RPA's removed due to absence of rooting activity. (Refer to 7RosecroftAv.trial dig)

extent of previously-approved scheme shown in dashed red line

Revision
02/10/2020
Tree Constraints Plan
Key:
Survey map TCP 7 Rosecroft Av
Scale - 1:50 @ A3

RPA (Root protection area) - Red dashed circle
Primary root locations, refer to trial dig - Orange dashed line