

APPENDIX 01

Appendix 1: 1930s plans


RUSSELL
SQUARE



THE ROYAL HOTEL

TAVISTOCK
SQUARE

PLAN 102264

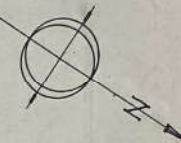

WO B U R N P L A C E

HOTEL
RUSSELL

PROPOSED GARAGE

DRAWING (/) APPROVED

(Sd.) G. TOPHAM FORREST,

Superintending Architect.

B.A.C.

9
12
30

PROPOSED GARAGE
HERBRAND STREET W.C.1
FOR DAIMLER HIRE LTD
KEY PLAN OF SITE
SCALE: 1/625 OR 33'0" TO 1"

DRWG. NO 1093-10


DATE 30-9-30

WALLIS GILBERT & PARTNERS
ARCHITECTS
29 ROLAND GONS. S.W.

ARCHITECTS DEPT.
304231-00061

DR. W. H. S. (H) APPROVED
(B) H. G. TUPHAM FORRETT,
8 JUL 1933

3

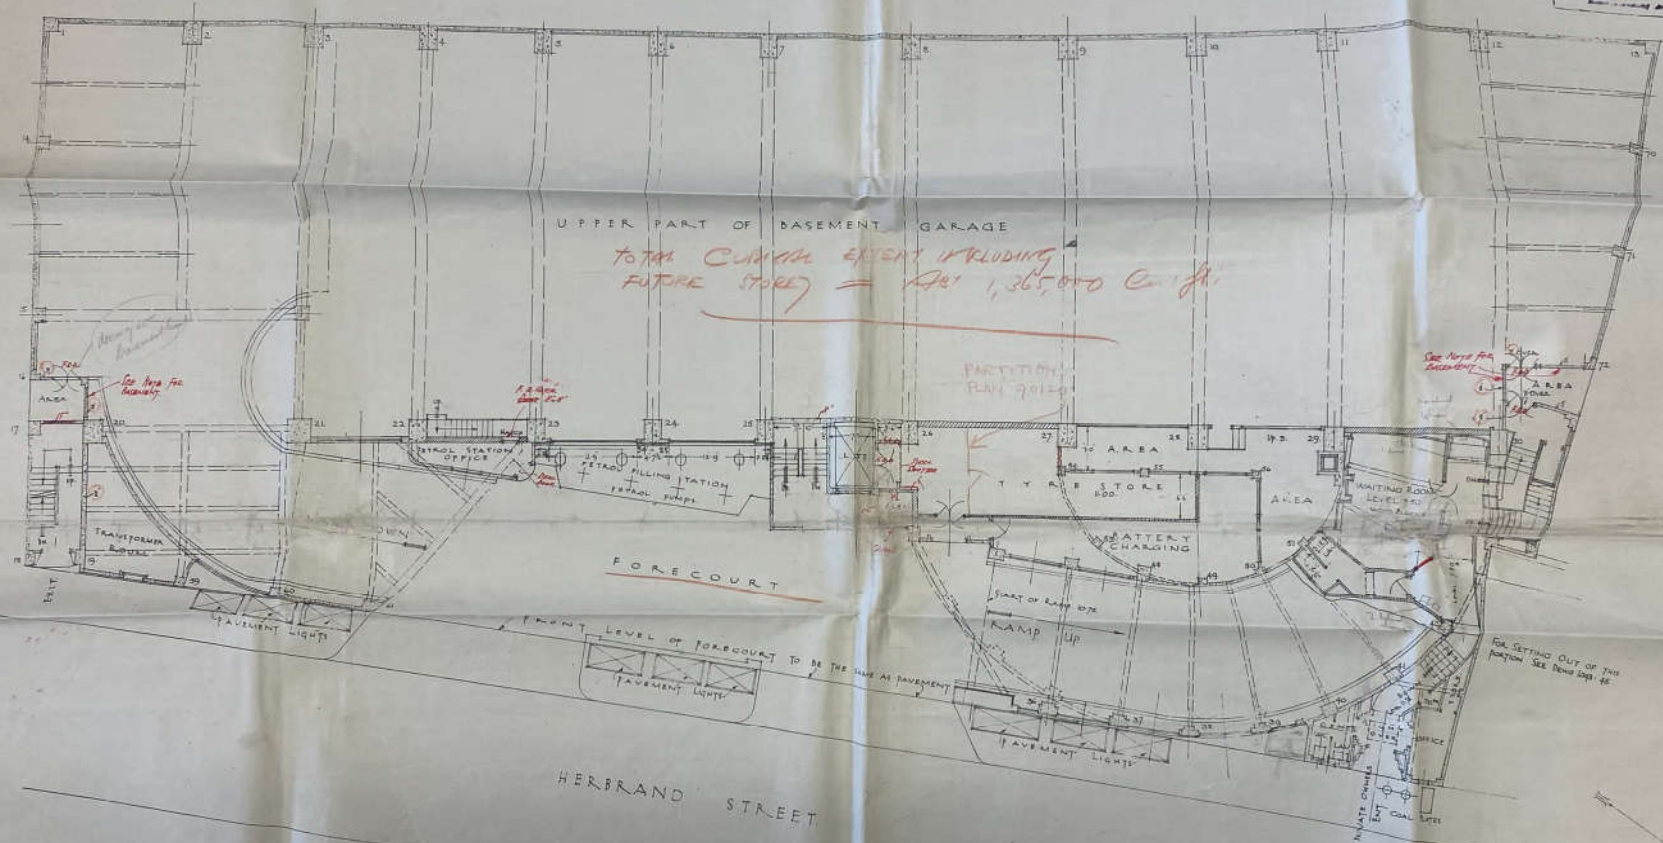

PLAN AT ROAD LEVEL

SCALE: EIGHT FEET TO AN INCH

Notes added in red ink by
WALLIS GILBERT & PARTNERS
16.25
21st May 1933

PROPOSED GARAGE HERBRAND ST. WC1 FOR DAIMLER HIRE LTD


DRAWING NO 1003-3
DATE: NOV 23 1933

WALLIS GILBERT & PARTNERS
CHARTERED ARCHITECTS
29 ROLAND GARDENS SW7

ARCHITECTS DEPT
304731-23061

DRAWINGS (//) APPROVED B.A.C.
(B.A.) & TOPHAM FORREST.
8 JUL 1930

2

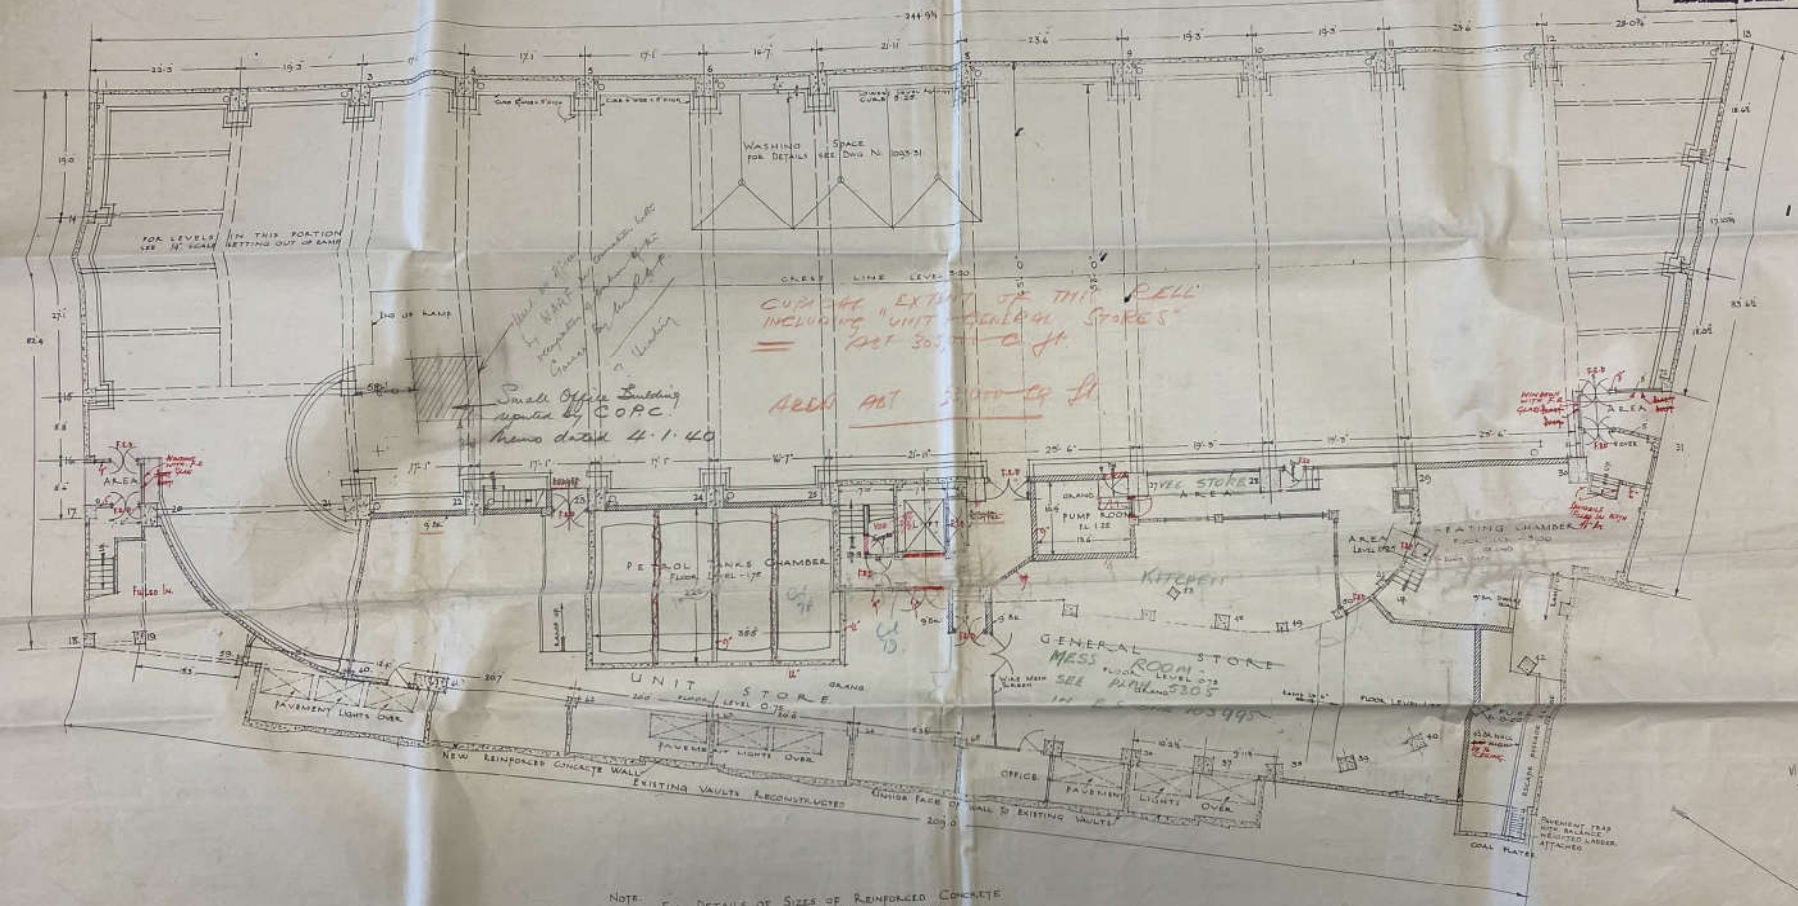

NOTE:
FOR DETAILS OF SIZES OF REINFORCED CONCRETE
SEE THICKENED CONCRETE STEEL CO. DRAWINGS
FOR DRAINAGE DETAILS SEE DRG. NO. 1095 23

See how Notes and
on main floor
21.1.1930

BASEMENT PLAN

SCALE: EIGHT FEET TO AN INCH


HER BRAND ST. WCI FOR DAIMLER HIRE LTD

DRAWING NO 1095-14
DATE NOV 25th 1930

WALLIS GILBERT & PARTNERS
CHARTERED ARCHITECTS
29 ROLAND GARDENS SW7

ARCHITECTS DEPT
304731-29661

DRAWINGS (11) APPROVED B.A.G.
(SHEET) G. TOPHAM FORRESTER.
20 JUL 1931

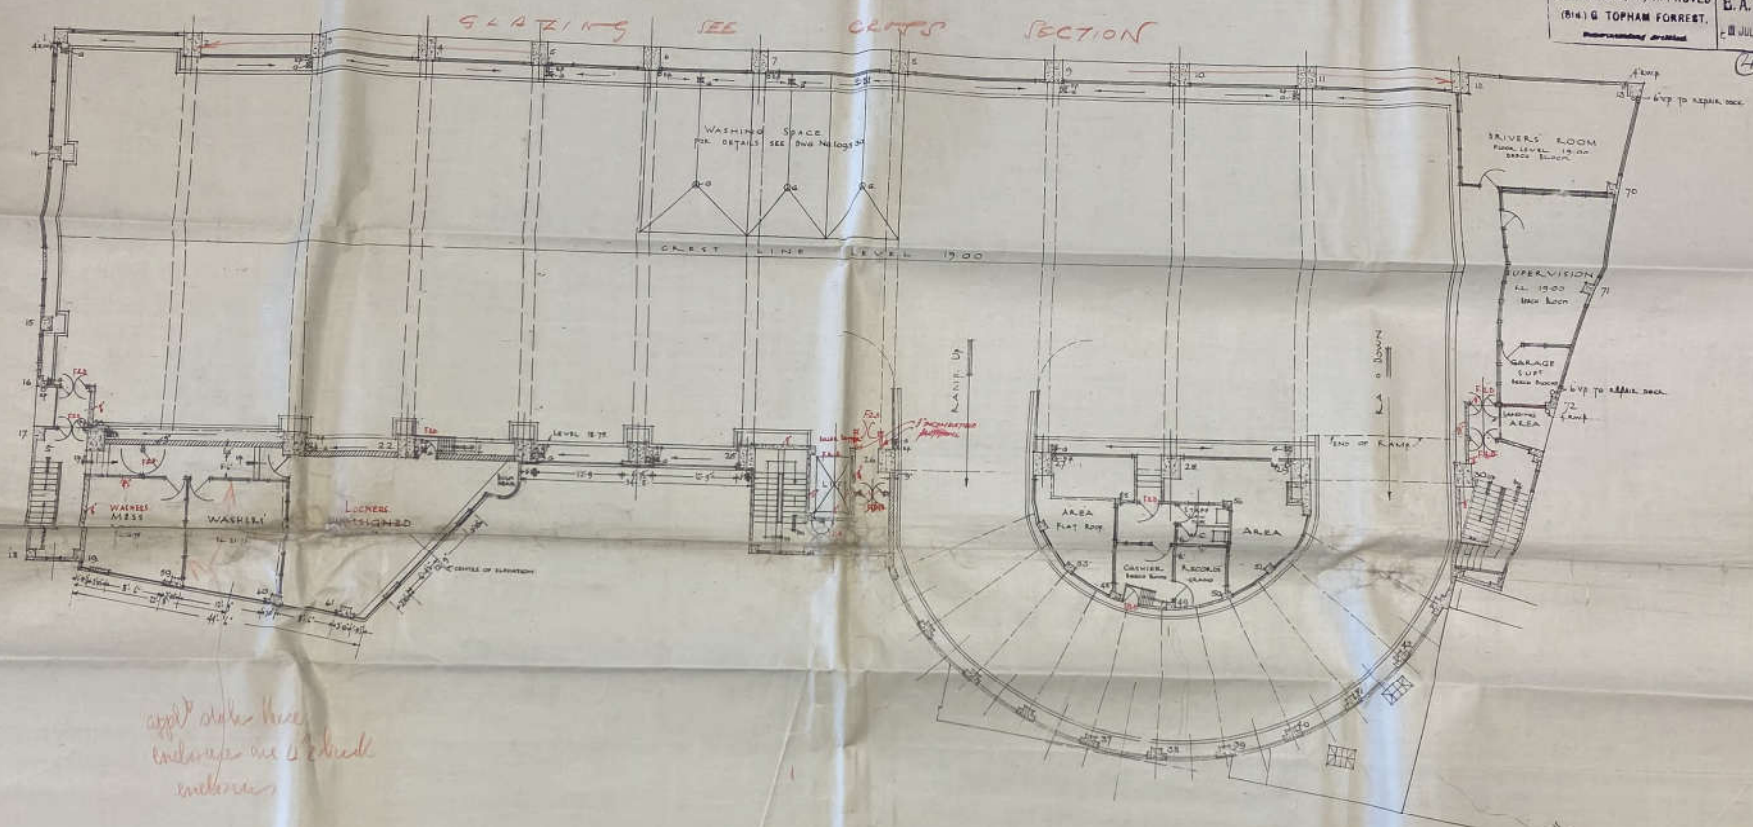

*appt. stairs three
enclosures are 6' x 6' and
measures*

GROUND FLOOR PLAN
SCALE: EIGHT FEET EQUALS ONE INCH

*See the Notes added by
WALLS GILBERT & PARTNERS
20 May 1931*


NO.	REVISION

PROPOSED GARAGE HERBRAND ST WCI FOR DAIMLER HIRE LTD


DRAWING NO 1095-19
DATE: 12 DEC 1930

WALLS GILBERT & PARTNERS
CHARTERED ARCHITECTS
29 ROLAND GARDENS SW7

LEVEL OF 25' 0" ABOVE
PAVEMENT IN
HERBRAND STREET.

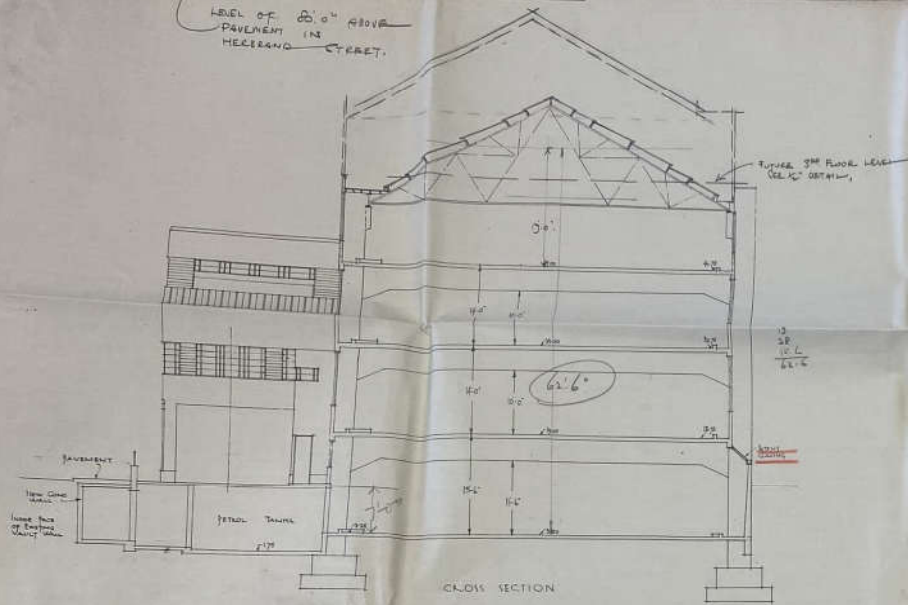


CROSS SECTION

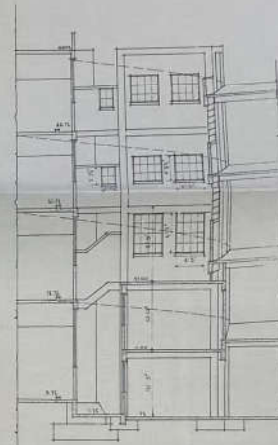


CROSS SECTION THRO' RAMP AREA LOOKING NORTH



CROSS SECTION THRO' RAMP AREA LOOKING SOUTH

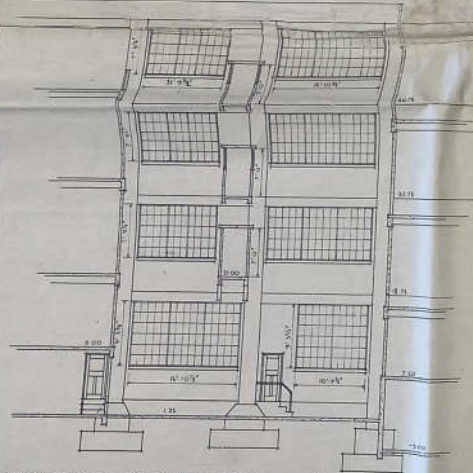

CROSS SECTION THRO' RAMP AREA LOOKING WEST

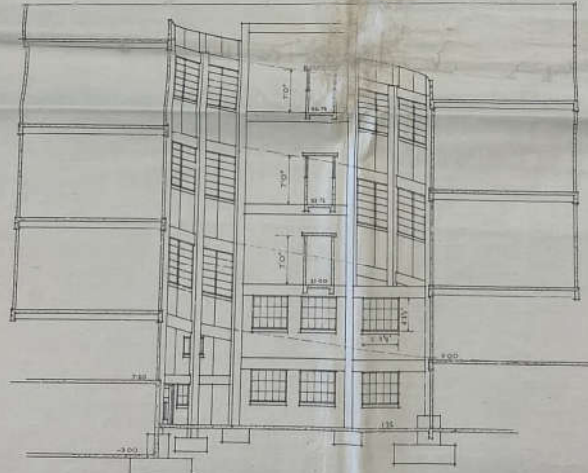

CROSS SECTION THRO' RAMP AREA LOOKING EAST

ARCHITECTS DEPT
208F21-20861

DRAWN BY (H) APPROVED
W. G. LOPHAM FORRESTER
8 JUL 1930


8

PROPOSED GARAGE HERBRAND ST. WC1 FOR DAIMLER HIRE LTD

SCALE EIGHT FEET TO AN INCH

DRAWING NO 1095-22
DATE DEC 15TH 1930


WALLIS GILBERT & PARTNERS
CHARTERED ARCHITECTS
29 ADOLPH WATKINS ST.

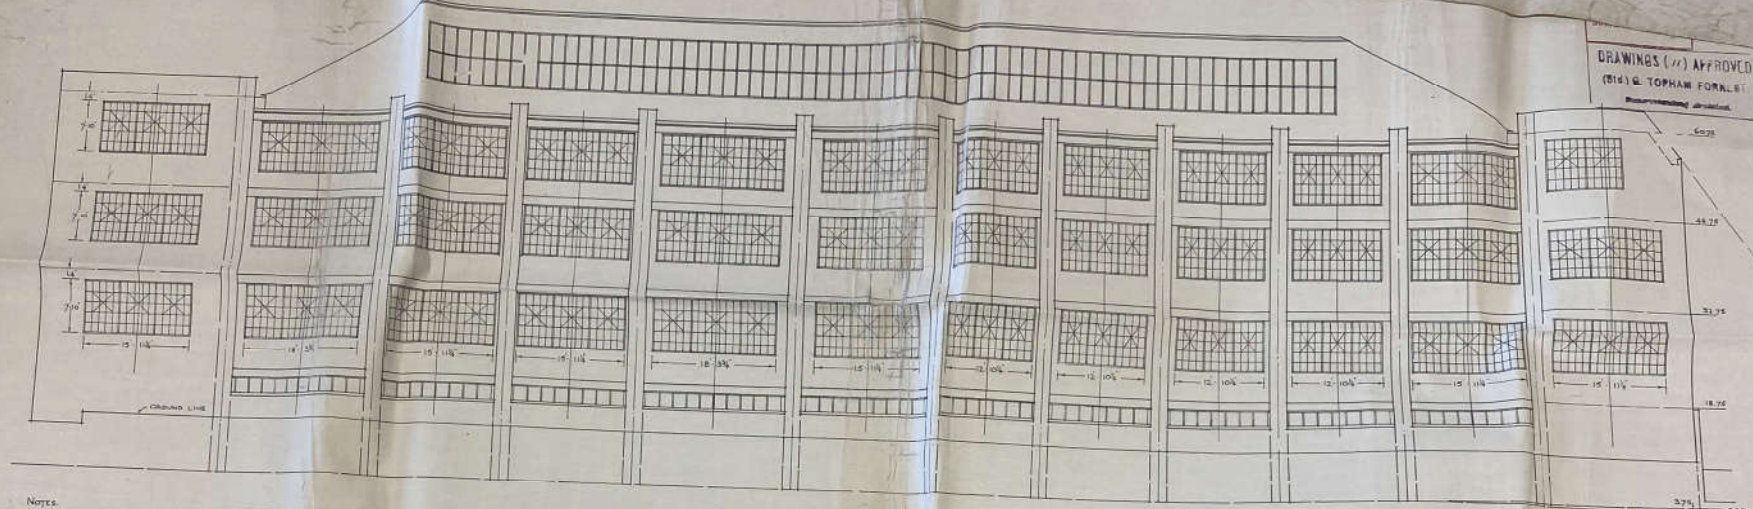


DRAWINGS (11) APPROVED
 (B14) & TOPHAM FOR LET
 8 JUL 1933

NOTES:
 ALL OPENING LIGHTS & HUBBLES WITH BOX CHIEFS
 WINDOWS COLOURED PINK TO HAVE OBSCURE GLASS

WEST ELEVATION

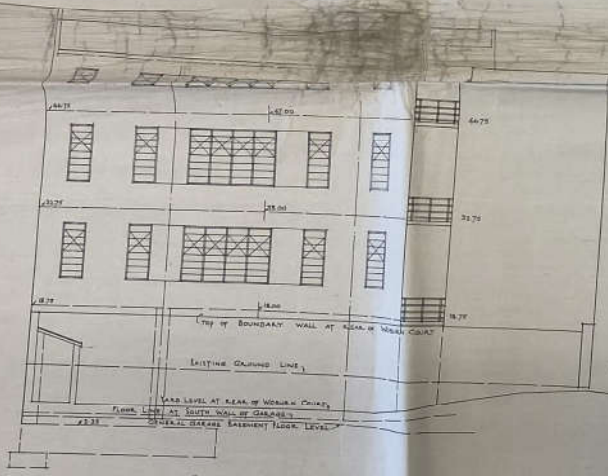

SOUTH ELEVATION

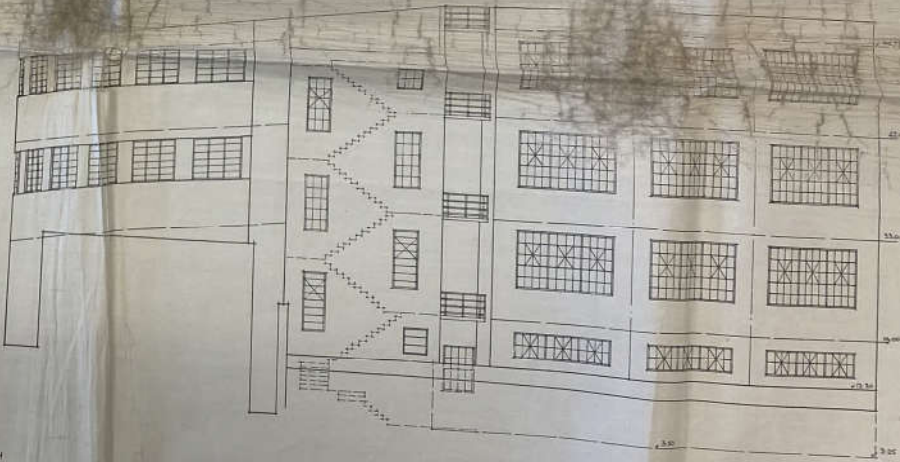

NORTH ELEVATION

SCALE: EIGHT FEET TO 1 INCH

PROPOSED GARAGE HERBRAND ST. WC1 FOR DAIMLER HIRE LTD


DRAWING No 1093-28
 DATE 15 DEC. 1930

WALLIS GILBERT & PARTNERS
 CHARTERED ARCHITECTS
 29 ADLAND GARDENS SW7

ARCHITECTS DEPT
3047331-25666

DRAWING(S) APPROVED B.A.C.
BY H. G. TOPHAM FORRESTER
8 JUL 1930

(10)

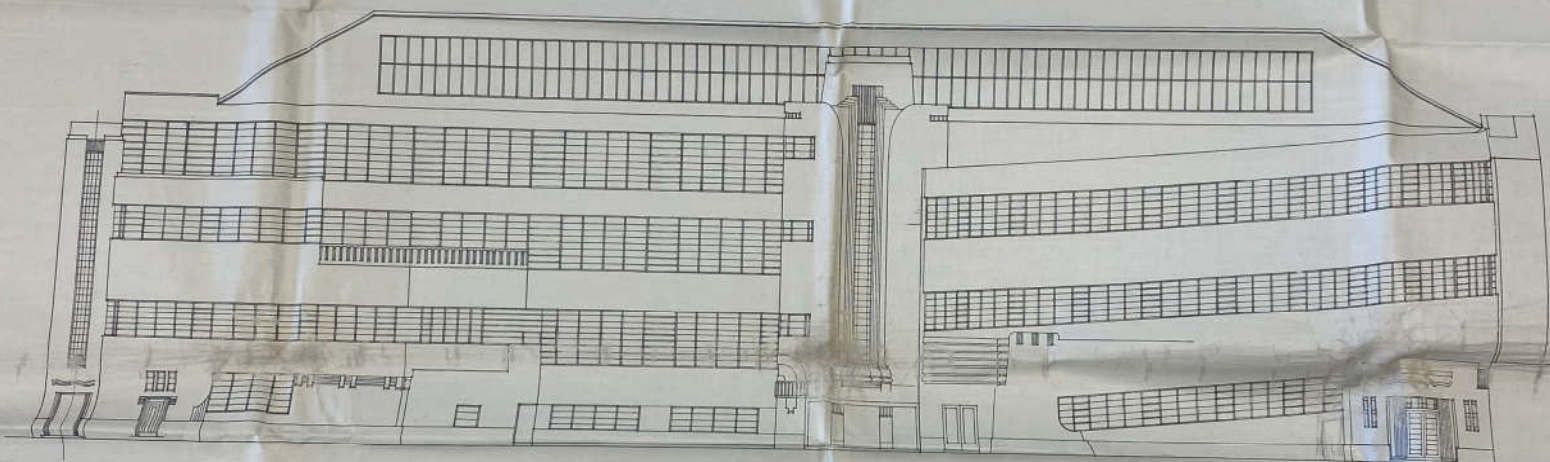

ELEVATION TO HERBRAND STREET

SCALE: EIGHT FEET TO ONE INCH

PROPOSED GARAGE HERBRAND ST. W.C. FOR DAIMLER HIRE LTD

DRAWING NO 1095-19
DATE 16th DEC 1930

WALLIS GILBERT & PARTNERS
CHARTERED ARCHITECTS
29 ADOLPH WATKINS GARDENS SW7