


Plan as Proposed  
Scale 1:50

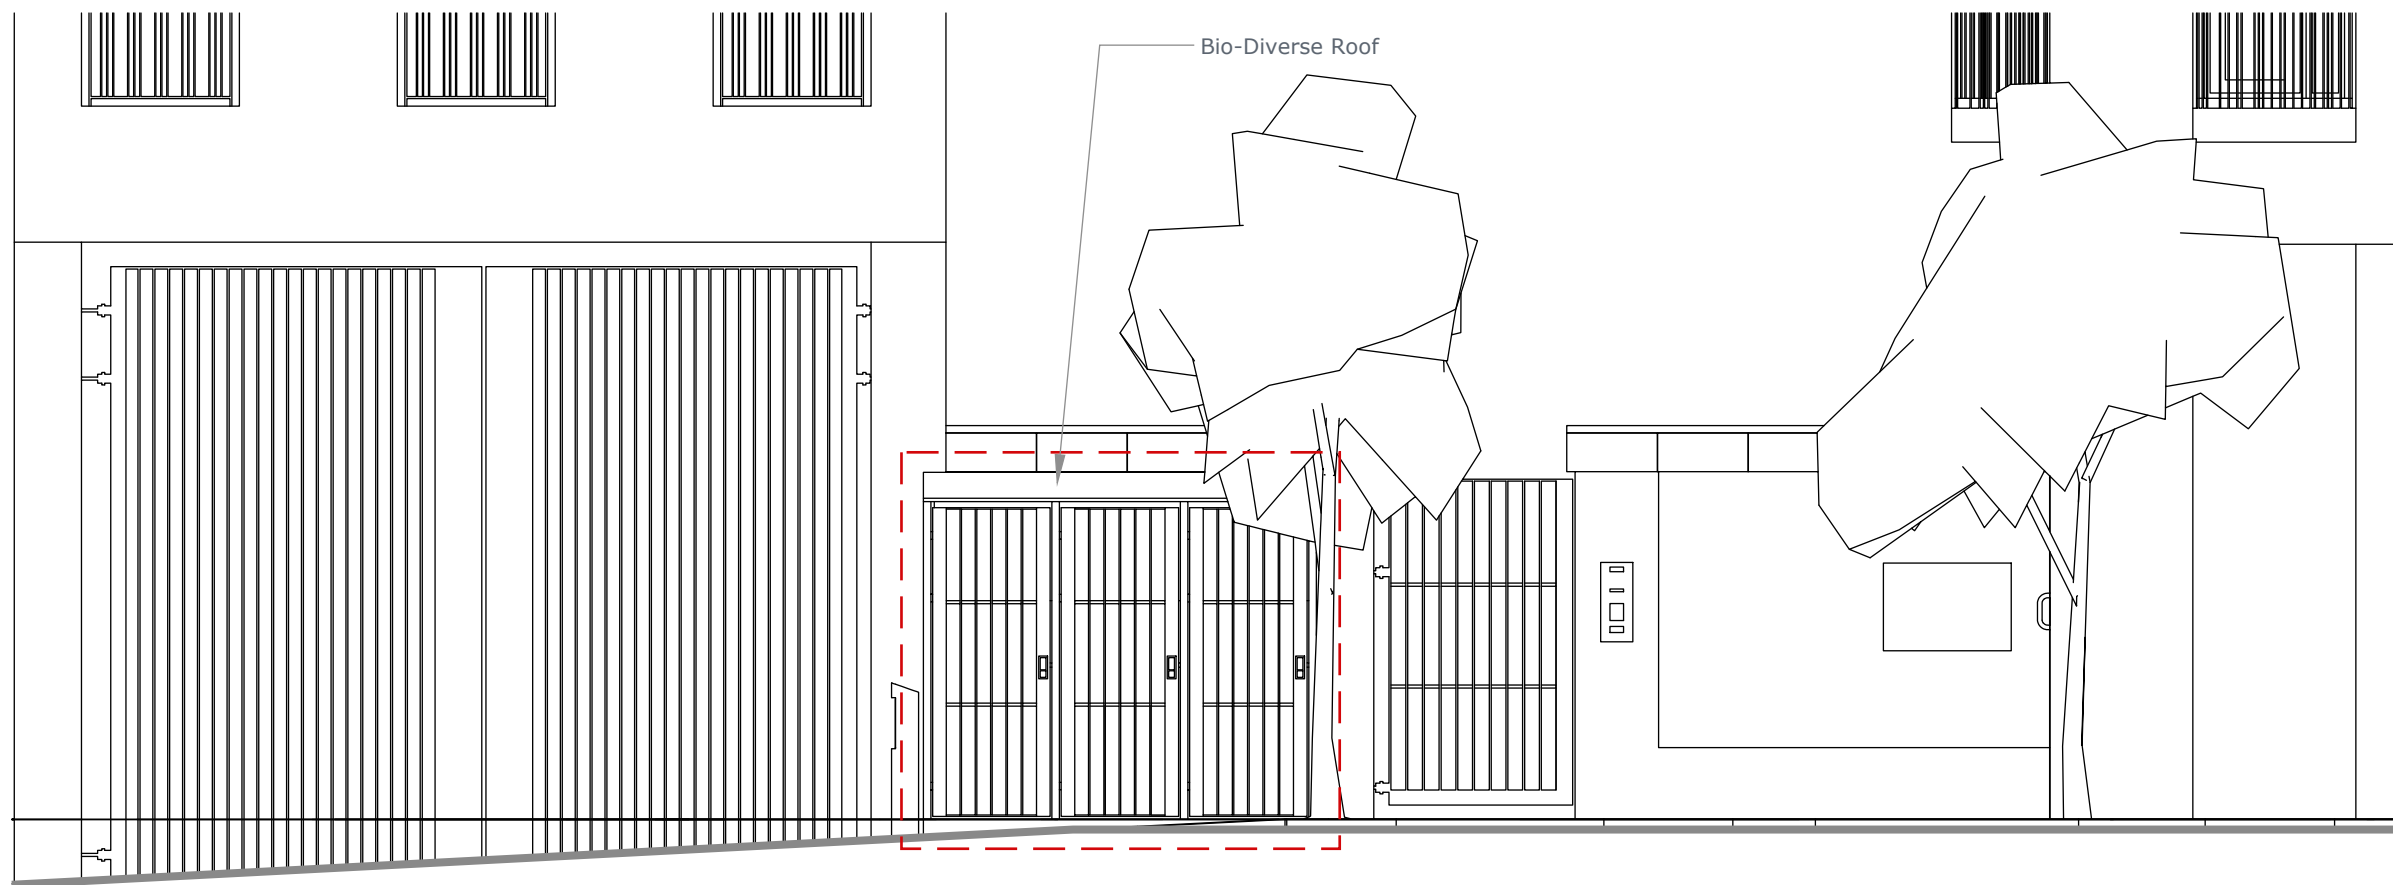


Front Elevation as Proposed  
Scale 1:50

This drawing and the copyrights and patents therein are the property of JPM Drafting and may not be used or reproduced without consent.

This drawing is to be read in conjunction with all relevant consultants and/or specialist's drawings/documents and any discrepancies or variations are to be notified to JPM Drafting before the affected work commences.

A3

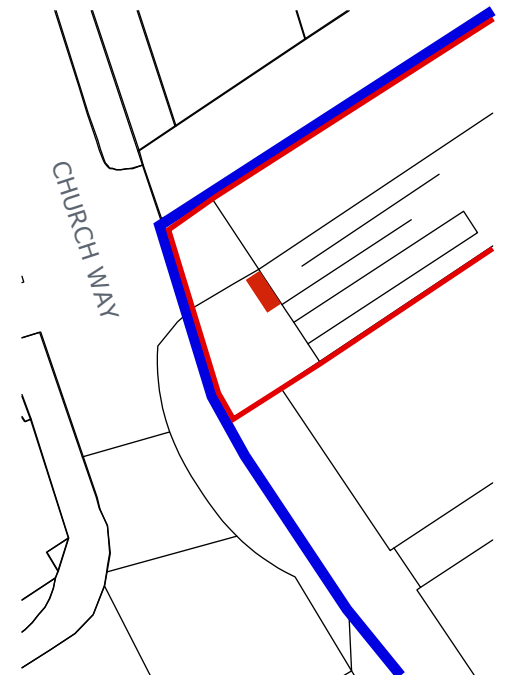

Location Plan  
Scale 1:500  
Revision

A: Red line added to denote 22-34 Churchway, blue line showing extent of ownership by applicant.  
B: Bio-diverse roof to bin store

**JPM**  
DRAFTING

Oaklands  
London Road  
Battle  
East Sussex  
TN33 0LS  
07581 204 580

Client.  
Unison Centre

Address.  
Unison Centre  
130 Euston Road  
London  
NW1 2AY

Project.  
Residential Bin Store

Title.  
Plan & Front Elevation  
As Proposed

Purpose of Issue.  
**PLANNING**

Scale.	D	C	Date.
1:50@A3	JPM	BC	19/10/2020

Job No.	Drawing No.	Revision.
56008	PL 09.02	B