


North Elevation as Proposed
Scale 1:50




South Elevation as Proposed
Scale 1:50

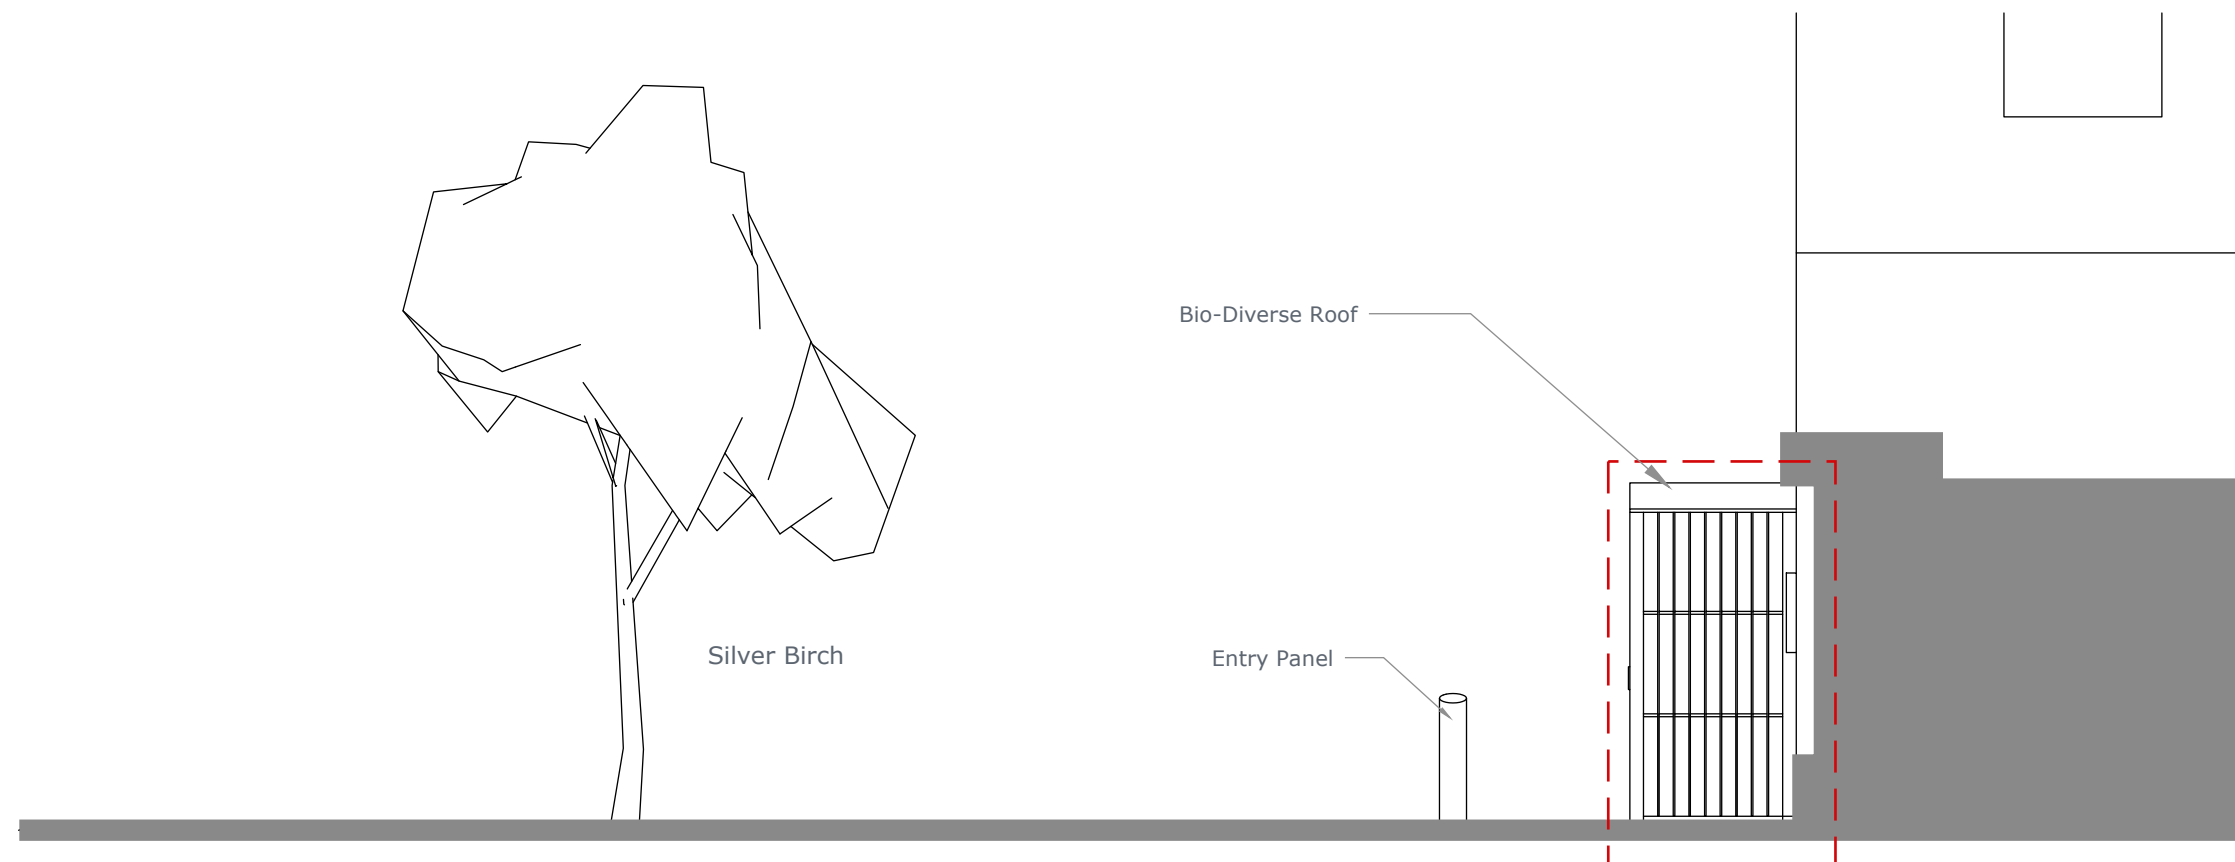

This drawing and the copyrights and patents therein are the property of JPM Drafting and may not be used or reproduced without consent.

This drawing is to be read in conjunction with all relevant consultants and/or specialist's drawings/documents and any discrepancies or variations are to be notified to JPM Drafting before the affected work commences.

A3

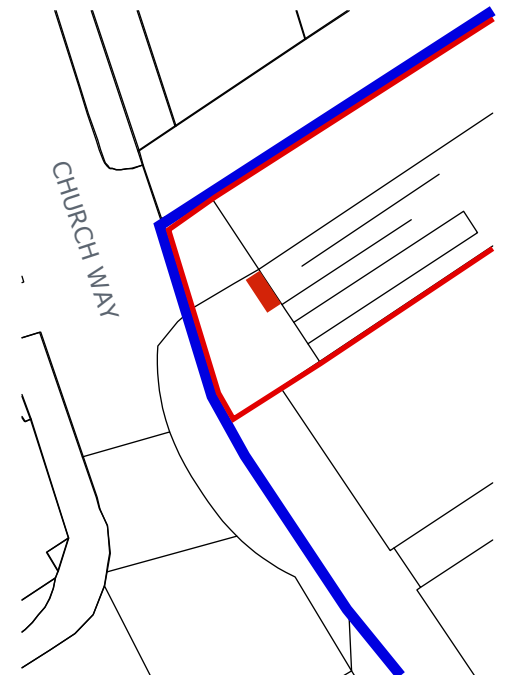

Location Plan
Scale 1:500
Revision

A: Red line added to denote 22-34 Churchway, blue line showing extent of ownership by applicant.
B: Bio-diverse roof to bin store

JPM
DRAFTING

Oaklands
London Road
Battle
East Sussex
TN33 0LS
07581 204 580

Client.
Unison Centre

Address.
Unison Centre
130 Euston Road
London
NW1 2AY

Project.
Residential Bin Store

Title.
Side Elevations
As Proposed

Purpose of Issue.
PLANNING

| Scale. | D | C | Date. |
|---------|-----|----|------------|
| 1:50@A3 | JPM | BC | 19/10/2020 |

| Job No. | Drawing No. | Revision. |
|---------|-------------|-----------|
| 56008 | PL 10.01 | B |