


AS BUILT LOWER GROUND FLOOR PLAN

Scale Meters

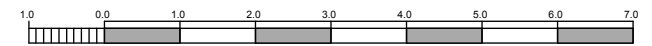

UNDERCOVER ARCHITECTURE LTD	The Studio 48 Mornington Terrace, NW1 7RT T: +44 20 7388 7698 E: info@undercoverarchitecture.com	PROJECT TITLE	48 MORNINGTON TERRACE LONDON, NW1 7RT	DATE	SEPTEMBER 2020	DRAWING TITLE	AS BUILT LOWER GROUND FLOOR	REVISION	AS BUILT	This drawing is the copyright of Undercover Architecture Ltd and may not be copied, altered or reproduced in anyway or passed to a third party without written authority. All dimensions are subject to site survey and site verification. Do not scale.
		CLIENT	UNDERCOVER ARCHITECTURE LTD	SCALE	1:100 @ A3	DRAWING N.	AS 101			