
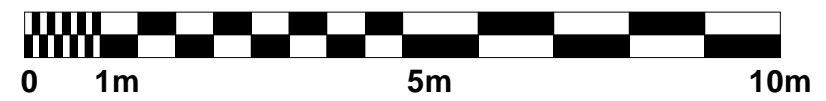


Gross Internal Floor Area :- 108.92 m²

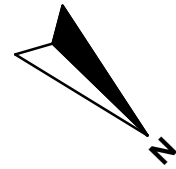

Please note that all dimensions must be checked on site and not scaled off this drawing
 File Ref: 1236 - BA - Plans 2.pln

NOTES.

Preliminary	
Planning	■
Building Regs.	
Tender	
Construction	
As-built	■

Rev	Date	Description
A	09-11-20	Unit 3 Internal layout surveyed.

© Copyright

ARCHITECTS
DONALD SHEARER
 CHARTERED ARCHITECTS

Scholar's House, Shotton Brook Office Park, Timothy's Bridge Road, Stratford-upon-Avon, Warwickshire, CV37 9NR
 Tel: 01789 294 560
 ds-architects@hotmail.co.uk

Project	Unit 3, Regis Road	Reference Number	1236-BA-102 A	
Client	Mr. A. Sharpe	Date	Jan 16	Scale 1:100
Drawing	Existing First Floor Plan			
		Drawing size	A3	