
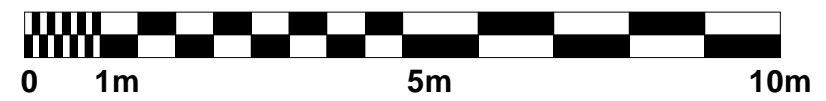


Gross Internal Floor Area  
 :- 108.92 m<sup>2</sup>

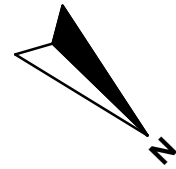

Please note that all dimensions must be checked on site and not scaled off this drawing  
 File Ref: 1236 - BA - Plans 2.pln

NOTES.

Preliminary	
Planning	■
Building Regs.	
Tender	
Construction	
As-built	■

Rev	Date	Description
A	09-11-20	Unit 3 Internal layout surveyed.

© Copyright

**DONALD SHEARER**  
 CHARTERED ARCHITECTS

Scholar's House, Shotton Brook Office Park,  
 Timothy's Bridge Road, Stratford-upon-Avon,  
 Warwickshire, CV37 9NR  
 Tel: 01799 294 560  
 ds-architects@hotmail.co.uk

Project	Unit 3, Regis Road	Reference Number	1236-BA-101 A				
Client	Mr. A. Sharpe	Date	Jan 16	Scale	1:100	Drawing size	A3
Drawing	Existing Ground Floor Plan						