


Materials Key:

- | | | | | |
|---|---|---|--|---|
| 01 Existing Clay Tiles | 07 Existing Cast Stone Urn | 13 Existing Painted Timber Facia | 19 Existing Decorative Metal screen with Louvre behind, screen re hung to allow removal for louvre access behind | 25 Existing decorative metal screen adjusted to match right hand side, screen re hung to allow removal for louvre access behind |
| 02 Existing lead ridge Flashing | 08 Existing Lead Clad Dormers | 14 Existing Solid Panelled Timber Entrance Door | 20 Existing Cast Stone Step | 26 New Solid Panelled Timber Double Entrance Door Painted gloss Black |
| 03 Existing Brickwork | 09 Existing Cast Stone Sill | 15 Existing Decorative Glazed Light above Door | 21 Existing Clay Chimney Pot | |
| 04 Existing Expressed Brick Panels | 10 Lead Clad Coping | 16 Existing Decorative Painted Timber Moulding | 22 Existing Access Control Panel | |
| 05 Existing Window Type 01 - Timber Framed Sash Windows | 11 Existing Contrasting Flush Brickwork | 17 Existing Decorative Painted Timber Pillaster | 23 Steel Kick Plate | |
| 06 Existing Window Type 02 - Timber framed windows | 12 Lead Flashing | 18 Existing Steel Balustrade | 24 New Access Control Panel Mounted at Lower Level | |

C3M Studio Mark Up - 24.11.20 - 072020_SK_PR_301

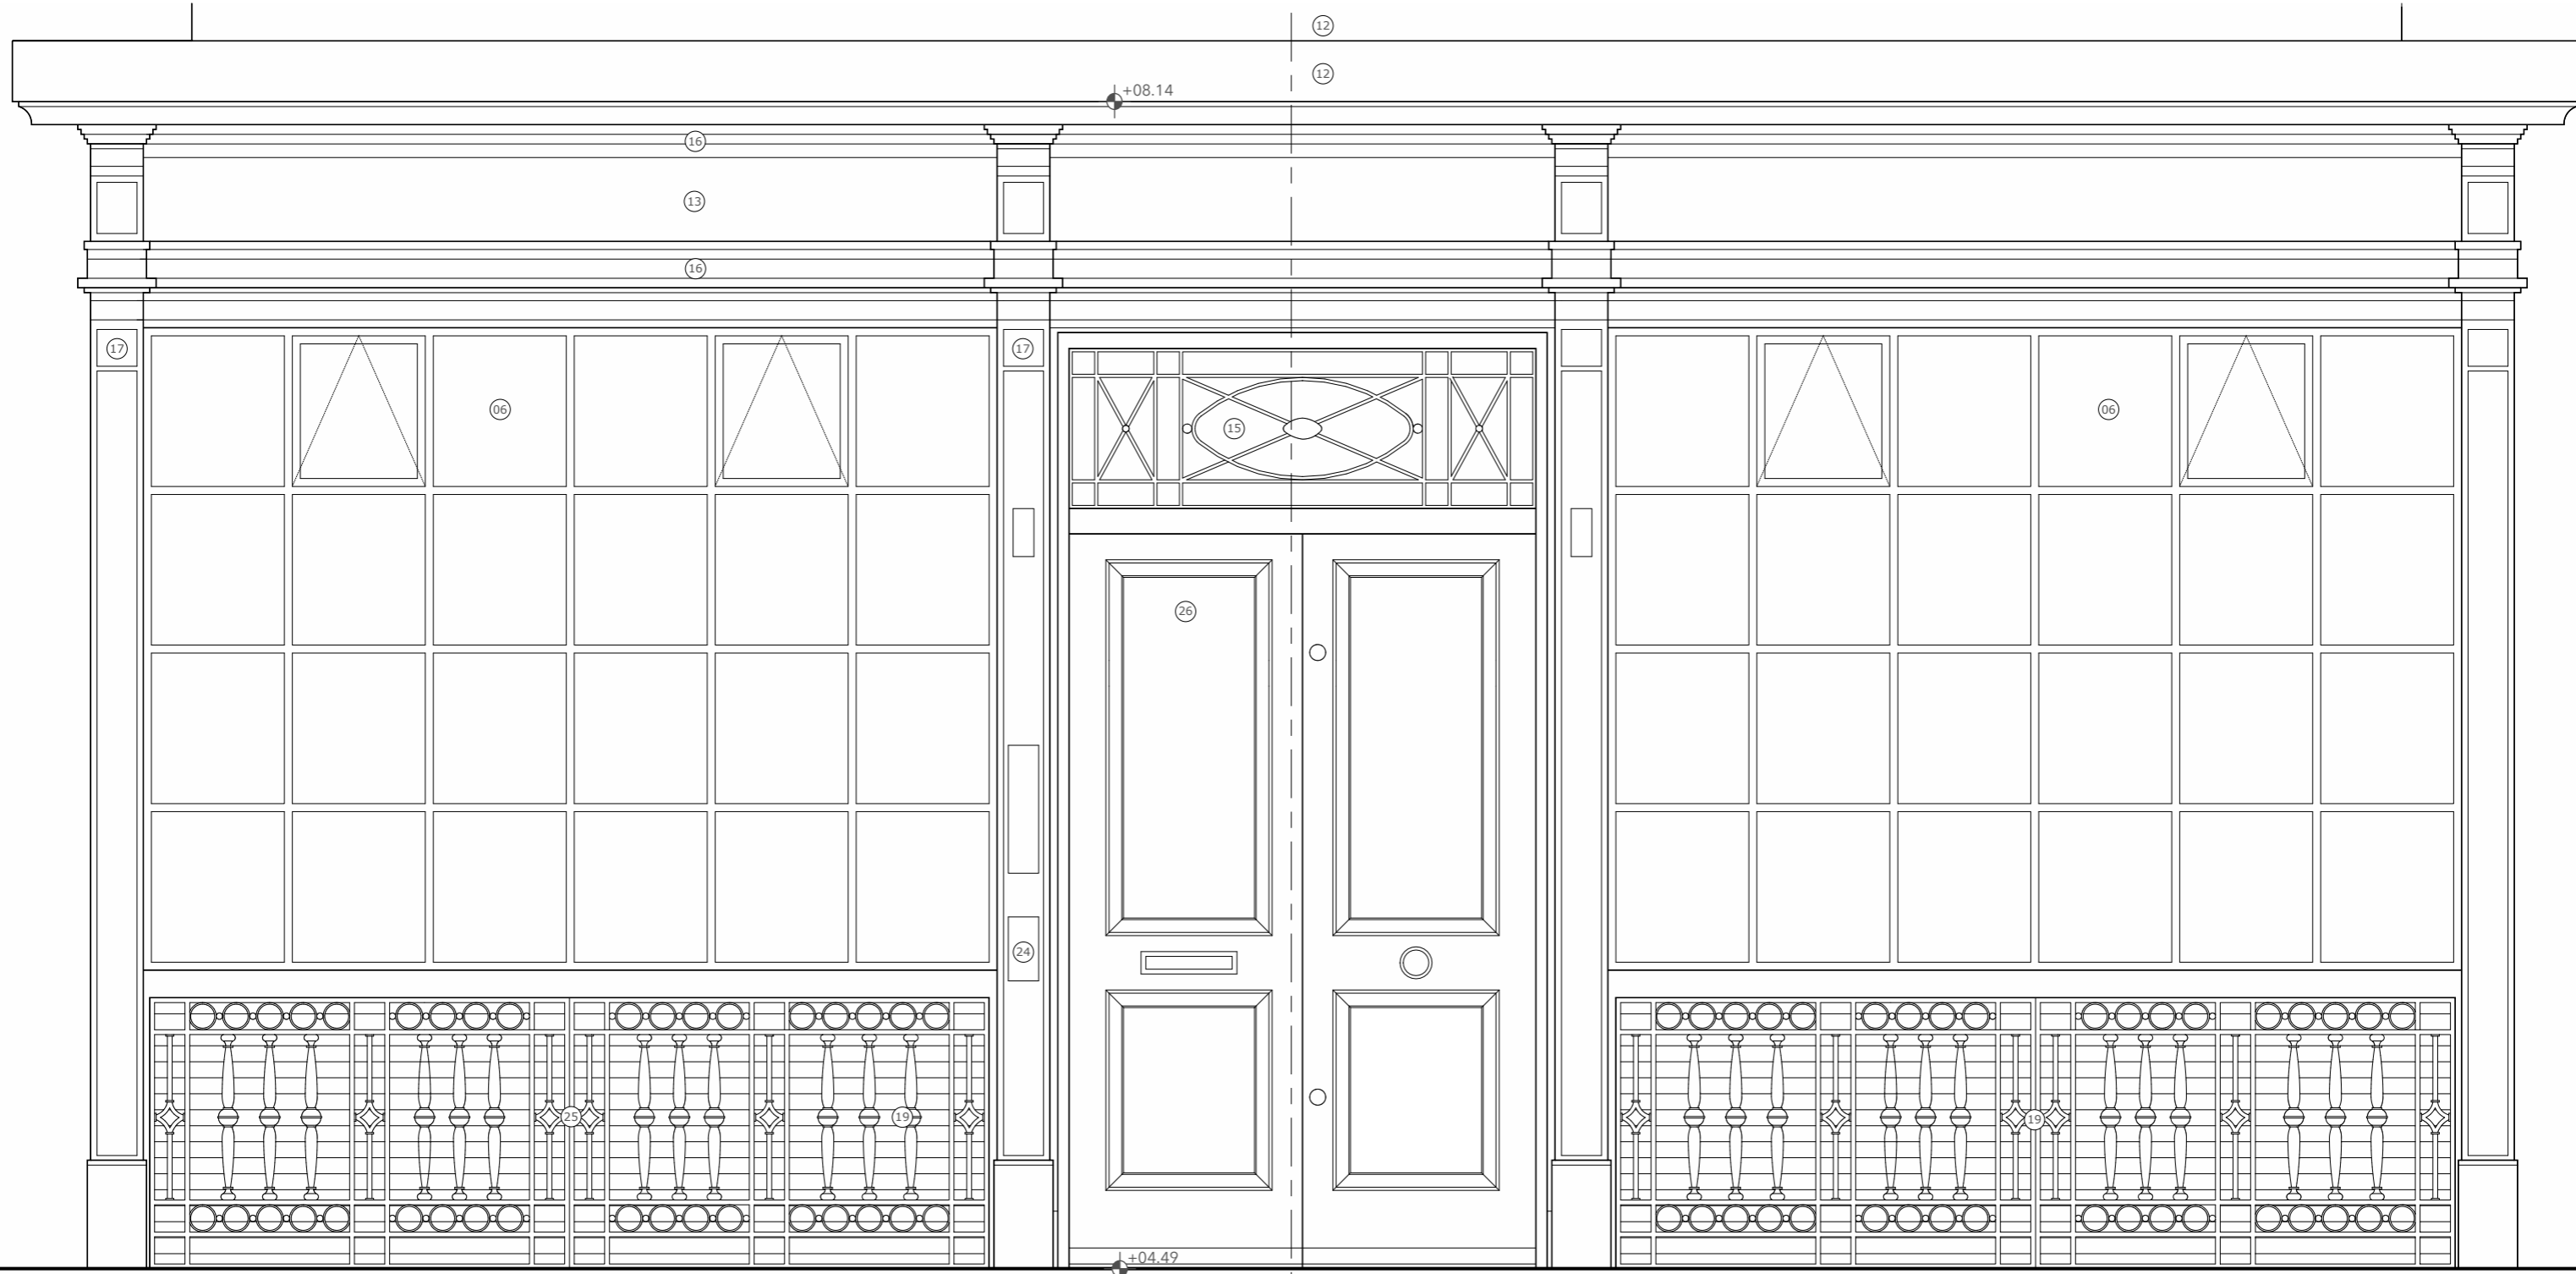

+21.110 Spot Levels



C3M STUDIO

CONSULTANTS:

CLIENT:

PROJECT:

Notes:
Do not scale from this drawing except via scale bar.
For planning purposes only.
Check all dimensions on site before fabrication or setting out.
This document is copyright and may not be reproduced without permission.

Revision	Reason For Issue	Date
A	Issued For Planning Submission	August 2020
B	Issued For Planning Submission	September 2020

REF: 072020_PL_PR_301

Architecture // Branding // Concept // Design // Interiors

Soho Housing

18 Hanway Street

Drawing Name: **Proposed Drawing**

mail // c3m_studio@me.com
mobile // 020 8289 2315
www // c3mstudio.com

LONDON, W1T 1UF

Drawing Description: **Ground Floor Elevation**

Scale: **1:20 @ A3 1:40 @ A1**