

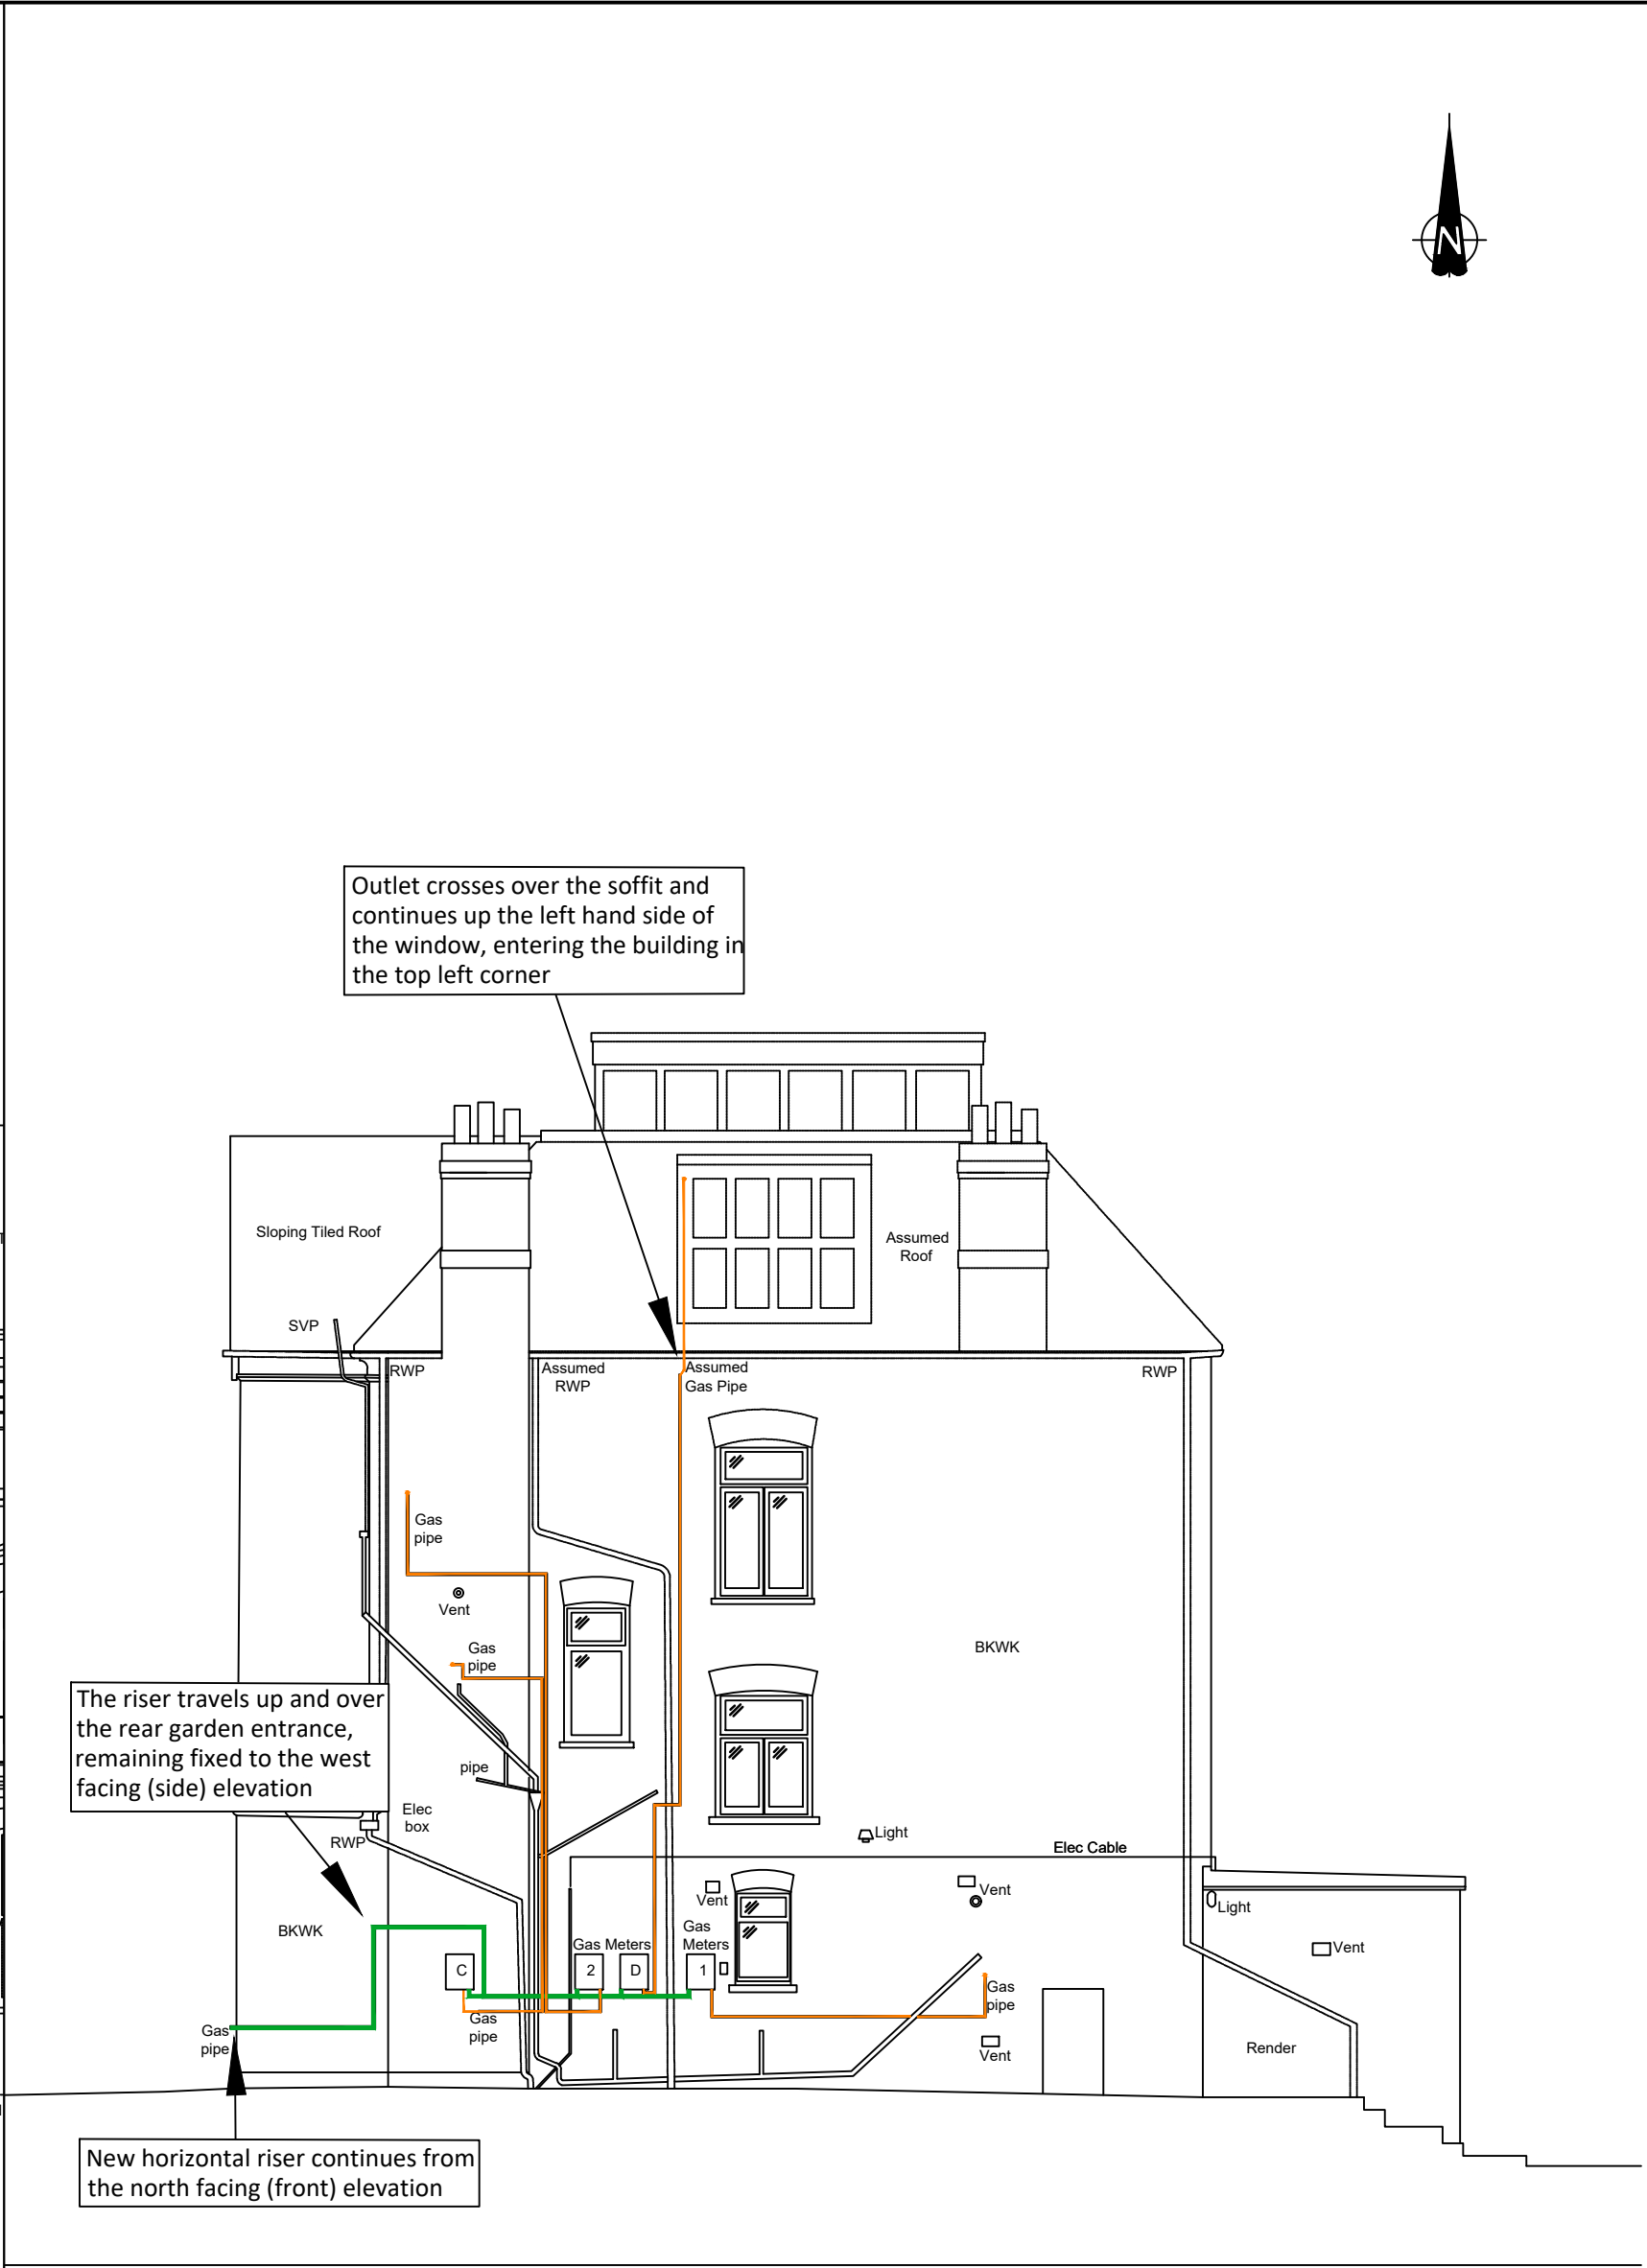


Elevation 1
North facing (front) elevation

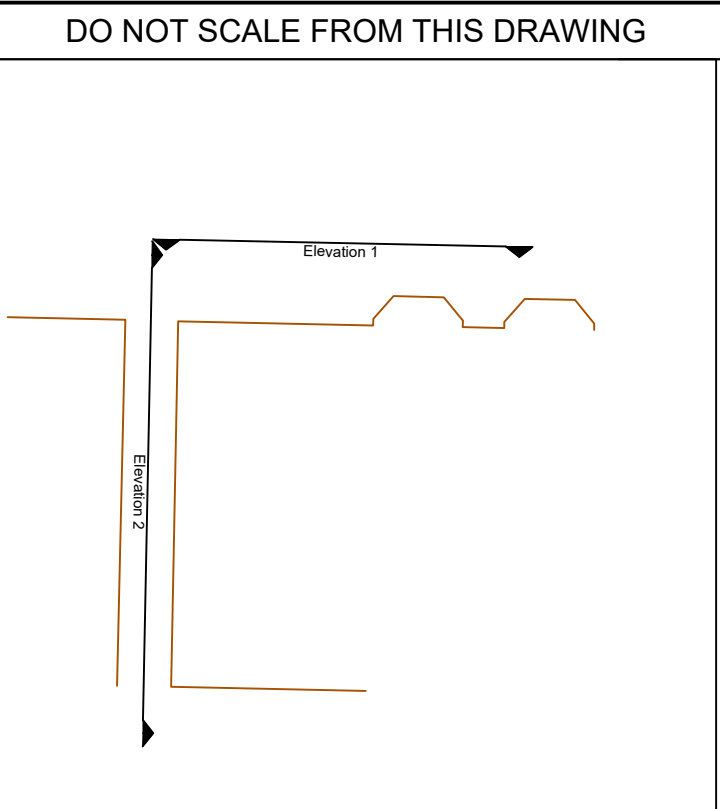


Elevation 2
West facing (side) elevation

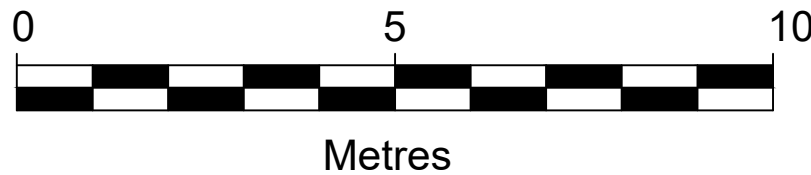

LEGEND
Extent of proposed 2" gas riser
Extent of proposed 3/4" outlet pipes

Note: The garden gate to the west of the building has been removed from the elevation plans to allow the route to be fully appreciated.

REVISION	DETAILS			DATE	DRAWN	CHKD	APPD
CLIENT							
CADENT GAS LTD							
PROJECT							
59 COMPAYNE GARDENS, LONDON, NW6 3DB							
DRAWING TITLE							
AS INSTALLED ELEVATIONS PLAN							
DRG No. CA12007-005				REV A			
DRG SIZE A2		SCALE 1:100		DATE NOV 2020			
DRAWN BY ACH		CHECKED BY SW		APPROVED BY SW			
<div><div><div><div>wardell armstrong</div></div></div><div><div><div><div><div><input type="checkbox"/> STOKES ON TRENT TEL 01782 276700 WWW.WARDELL-ARMSTRONG.COM</div><div><div><div><div><input type="checkbox"/> BIRMINGHAM</div><div><input type="checkbox"/> BOLTON</div><div><input type="checkbox"/> CARDIFF</div><div><input type="checkbox"/> CARLISLE</div><div><input type="checkbox"/> EDINBURGH</div></div><div><div><div><div><input type="checkbox"/> GLASGOW</div><div><input type="checkbox"/> LEEDS</div><div><input type="checkbox"/> LONDON</div><div><input type="checkbox"/> MANCHESTER</div><div><input type="checkbox"/> NEWCASTLE UPON TYNE</div></div></div></div></div></div></div></div></div></div></div>							