



A Ground Penetrating Radar (GPR) survey was conducted at Snowman House and Caterbridge on Abbey Road in London. The survey objective was to search for evidence of buried services and obstructions as part of a PAS M39 survey. The survey used a GSSI Dual Frequency Radar system in conjunction with 300MHz and 800MHz antennae giving a depth of penetration of approximately 1.5 metres.

Most ground conditions contain electrically contrasting layers, which produce reflection events on the GPR profiles. Features such as soil or fill boundaries provide the background signals around unusual features such as pipes. Processing and interpretation procedures are designed to separate the reflections into various target categories, and then map the different reflection types on to a plan diagram. This process involves the interpretation of each individual radar profile, followed by an aerial interpretation of all the radar profiles. Features identified across several profiles are interpolated in areas where the data is well constrained. The survey results are presented as a plan interpretation in Drawing No. 1. The data interpretation identified five significant categories of radar targets which are described below:

i) **Probable pipe/service**
A radar profile orthogonal or at a high angle to a length of pipe or service typically produces a moderate amplitude, steeply curved or hyperbolic reflection response which should be discernible against background reflections. The service position is located at the apex of the hyperbola. At low angles of intersection between survey lines and pipe tracks, the resultant planar reflection response is more ambiguous and can be difficult to identify. Pipe tracks are identified by the recognition of alignments of similar reflections between adjacent parallel profiles. The plan interpretation displays the position of interpreted pipe tracks. The classification of a probable service is based on dual method detection by GPR and utility detection equipment.

ii) **Possible pipe/service**
This target category is broadly similar to the probable pipe/service category described above. The main difference is that the interpreted pipe has been detected only by GPR.

iii) **Anomalous layer**
Anomalous layers occur as well defined, moderate to high amplitude, planar, sometimes more irregular reflections, with weak evidence of edge scattering. Anomalous layers are distinct compositional layers within the subsurface which may correspond to constructed planar features such as foundations; or discrete layers within the ground.

iv) **Disturbed ground / possible obstruction**
Areas identified as disturbed ground generally appear as zones of moderate amplitude, irregular, reflections with broken layering. In some cases, there is evidence of a more chaotic internal structure, resulting from interaction between individual reflections. Disturbed ground can be associated with discrete changes in ground composition, backfilled excavations or partially demolished structures.

v) **Area of reinforcement**
Single rebars and other steelwork within concrete structures normally appear as high amplitude reflections on GPR records, caused by the strong electrical contrast between concrete and steel. A radar profile perpendicular or at a high angle to the length of a single rebar, produces a reflection with a characteristic hyperbolic geometry. Reinforcing mesh reflection responses are generally more complicated, due to interference from overlapping reflections between adjacent rebars.

UTILITY SERVICES IDENTIFICATION	
Service Name	Symbol
Water	Blue line
Gas	Red line
Electricity	Black line
Telecommunications	Green line
Other	Orange line
Unknown	Grey line
Service Name	Symbol
Water	Blue circle
Gas	Red circle
Electricity	Black circle
Telecommunications	Green circle
Other	Orange circle
Unknown	Grey circle


GENERAL NOTES

Locations are shown outside of the survey area. Any point marks outside of the area are for information purposes only and may not represent the full extent of the sub-surface utilities.

Only sub-surface utility information is provided. Above ground utility information may be shown where it directly affects sub-surface utility information.

Where a utility is shown as a line, it is assumed to be a pipe or cable. Where a utility is shown as a point, it is assumed to be a manhole or access point. Where a utility is shown as a circle, it is assumed to be a manhole or access point. Where a utility is shown as a square, it is assumed to be a manhole or access point. Where a utility is shown as a triangle, it is assumed to be a manhole or access point. Where a utility is shown as a diamond, it is assumed to be a manhole or access point. Where a utility is shown as a hexagon, it is assumed to be a manhole or access point. Where a utility is shown as an octagon, it is assumed to be a manhole or access point. Where a utility is shown as a circle with a cross, it is assumed to be a manhole or access point. Where a utility is shown as a square with a cross, it is assumed to be a manhole or access point. Where a utility is shown as a triangle with a cross, it is assumed to be a manhole or access point. Where a utility is shown as a diamond with a cross, it is assumed to be a manhole or access point. Where a utility is shown as a hexagon with a cross, it is assumed to be a manhole or access point. Where a utility is shown as an octagon with a cross, it is assumed to be a manhole or access point.

Information added from post processed GPR	
Probable pipe / service	(Symbol)
Possible pipe / service	(Symbol)
Anomalous layer	(Symbol)
Disturbed ground / possible obstruction	(Symbol)
Area of reinforcement	(Symbol)

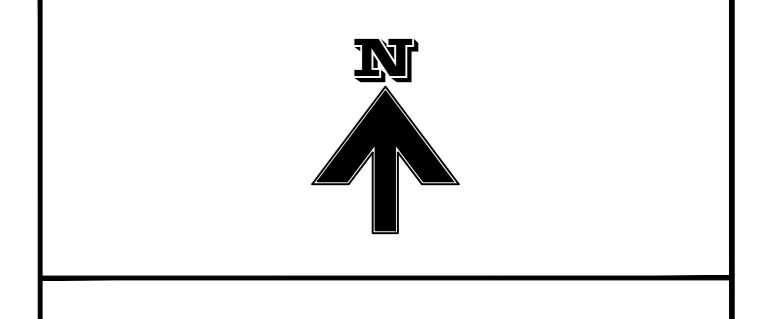

SHEET LAYOUT	
Sheet 01	(Symbol)

Rev	Notes	Drawn	Date
1	Additional Area Checked, Stats Corrected	LP	23/09

Notes: Grid Origin and Level Datum are referenced to clients drawing "WRS2002-METRA-EXT-X-DR-X-001" which has been inserted into this model for background reference.

SUMO SERVICES Ltd
 8 HARVARD BUSINESS CENTRE
 HARVARD
 PO BOX 24
 TEL: 0845 455 1554
 FAX: 0845 455 1553
 www.sumoservices.com

UTILITY SURVEY

Client: **WATES**

Project: **ABBEE AREA PHASE 2**

Date Completed: **AUGUST 2019** Post Code: **NW6 4DP**

Surveyed: **LPBK** Scale: **1:200@A0**

Drawn: **LP**

Checked: **ME**

Dwg No: **01** Job No: **C2019/223** Rev: **1**

**Air Monitoring Installation
 sketch 01 - Prior to
 commencing on site.**