


**PROPOSED**  
Section BB



**EXISTING**  
Section BB

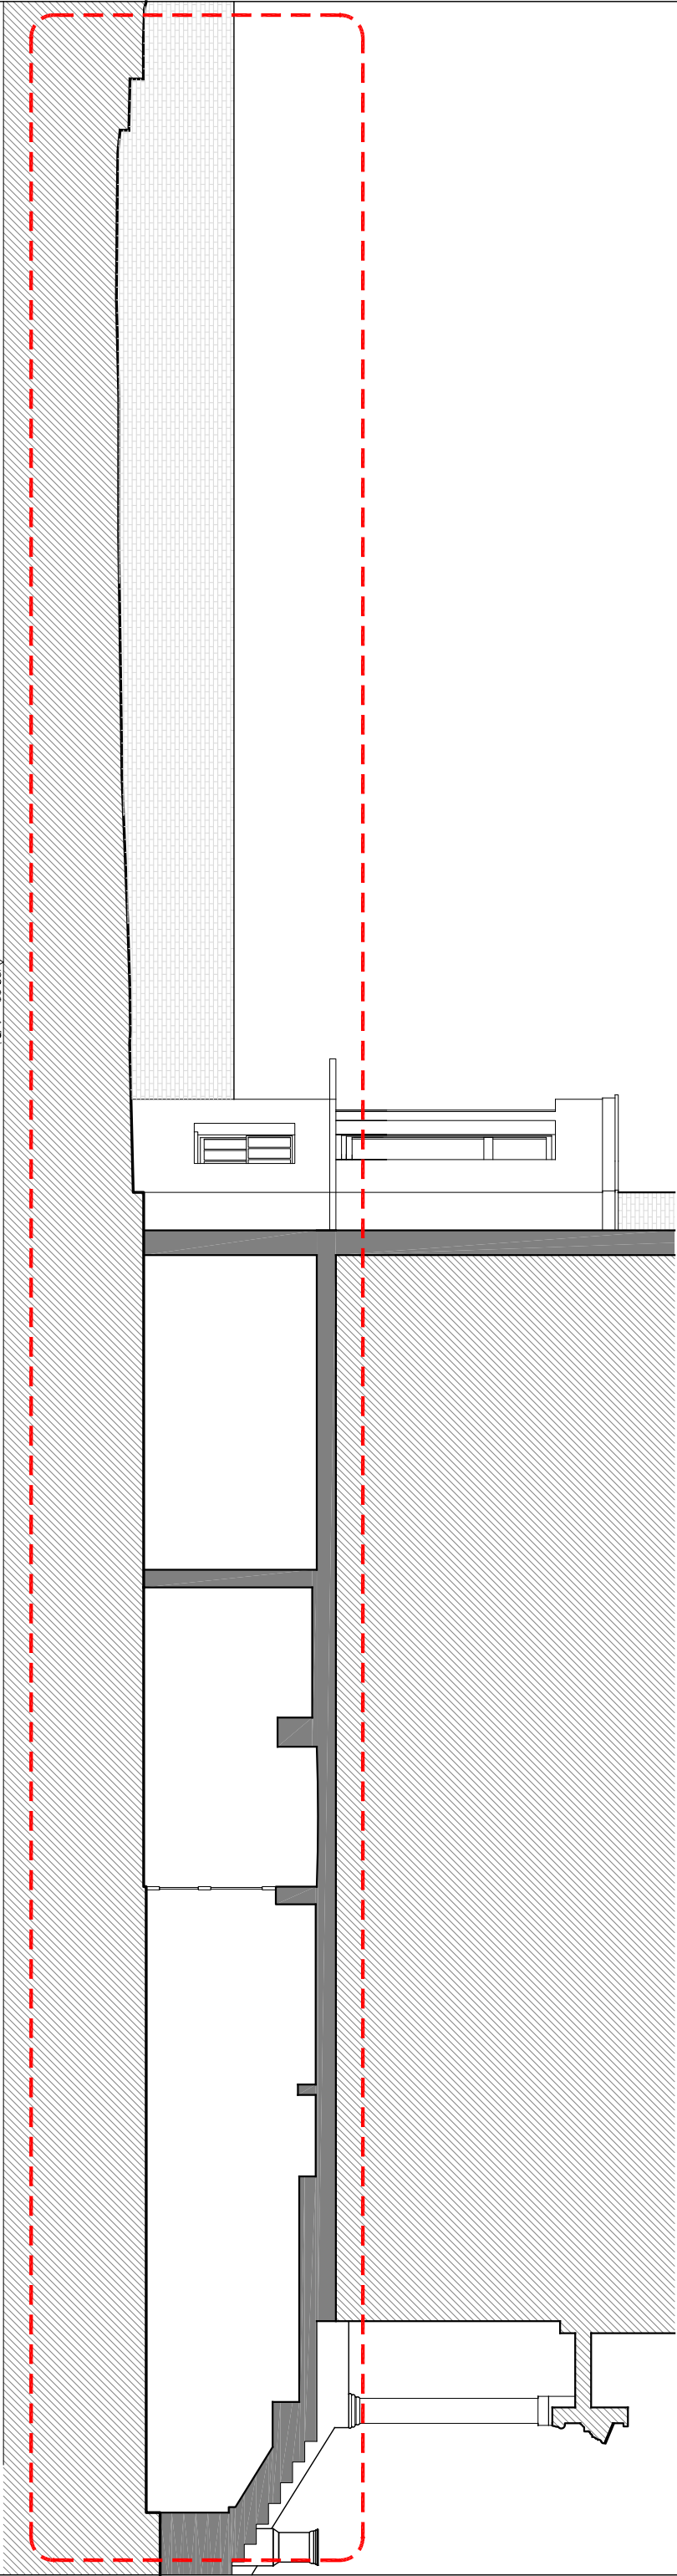

PLEASE NOTE:

1. All dimensions to be checked on site before fabrication,
2. Contractor to refer to engineers drawings before proceeding with works.
3. All drawings and designs are covered by design right (intellectual property), and may not be distributed, copied or issued without written permission by the Architect.
4. All design concepts are the sole property of the Architect and no adaptations, reproductions or copies may be made without written permission of the Architect.
5. These drawings are subject to any variation required or recommendation by any statutory authority, or for the better carrying out of the works.
6. Samples to be provided by contractor for XUL Architects approval.
7. All finishes to XUL Architects satisfaction.
8. All drawings to be approved by XUL Architecture prior to construction.

ADDITIONNAL NOTE:

Issue key:		Project Address		Issue For:	
Information (I)		68 Belsize Park Gardens		PLANNING	
Planning (P)		Scale 1:100@A3		PROPOSED & EXISTING	
Tender (T)		Rev. Date 01.12.20		Section BB	
Construction (C)		Drawn SL		Dwg. No. PP-08	
As Built (B)		Checked SS		Rev. P-01	
				Project Number 20043	



Ground Floor Office  
33 Belsize Lane  
London NW3 5AS  
Office: +44 (0) 207 431 9014  
info@xularchitecture.co.uk  
www.xularchitecture.co.uk