


PROPOSED
Side Elevation

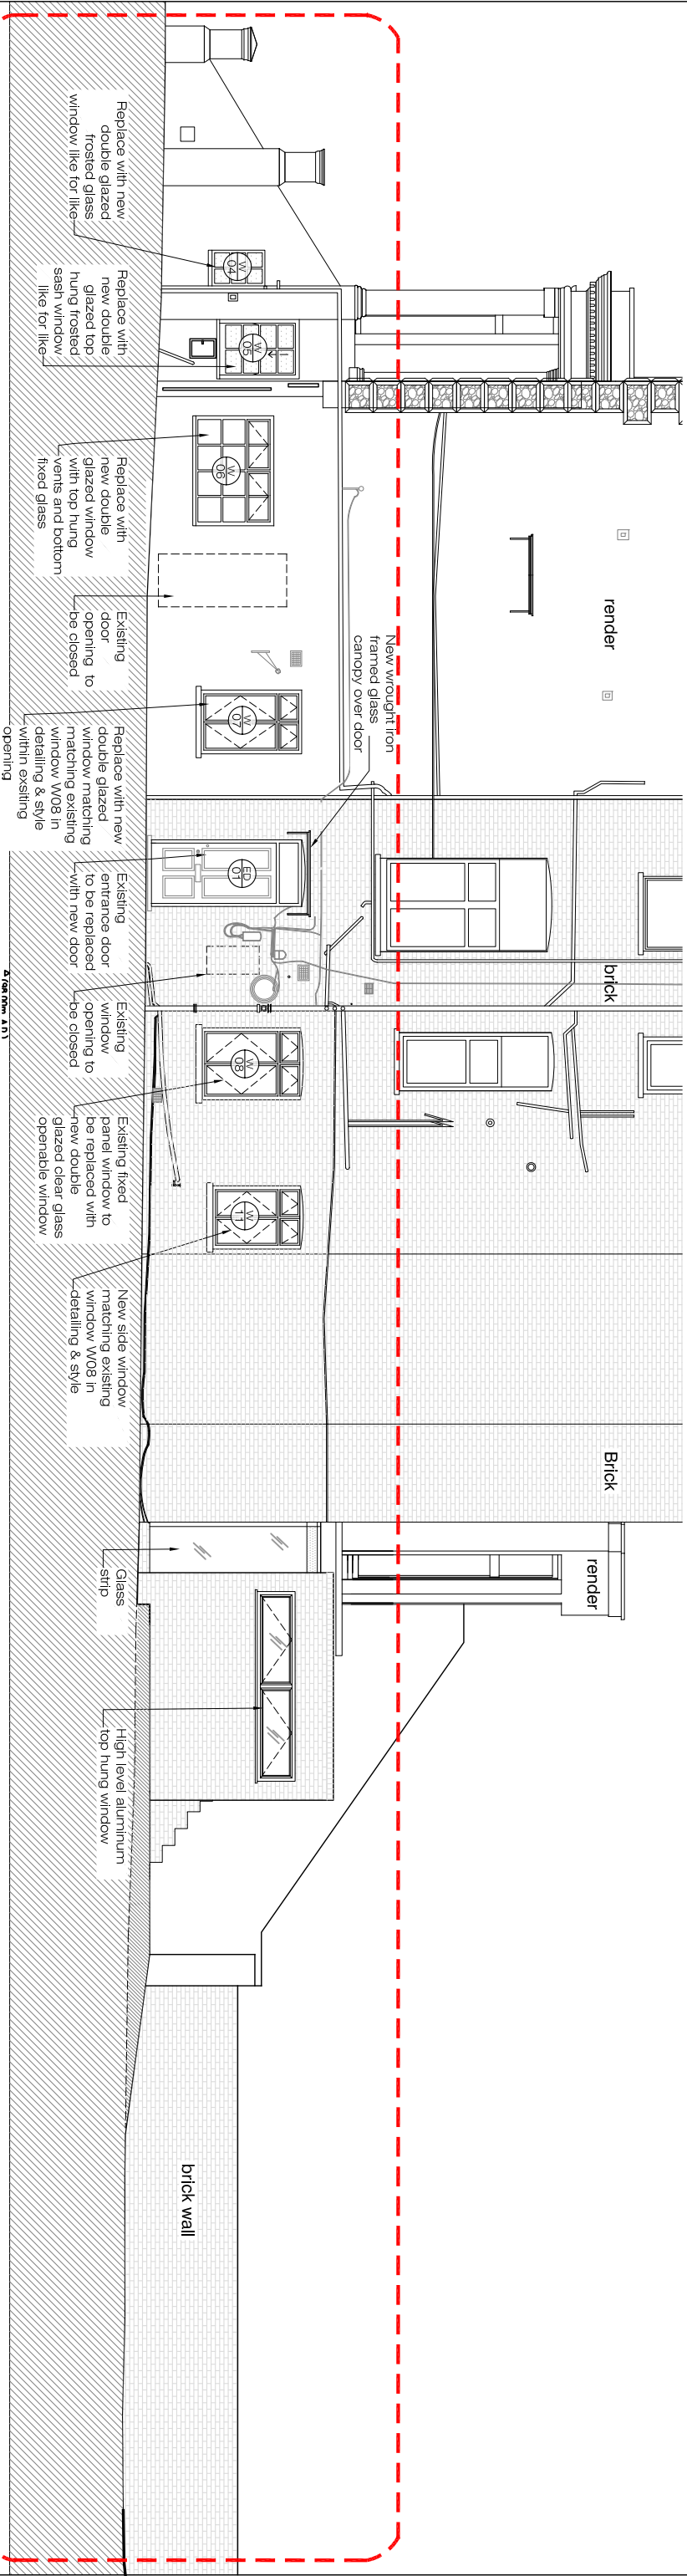

EXISTING
Side Elevation

PLEASE NOTE:

- All dimensions to be checked on site before fabrication.
- Contractor to refer to engineers drawings before proceeding with works.
- All drawings and designs are covered by design right (intellectual property) and may not be distributed, copied or issued without written permission by the Architect.
- All design concepts are the sole property of the Architect and no adaptations, reproductions or copies may be made without written permission of the Architect.
- These drawings are subject to any variation required or recommendation by any statutory authority, or for the better carrying out of the works.
- Samples to be provided by contractor for XUL Architectures approval.
- All finishes to XUL Architectures satisfaction.
- All drawings to be approved by XUL Architecture prior to construction.

ADDITIONNAL NOTE:

Issue key:		Project Address		Issue For:	
Information (I)		68 Beisize Park Gardens		PLANNING	
Planning (P)		Scale 1:100@A3		PROPOSED & EXISTING	
Tender (T)		Rev. Date 01.12.20		Side Elevation	
Construction (C)		Drawn SL		Dwg. No. PP-03	
As Built (B)		Checked SS		Rev. P-01	
				Project Number 20043	