

Buller Greenbury Associates Ltd

4, Dukes Mews, Manchester Square, London, W1U 3ES

tel 020 7486 3658 fax 020 7487 4104

Registered in England No: 2536977

e-mail: bga@bullerga.co.uk79 Delsie Lane.
pwx 0102947**Facsimile Cover Sheet**

To: ~~ROB EREN~~
LB CAMDEN (PLANNING) Fax no. 0207-974-1975
cc: Fax no.
From: DUDLEY HASPINKAU Ref: DPH/569.
Job name: ~~BEISZEDAK~~ Job no: 569
Date: 14 FEB 03. No. of pages: 3, (inc)

Further to my fax of the 12 Feb 03.

I attach hereto a copy of my original fax dated 6:12:02 and would be grateful to receive your comment as a matter of urgency.

Regards

Dudley Haspinkau

No record of original
in letter book

→ Eileen

Buller Greenbury Associates Ltd

4, Dukes Mews, Manchester Square, London, W1U 3ES

tel 020 7486 3658 fax 020 7487 4104

Registered in England No: 2536977

e-mail: bga@bullerga.co.uk

Facsimile Cover Sheet

To:	Rob Brew -L B Camden (Planning)	Fax no.	7 9741975
cc:		Fax no.	
From:	Dudley Haspineall	Ref:	569-310-2002.12.5-DH-13F
Job name:	Belsize Park/ Belsize Lane	Job no:	569
Date	15.08.02 2:12:02	No. of pages:	one (inc)

Dear Mr Brew,

We are in the process of producing working drawings for the building of the terrace housing along Belsize Lane which is intended to commence in May 2003 and there are some minor adjustments that need to be considered during this design/development stage.

This is mainly with regard to the roof configuration, which whilst trying to respect the ridge height of the adjoining property [No 77 c] has resulted in minor alterations as shown on the attached drawing No569/DP/01/005.[namely the flat roof between ridges].

It is hoped that these adjustments to the roof can be considered as minor amendments to the approved drawings and I would seek your advice on this matter.


Should you have any queries on the foregoing or require any further information then please do not hesitate to contact Nigel Buller or myself.

Yours Sincerely,

Dudley Haspineall.

For and on behalf of

Buller Greenbury Associates Ltd.

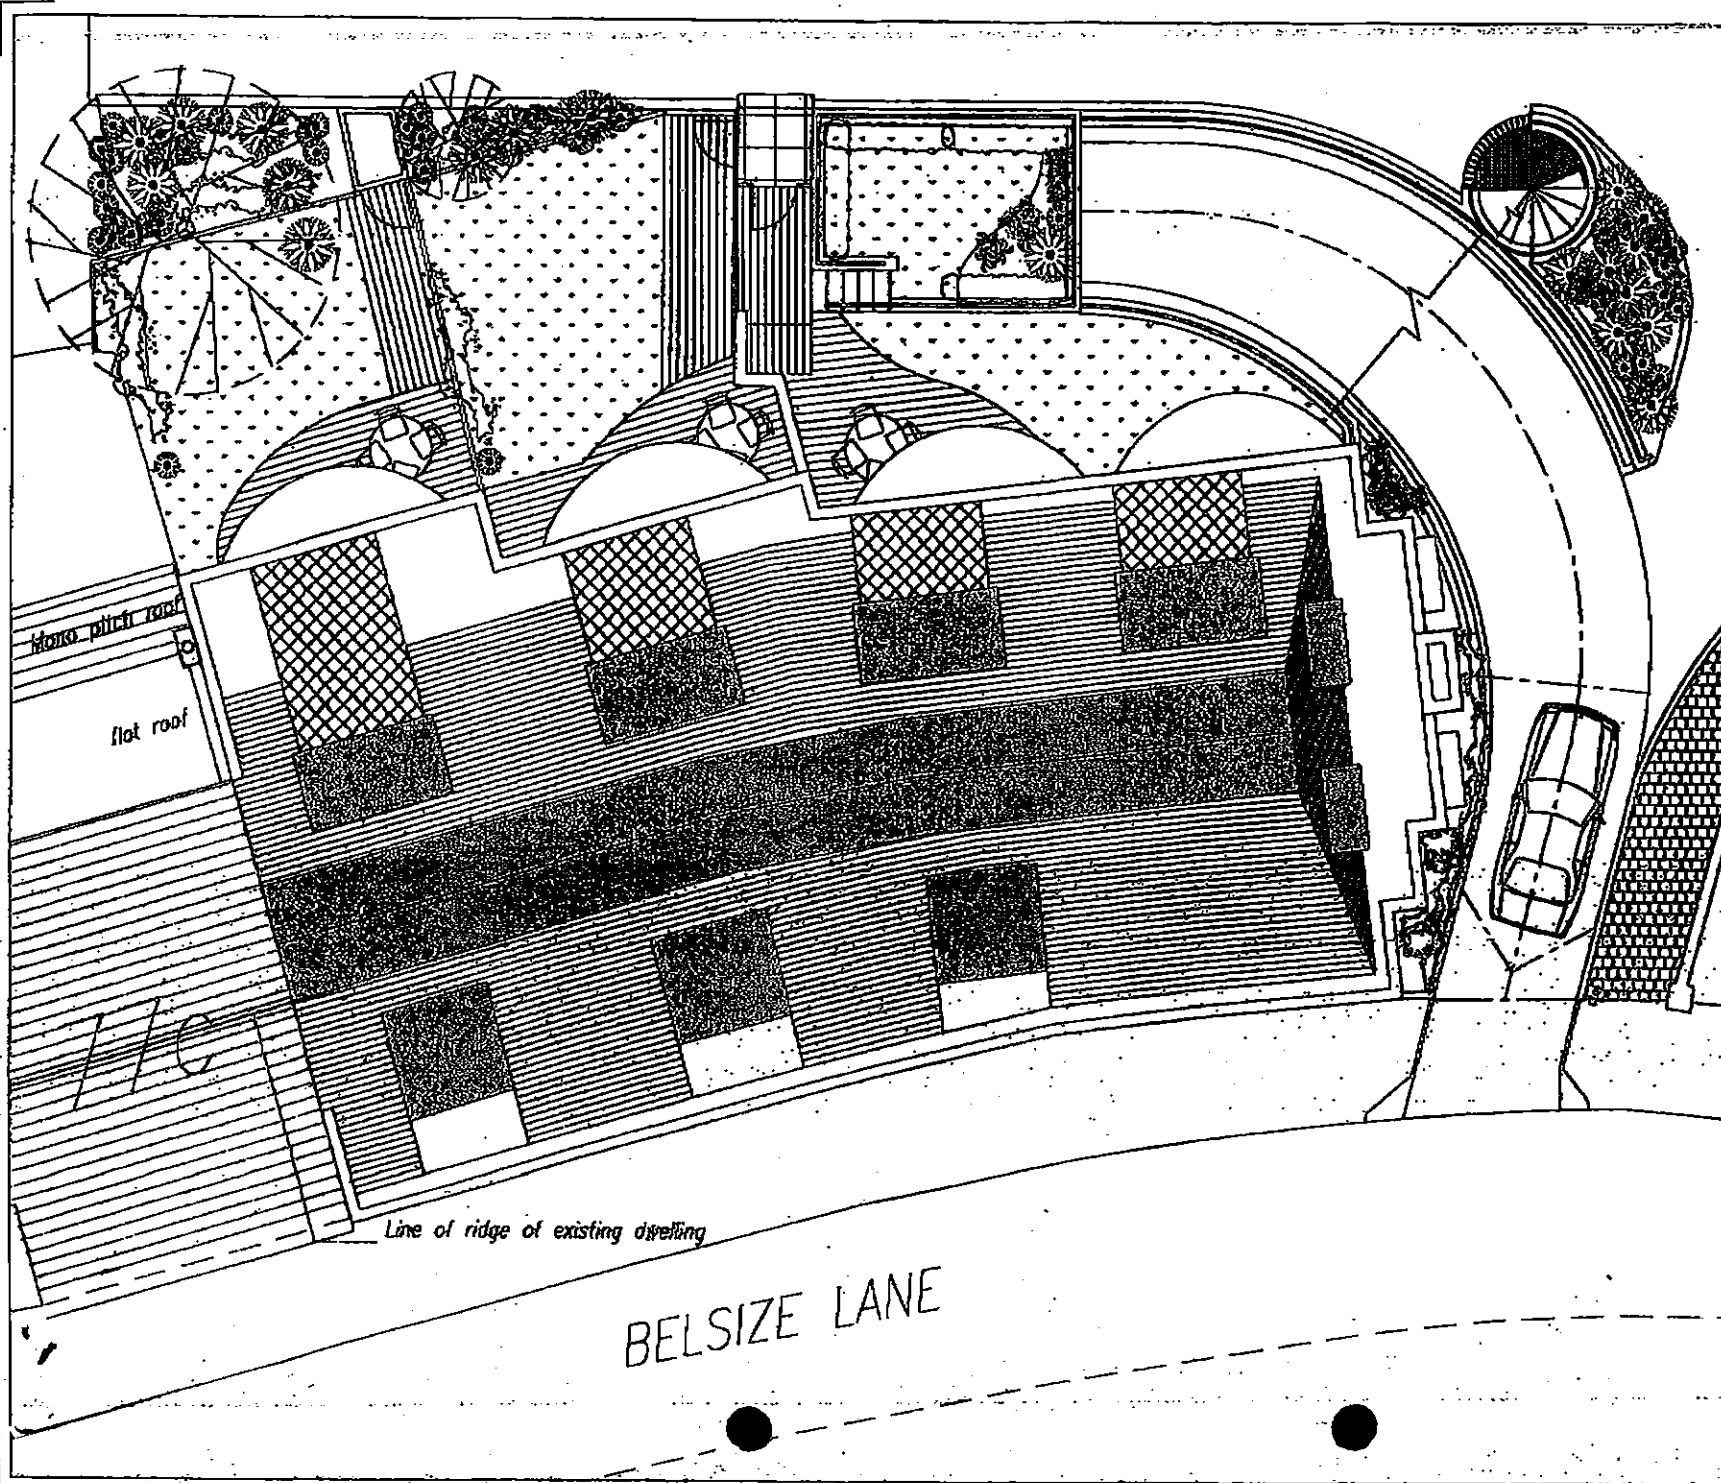

This scheme is subject to the planning and all other necessary consents. Conditions, notes and terms given shall be only agreements and subject to the survey.

All dimensions are to be quoted in this. Any discrepancies are to be reported to the architect before work commences. Client dimensions only are to be taken from the building.

This drawing is to be kept in confidence, with all relevant documents, and any reproduction or circulation not to be without the architect's consent.

Notes

Buller Greenbury Associates

Chartered Architects

4 Ditchley Mews, London W9U 3DS.
Tel: 020 7465 3656 Fax: 020 7467 4104
Email: Gbassoc@bt.com

**7B BELSIZE LANE
LONDON NW3**

ROOF PLAN

scale: 1:1000	date: DEC 2002
drawn: Gbassoc	checked: Gbassoc

drawing number: **603/DP/01/005**

00000000000000000000