
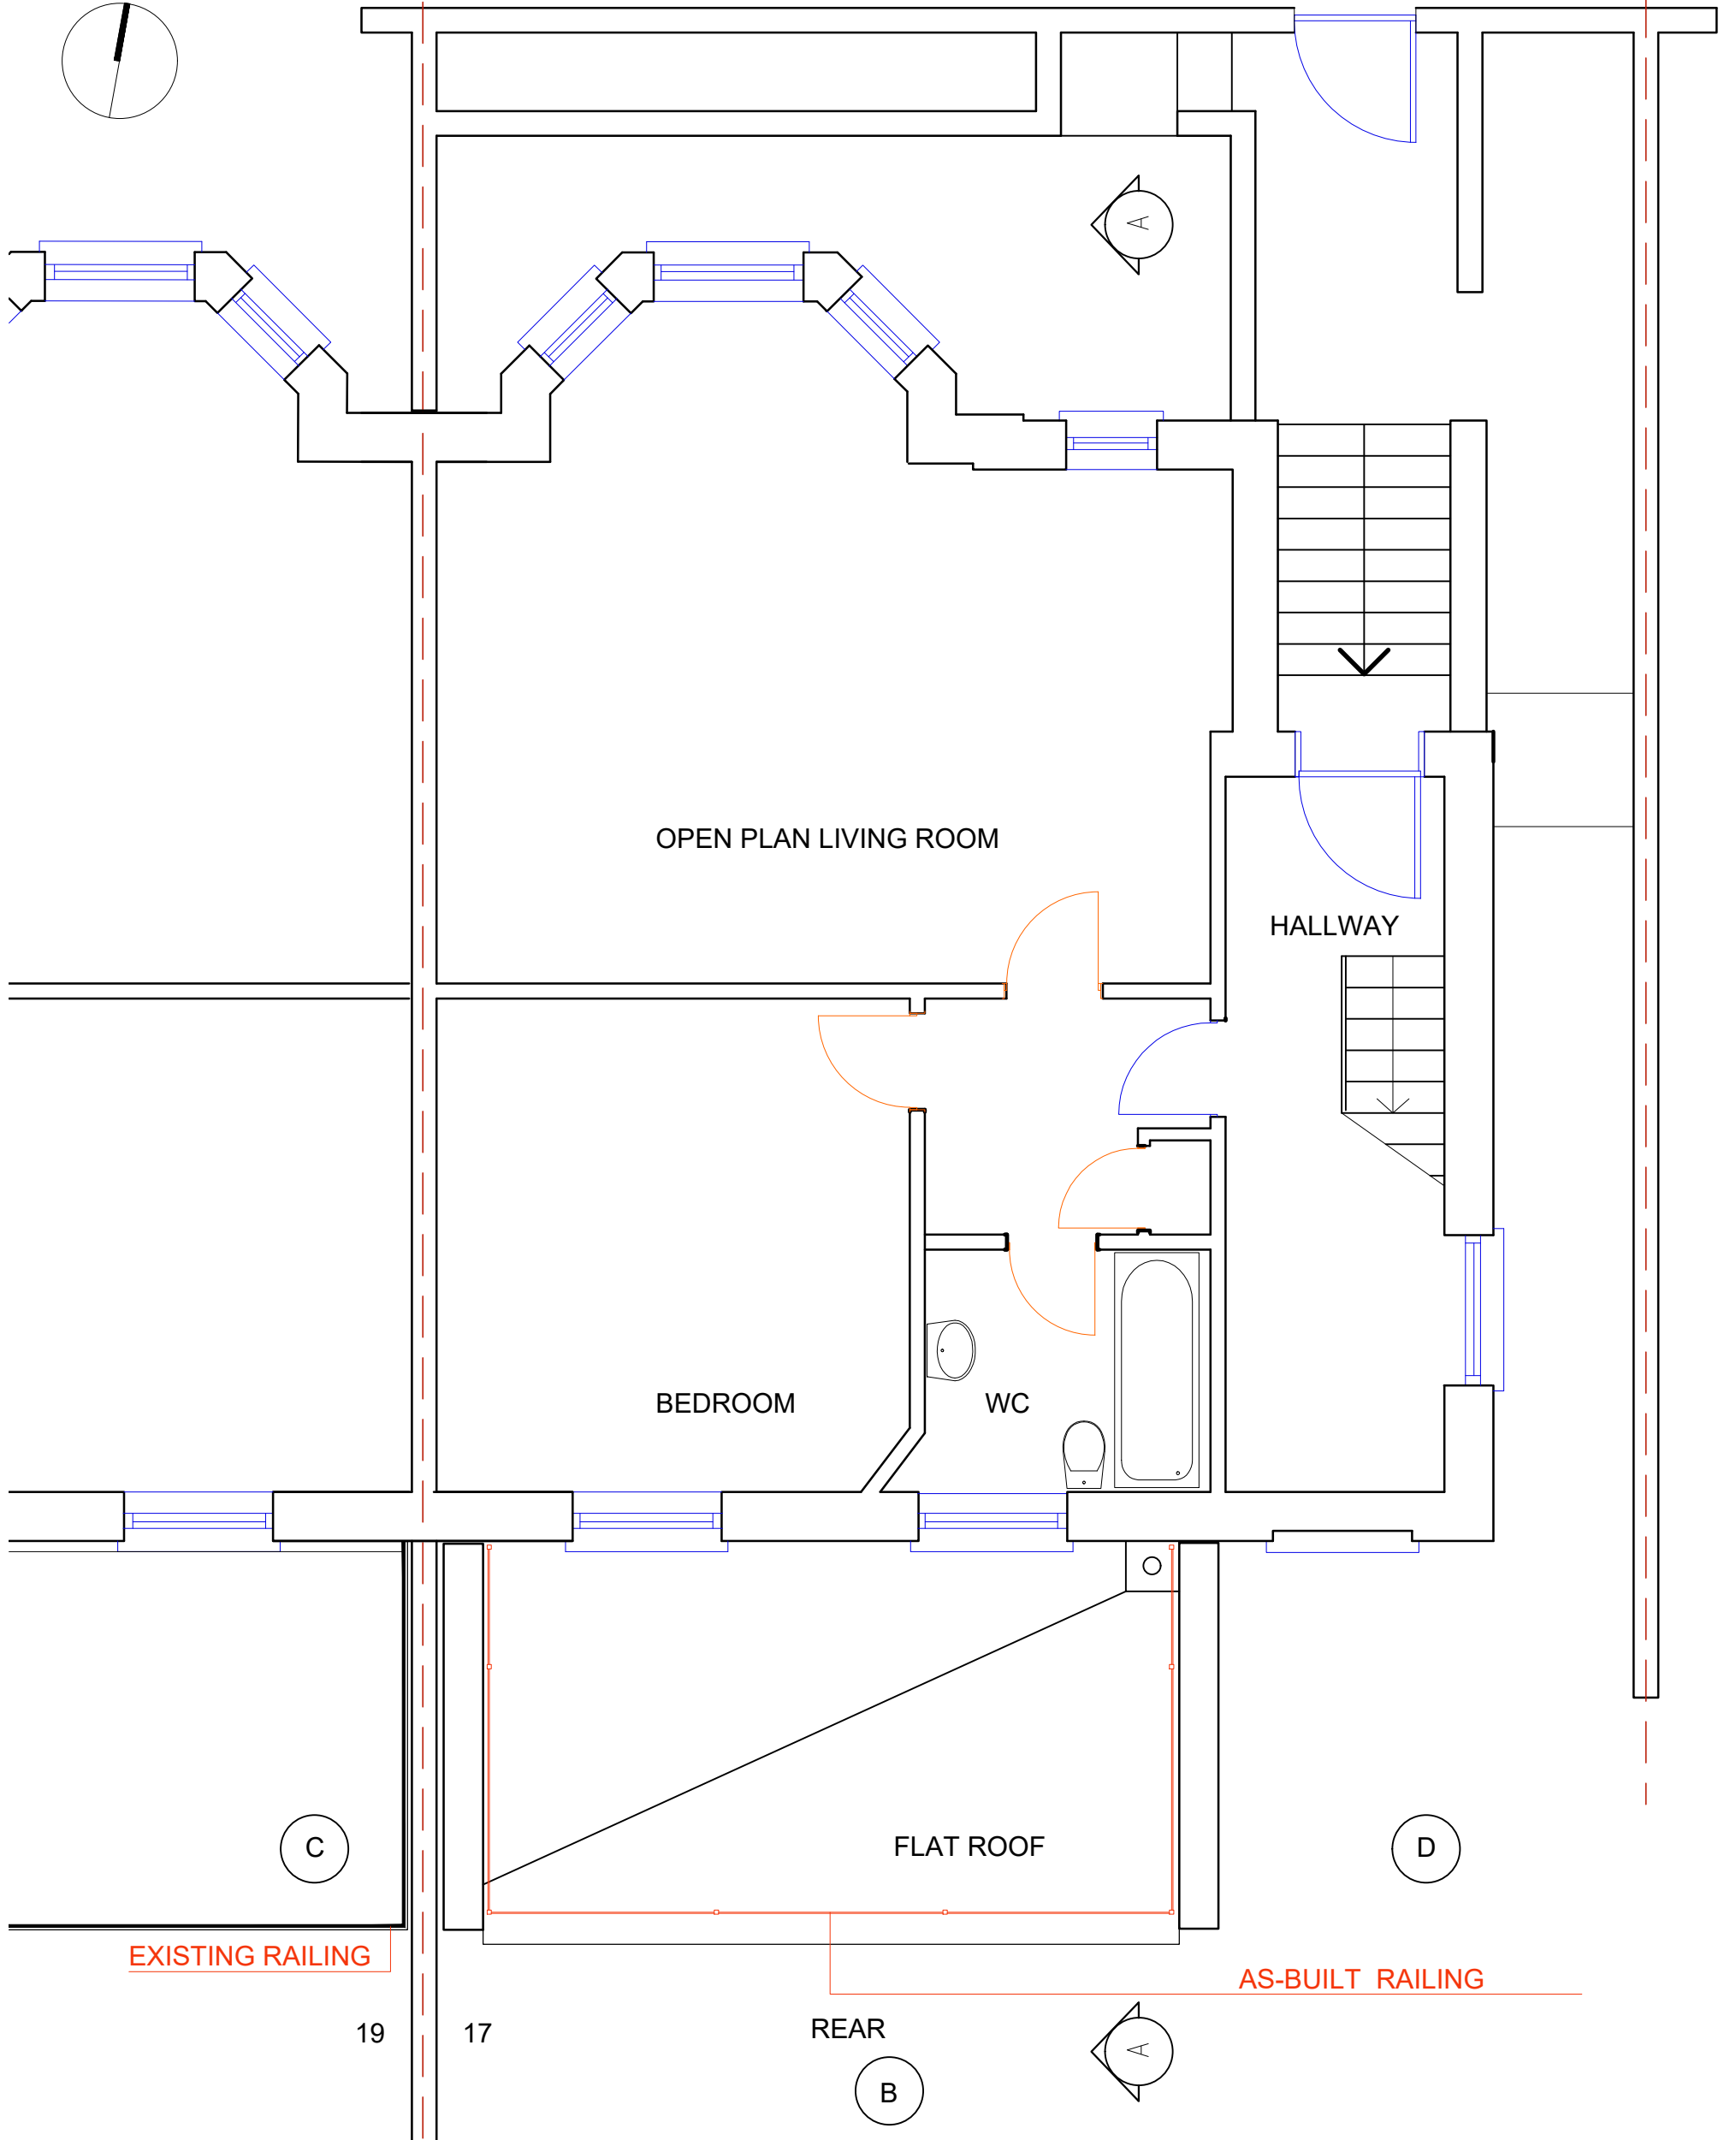


REGENTS PARK ROAD

19

17

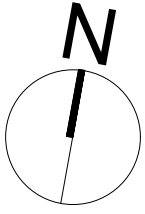

EXISTING RAILING

AS-BUILT RAILING

REAR

REV A -01.12.20

FIRST ISSUE

01-10-20

DRAWN

SB

CHECKED

SB

TITLE

FLAT GROUND FLOOR  
AS-BUILT GROUND FLOOR PLAN

CLIENT

O'NEILL INVESTMENTS LIMITED

**SEZ ASSOCIATES**

PROJECT

17 REGENT'S PARK ROAD,  
LONDON NW1 7TL

5, MARYGOLD HOUSE, TAYLOR CLOSE, TW3 4BZ, HOUNSLOW

Mob: + 44 (0) 7989697333

E-mail: svetlazana@yahoo.co.uk

Revision/Issue Date

JOB NO

RPR-17

REVISION

DRAWING NO

PL-101-02