


Rev	Date	By	Description
A	24/11/2020	AZ	Parking spaces added;
B	27/11/2020	AZ	Parking spaces arrangement amended; pedestrians walkways added;
C	02/12/2020	AZ	Graphic amendments; van car parking arrangement changed;
D	07/12/2020	AZ	Ground Floor arrangement amended following comments from Client;
E	07/12/2020	AZ	Label amended;
F	04/02/2021	AZ	Cycle positions amended;

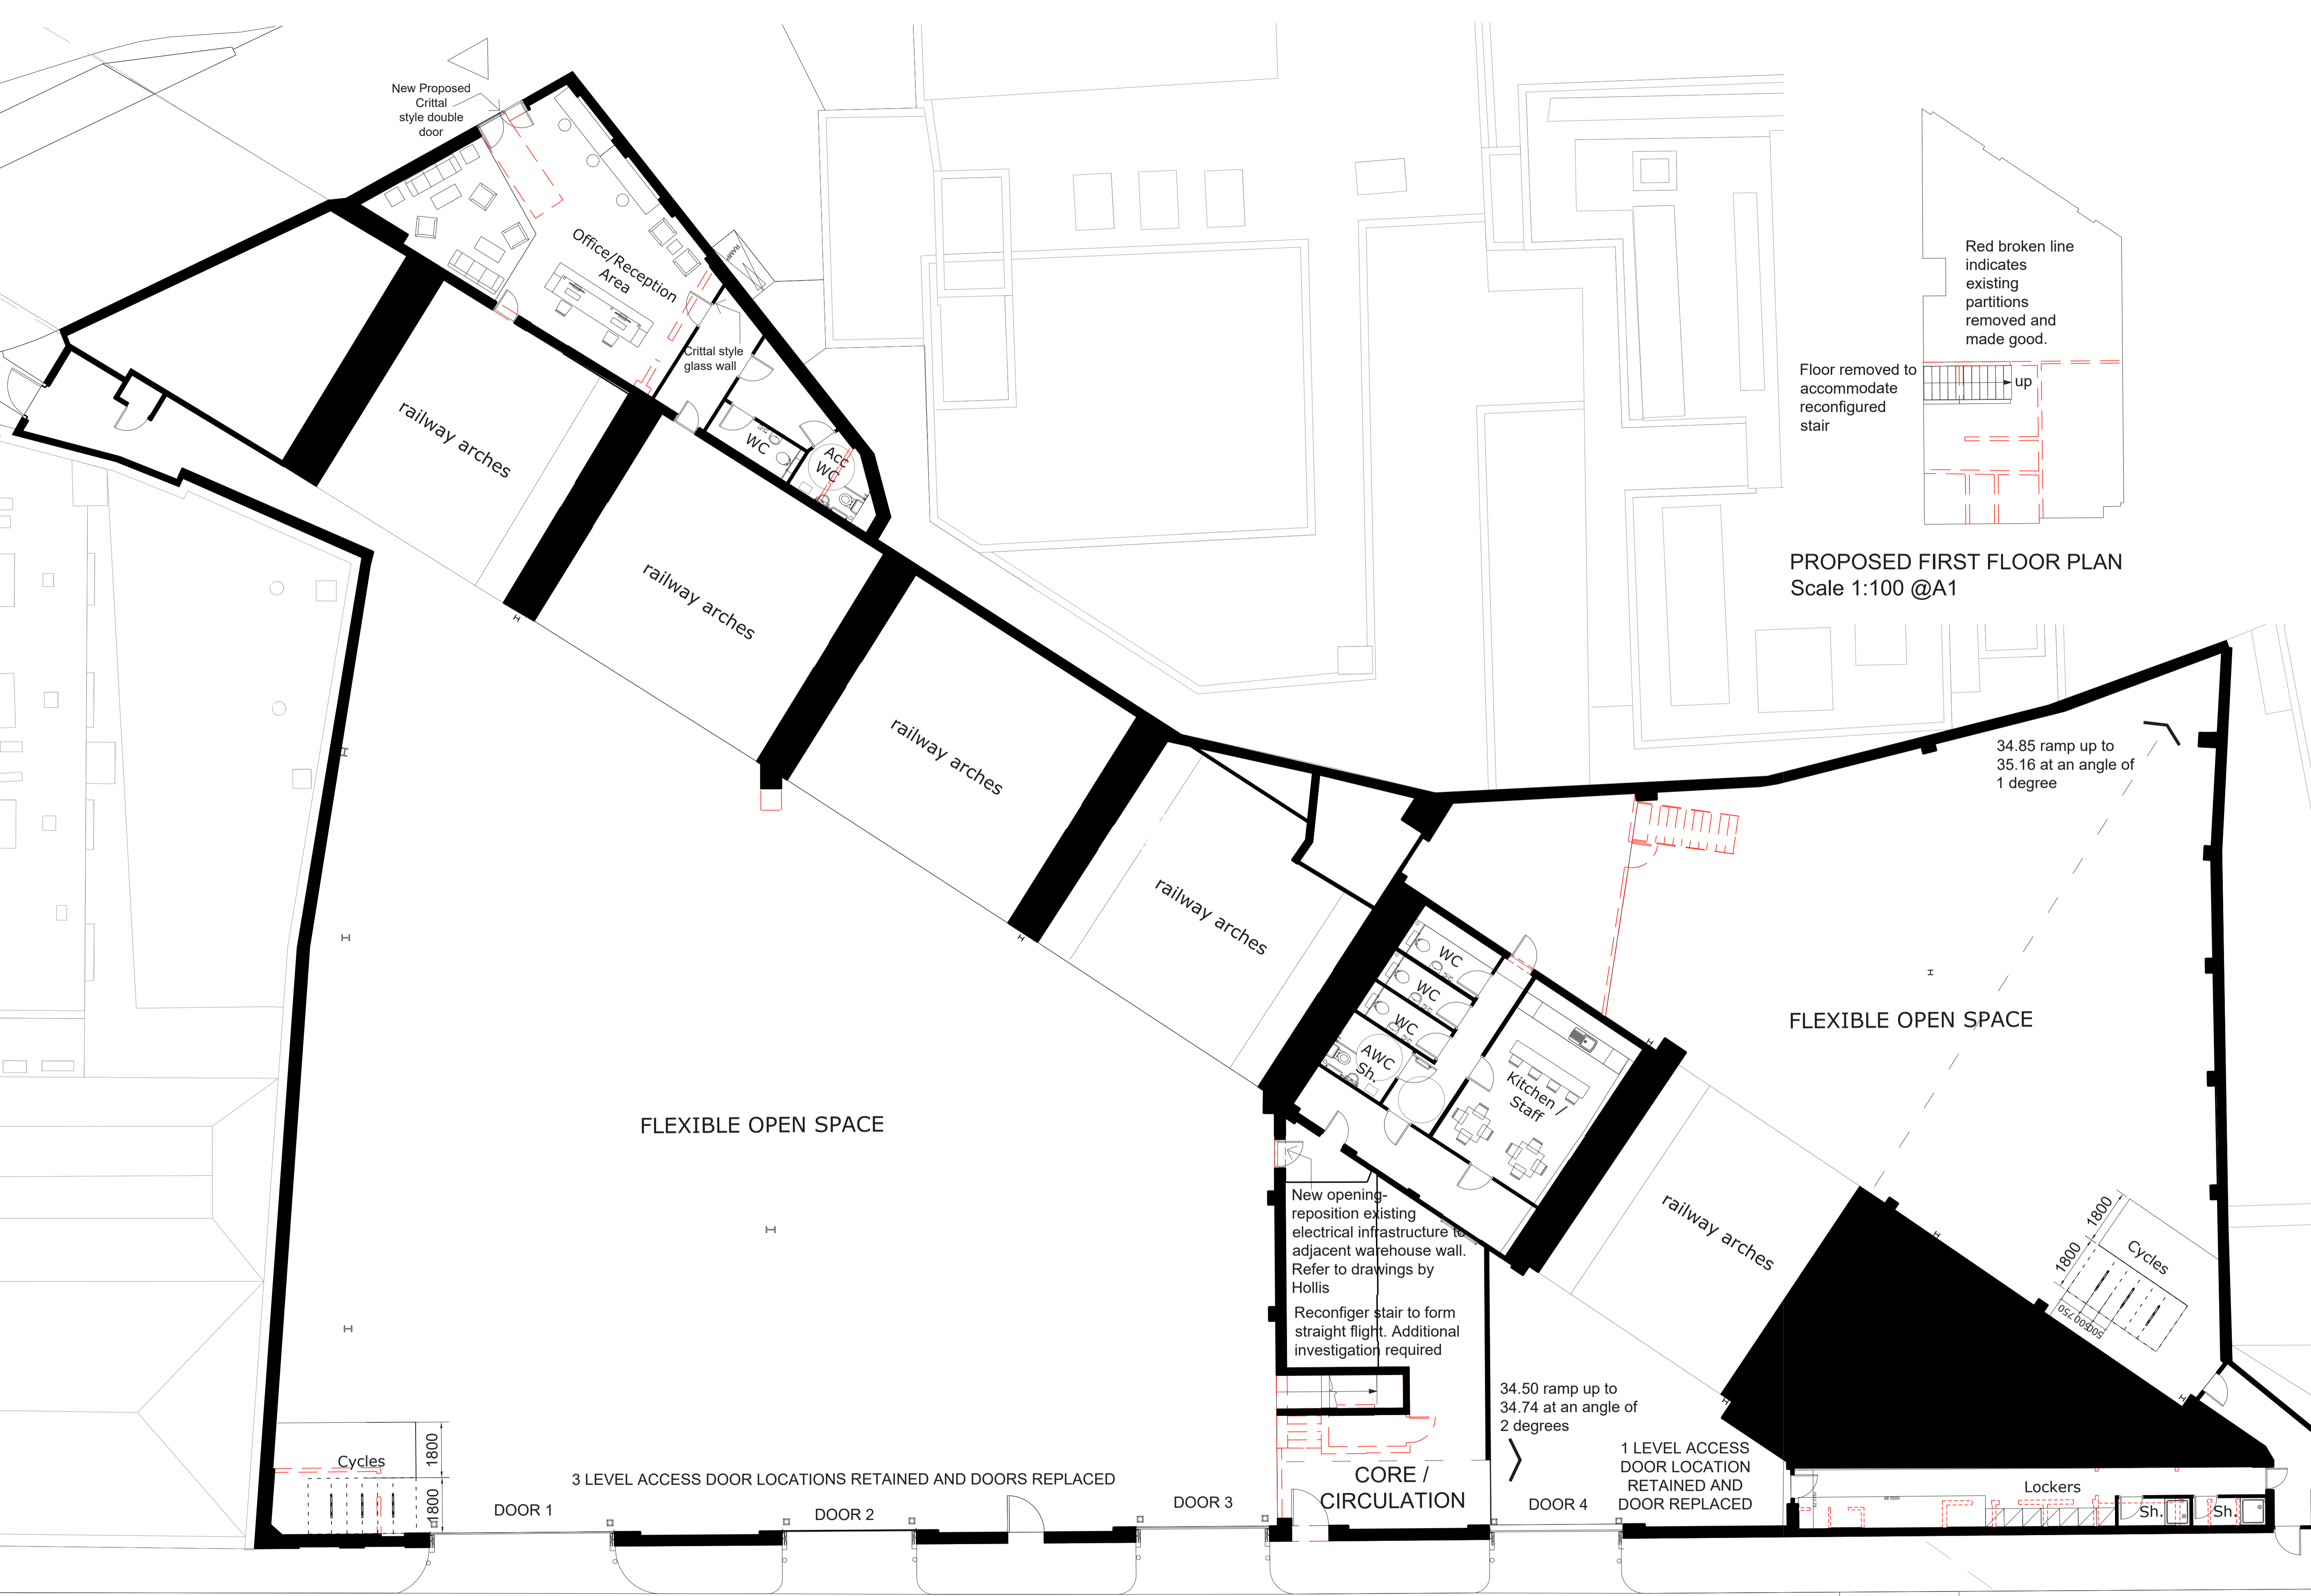

PROPOSED FIRST FLOOR PLAN  
Scale 1:100 @A1


PROPOSED GROUND FLOOR PLAN  
Scale 1:100 @A1

  
**SEGRO**  
**SGP**  
 Architects + Masterplanners

Waterfront House  
 2a Smith Way  
 Grove Park  
 Enderby  
 Leicestershire LE19 1SX  
 t: +44 (0)116 247 0557  
[www.stephengeorge.co.uk](http://www.stephengeorge.co.uk)

Refurbishment  
 3-6 Spring Place  
 Kentish Town

Drawing Name: Proposed Floor Plan						
Drawing Stage:	PLANNING					
Suitability:	S2 - Information					
SGP File Ref:	19-275					
19-275	30/09/2020	AZ	JN	1:100 @ A1	F	
SGP Project No:	Date:	Drawn:	Team:	Scale:	Rev:	
Drawing Number: 19-275 - SGP - XX - 00 - DR - A - 131100						
Project Code	Originator	Volume	Level	Type	Role	Number

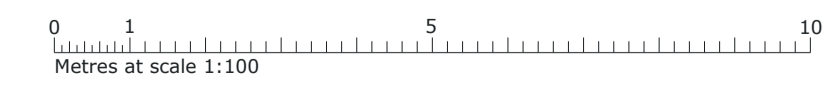

Red Line Boundary based on O/S Data and NOT confirmed as the Legal Boundary  
 This drawing, the works and concepts depicted are copyright of Stephen George + Partners LLP and may not be reproduced or made use of, either directly or indirectly without express written consent. Do not scale off this drawing. All heights, levels, sizes and dimensions to be checked on site before any work is put to hand.