


This drawing is not to be scaled—verify all dimensions on site.

Notes

ELEVATION OF MOTOR & TANK HOUSING AS CONSTRUCTED.

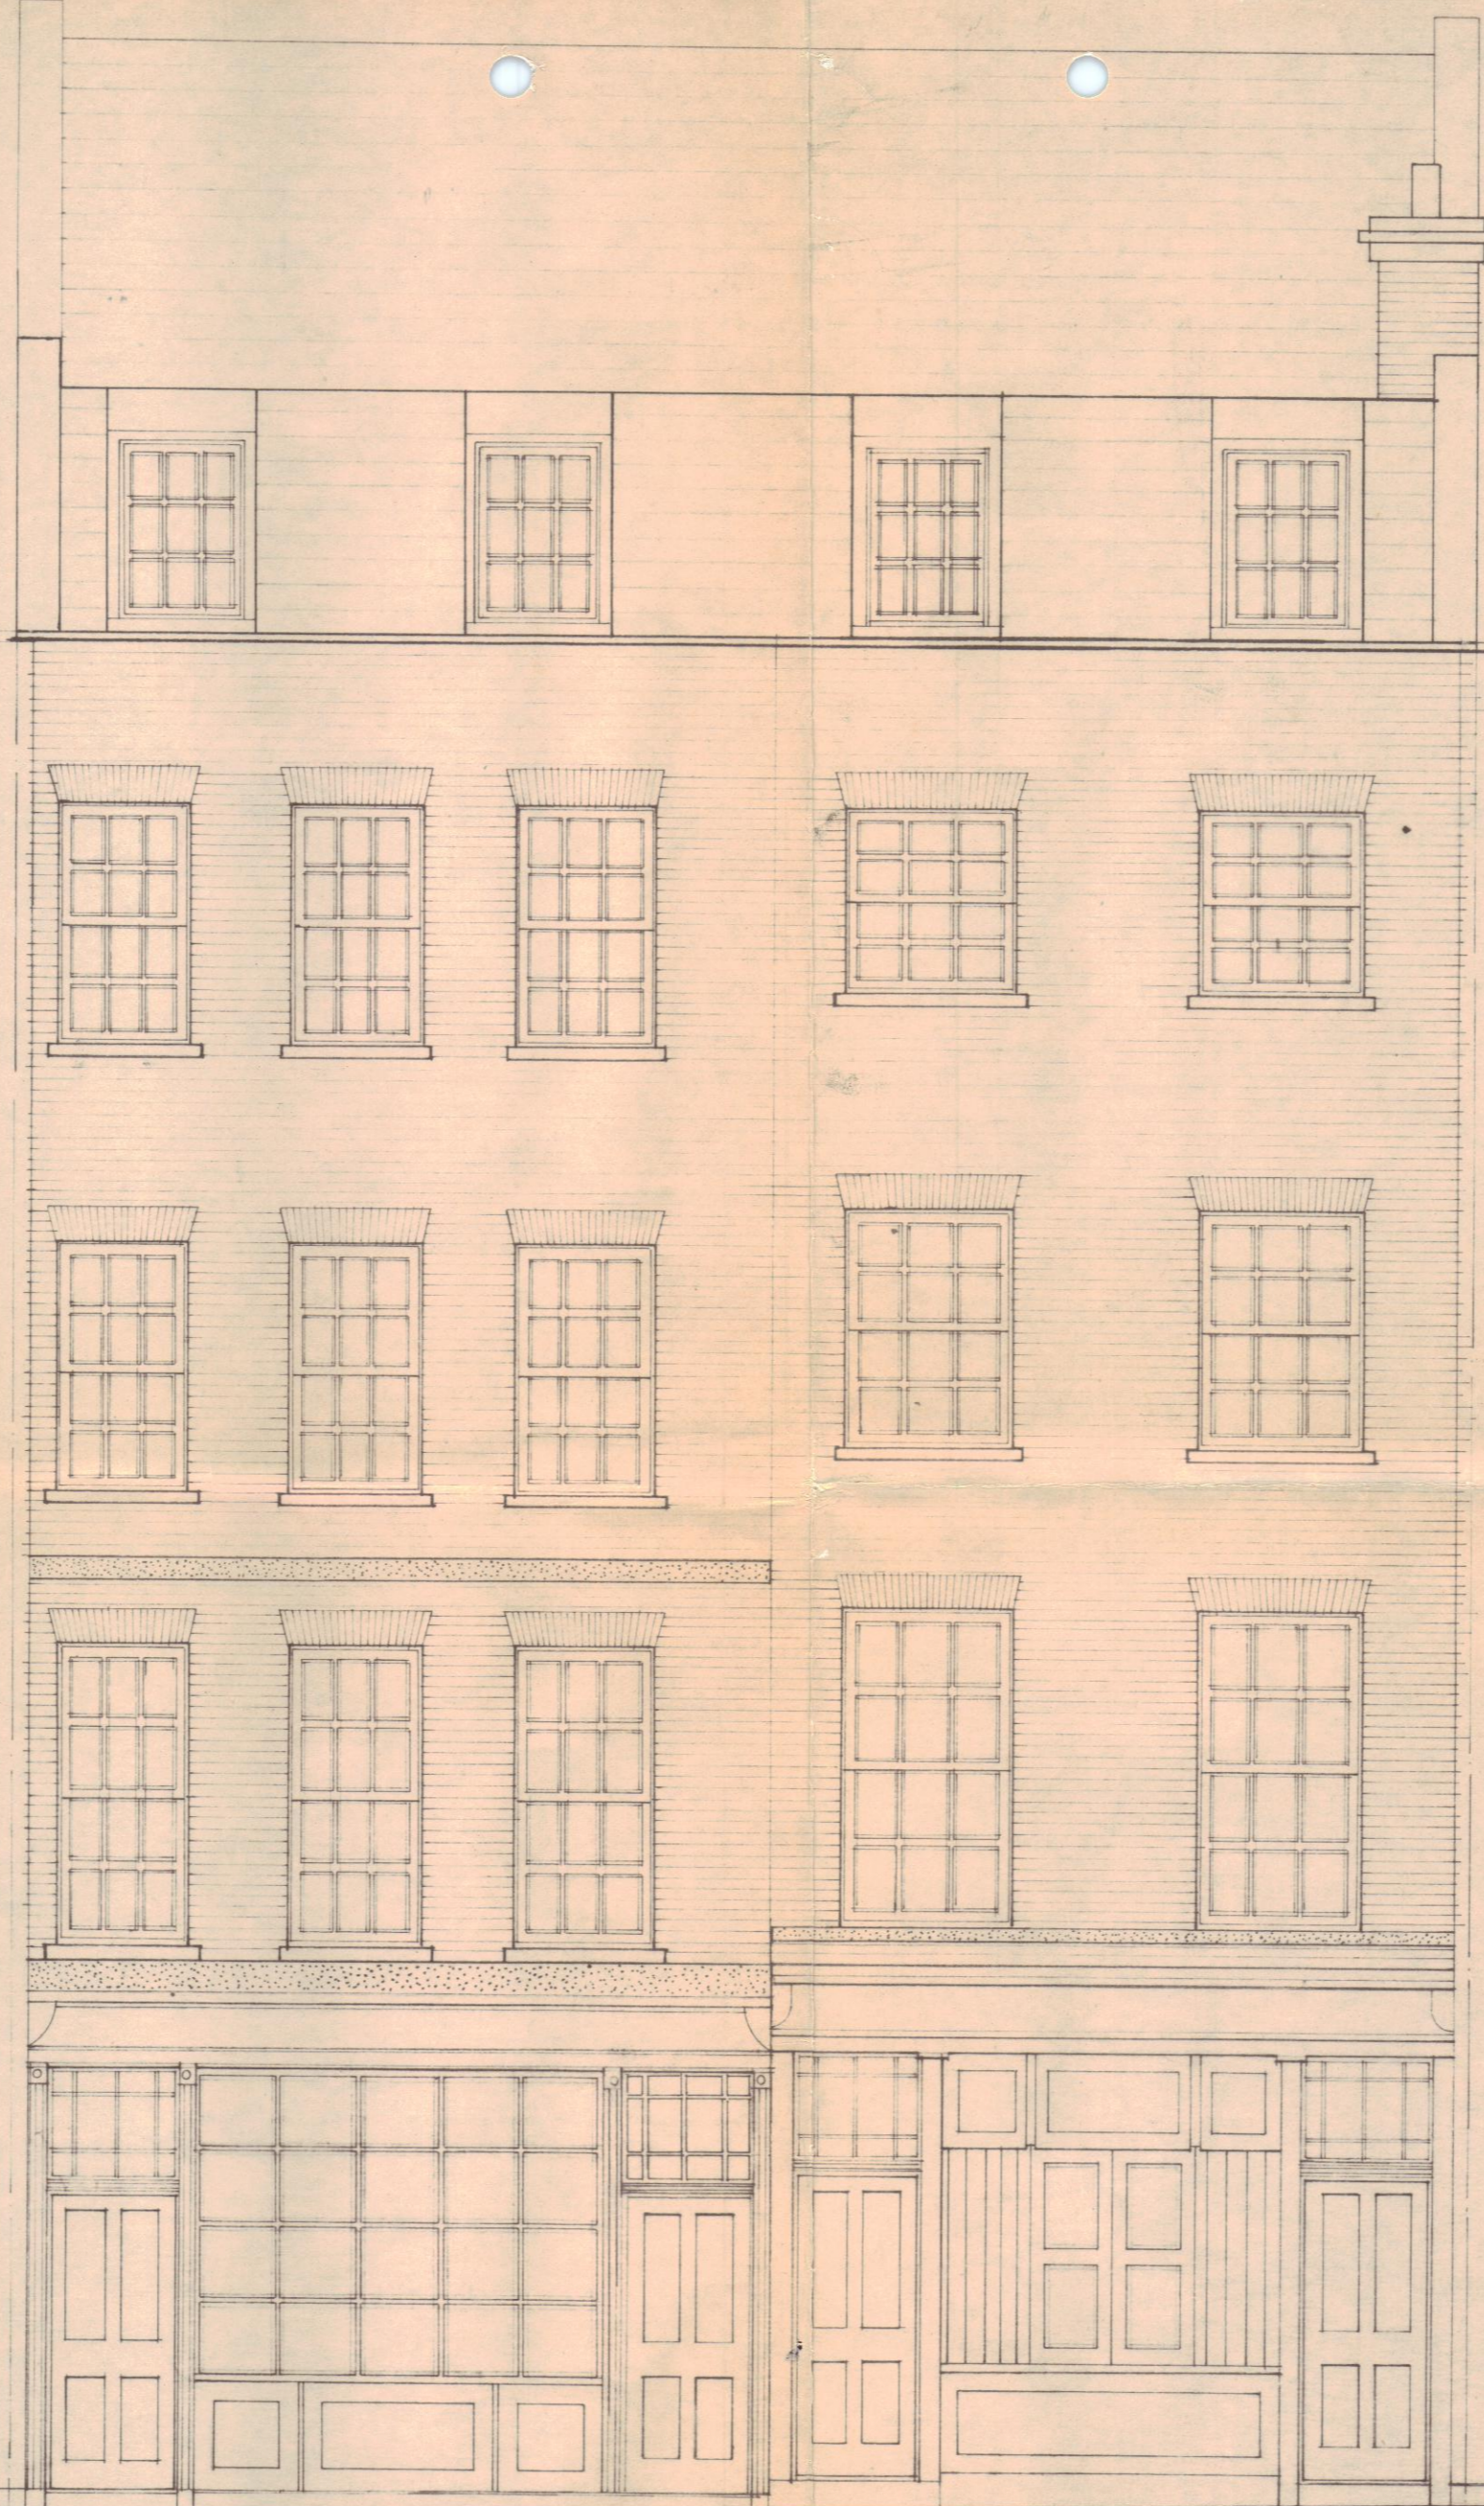

26 SHORTS GUNS.

LONDON BOROUGH OF CAMDEN
TOWN AND COUNTRY PLANNING ACTS
3 OCT 1984
~~APPROVED~~
PLANS NOT APPROVED
ON BEHALF OF THE COUNCIL

Revisions

P14/55/D)
PL/8400700 +
HB/8470100

LONDON BOROUGH OF CAMDEN
TOWN AND COUNTRY PLANNING ACTS
29 MAY 1984
~~APPROVED~~
PLANS NOT APPROVED
ON BEHALF OF THE COUNCIL

ELEVATION TO NEAL STREET.

Project		35/37, NEAL STR. W.C.2			Title		FRONT ELEVATION					
Scale	1:50	Date	AUG. 79	Drawn	Checked	Job No.	232	Drawing No.	PA-92	Revision	A	Date Issued
Douglas Paskin Associates												
7 Cliff Road Studios London NW19AN 01-485 1114												