


This drawing is not to be scaled—verify all dimensions on site.

Notes  
LIFT MOTOR & TANK HOUSING  
AS CONSTRUCTED.

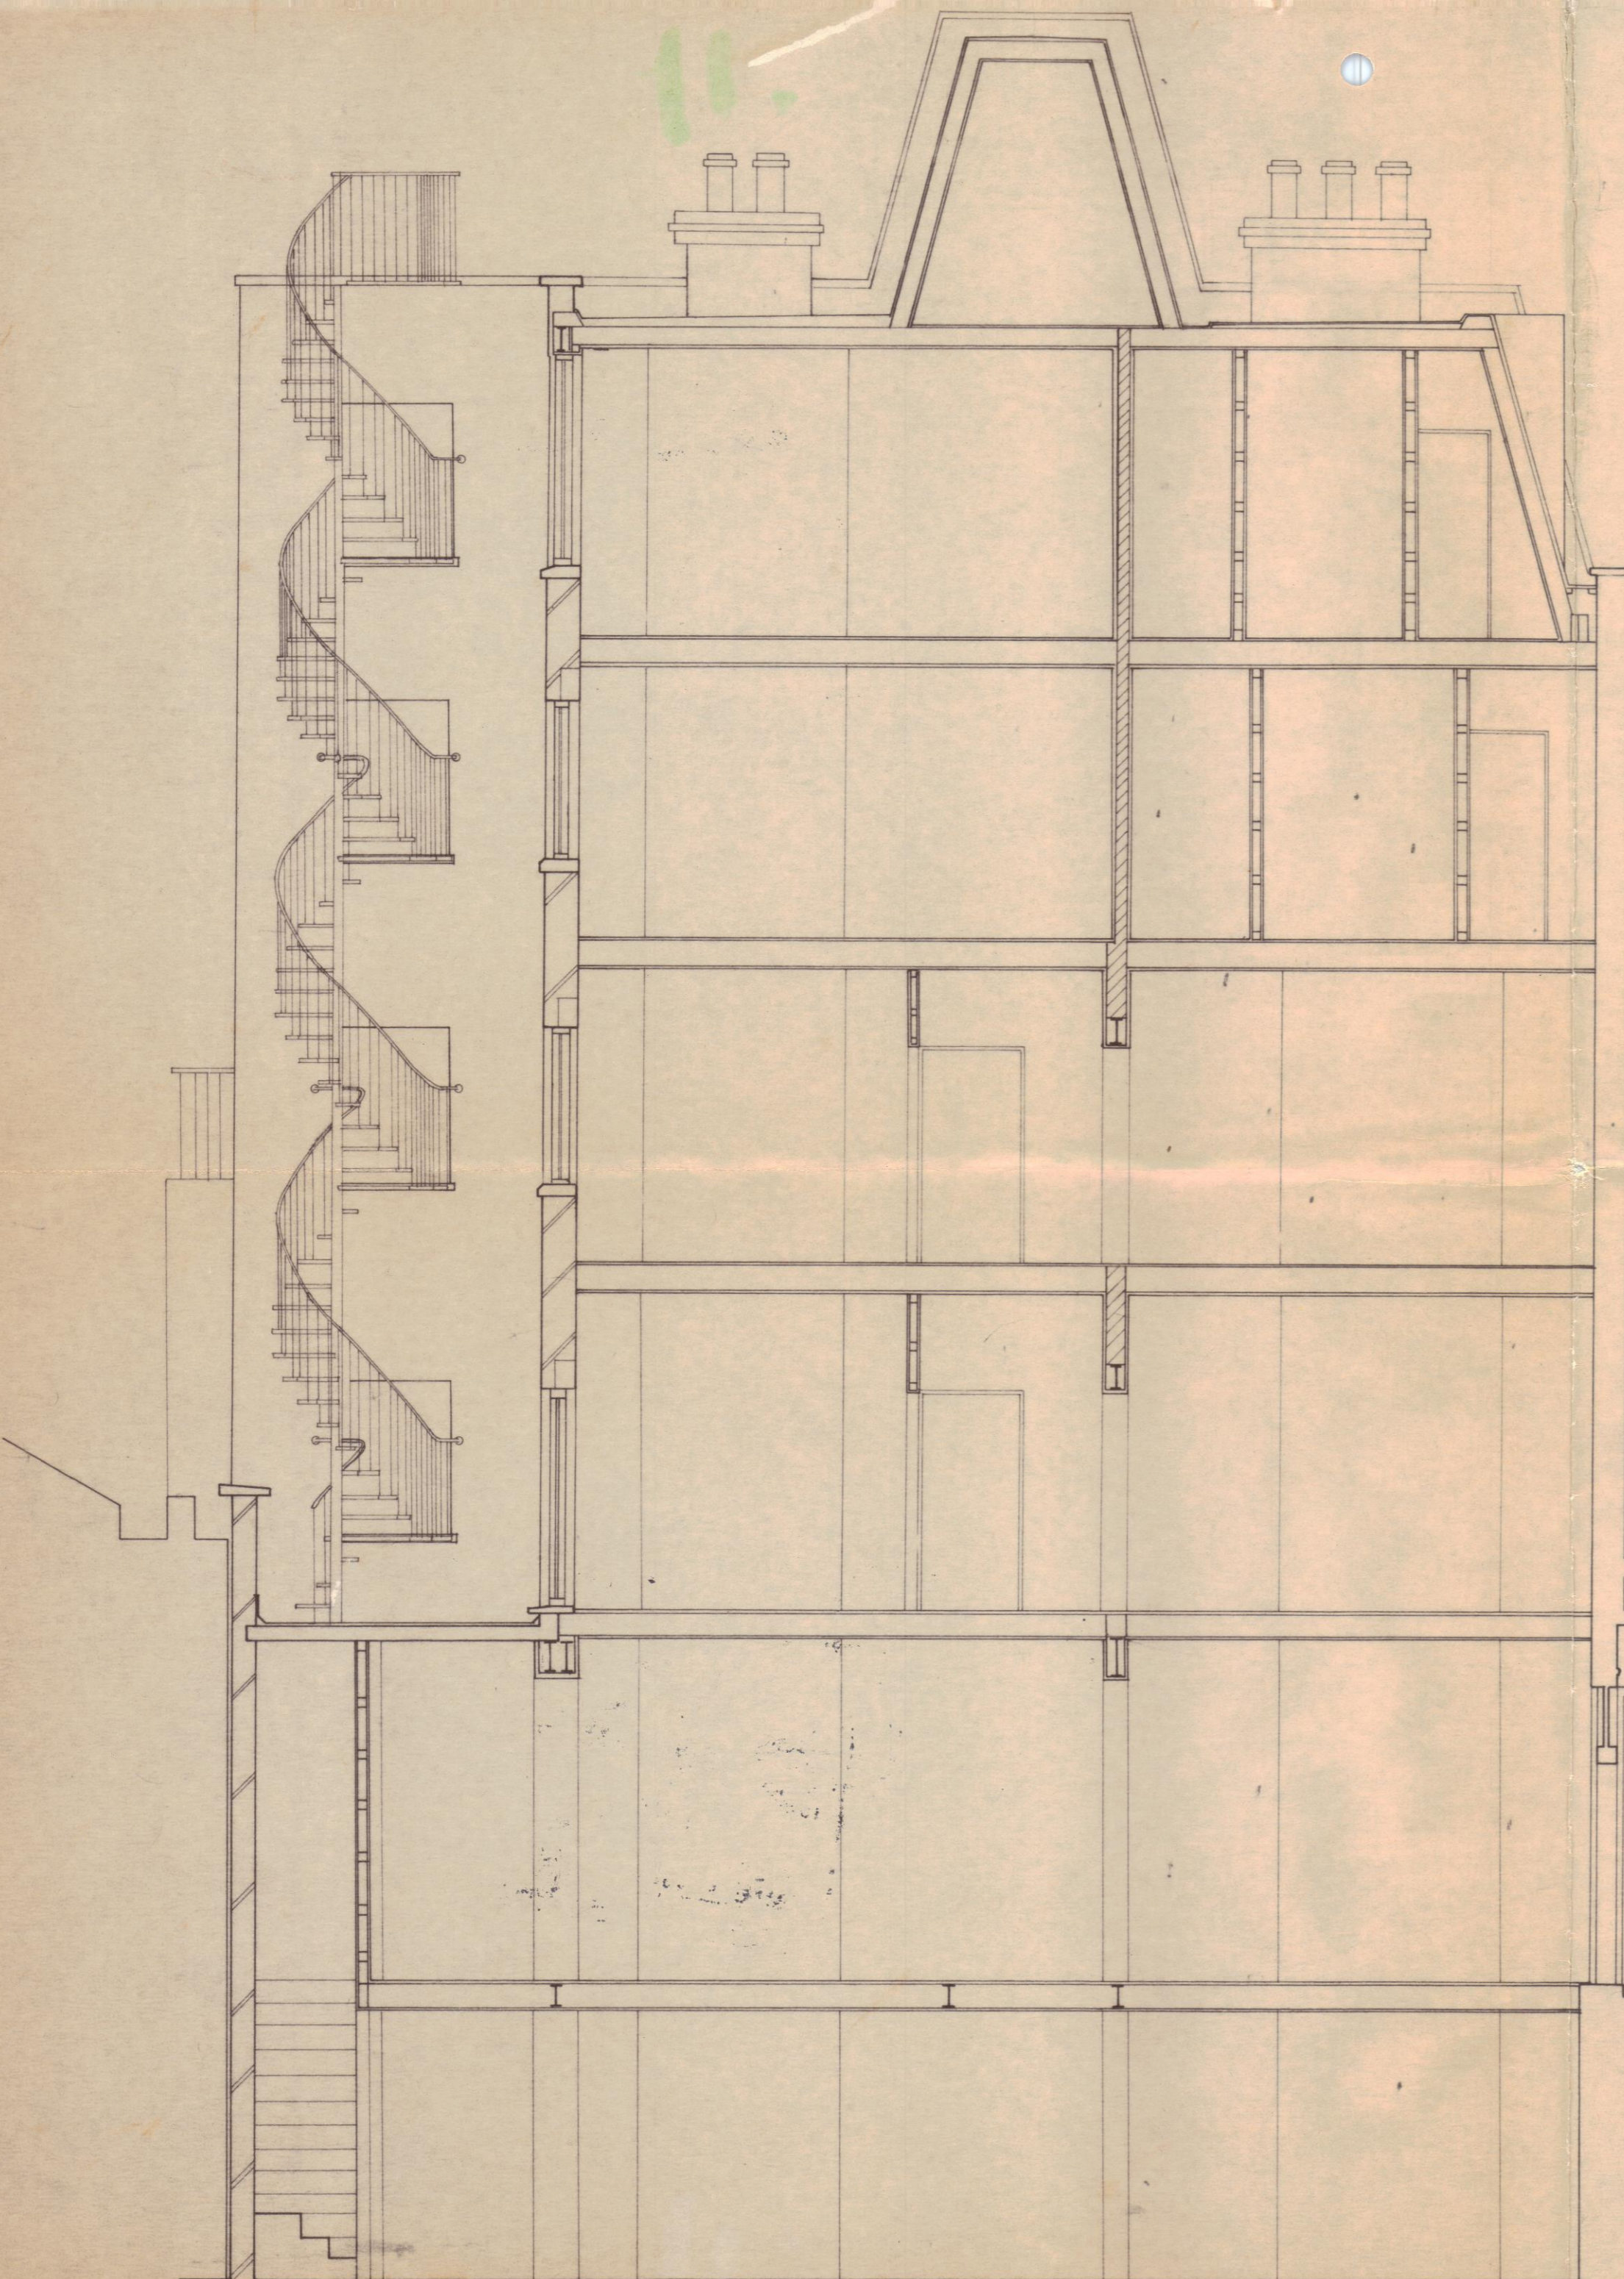

LONDON BOROUGH OF CAMDEN  
TOWN AND COUNTRY PLANNING ACTS  
-3 OCT 1984  
~~APPROVED~~  
PLANS NOT APPROVED  
ON BEHALF OF THE COUNCIL

Revisions

P14/55/D/  
PL/8400200 +  
HB/8470100

LONDON BOROUGH OF CAMDEN  
TOWN AND COUNTRY PLANNING ACTS  
29 MAY 1984  
~~APPROVED~~  
PLANS NOT APPROVED  
ON BEHALF OF THE COUNCIL

NEAL STREET

Project 35/37 NEAL STREET W.C.2.				Title SECTION			
Scale 1:50	Date MAY '83	Drawn APT	Checked	Job No. 232	Drawing No. PA-91	Revision A	Date Issued

Douglas Paskin Associates

7 Cliff Road Studios London NW19AN 01-485 1114