





DENOTES AREA OF PROPOSED NETTING TO PREVENT AND RESTRAIN DEBRIS FALLING.
NETTING TO BE HUCK 45mm Mesh Fall Arrest Net with Debris Overlay & Border Rope (PRODUCT ID: 1903D-045) STRAPPED
TIGHT AND SECURED TO BRICKWORK WITH EXCALIBUR M8 SCREWBOLTS M8 EYB 06 / 050 AT MAX 500mm ctrs.
Dry fix into pre-drilled holes located centrally through bricks to manufacturer recommendations.



22897.2mm

approx.

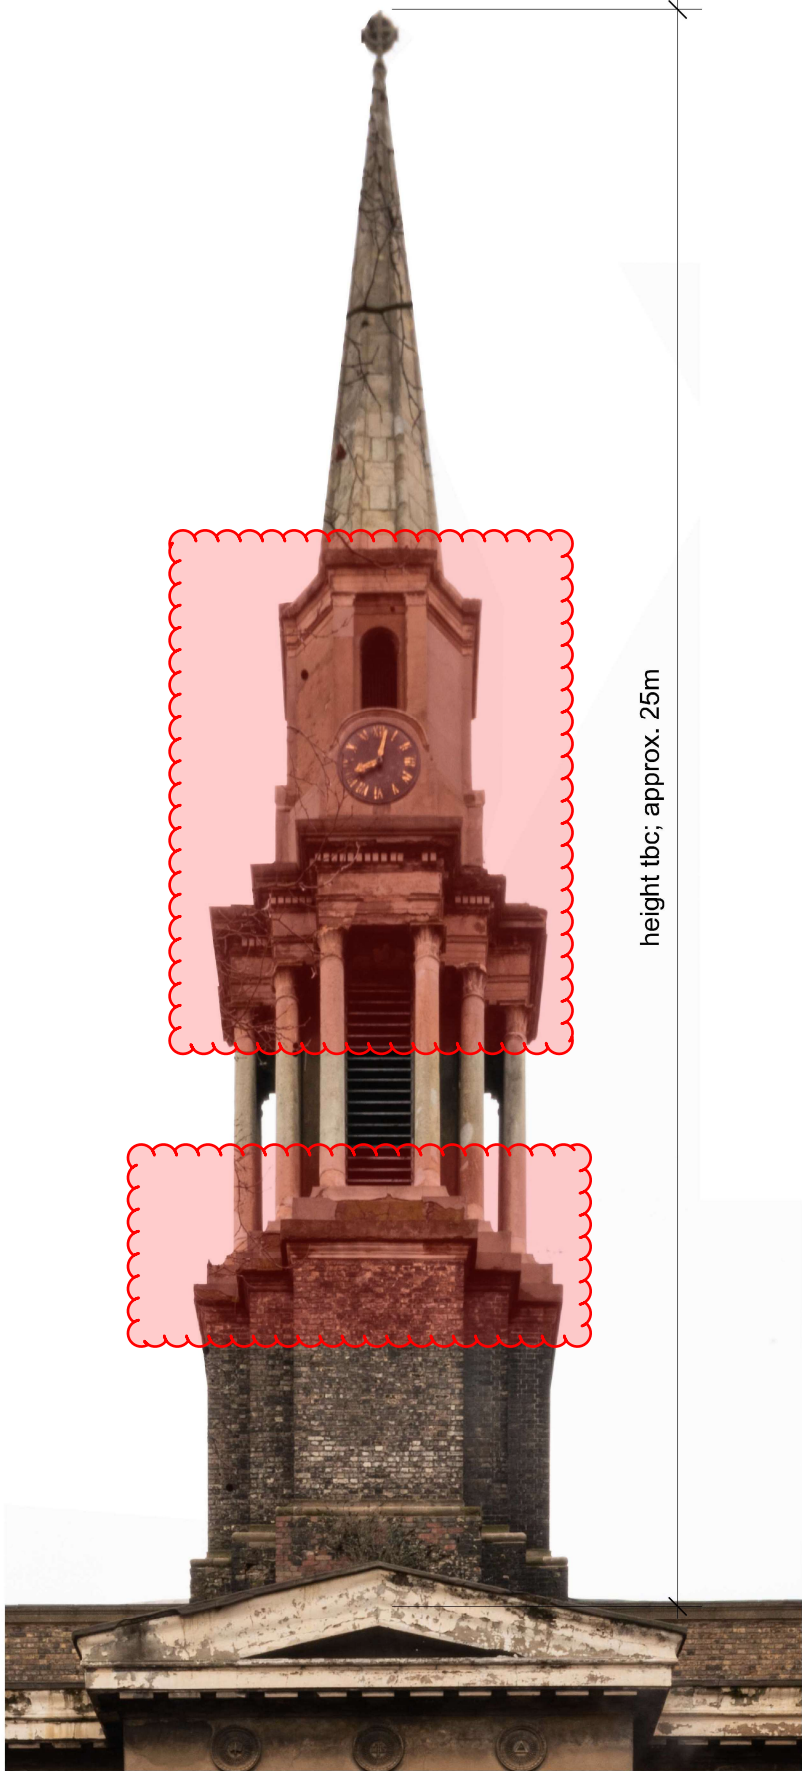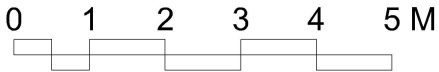

height tbc; approx. 25m

CONISBEE MARK-UP
200468-S-SK-02 29/01/2021

Revisions

--	--	--	--

Notes DO NOT SCALE - Use Figure
Dimensions Only IF IN DOUBT - ASK

--

St George's Cathedral
1-3 Redhill Street,
London NW1 4BG

Elevation
South - As Existing

ROGER MEARS ARCHITECTS LLP
Union Chapel, Compton Avenue London N1 2XD
rma@mears.co.uk tel 020 7359 8222
www.mears.co.uk

Date	Scale	Job No.	Code	Dwg No.
25.01.2021	1:100@A3	2014	-	32-