


3AFL Existing plan and elevation

Existing with demolitions approved under 2020/4357/P

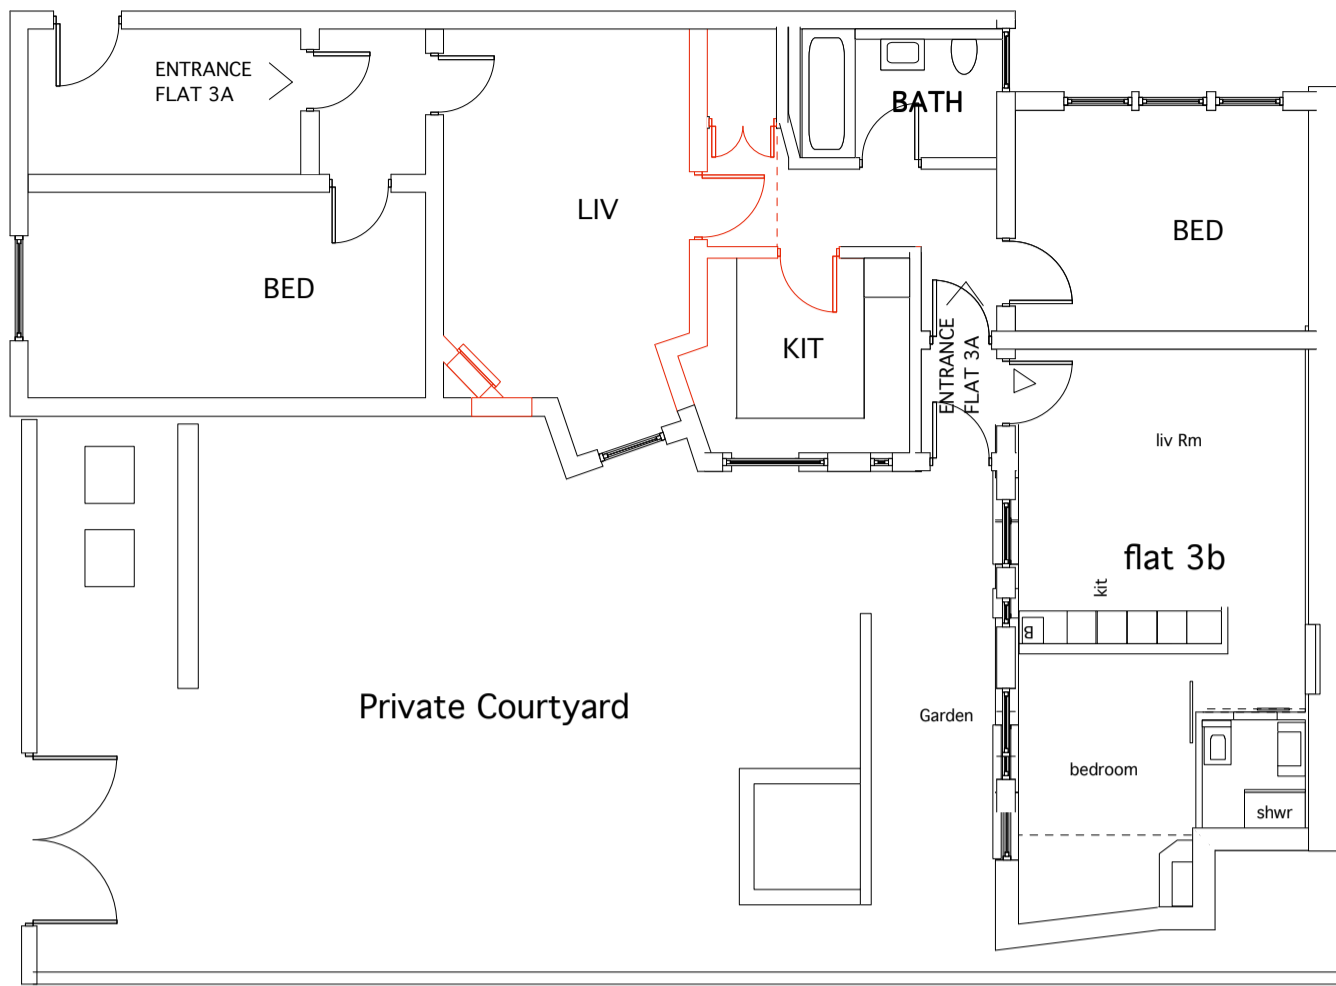

Existing plan

Red lines denote proposed demolition



Existing courtyard elevation (Noth)

Note: window previously approved for this position

0 1 2 3m

scale 1:100

FLAT 3A
FITZROY LODGE