



1 AS BUILT PASSAGEWAY ELEVATION
1:50 @ A1

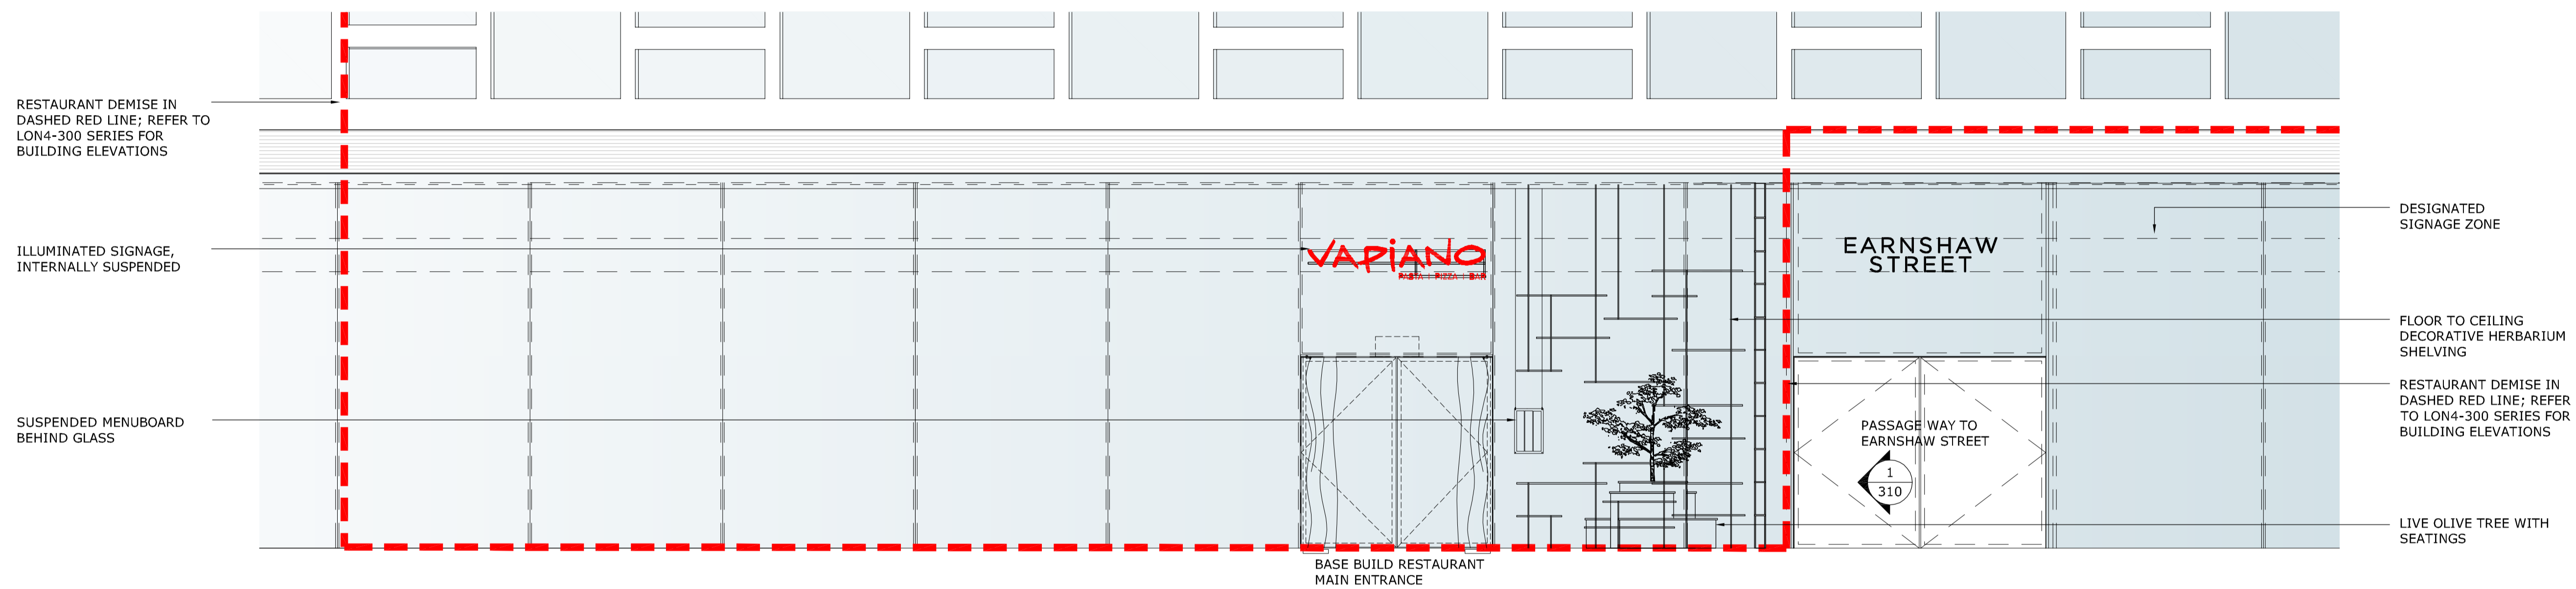

2 AS BUILT SHOPFRONT ELEVATION
1:50 @ A1

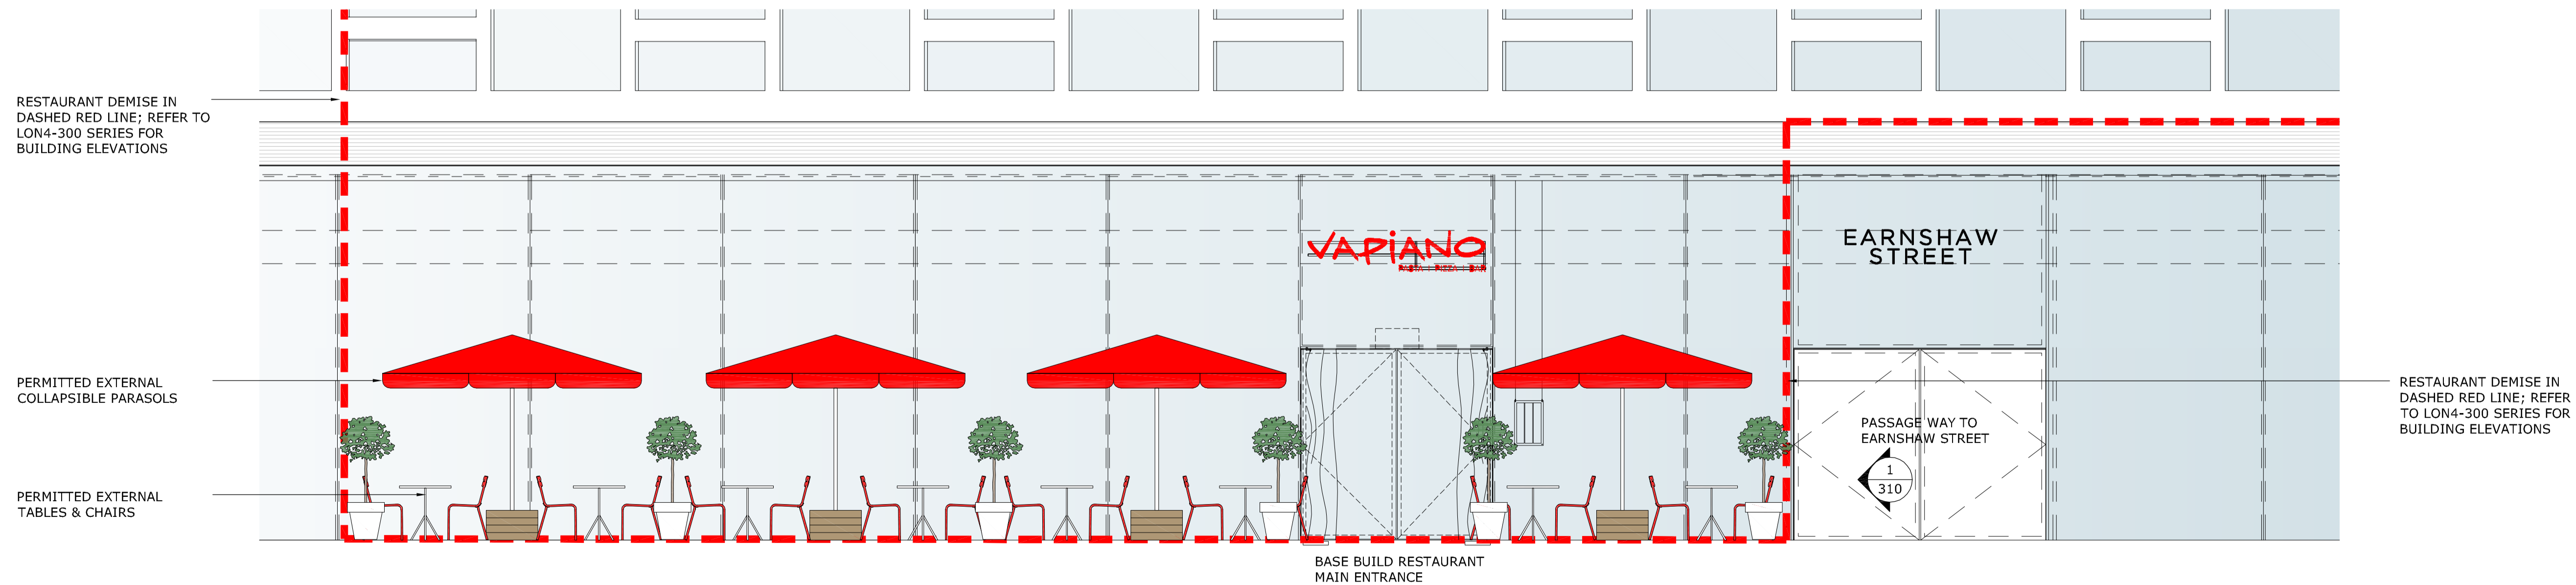

3 PERMITTED EXTERNAL SEATING
1:50 @ A1

GENERAL NOTES:
DO NOT SCALE FROM THIS DRAWING
ALL DIMENSIONS TO BE CHECKED ON SITE
ANY OMISSIONS OR DISCREPANCIES TO BE REPORTED TO THE ARCHITECT IMMEDIATELY
IF IN DOUBT ASK

P1	16.03.21	LISTED BUILDING CONSENT	FG
REV	DATE	NOTES	DR
DRAWING STATUS			

PLANNING

CLIENT
VAPIANO®

ARCHITECT
FINKERNAGEL ROSS
Third Floor
Unicorn House
221-222 Shoreditch High Street
London E1 6PJ
Tel: 020 7377 5114
info@finkernagelross.com
www.finkernagelross.com

PROJECT
**VAPIANO LONDON 4
CENTRE POINT
LONDON WC2H**

DRAWING TITLE
**AS BUILT SHOPFRONT
& PASSAGEWAY ELEVATIONS**

DRAWN	DR. DATE	CHECKED	CH. DATE
FG	03.03.21	FF	12.03.21

SCALE	SHEET SIZE
1:50 @ A1	A1

DRAWING NO	REVISION
VAP-LON4-310	P1