



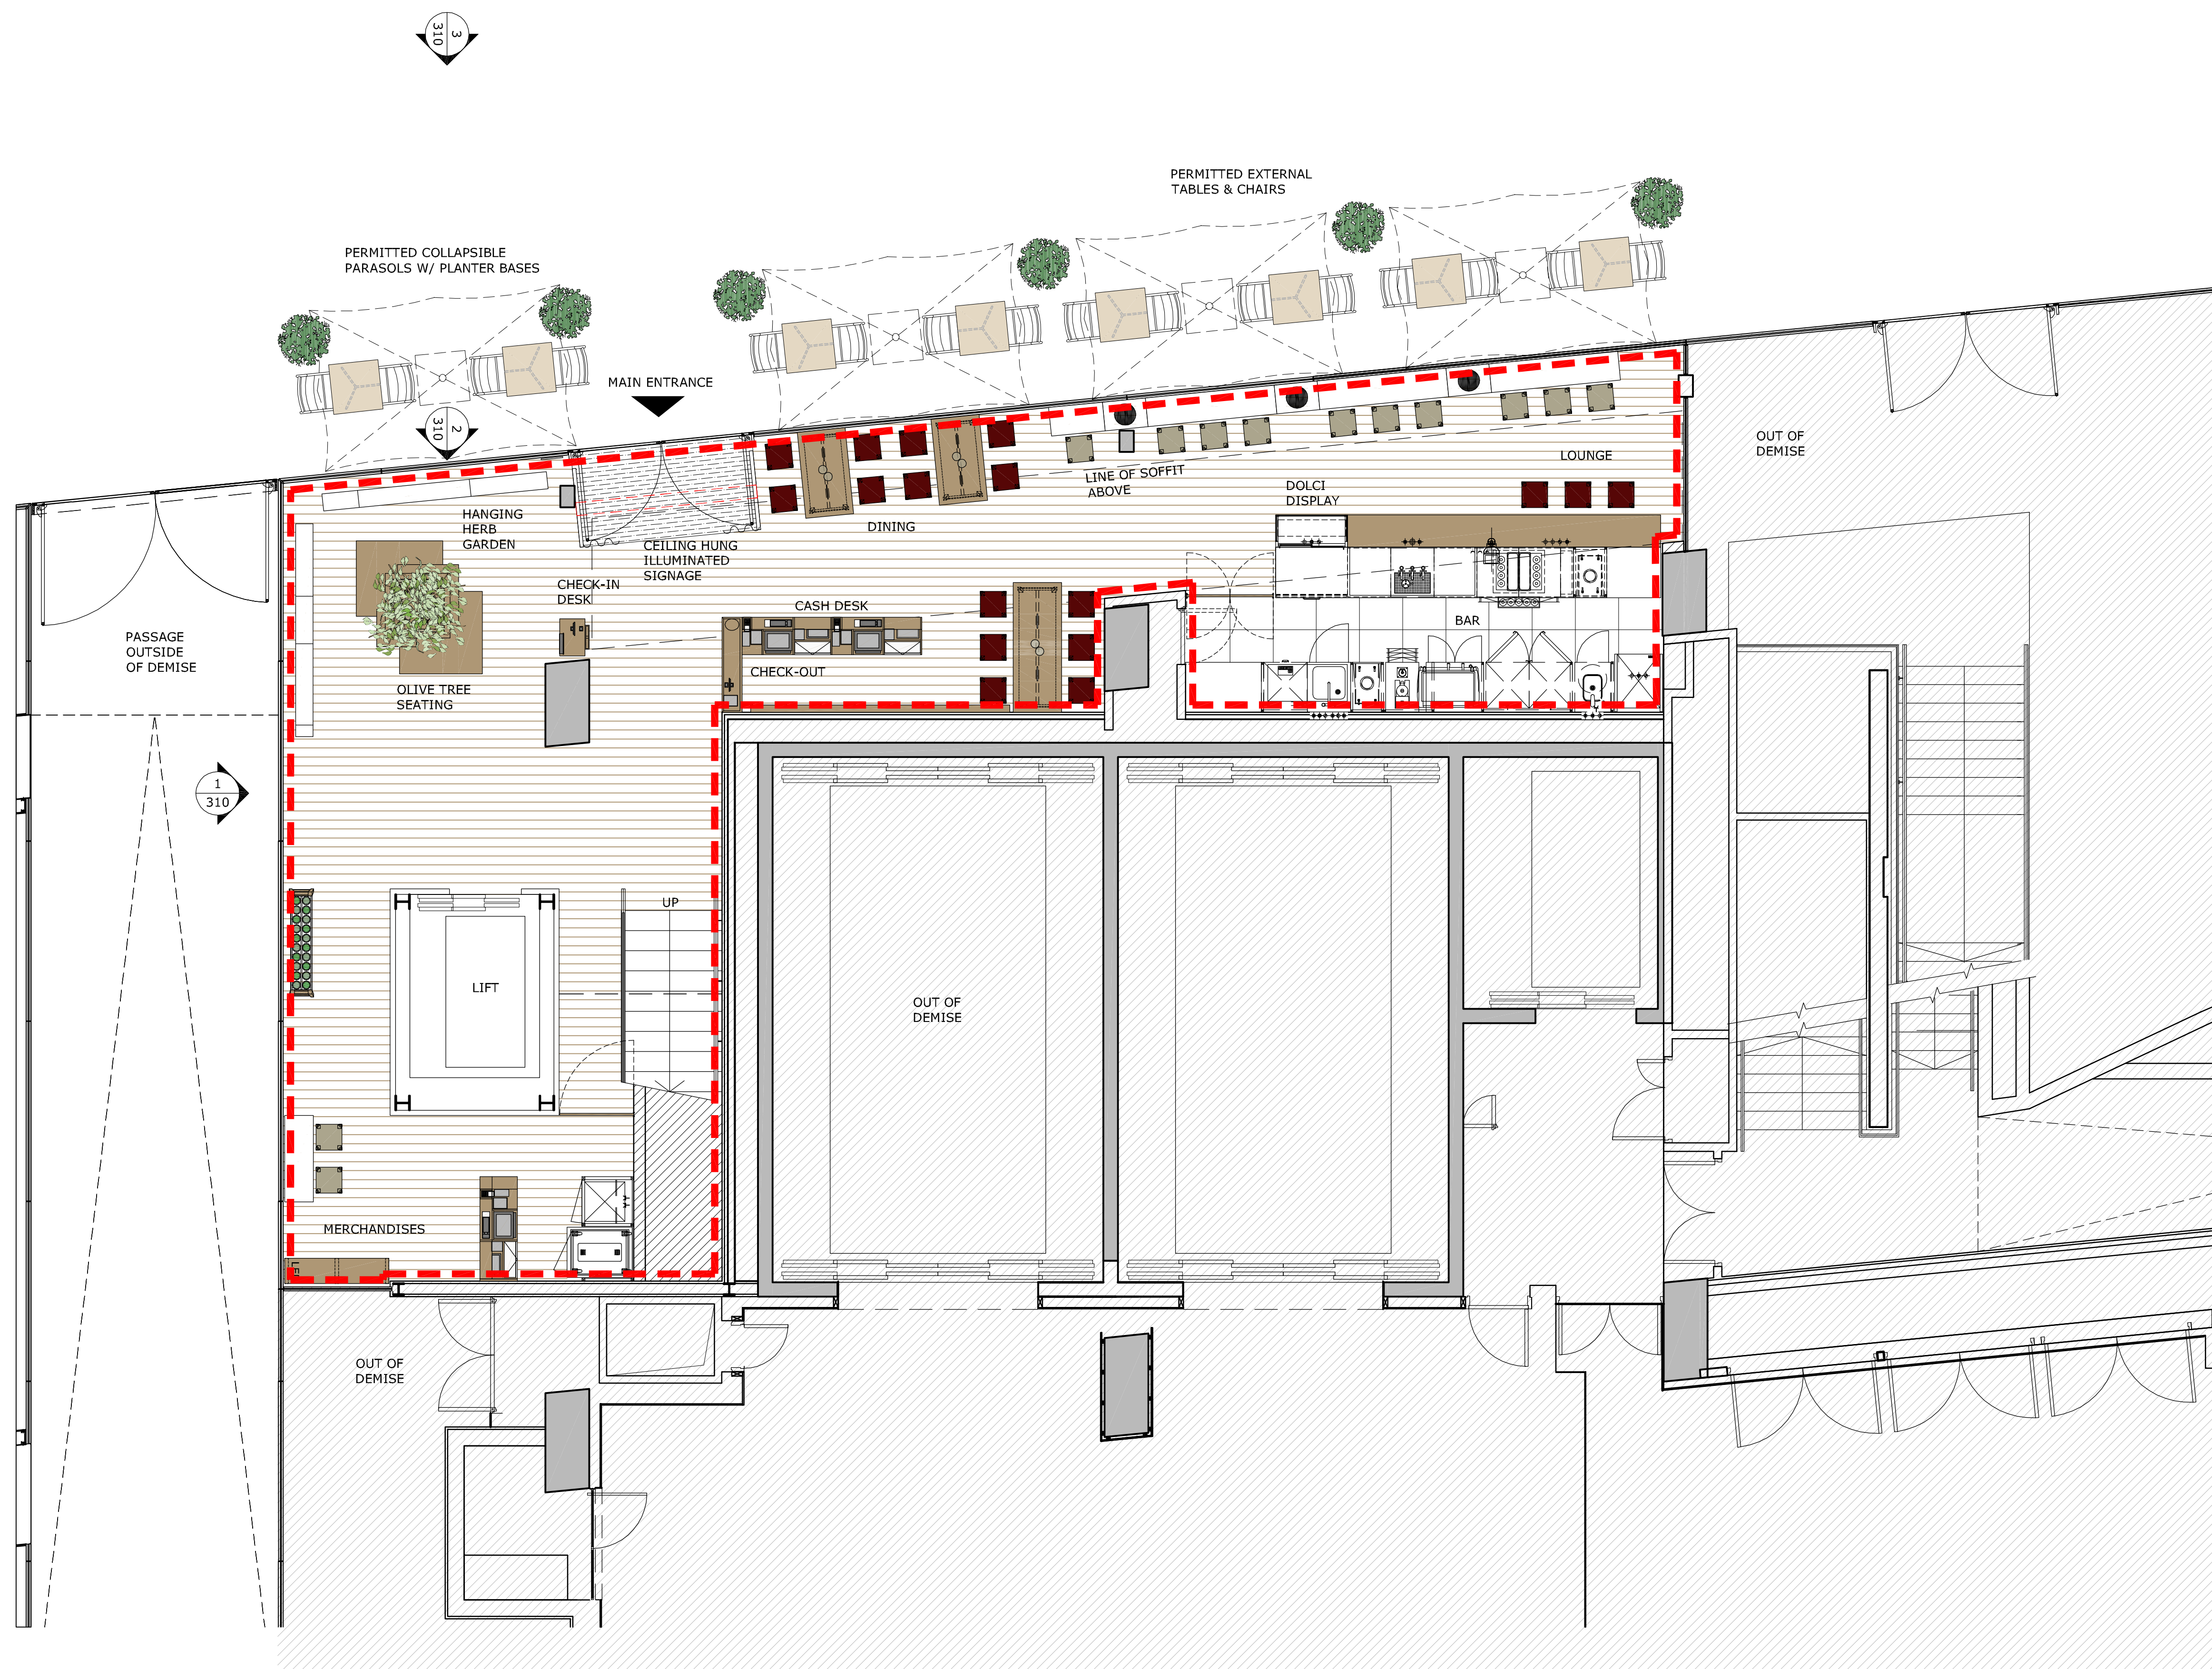

1 AS BUILT GROUND FLOOR PLAN
1:50 @ A1

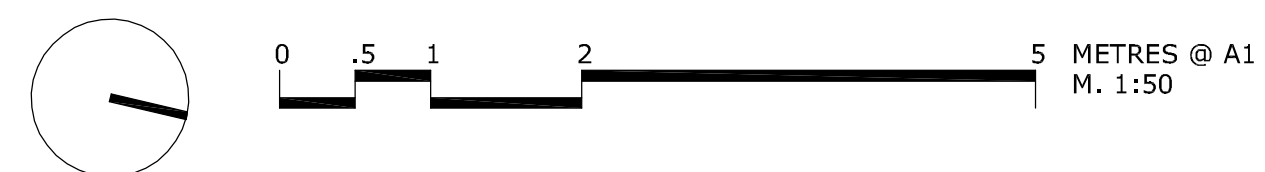

GENERAL NOTES:

ALL DIMENSIONS TO BE CHECKED ON SITE
ANY OMISSIONS OR DISCREPANCIES TO BE
REPORTED TO THE ARCHITECT IMMEDIATELY
IF IN DOUBT ASK

P1 16.03.21 LISTED BUILDING CONSENT FG
REV DATE NOTES DR
DRAWING STATUS

PLANNING

CLIENT

VAPIANO®

ARCHITECT

FINKERNAGEL ROSS

Third Floor
Unicorn House
221-222 Shoreditch High
Street
London E1 6PJ
Tel: 020 7377 5114
info@finkernagelross.com
www.finkernagelross.com

PROJECT

VAPIANO LONDON 4
CENTRE POINT
LONDON WC2H 8TA

DRAWING TITLE

AS BUILT GROUND FLOOR
FLOOR PLAN

DRAWN	DR. DATE	CHECKED	CH. DATE
FG	03.03.21	FF	12.03.21

SCALE	SHEET SIZE
1:50	A1

DRAWING NO	REVISION
VAP-LON4-120	P1