


All single glazed windows to be replace like for like for double glazed ones.

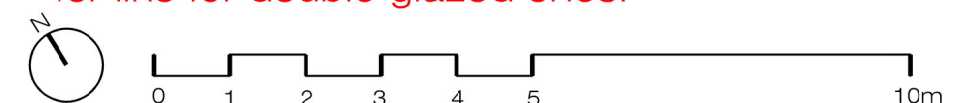

PLEASE NOTE:

- All dimensions to be checked on site before fabrication.
- Contractor to refer to engineers drawings before proceeding with works.
- All drawings and designs are covered by design right (intellectual property), and may not be distributed, copied or issued without written permission by the Architect.
- All design concepts are the sole property of the Architect and no adaptations, reproductions or copies may be made without written permission of the Architect.
- These drawings are subject to any variation required or recommendation by any statutory authority, or for the better carrying out of the works.
- Samples to be provided by contractor for XUL Architecture's approval.
- All finishes to XUL Architecture's satisfaction.
- All drawings to be approved by XUL Architecture prior to construction.

ADDITIONNAL NOTE:

Issue key:

Information (I)	Project Address	Issue For:
Planning (P)	35 Greville Road, NW6 5JB	PLANNING
Tender (T)	Scale 1:100@A3	PROPOSED
Construction (C)	Rev. Date 17.03.21	Plan
As Built (B)	Drawn TP	Dwg. No. PA-02 Rev. P-02
	Checked SL	Project Number 19115