
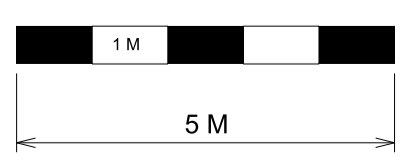


KEY	REV	DATE
	00	23/12/15 Issued for Stage 2

 Appraised area of granite sets, to be lifted, cleaned and reused. Extent to be ascertained by contractor.

Markup by BBUK Studio Ltd, 201117




CONSULTANTS	
CLIENT:	DUKELEASE PROPERTIES LTD.
CONTRACTOR:	-
STRUCTURAL ENGINEER:	ECKERSLEY O'CALLAGHAN
SERVICES ENGINEER:	MIT LTD.
COST CONSULTANT:	EXIGERE
PROJECT MANAGER:	GVA SECOND LONDON WALL
ACOUSTIC CONSULTANT:	HANN TUCKER ASSOCIATES
CLADDING CONSULTANT:	-
SPECIFICATIONS CONSULTANT:	-

**NOTE**

1. Do not scale from this drawing.
2. All dimensions to be checked on site by the contractor and such dimensions to be his responsibility.
3. Report all drawing errors, omissions and discrepancies to the architect.
4. This document may be issued in an uncontrolled CAD format to enable others to use it as background information to make alterations and/or additions. In that instance the file will be accompanied by a PDF version. It is for those making such alterations and additions to ensure that they make use of current background information.

AHMM Ltd accepts no liability for any such alterations or additions to the background information or arising out of changes to background information which occur prior to alterations of additions being made.

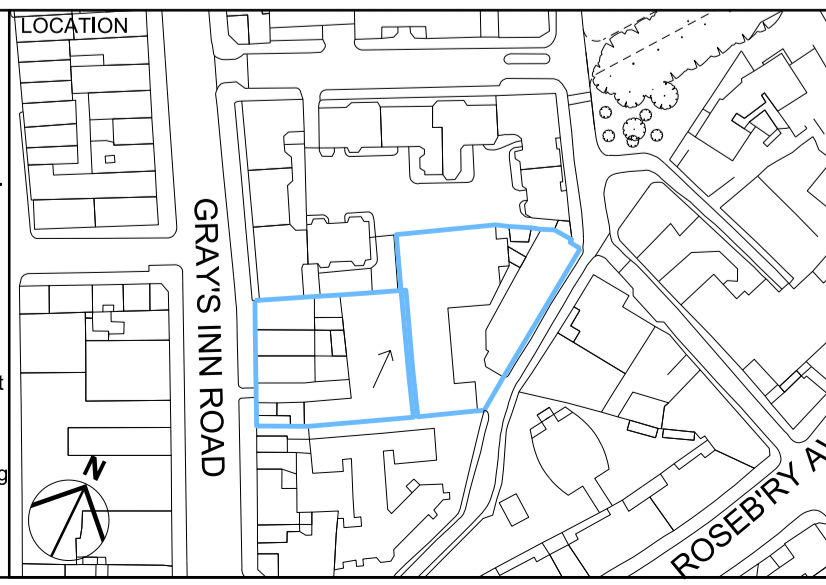

ALLFORD HALL MONAGHAN MORRIS					
ARCHITECTS Ltd MORELANDS, 5-23 OLD STREET LONDON EC1V 9HL TEL 020 7251 5281 FAX 020 7251 5123 WEB WWW.AHMM.CO.UK					
job title 156-164 GRAY'S INN ROAD / PANTHER HOUSE					
drawing title / location EXISTING GROUND FLOOR PLAN EXISTING GA DRAWINGS					
drawn by	checked	scale	status		
MA	LSC	1:100@A1; 1:200@A3	PRELIMINARY		
project	zone	source	classification	drawing no.	revision
14093	A	[01]	100	00	