


FLAT 25

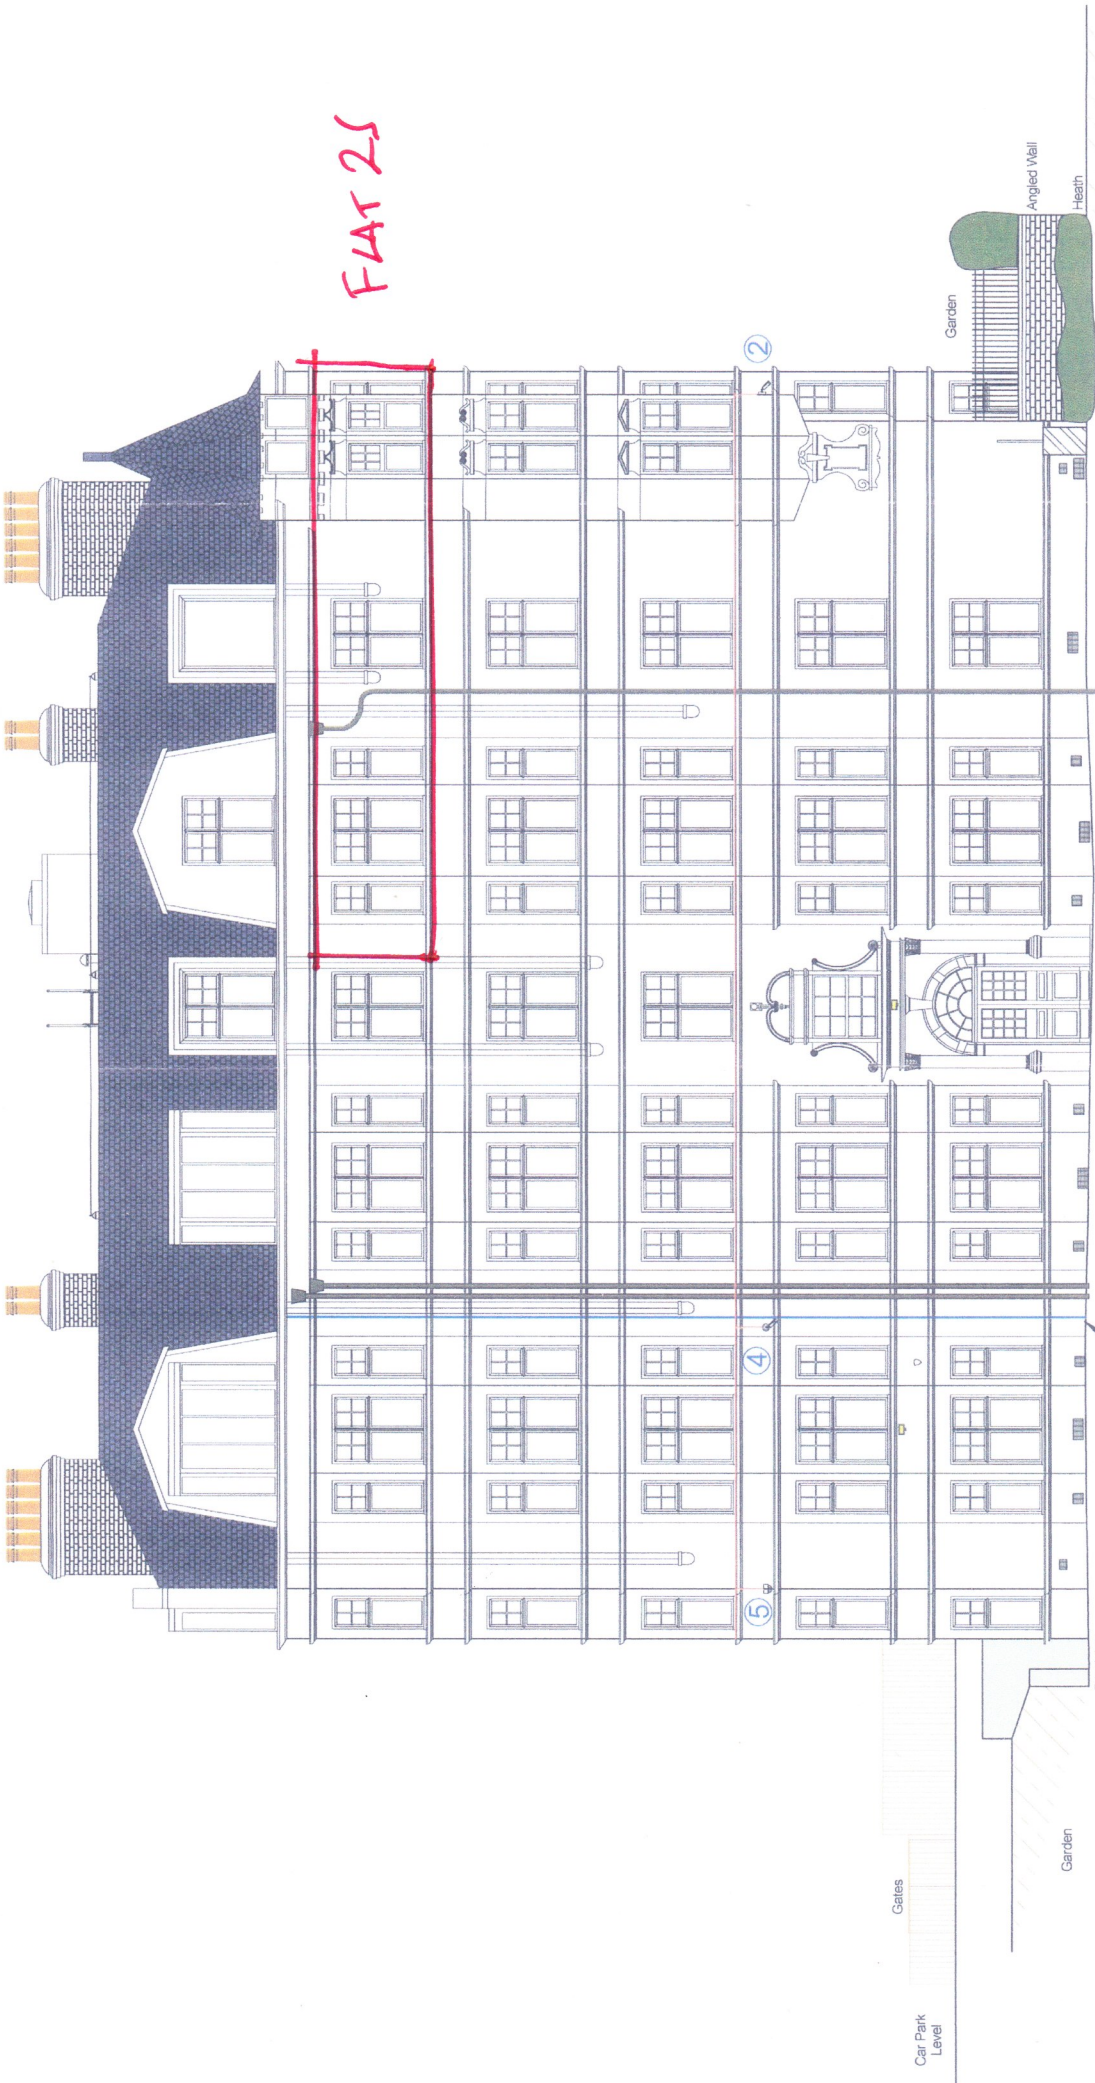

Note:-
 1) The Cable routes are indicative and are concealed on the decorative courses where it was possible

Key
 New Cable
 Previous Camera Position
 Existing Camera
 PIR

North Elevation

Date: Jan 2019
 Scale: 1:100@A3

Client: The Priors LTD
 Location: The Priors NWG 1BS
 Title: Book As Built North Elevation

Chartered building surveyors
 Tel: 020 8905 7505
 Fax: 020 0226 5574
 Symonds Street, London, N1 6EU

northwood
 carlton

Dwg. No.: 14-062EX-03

Planning Application
 2021/0322/P

FLAT 25



Planning Application
2021/0332/P

Note
1) The Cable routes are indicative and are concealed on the decorative courses where it was possible

Key
 - Cable route
 - Pre-existing Camera Position
 - Existing Camera

Date: Jan 2019
 Scale: 1:150@A3

Client: The Poyors LTD
 Location: The Poyors NM3-1BS
 Title: Block A As Built - Proposed West Elevation

RICS
 chartered building surveyors
 100 Abchurch Lane
 London EC4N 3DF
 Tel: 020 8205 1374
 Fax: 020 8205 1374
 Synal House, 422, Epsom Road,
 London, NW6 0HU

northwood
 carter

Dwg. No.: 14-062EX-04

West Elevation