




Internal Room Elevation
Scale: 1:10

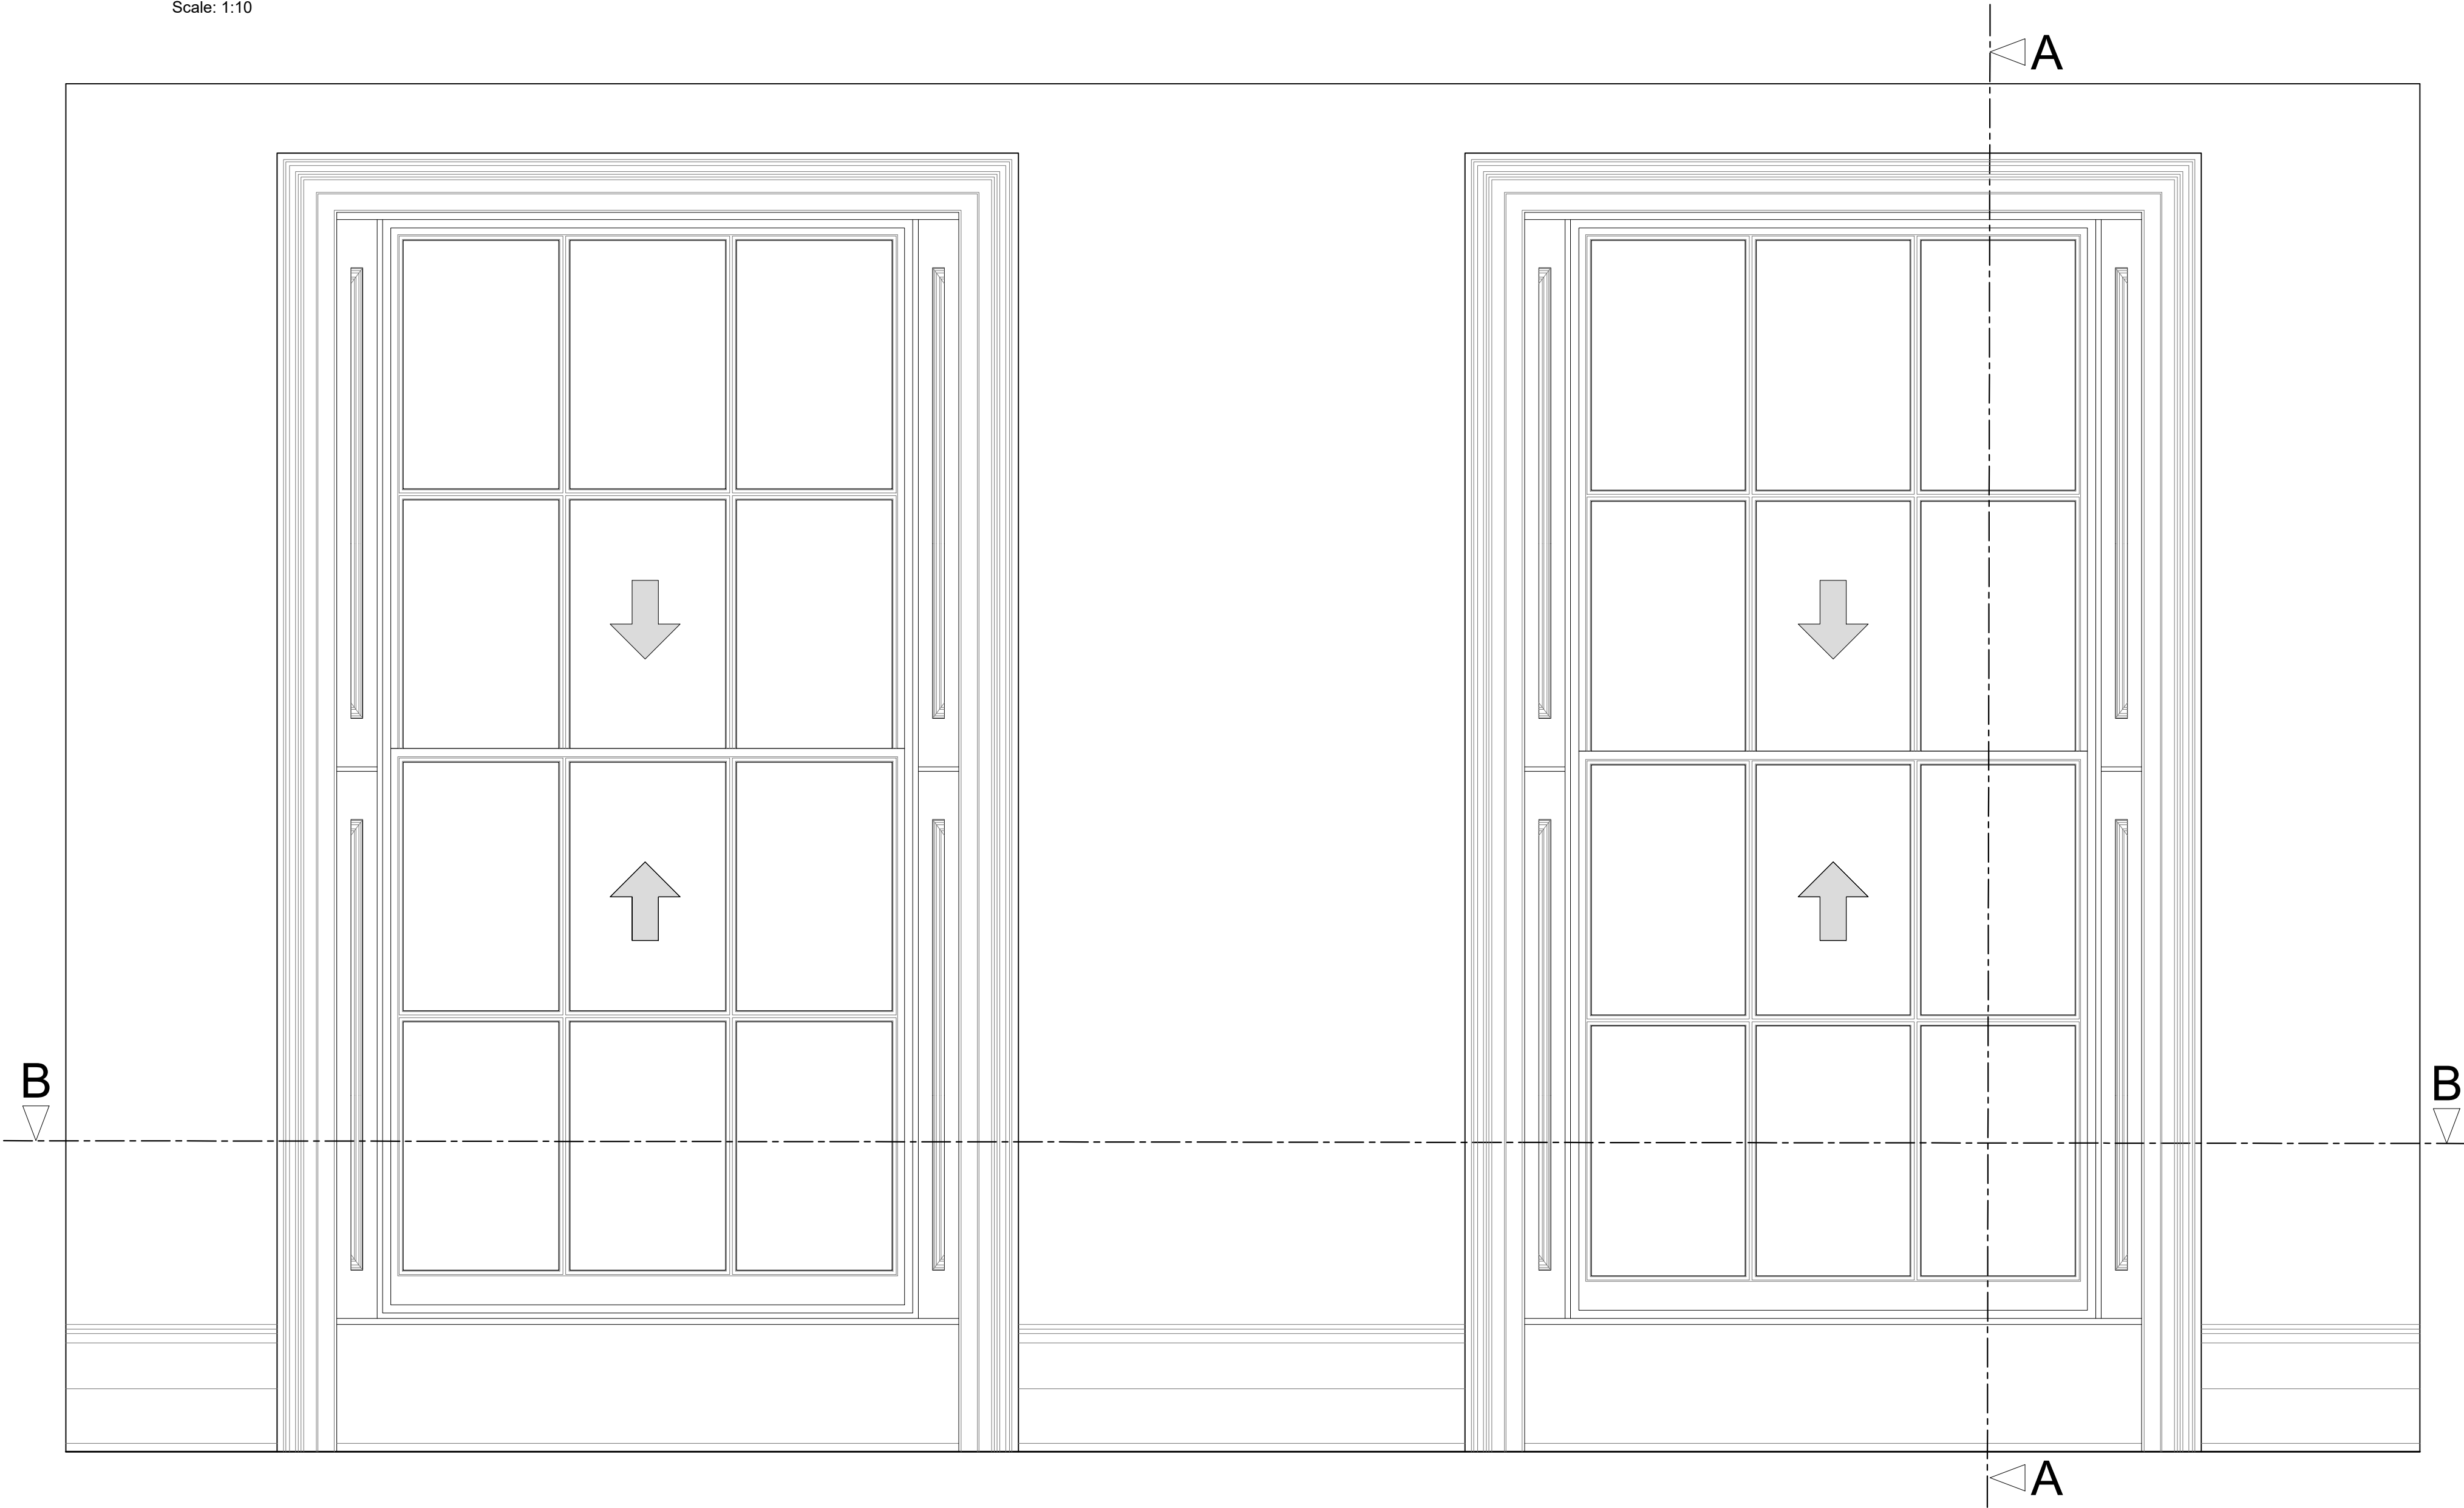

Section A-A through External Wall
Scale: 1:10

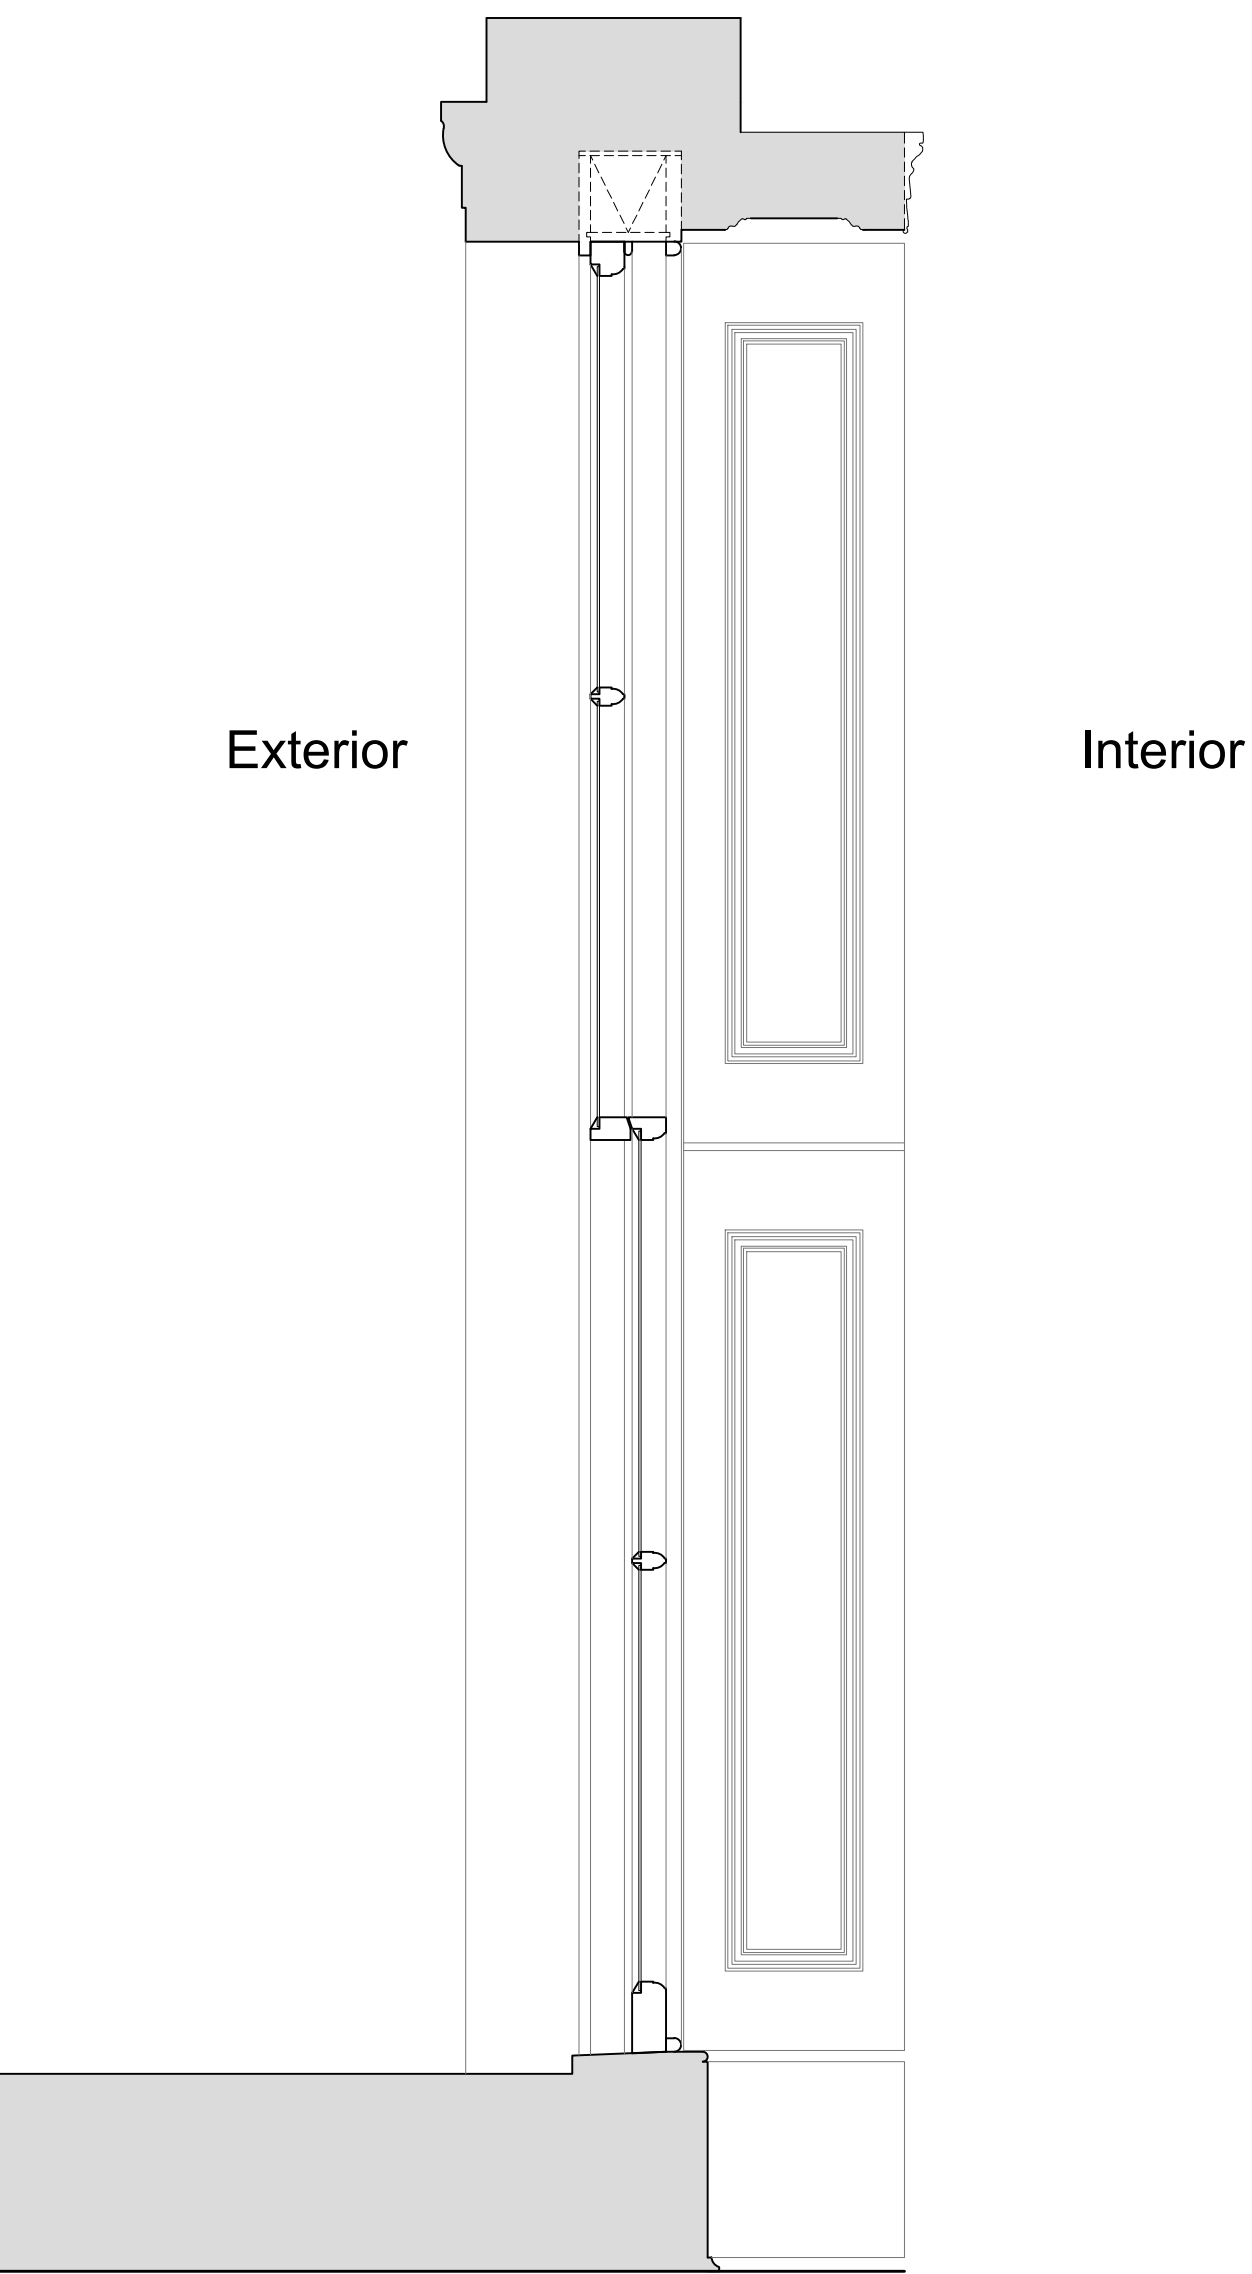

Plan Section B-B
Scale: 1:10

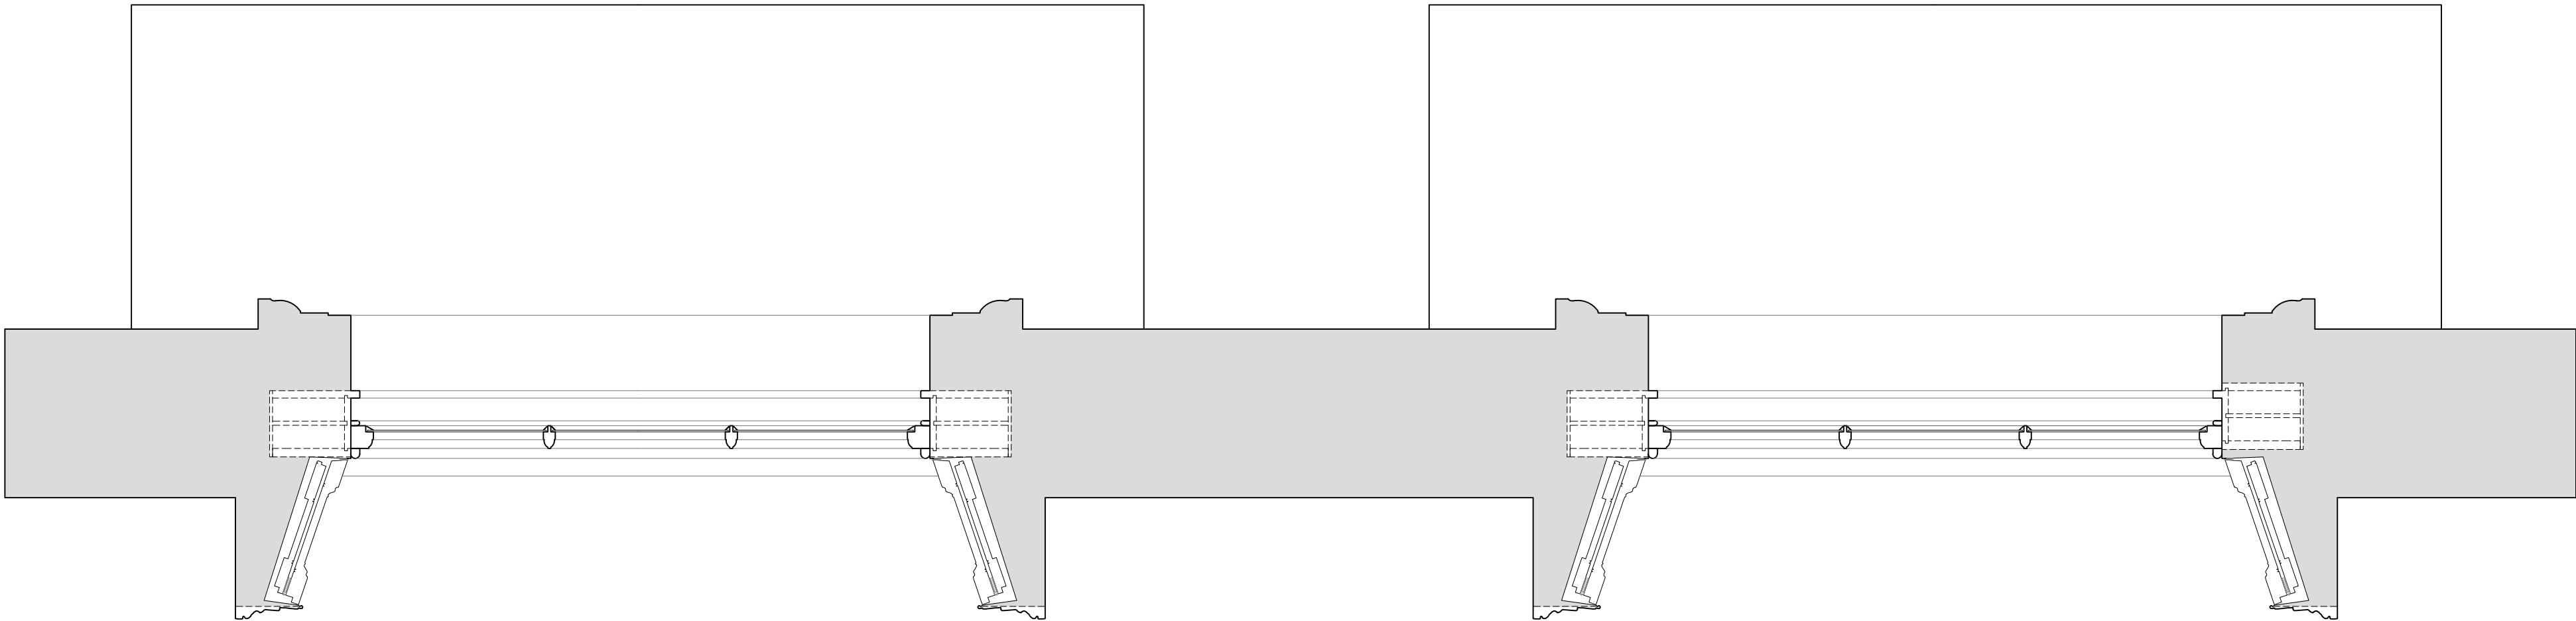

Revision	Date	Amendment
1.0	08-10-2018	Issued for listed building consent application

Do not reproduce this drawing without written permission
All dimensions are in millimetres unless stated otherwise

Drawing Not For Construction

HS2


High Speed (HS2) Limited
25th Floor
One Canada Square
Canary Wharf
London E14 5AB

COSTAIN SKANSKA


Costain Skanska Joint Venture
1st Floor
The Podium
1 Eversholt Street
London NW1 2DN

Site Address: 54 B Delancey Street, London NW1		
Drawing Title: First Floor - Lounge: EXISTING Window Joinery Details - Sheet 1 of 3		
Surveyed by: AP & PB	Drawn by: AP	Checked by: VH
Presentation Scale: as shown @ A1		Revision: 1.0
Date: 27-09-2018	Drawing No: WPI P066 NI - 54B DeS-EX-FF-J-01	


Internal Room Elevation with Secondary Glazing Installed
Scale: 1:10

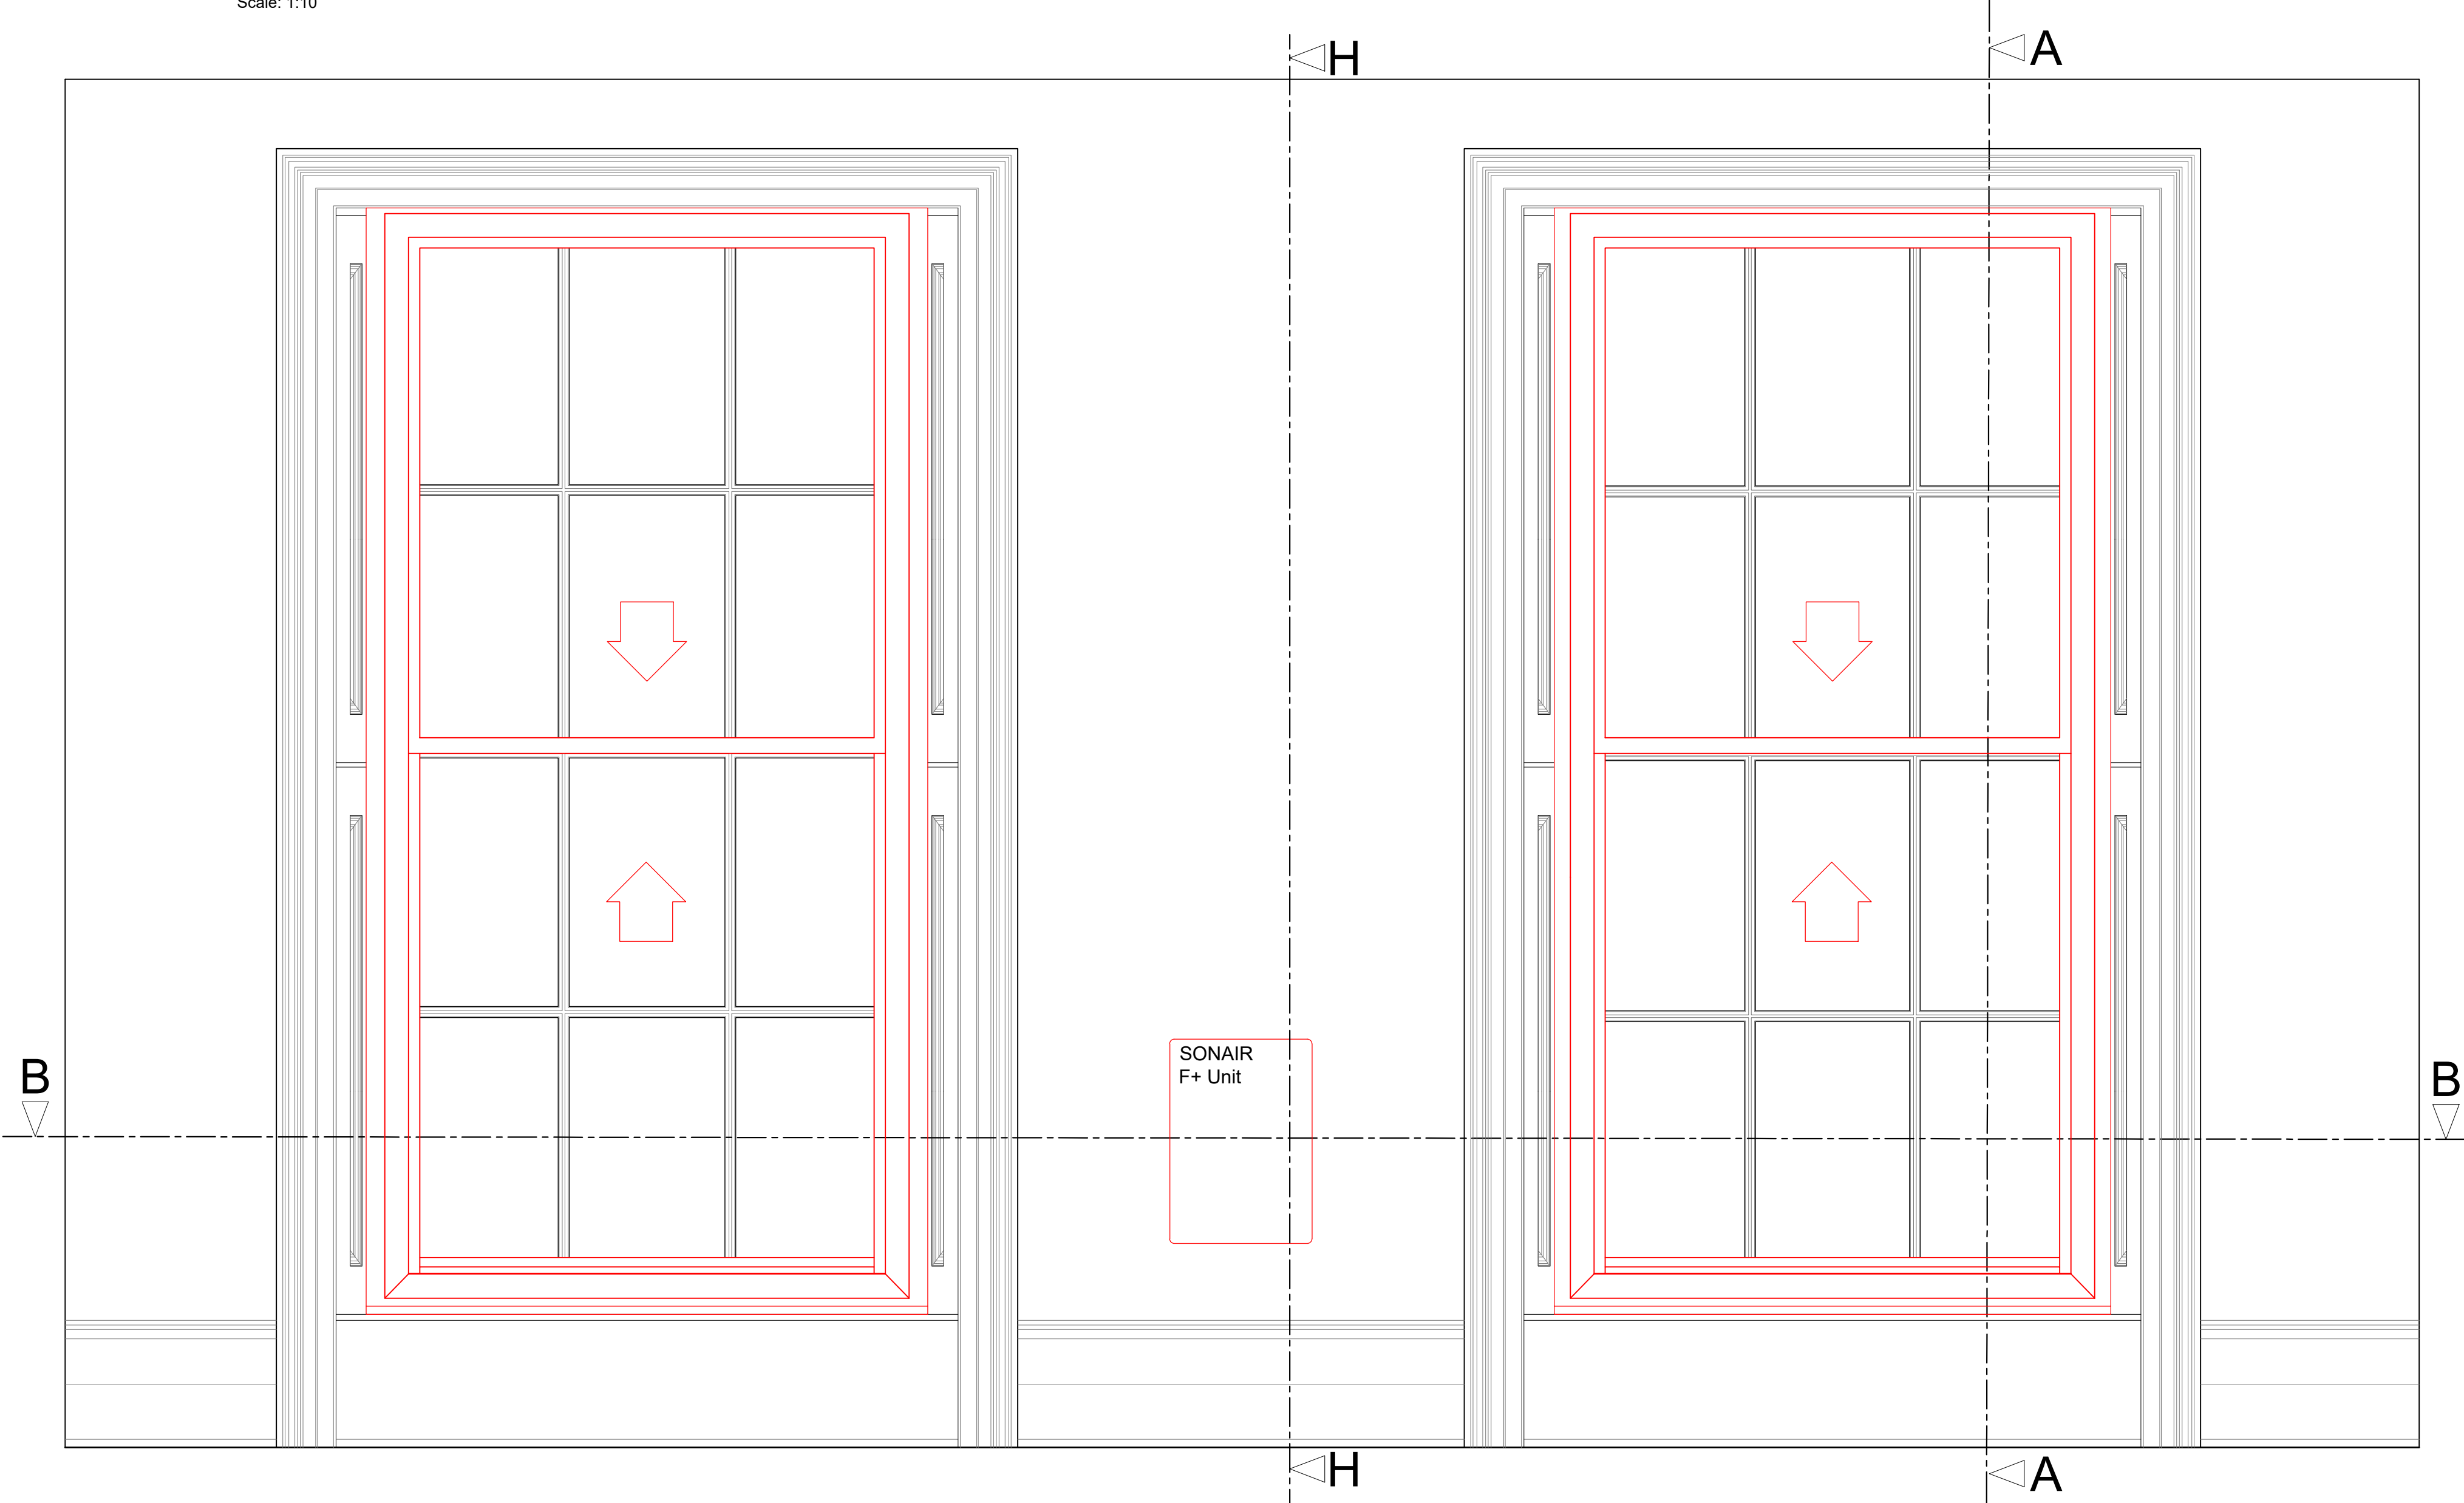


Section A-A through External Wall with Secondary Glazing Installed
Scale: 1:10

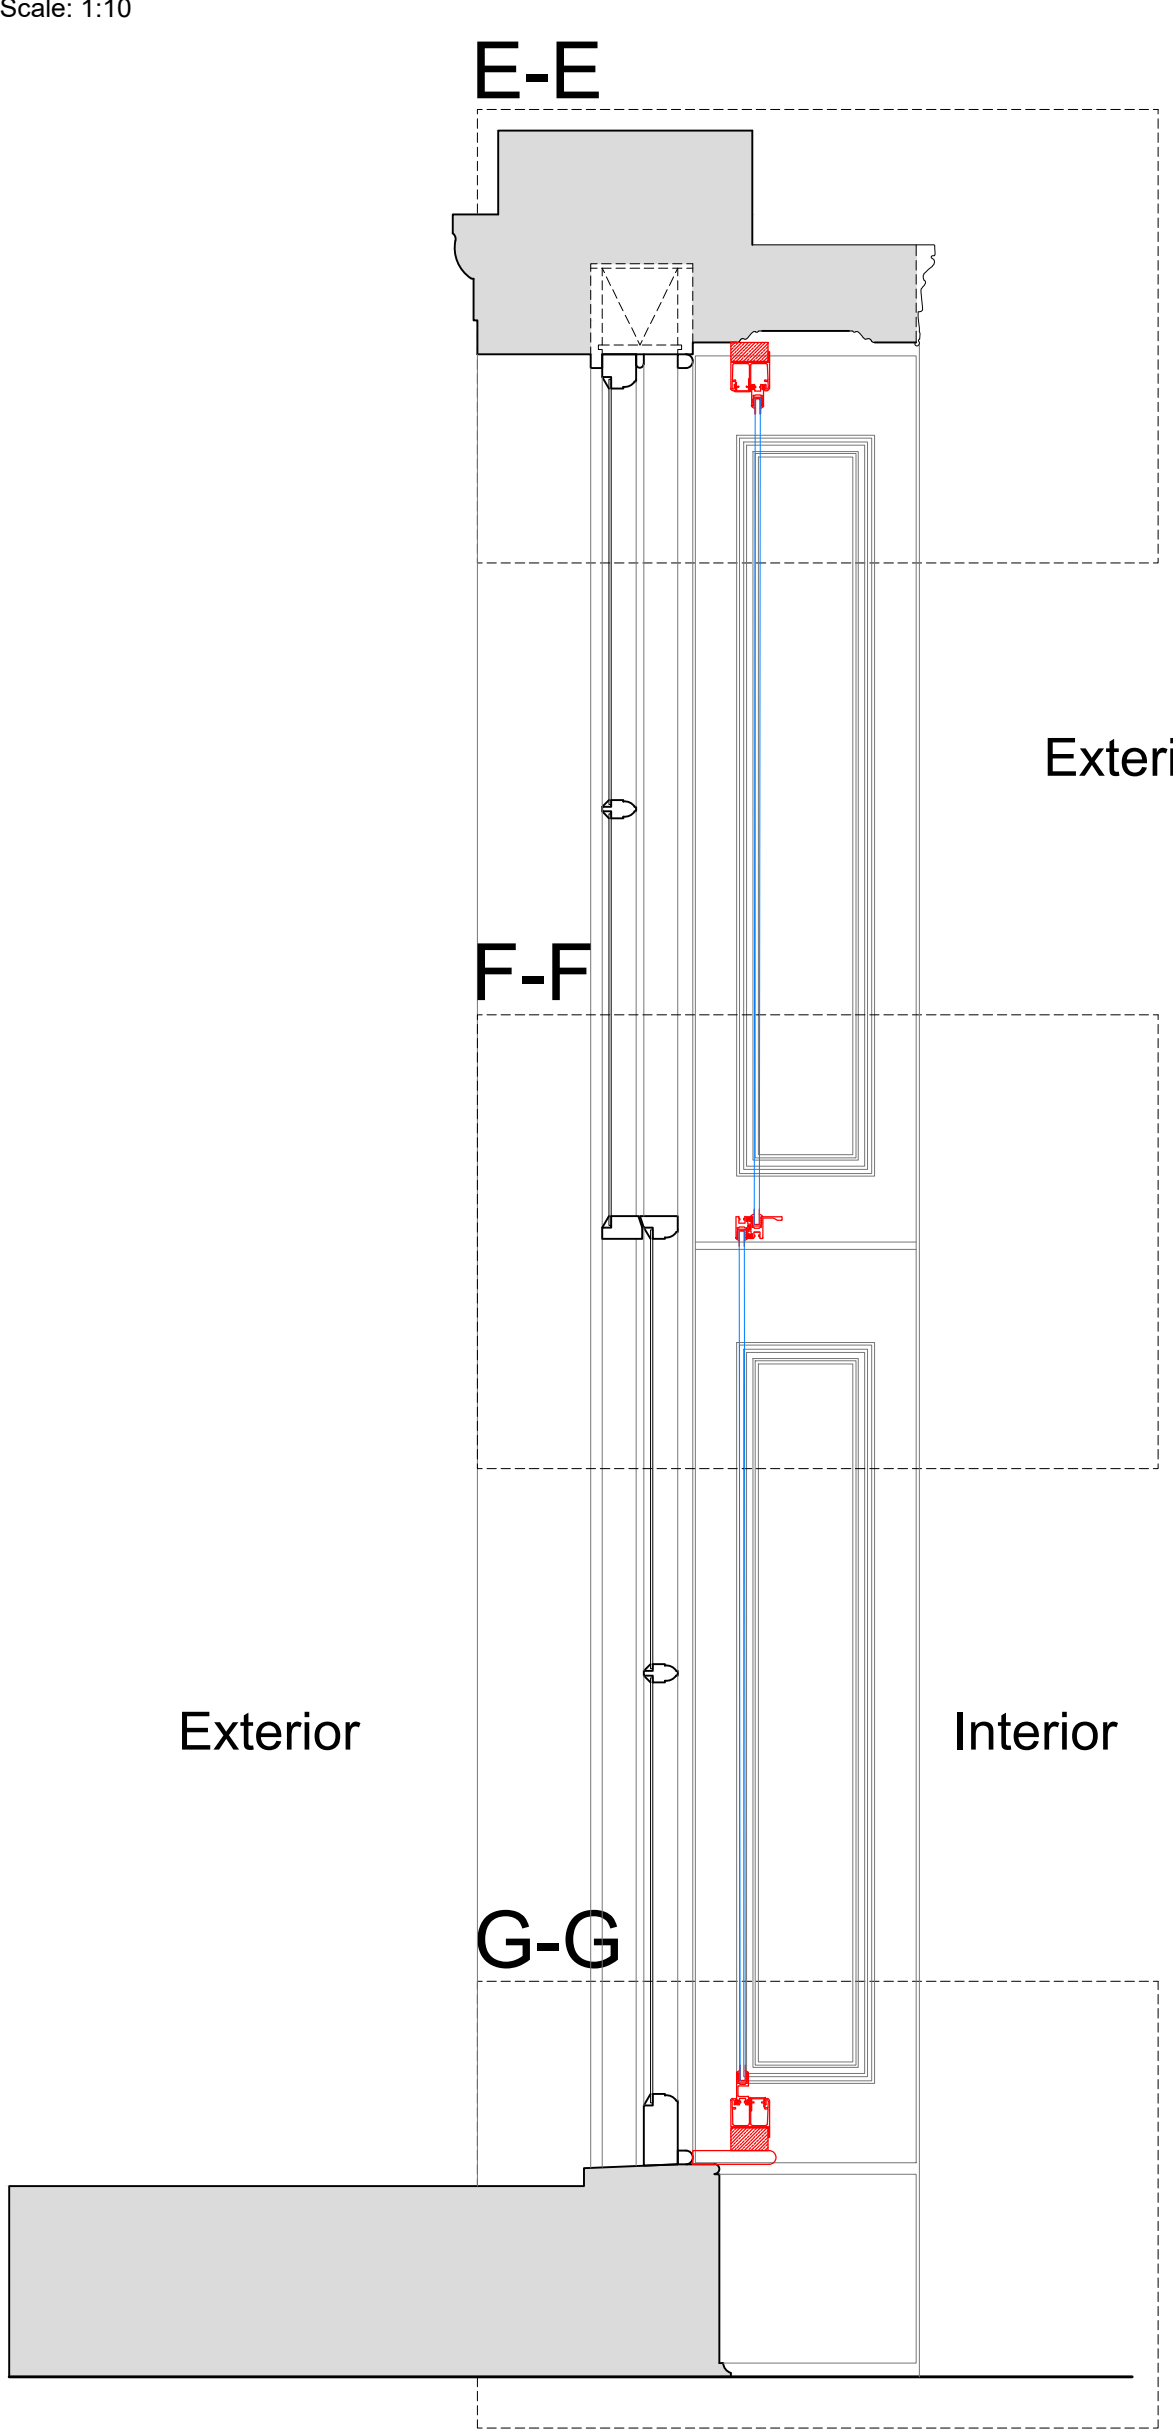


Section H-H through External Wall with Mechanical Ventilation Installed
Scale: 1:10

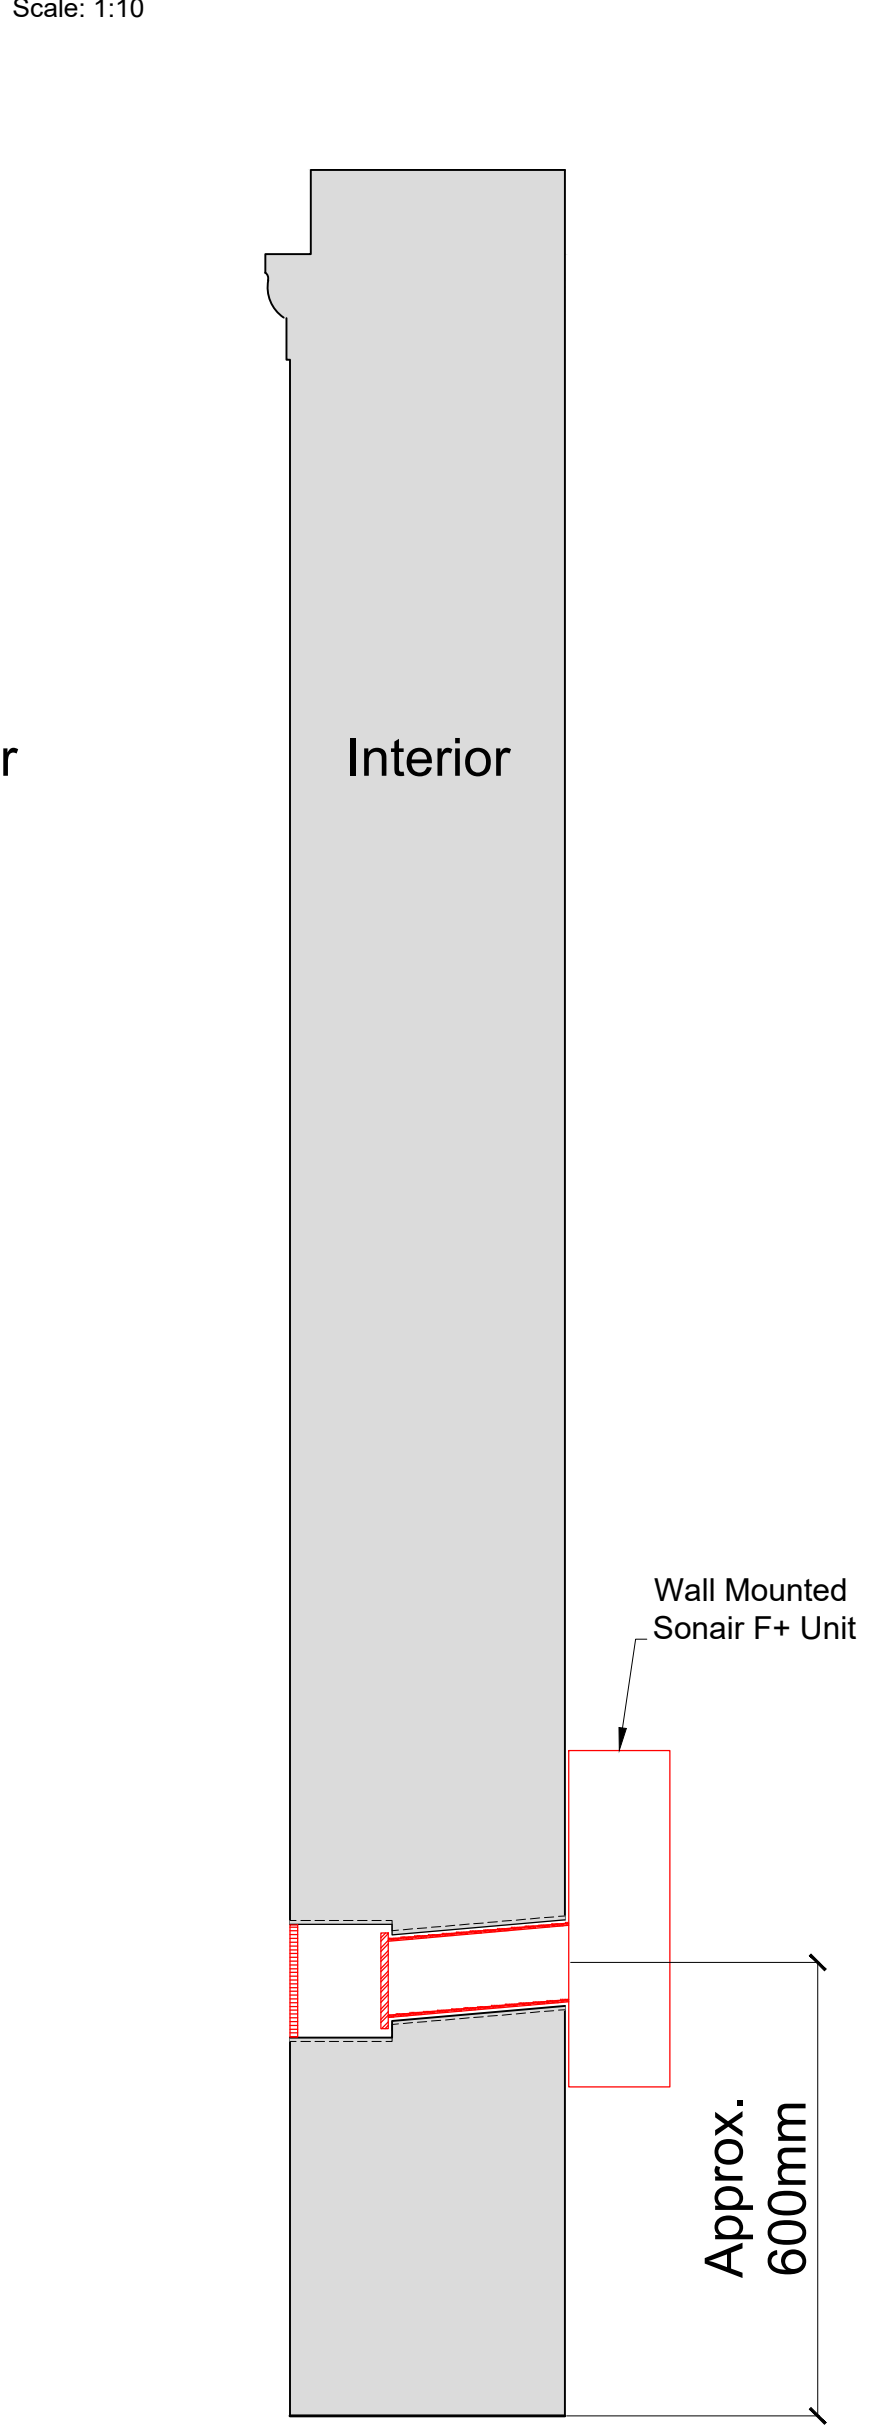

Plan Section B-B with Secondary Glazing Installed
Scale: 1:10

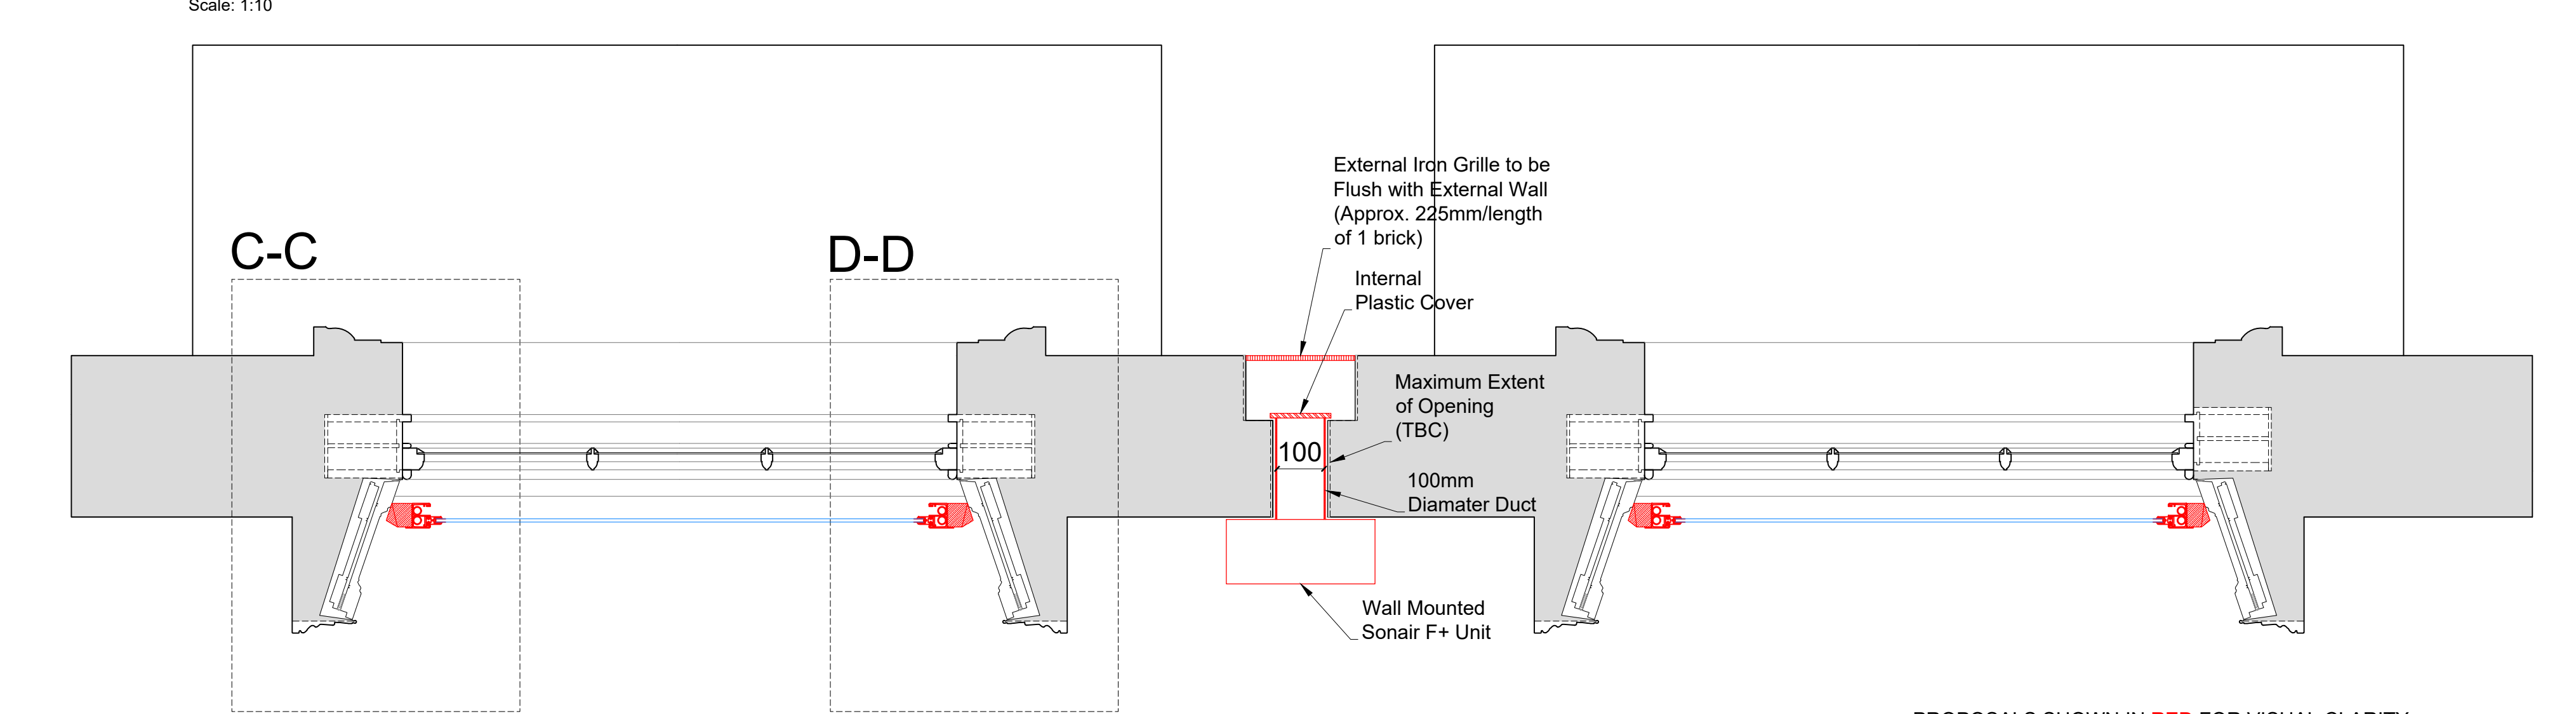

Detail of Sonair Unit
Scale: 1:5

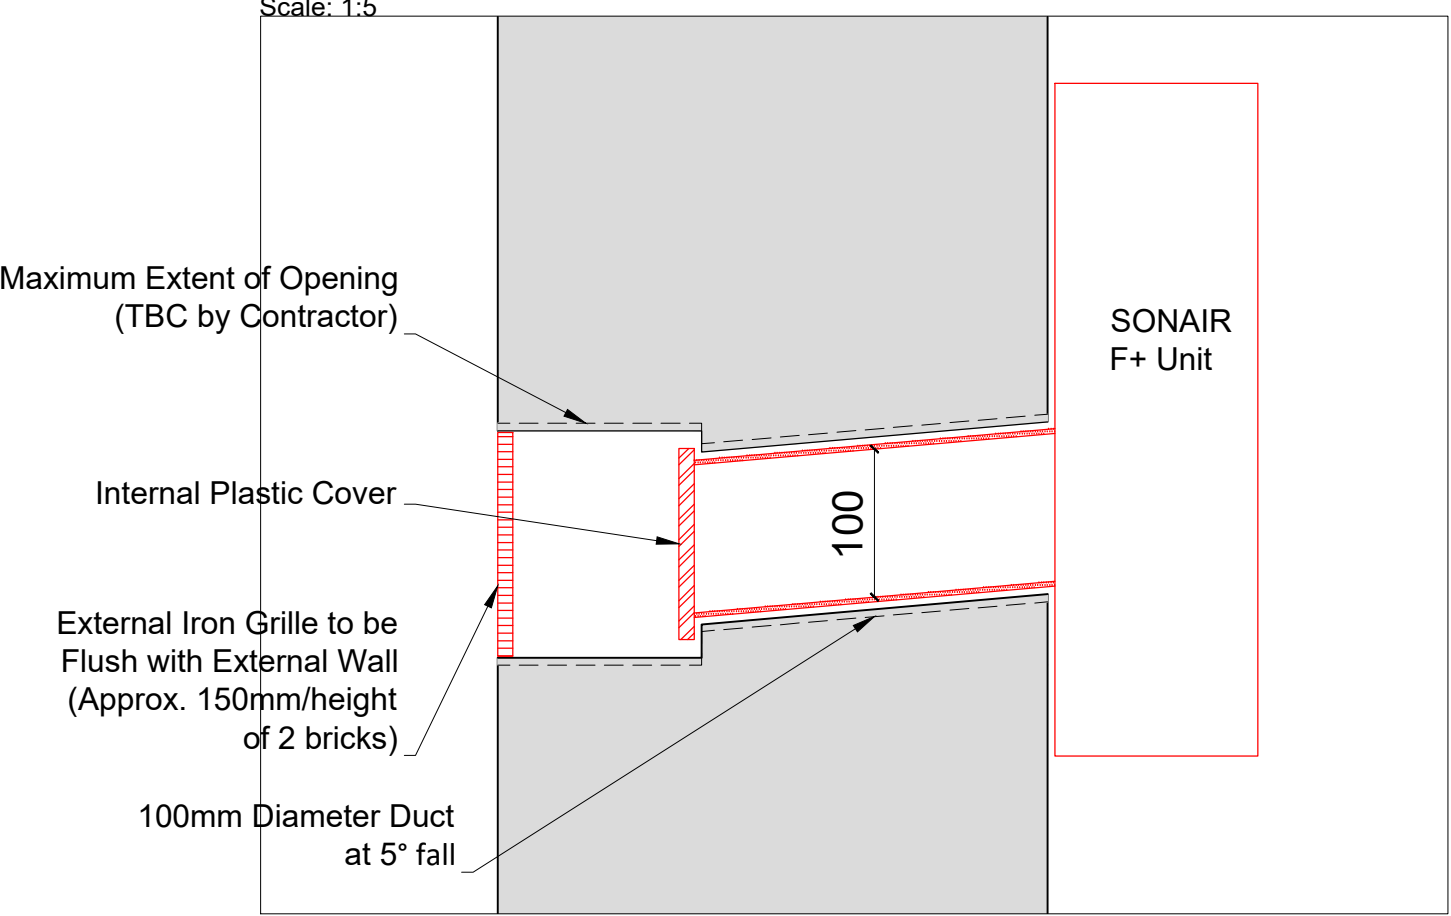

PROPOSALS SHOWN IN RED FOR VISUAL CLARITY

Revision	Date	Amendment
1.0	08-10-2018	Issued for listed building consent application

Do not reproduce this drawing without written permission
All dimensions are in millimetres unless stated otherwise

Drawing Not For Construction

HS2


High Speed (HS2) Limited
25th Floor
One Canada Square
Canary Wharf
London E14 5AB

COSTAIN SKANSKA


Costain Skanska Joint Venture
1st Floor
The Podium
1 Eversholt Street
London NW1 2DN

Site Address: 54 B Delancey Street, London NW1			
Drawing Title: First Floor - Lounge: PROPOSED Secondary Glazing Details - Sheet 2 of 3			
Drawn by: AP & PB	Checked by: AP	Presented by: VH	as shown @ A1
Date: 27-09-2018	Drawing No: WPI P066 NI - 54B DeS-PR-FF-J-01.1	Revision: 1.0	


Section C-C
Scale: 1:5 on A1

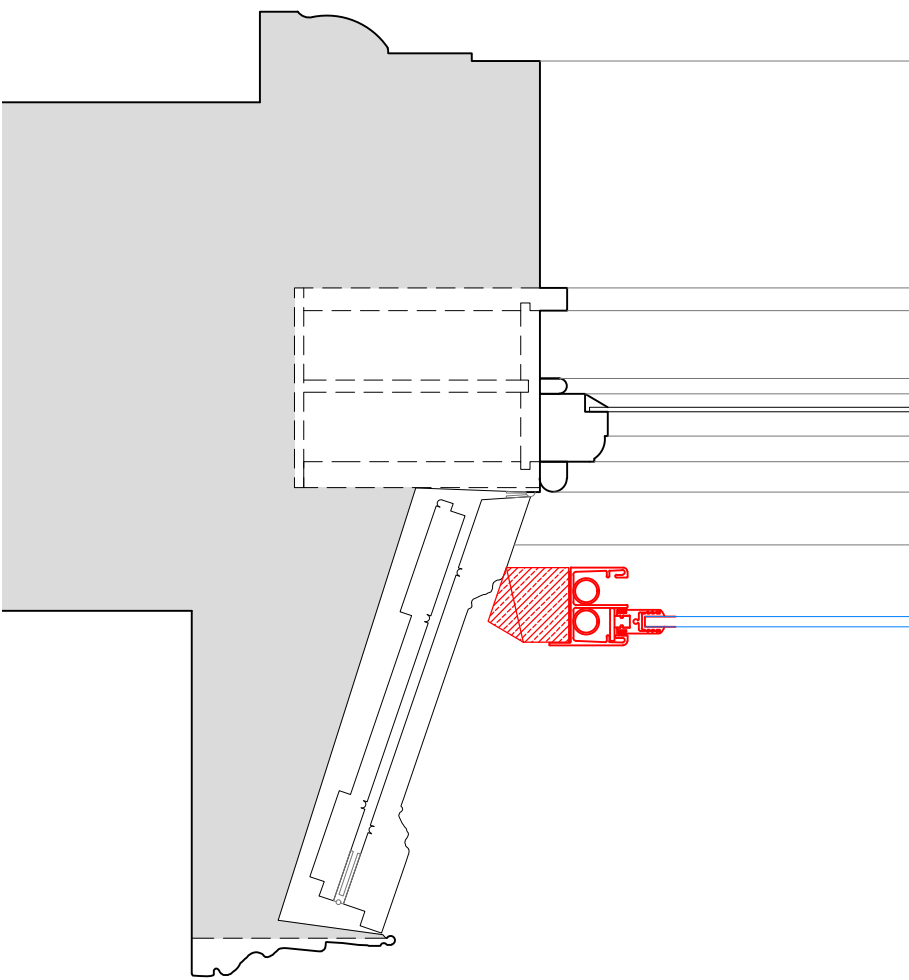


Section E-E
Scale: 1:5 on A1

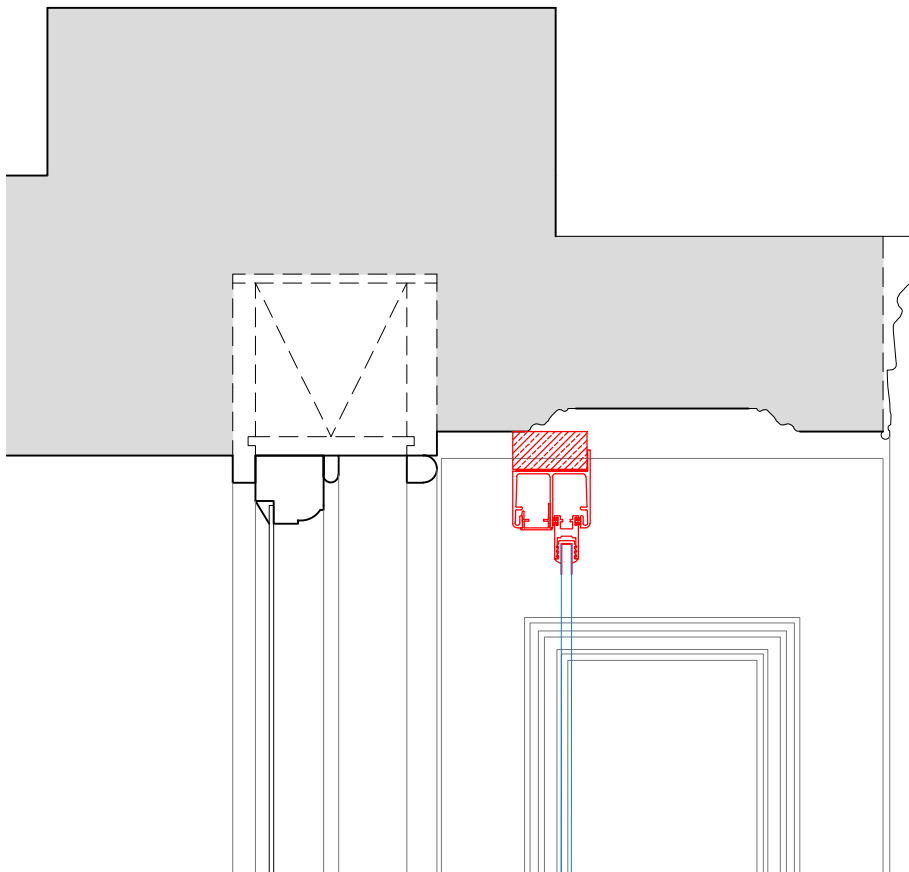


Section F-F
Scale: 1:5 on A1

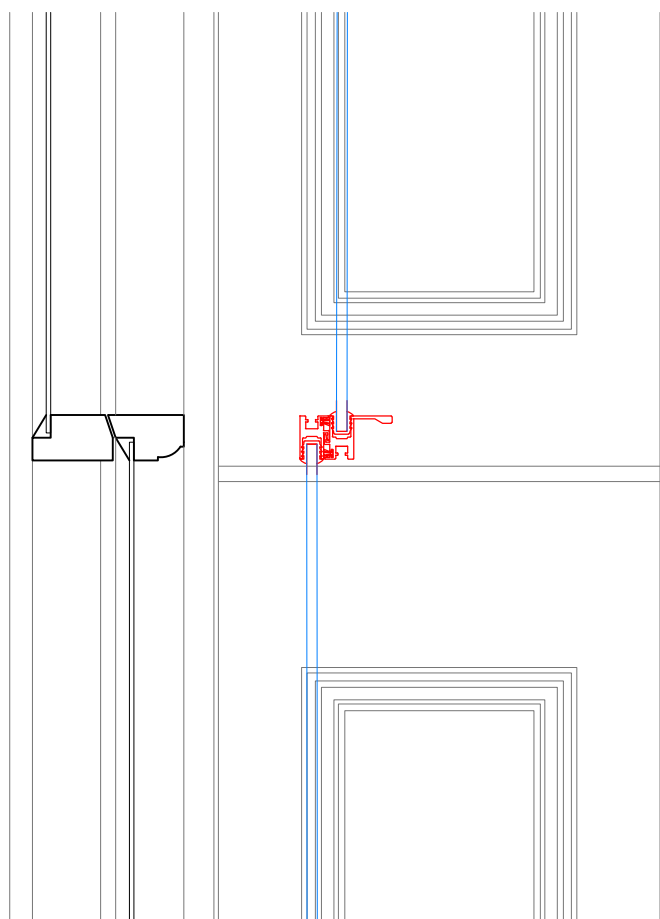

Section D-D
Scale: 1:5 on A1

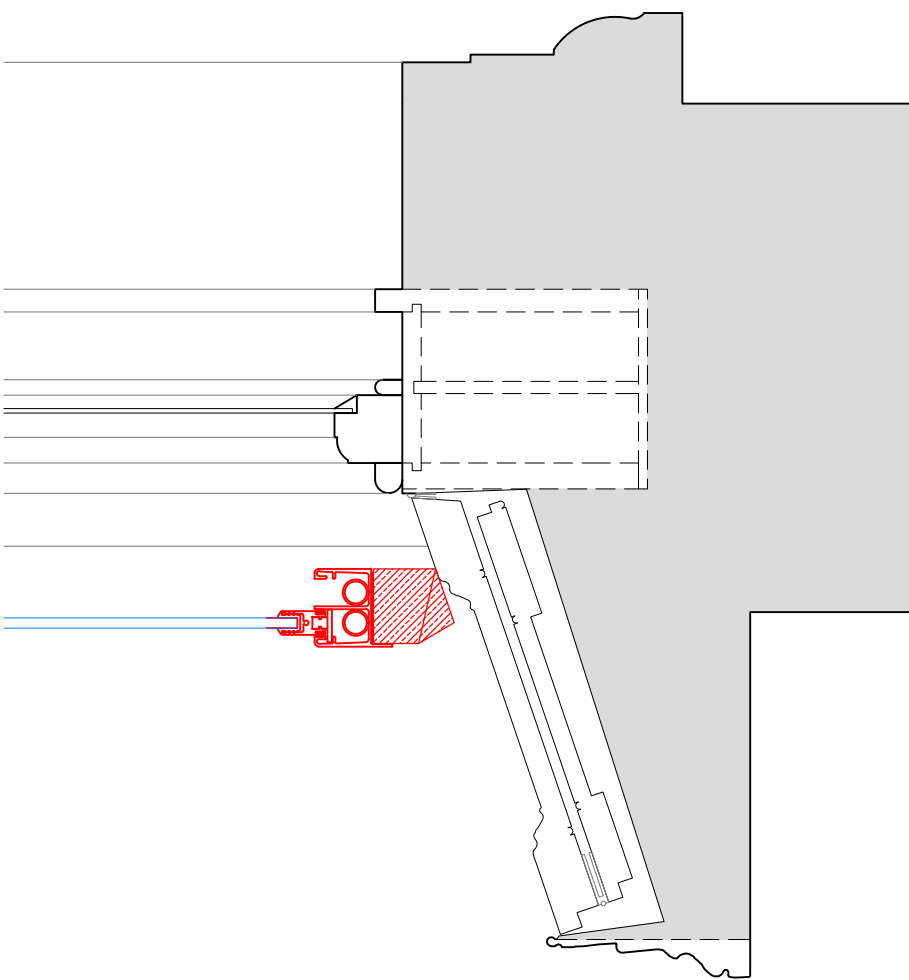

Section G-G
Scale: 1:5 on A1

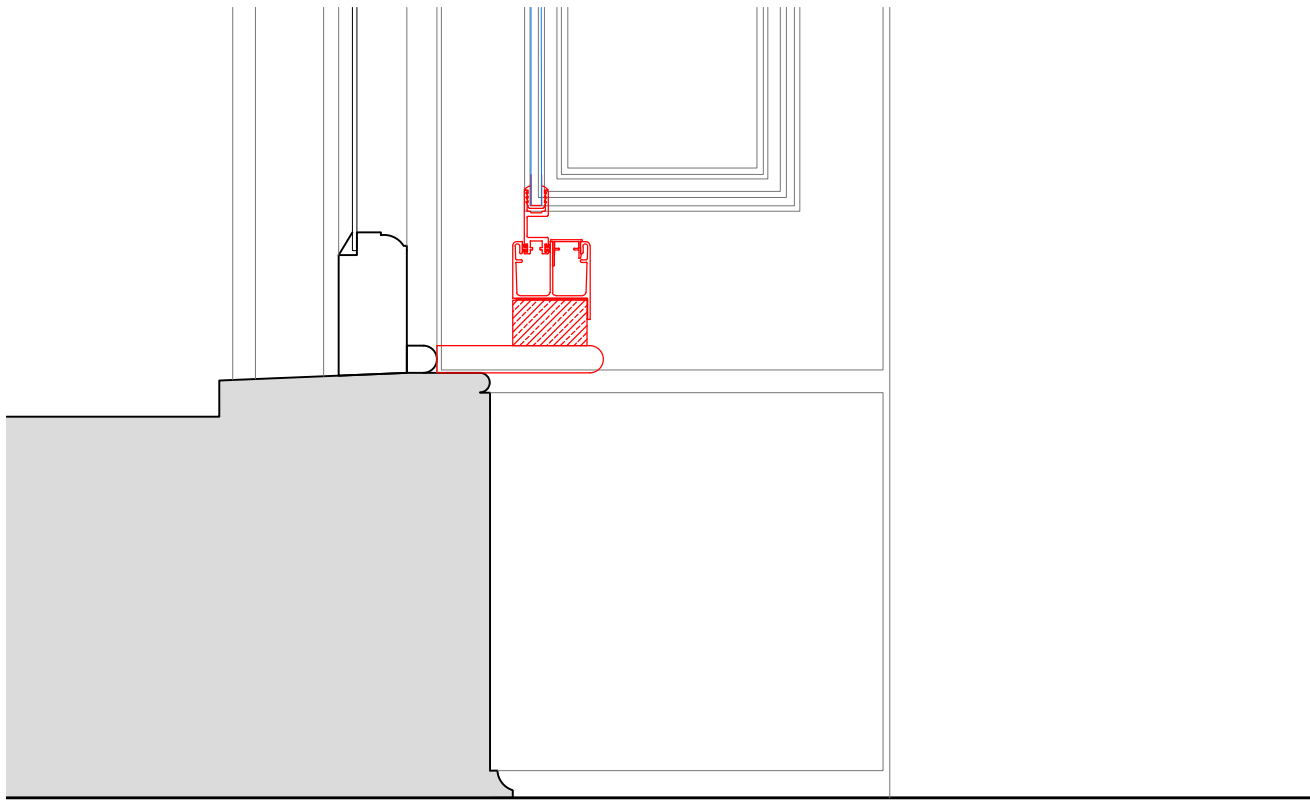

PROPOSALS SHOWN IN RED FOR VISUAL CLARITY

Revision	Date	Amendment
1.0	08-10-2018	Issued for listed building consent application

Do not reproduce this drawing without written permission
All dimensions are in millimetres unless stated otherwise

Drawing Not For Construction

HS2

High Speed (HS2) Limited
25th Floor
One Canada Square
Canary Wharf
London E14 5AB

COSTAIN SKANSKA

Costain Skanska Joint Venture
1st Floor
The Podium
1 Eversholt Street
London NW1 2DN

Site Address: 54 B Delancey Street, London NW1		
Drawing Title: First Floor - Lounge: PROPOSED Secondary Glazing Details - Sheet 3 of 3		
Surveyed by: AP & PB	Drawn by: AP	Checked by: VH
Presentation Scale: 1:5 @ A1		Revision: 1.0
Date: 27-09-2018	Drawing No: WPI P066 NI - 54B DeS-PR-FF-J-01.2	