

GENERAL NOTES:
DO NOT SCALE FROM THIS DRAWING
ALL DIMENSIONS TO BE CHECKED ON SITE
ANY OMISSIONS OR DISCREPANCIES TO BE
REPORTED TO THE ARCHITECT IMMEDIATELY
IF IN DOUBT ASK

P2	23.04.21	ADVERTISEMENT	FG
T1	16.04.21	TENDER	FG
P1	16.03.21	LISTED BUILDING CONSENT	FG
REV	DATE	NOTES	IDR

DRAWING STATUS

PLANNING

CLIENT

VAPIANO®

ARCHITECT

FINKERNAGEL ROSS

Third Floor
Unicorn House
221-222 Shoreditch High
Street
London E1 6PJ
Tel: 020 7377 5114
info@finkernagelross.com
www.finkernagelross.com

PROJECT
VAPIANO LONDON 4
CENTRE POINT
LONDON WC2H

DRAWING TITLE

EXISTING SHOPFRONT
& PASSAGEWAY ELEVATIONS

DRAWN	DR. DATE	CHECKED	CH. DATE
FG	03.03.21	AB	16.04.21
SCALE		SHEET SIZE	


1:50 @ A1

A1


DRAWING NO

REVISION


VAP-LON4-310 P2

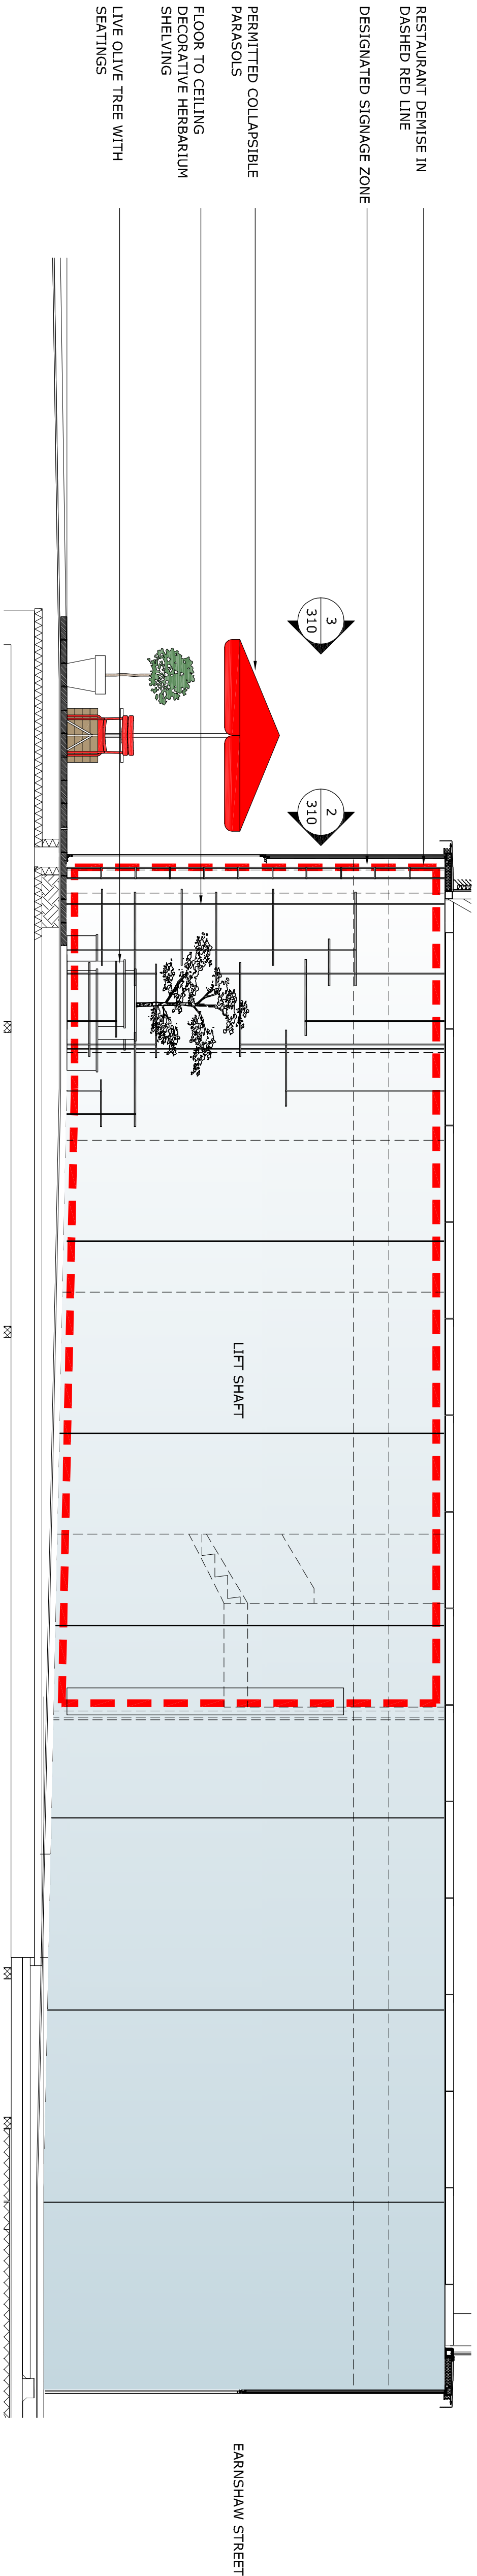

1 AS BUILT PASSAGEWAY ELEVATION
1:50 @ A1

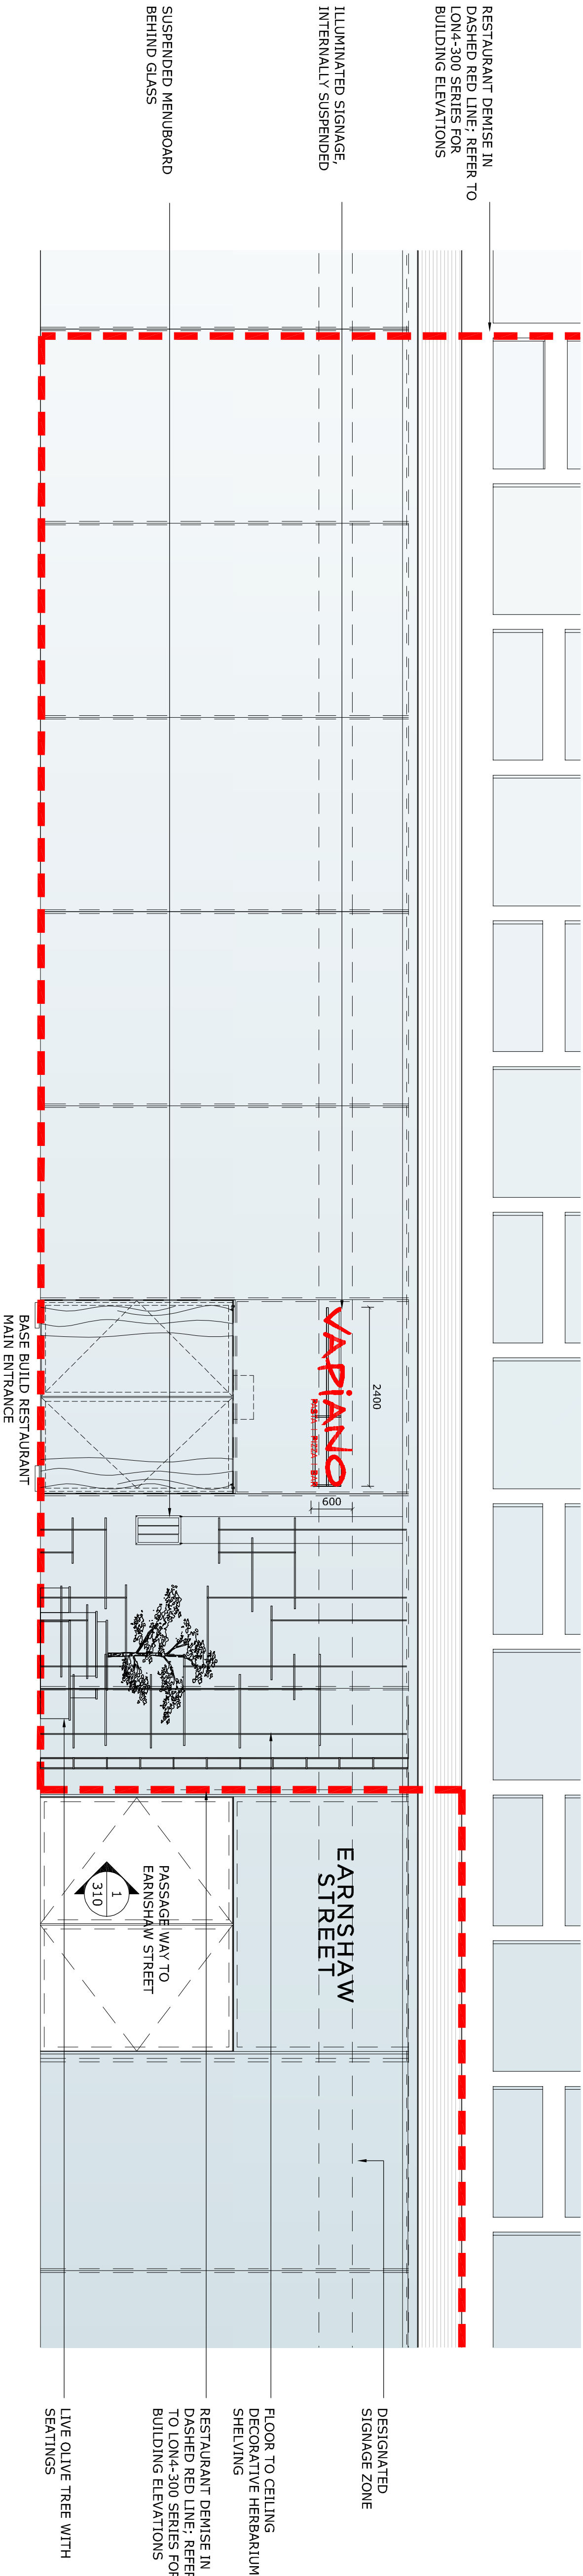

2 AS BUILT SHOPFRONT ELEVATION
1:50 @ A1

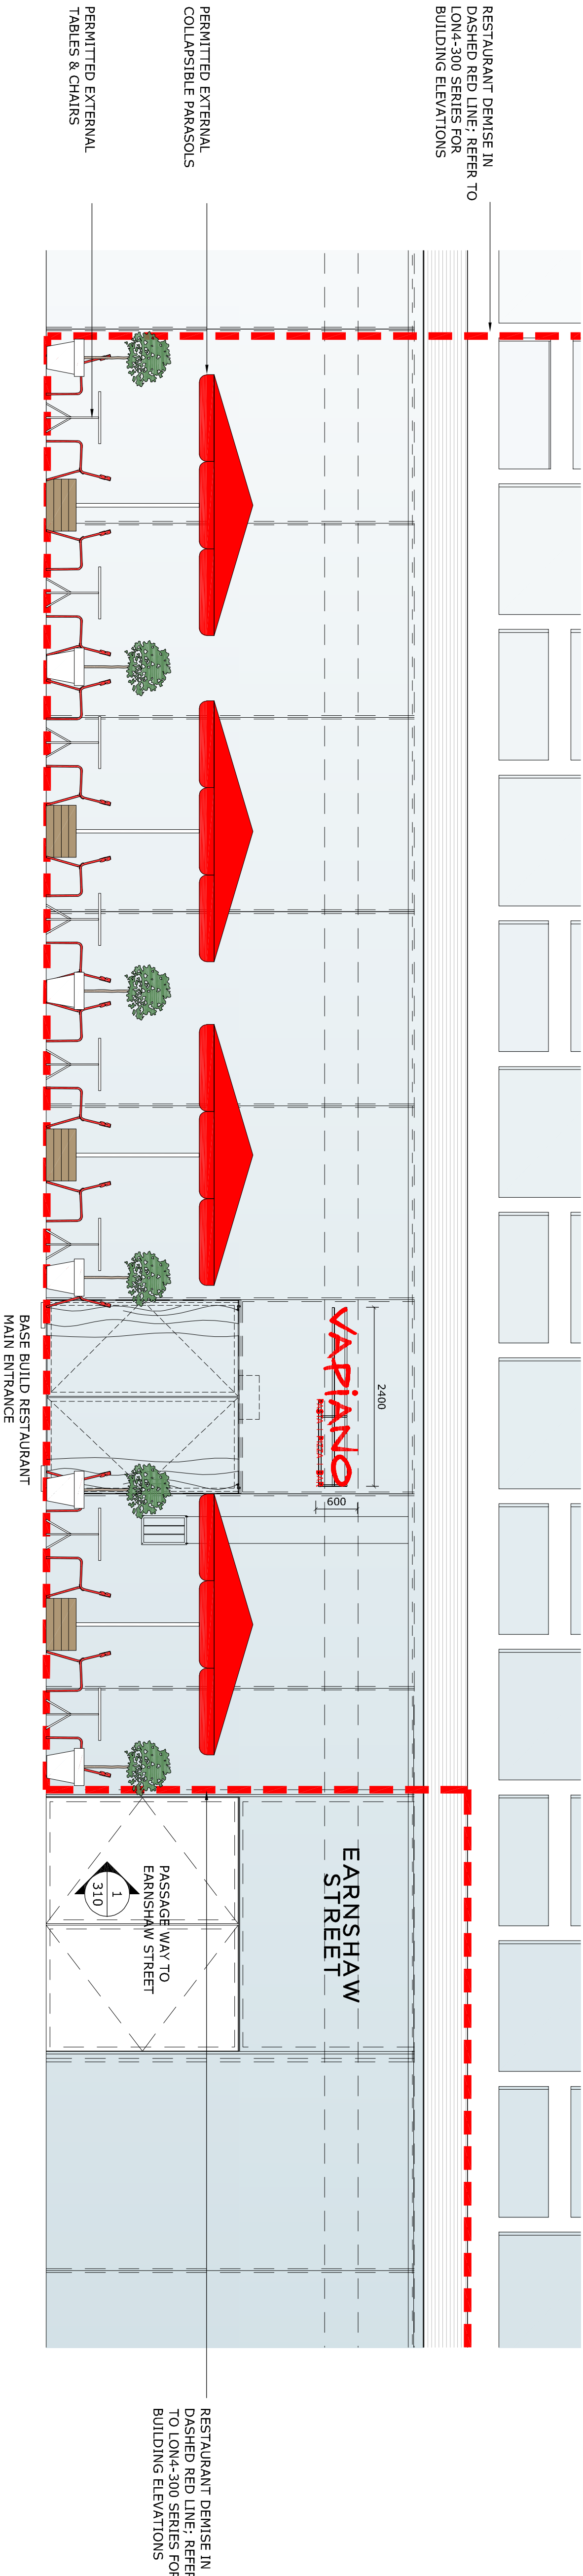

3 PERMITTED EXTERNAL SEATING
1:50 @ A1