FLOOR AREAS:

Ground Floor	Square Meterage	Square Footage (approx
FOH (customer areas)	36.54	393.26
Servery	13.97	150.37
FOH Subtotal	50.51	543.63
BOH*	102.25	1100.61
WC's	0	0
Total	152.76	1644.24

*BOH area includes: Staff room, Refuse area, COSHH, Managers office, Electric



Pret outdoor seating: 24noExternal aluminium frame
(black) and teak slatted chair



square tables: 12no
External 500x500mm black
Trespa 12mm thick table top
with aluminium base

seating barrier: 6no
Fabric banner with printed logo
supported by stainless steel
post and base

note: external furniture to be brought into store outside of trading hours

FOH Equipment list


7no tills: 2x 2no Glass top till module (Nuttall) 1x 3no Glass top till module (Nuttall)

Back coutner: 2no Cimballi machines

1no Filter machine

2no Ovens
1no Smoothie station (Slim)
2no Toastie machines

Langers: 1no 770 x 770mm Hot Langer 2no 1250 x 910mm Cold Langer 2no 990 x 910mm Cold Langer

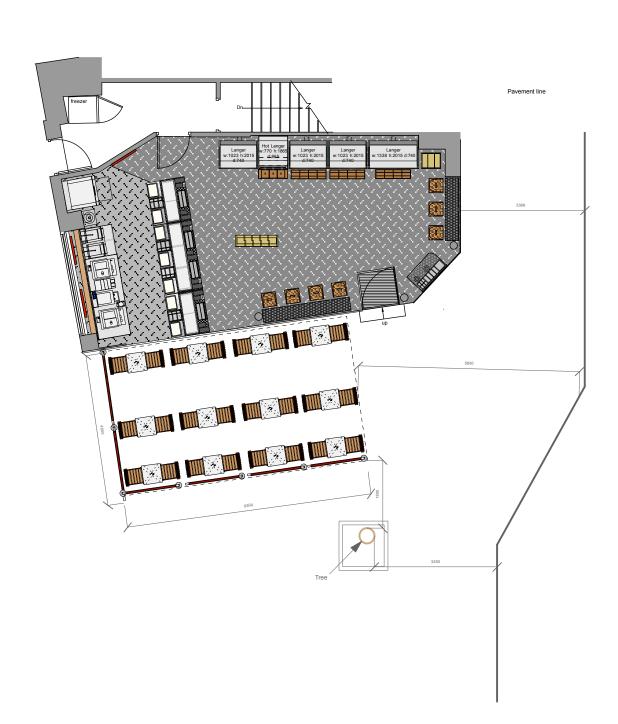

Notes:

As Built



Site: 240 High Holborn London

Title: Shop Layout

Rev: Date: Drawn By:

Dwg No. 240-Pret-01

Date: 23.01.15

Scale: 1:100 @ A3

Revision: Drawn By: LJB

© PRET A MANGER (EUROPE) LTD 2004