


Demolition Notes:

Drawings to be viewed / printed in colour.

Items shown in red are to be carefully removed.

Annotations highlighting works to be undertaken. For further details refer to Scope of Works.

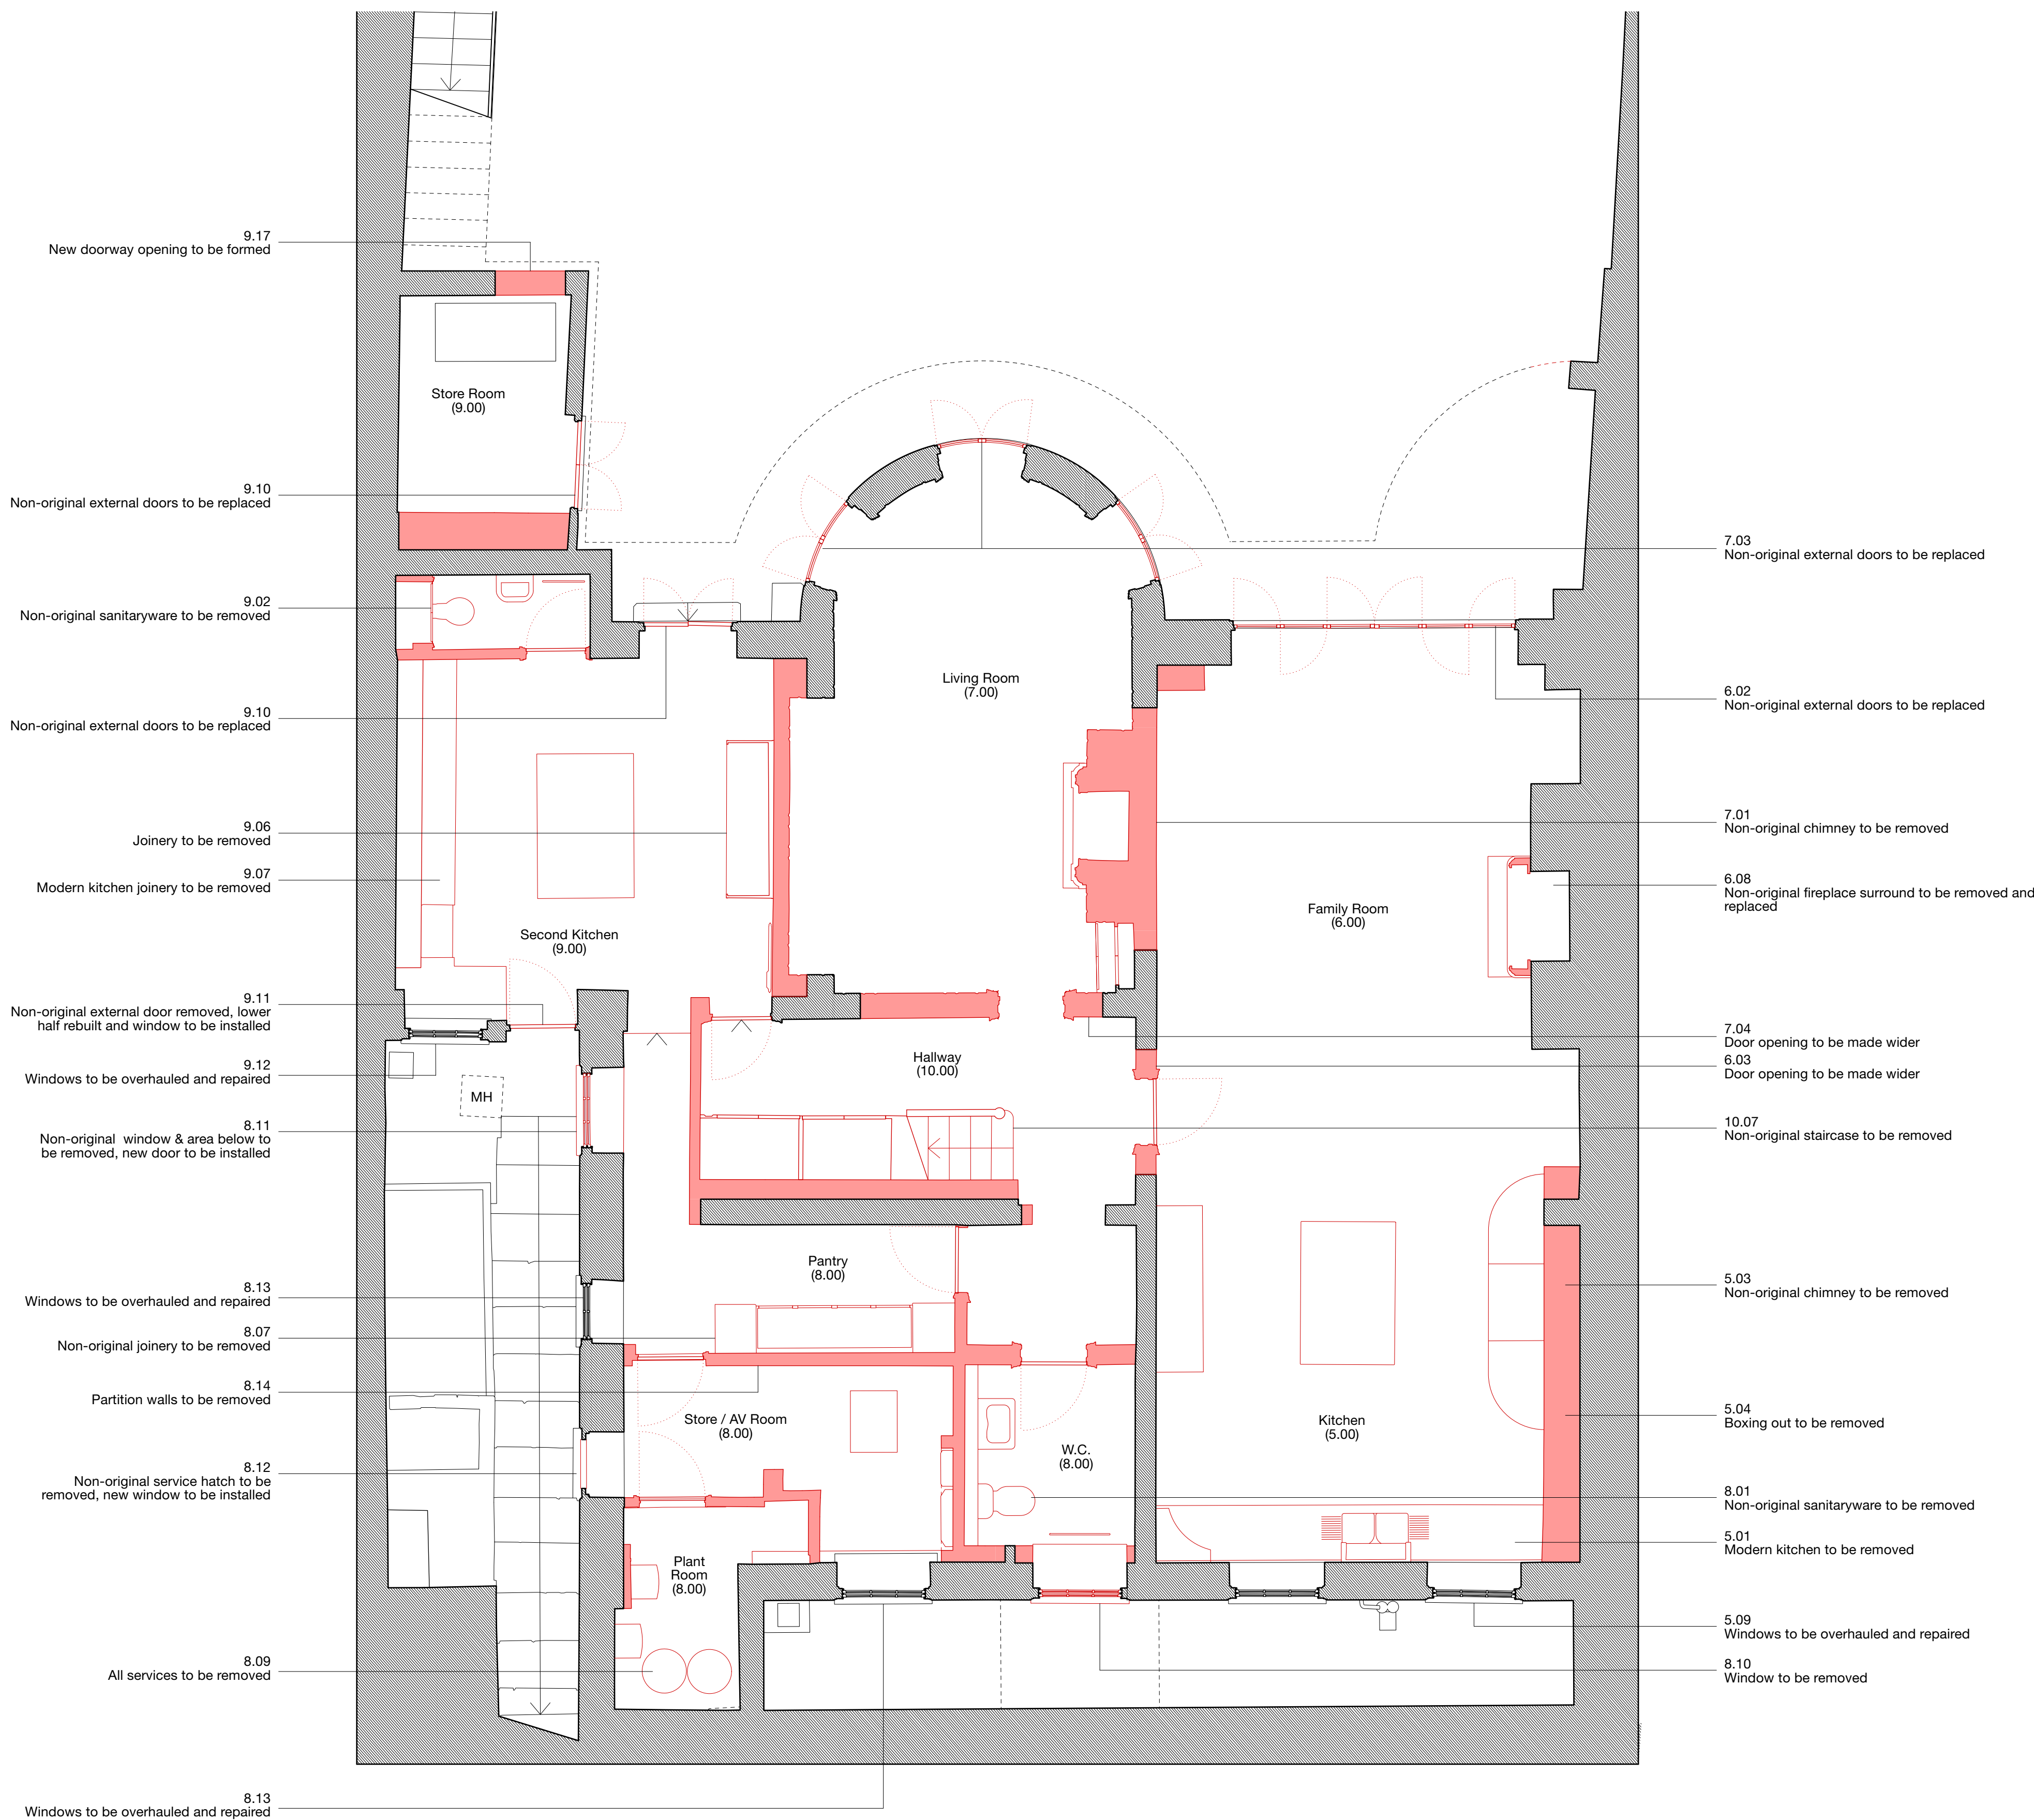

0 1 2 4m

31/44
Architects

6 Osborn Street
London
E1 6TD
United Kingdom
+44 (0)20 3735 7820
London
3144architects.com

Client
No. 5 The Grove

Project
The Grove

Date
06/05/2021

Drawing name
Demolition Lower Ground Floor Plan

Drawing number
44/2022/PL 1002

Status

Drawn
FG

Checked
SD

Scale / Format
1:50 / A1
1:100 / A3

Rev.	Date	Description	Drawn / Checked
------	------	-------------	-----------------


© 31/44 Architects
Do not scale from this drawing.
All dimensions to be verified on site.
This drawing is to be read in conjunction with all consultants information.
Any discrepancies to be reported immediately to the Architect.
Drawing may be scaled for planning purposes.

Demolition Notes:

Drawings to be viewed / printed in colour.

Items shown in red are to be carefully removed.

Annotations highlighting works to be undertaken. For further details refer to Scope of Works.

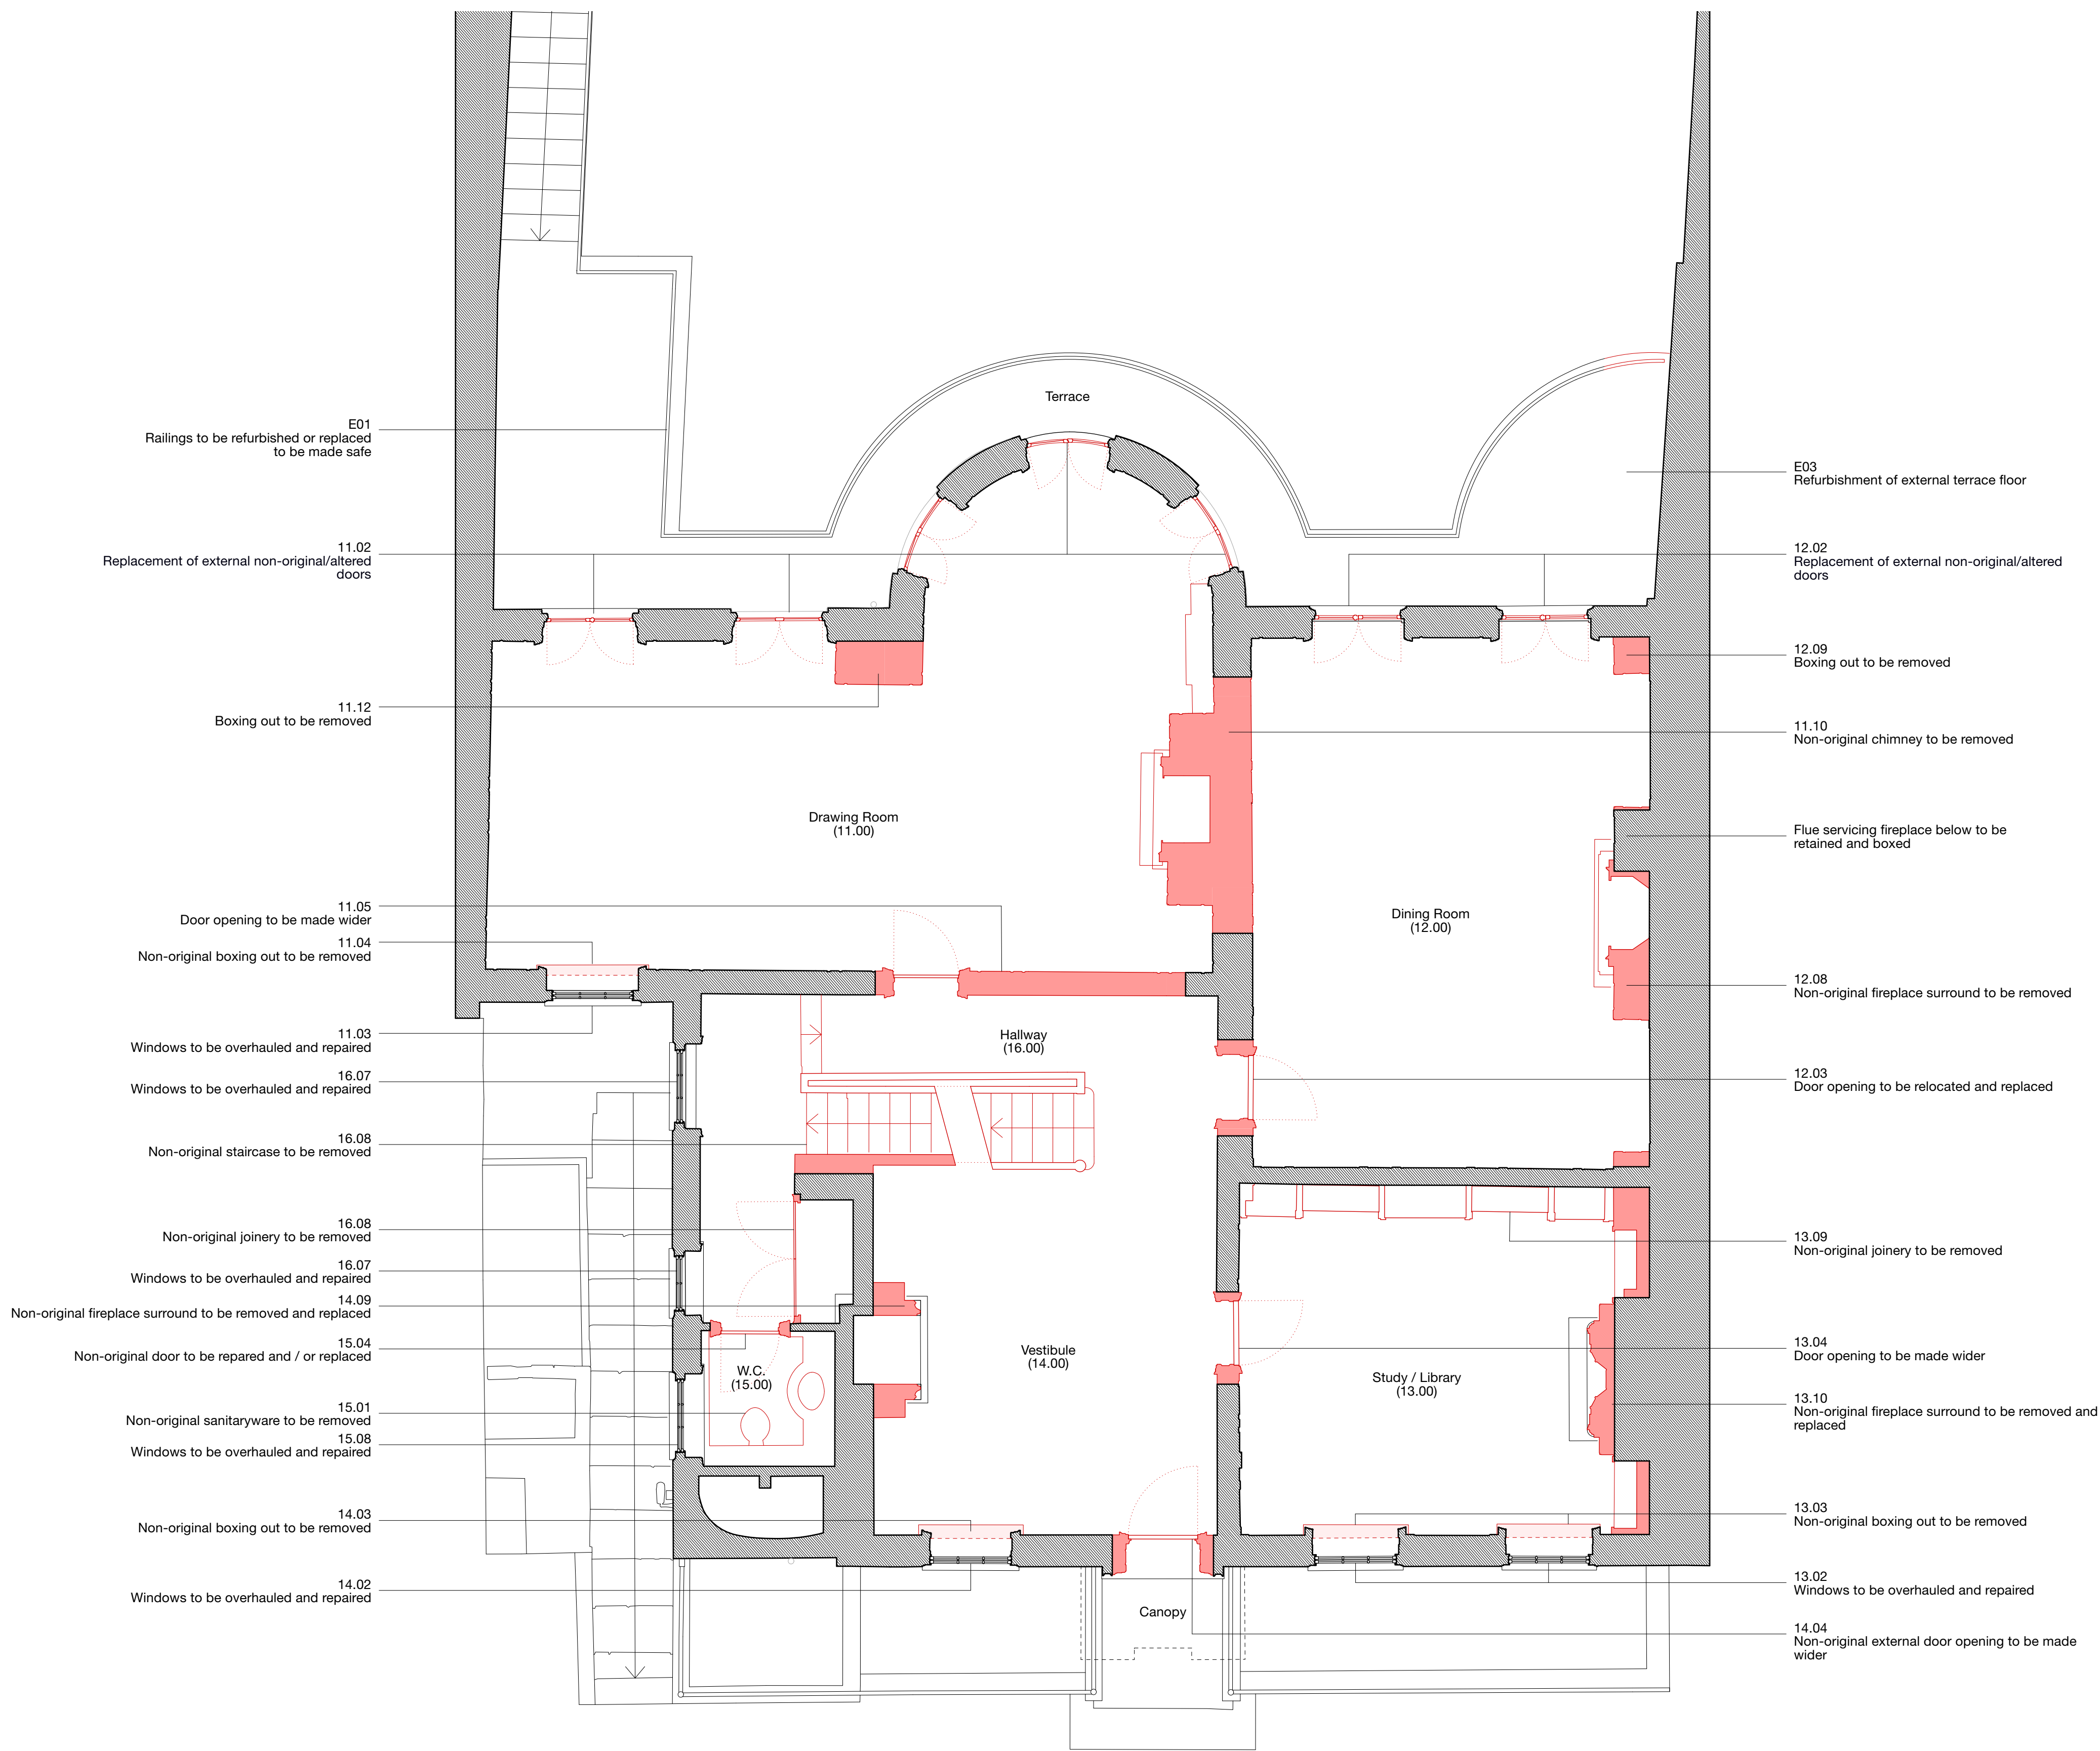

0 1 2 4m

31/44
Architects

6 Osborn Street
London
E1 6TD
United Kingdom
+44 (0)20 3735 7820
London
3144architects.com

Client
No. 5 The Grove

Project
The Grove

Date
06/05/2021

Drawing name
Demolition Upper Ground Floor Plan

Drawing number
44/2022/PL 1003

Status

Drawn
FG

Checked
SD

Scale / Format
1:50 / A1
1:100 / A3

Rev.	Date	Description	Drawn / Checked
------	------	-------------	-----------------


Do not scale from this drawing.
All dimensions to be verified on site.
This drawing is to be read in conjunction with all consultants information.
Any discrepancies to be reported immediately to the Architect.
Drawing may be scaled for planning purposes.

Demolition Notes:

Drawings to be viewed / printed in colour.

Items shown in red are to be carefully removed.

Annotations highlighting works to be undertaken. For further details refer to Scope of Works.

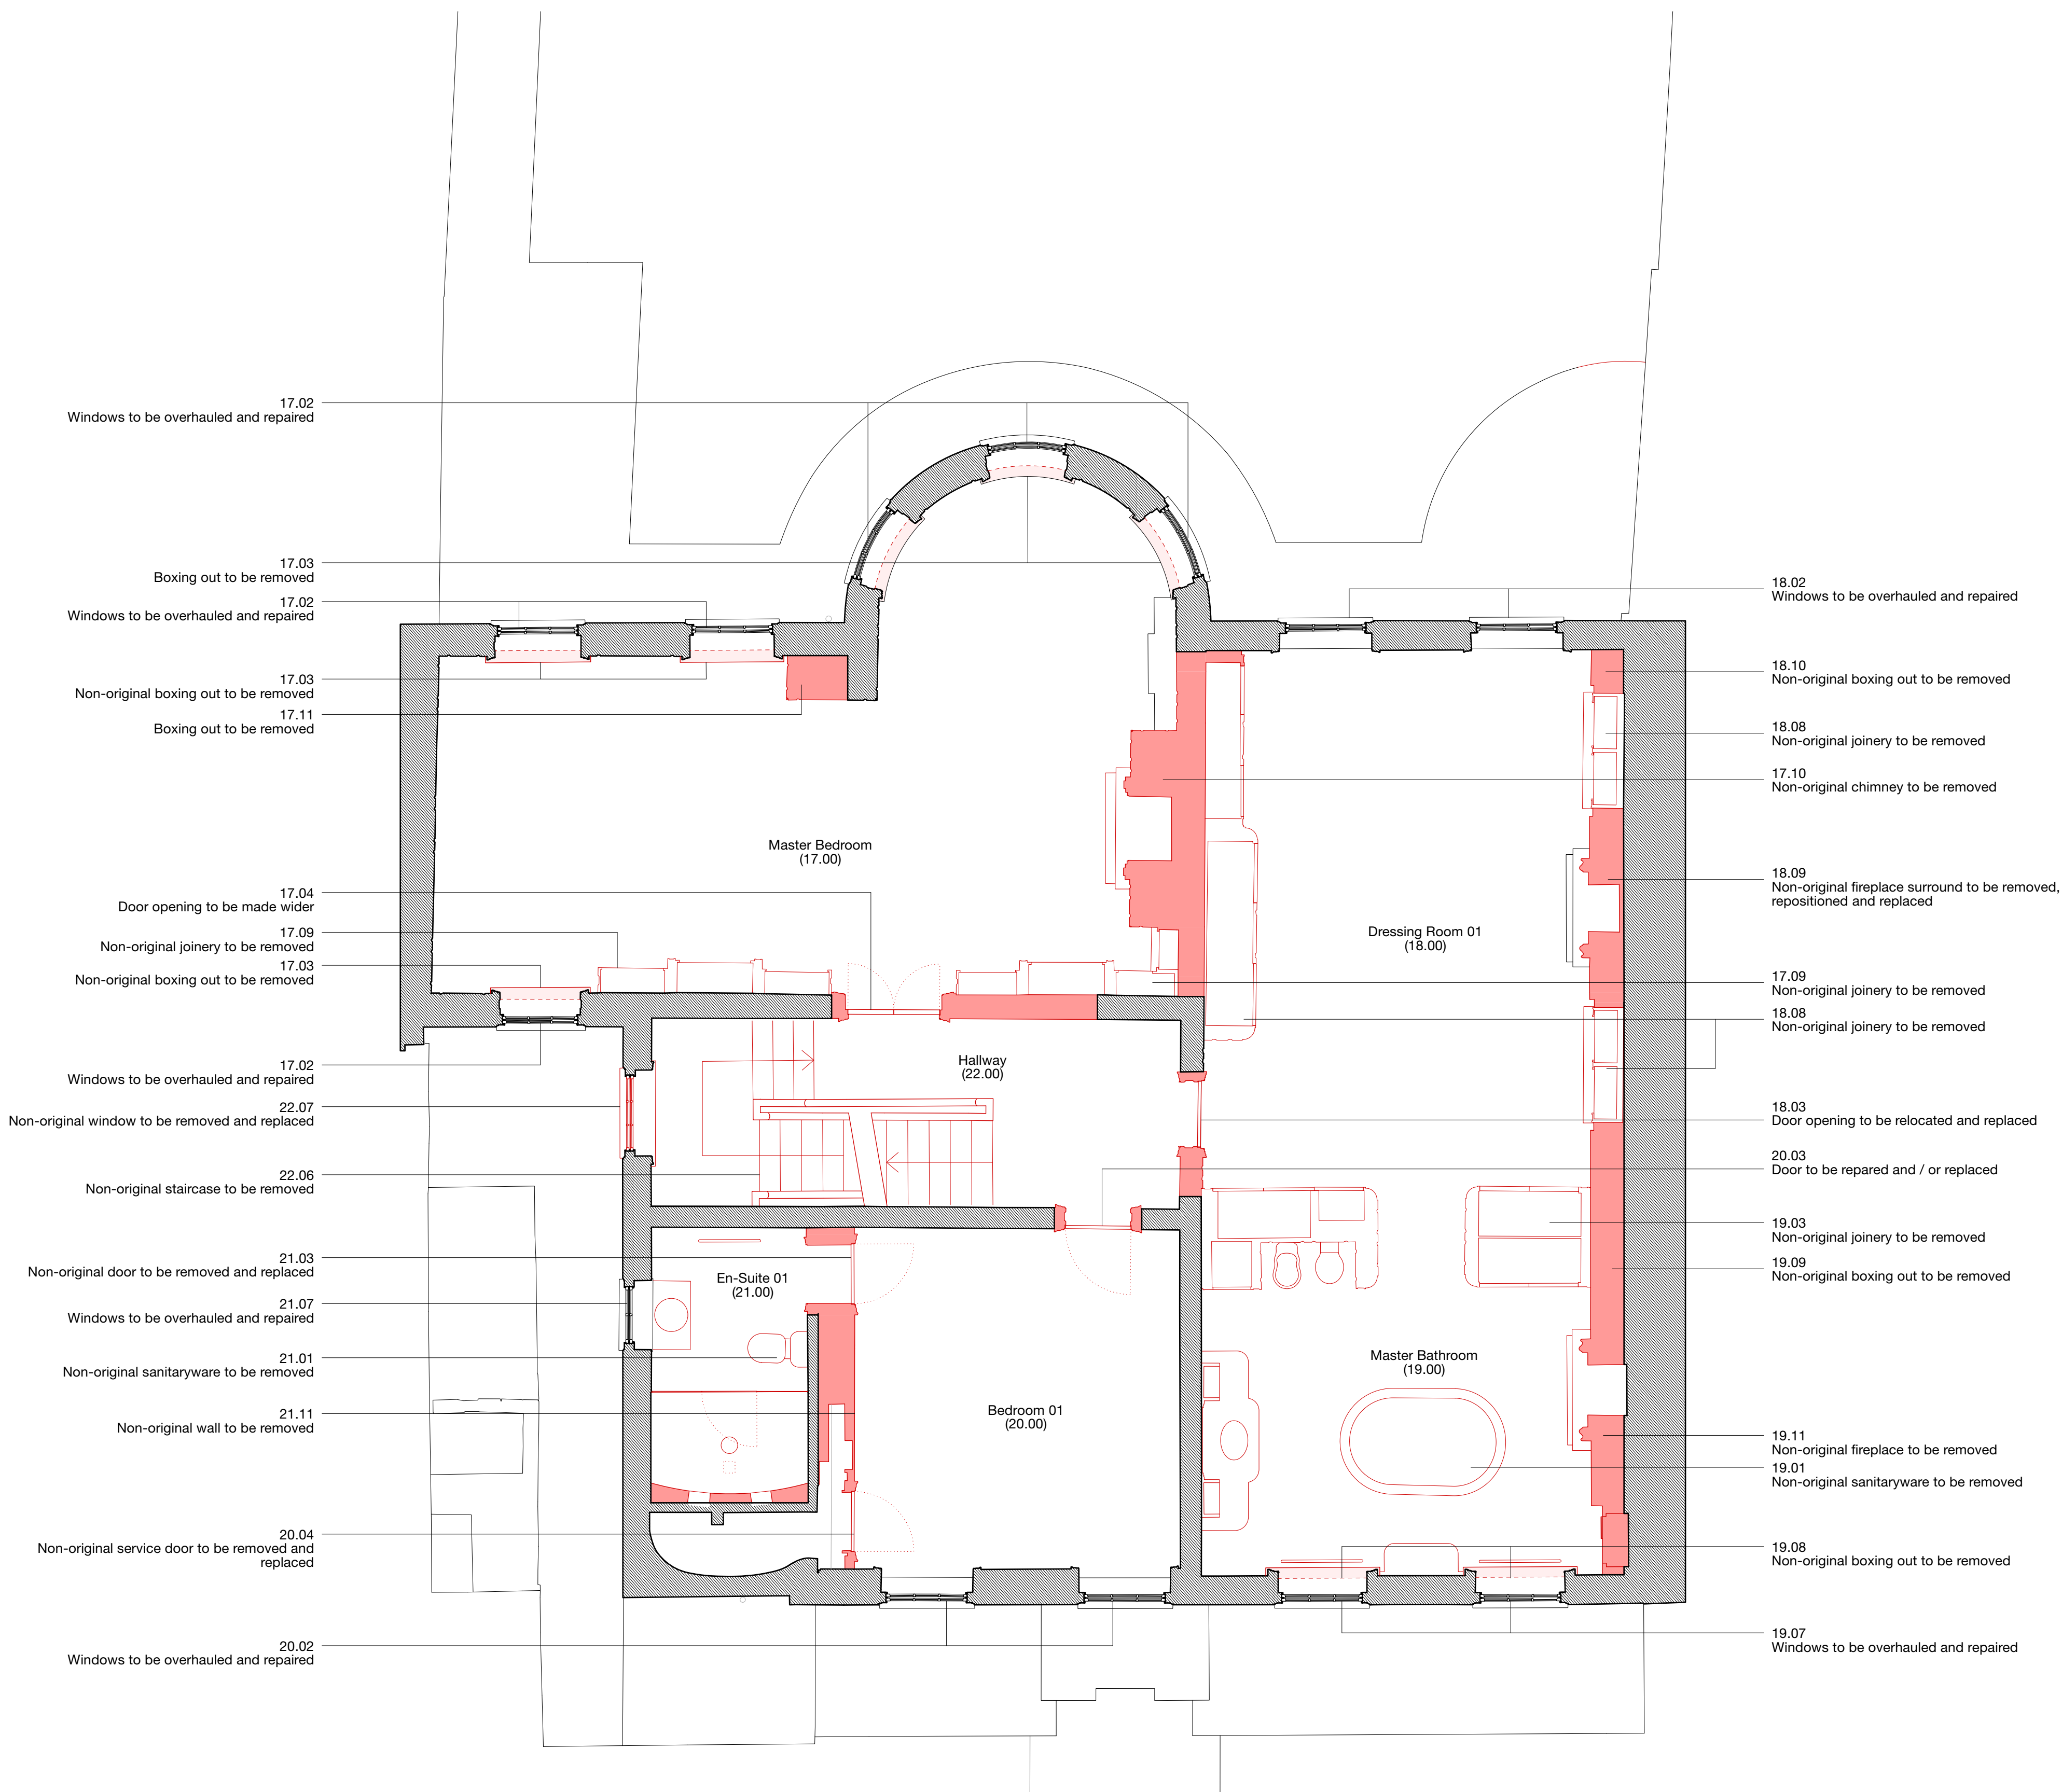

0 1 2 4m

31/44
Architects

6 Osborn Street
London
E1 6TD
United Kingdom
+44 (0)20 3735 7820
London@
3144architects.com

Client
No. 5 The Grove

Project
The Grove

Date
06/05/2021

Drawing name
Demolition First Floor Plan

Drawing number
44/2022/PL 1004

Status

Drawn
FG

Checked
SD

Scale / Format
1:50 / A1

1:100 / A3

Rev.	Date	Description	Drawn /	Checked
------	------	-------------	---------	---------

© 31/44 Architects

Do not scale from this drawing.
All dimensions to be verified on site.
This drawing is to be read in conjunction with all consultants information.
Any discrepancies to be reported immediately to the Architect.


Drawing may be scaled for planning purposes.

Demolition Notes:

Drawings to be viewed / printed in colour.

Items shown in red are to be carefully removed.

Annotations highlighting works to be undertaken. For further details refer to Scope of Works.

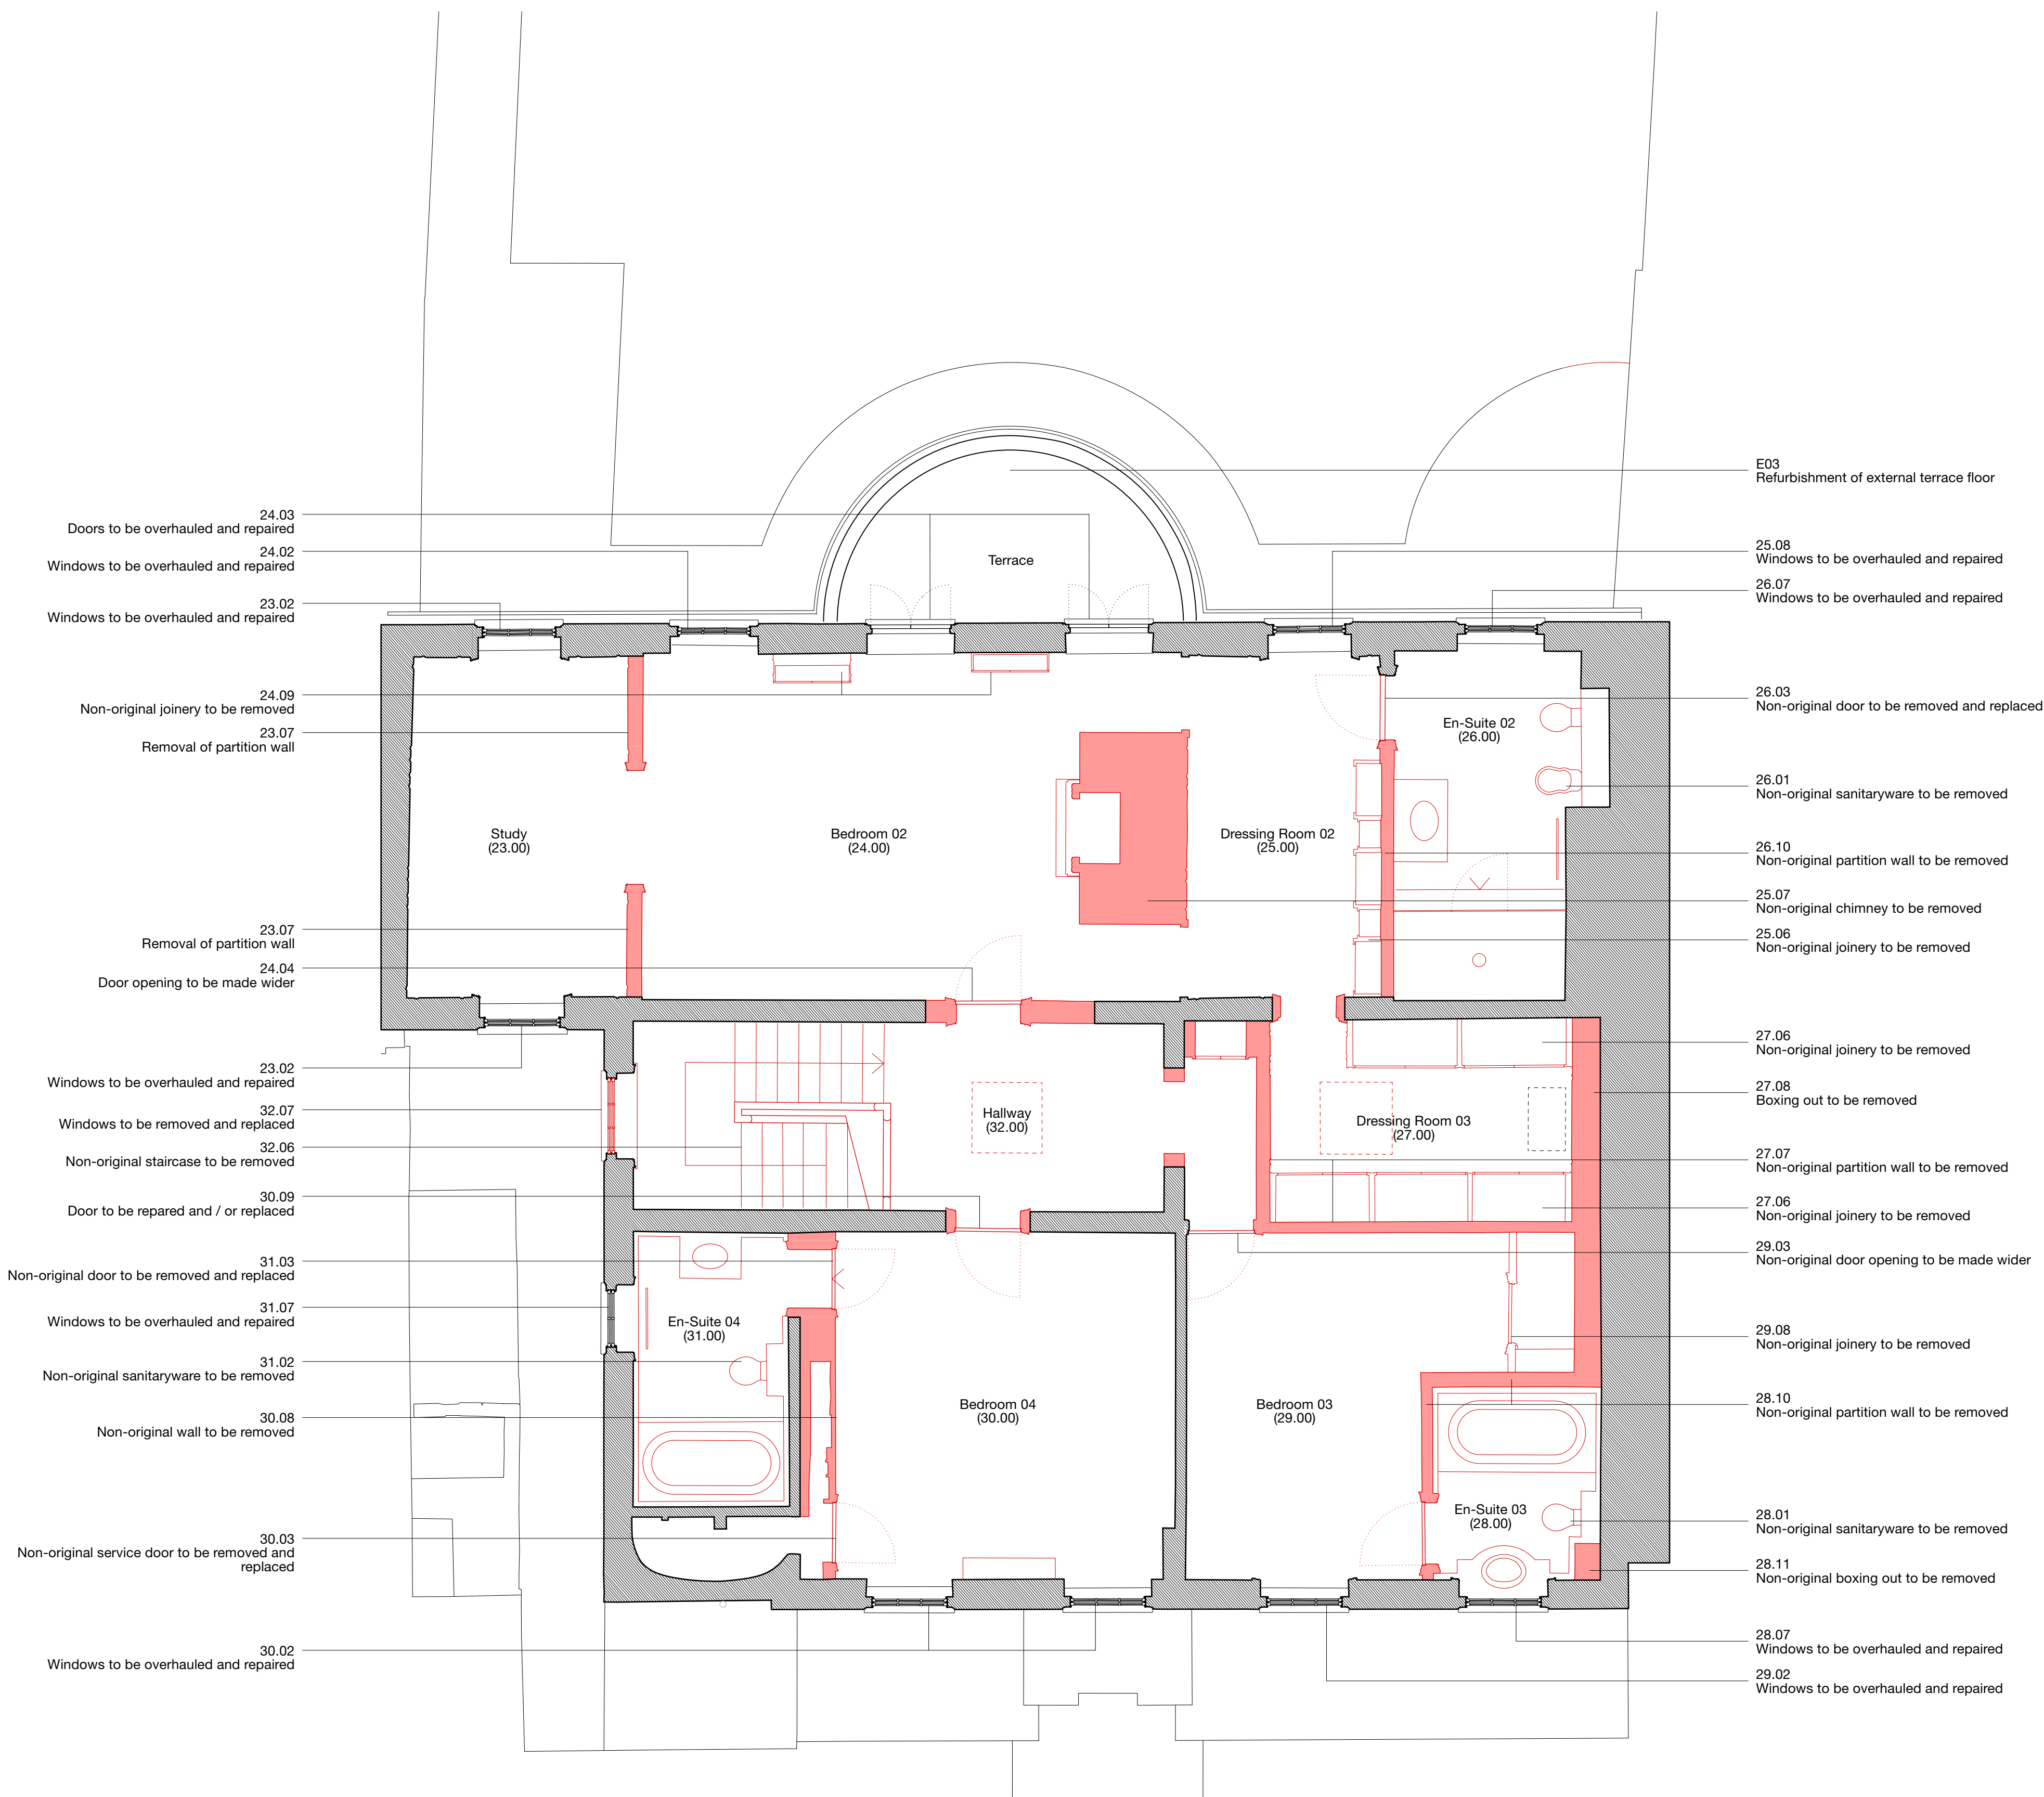

0 1 2 4m

31/44
Architects

6 Osborn Street
London
E1 6TD
United Kingdom
+44 (0)20 3735 7820
London
3144architects.com

Client
No. 5 The Grove

Project
The Grove

Date
06/05/2021

Drawing name
Demolition Second Floor Plan

Drawing number
44/2022/PL 1005

Status

Drawn
FG

Checked
SD

Scale / Format

1:50 / A1

1:100 / A3

Rev.	Date	Description	Drawn / Checked
------	------	-------------	-----------------

© 31/44 Architects

Do not scale from this drawing.
All dimensions to be verified on site.
This drawing is to be read in conjunction with all consultants information.
Any discrepancies to be reported immediately to the Architect.



Drawing may be scaled for planning purposes.

Demolition Notes:

Drawings to be viewed / printed in colour.

Items shown in red are to be carefully removed.

Annotations highlighting works to be undertaken. For further details refer to Scope of Works.

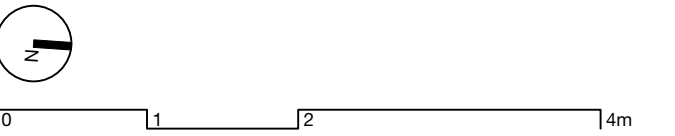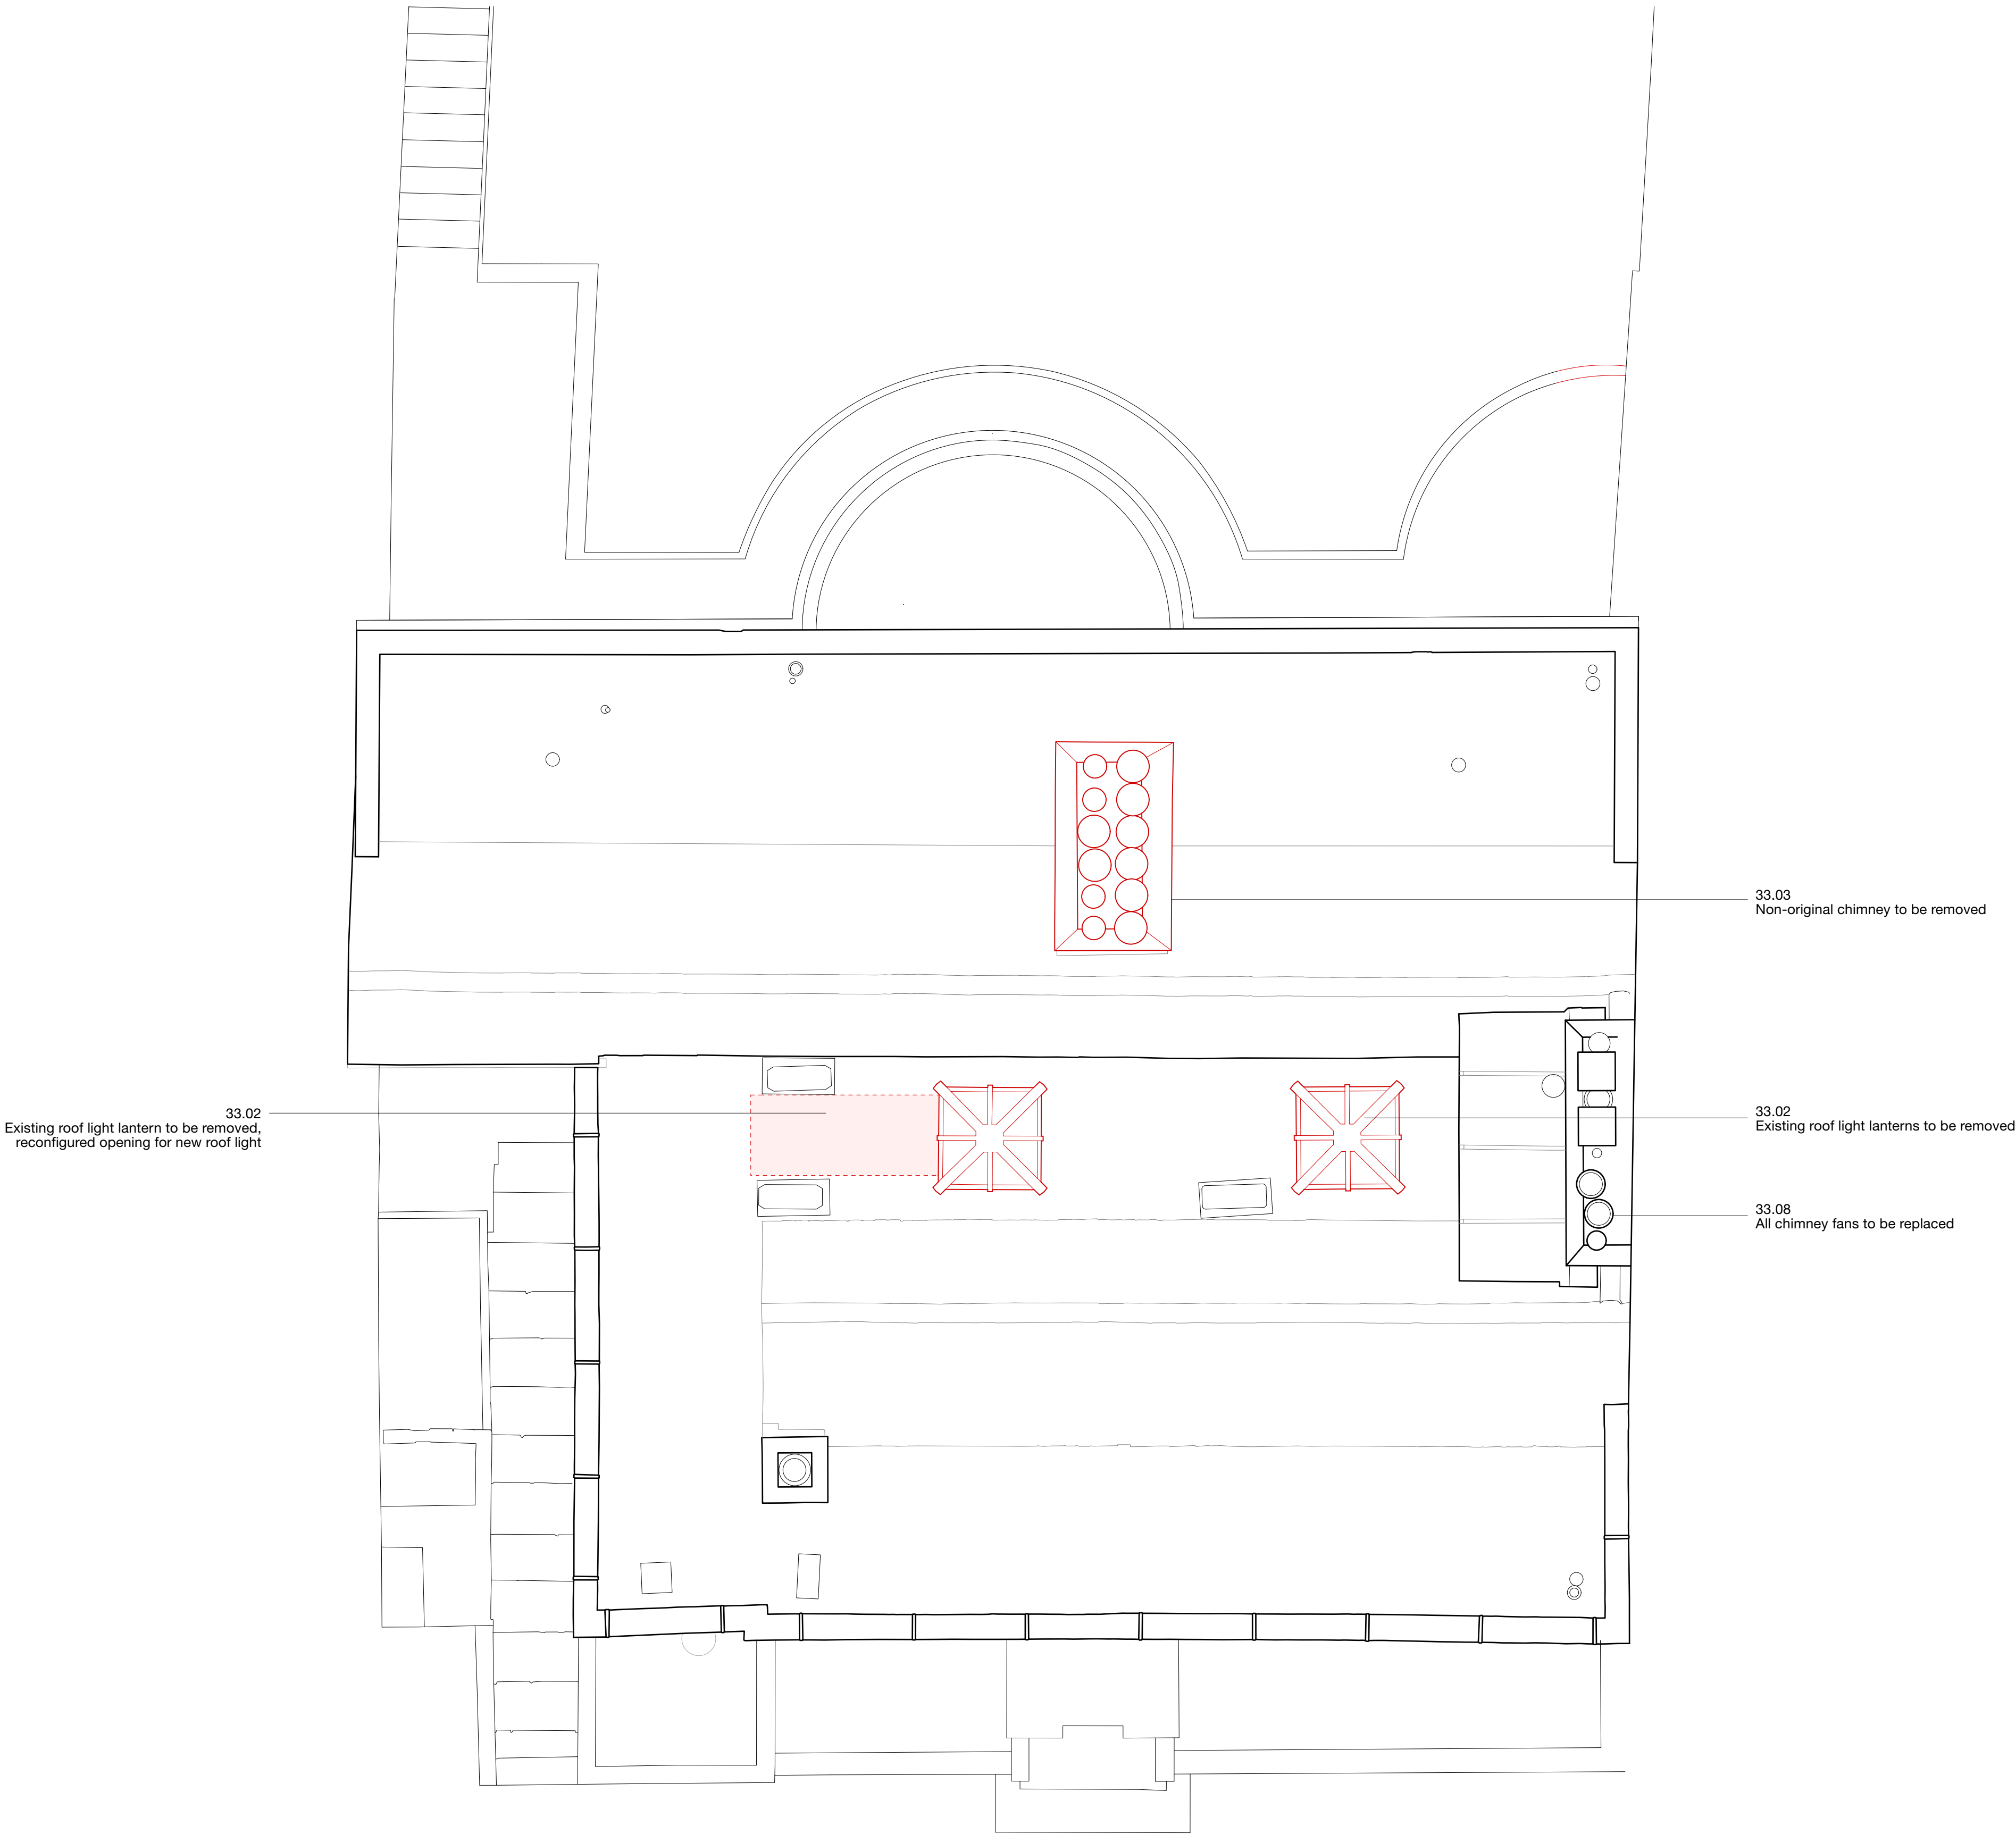


31/44 Architects

6 Osborn Street
London
E1 6TD
United Kingdom
+44 (0)20 3735 7820
London@3144architects.com

Client	No. 5 The Grove	Status
Project	The Grove	
Date	06/05/2021	Drawn Checked FG SD
Drawing name	Demolition Roof Plan	Scale / Format 1:50 / A1 1:100 / A3
Drawing number	44/2022/PL 1006	

Rev.	Date	Description	Drawn / Checked
© 31/44 Architects			
Do not scale from this drawing.			
All dimensions to be verified on site.			
This drawing is to be read in conjunction with all consultants information.			
Any discrepancies to be reported immediately to the Architect.			
Drawing may be scaled for planning purposes.			

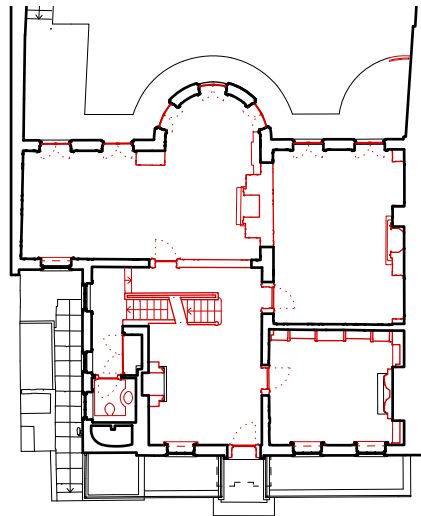

Demolition Notes:

Drawings to be viewed / printed in colour.

Items shown in red are to be carefully removed.

Annotations highlighting works to be undertaken. For further details refer to Scope of Works.



0 1 2 4m

31/44
Architects

6 Osborn Street
London
E1 6TD
United Kingdom
+44 (0)20 3735 7820
London
3144architects.com

Client
No. 5 The Grove

Project
The Grove

Date
06/05/2021

Drawing name
Demolition Front Elevation (East)

Drawing number
44/2022/PL 1007

Status

Drawn
FG

Checked
SD

Scale / Format


1:50 / A1

1:100 / A3

Rev.	Date	Description	Drawn / Checked
------	------	-------------	-----------------

Do not scale from this drawing.
All dimensions to be verified on site.
This drawing is to be read in conjunction with all consultants information.
Any discrepancies to be reported immediately to the Architect.

Drawing may be scaled for planning purposes.

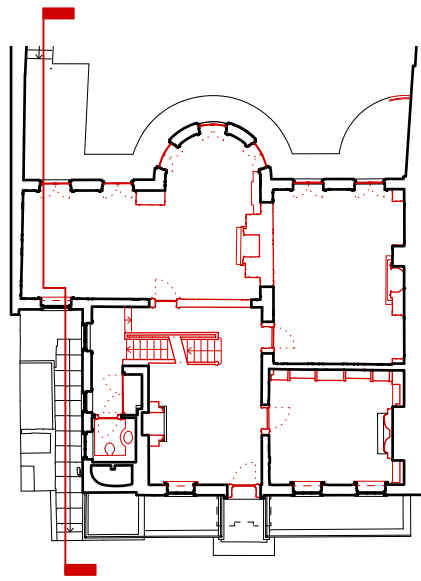

Demolition Notes:

Drawings to be viewed / printed in colour.

Items shown in red are to be carefully removed.

Annotations highlighting works to be undertaken. For further details refer to Scope of Works.



0 1 2 4m

**31/44
Architects**


6 Osborn Street
London
E1 6TD
United Kingdom
+44 (0)20 3735 7820
London
3144architects.com

Client No. 5 The Grove	Status
Project The Grove	
Date 06/05/2021	Drawn FG
Drawing name Demolition Side Elevation (South)	Checked SD
	Scale / Format 1:50 / A1 1:100 / A3

Drawing number
44/2022/PL 1008

Rev.	Date	Description	Drawn / Checked

© 31/44 Architects
Do not scale from this drawing.
All dimensions to be verified on site.
This drawing is to be read in conjunction with all consultants information.
Any discrepancies to be reported immediately to the Architect.
Drawing may be scaled for planning purposes.

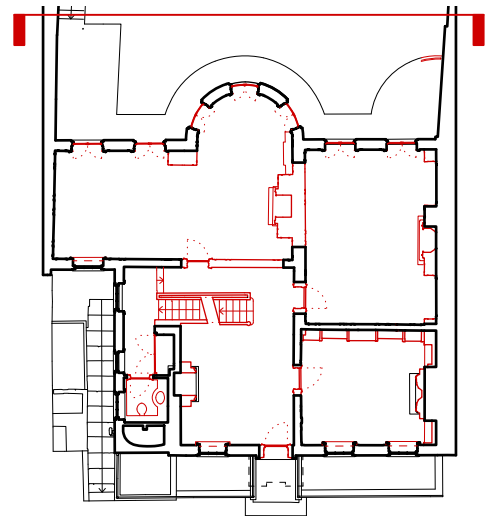

Demolition Notes:

Drawings to be viewed / printed in colour.

Items shown in red are to be carefully removed.

Annotations highlighting works to be undertaken. For further details refer to Scope of Works.



0 1 2 4m

**31/44
Architects**

6 Osborn Street
London
E1 6TD
United Kingdom
+44 (0)20 3735 7820
London
3144architects.com

Client
No. 5 The Grove

Project
The Grove

Date
06/05/2021

Drawing name
Demolition Rear Elevation (West)

Drawing number
44/2022/PL 1009

Status


Drawn
FG

Checked
SD

Scale / Format
1:50 / A1
1:100 / A3

Rev.	Date	Description	Drawn / Checked
------	------	-------------	-----------------

Do not scale from this drawing.
All dimensions to be verified on site.
This drawing is to be read in conjunction with all consultants information.
Any discrepancies to be reported immediately to the Architect.
Drawing may be scaled for planning purposes.

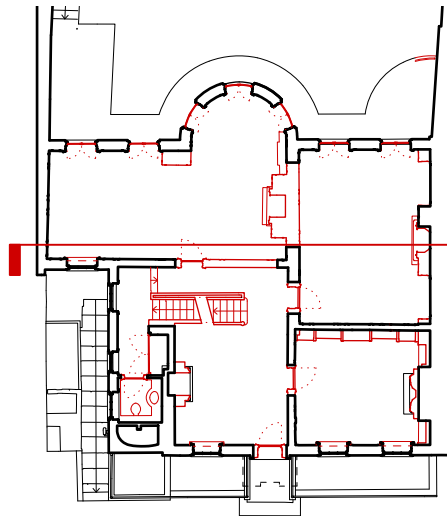

Demolition Notes:

Drawings to be viewed / printed in colour.

Items shown in red are to be carefully removed.

Annotations highlighting works to be undertaken. For further details refer to Scope of Works.



31/44
Architects

6 Osborn Street
London
E1 6TD
United Kingdom
+44 (0)20 3735 7820
London@
3144architects.com

Client
No. 5 The Grove

Project
The Grove

Date
06/05/2021

Drawing name
Demolition Section AA


Drawing number
44/2022/PL 1010

Status

Drawn
FG
Checked
SD
Scale / Format
1:50 / A1
1:100 / A3

Rev.	Date	Description	Drawn /	Checked
------	------	-------------	---------	---------

Do not scale from this drawing.
All dimensions to be verified on site.
This drawing is to be read in conjunction with all consultants information.
Any discrepancies to be reported immediately to the Architect.
Drawing may be scaled for planning purposes.


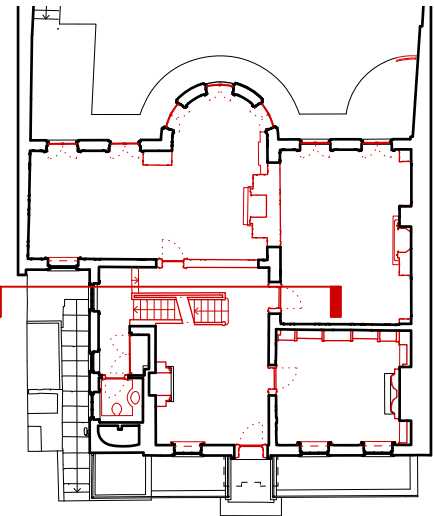


Demolition Notes:

Drawings to be viewed / printed in colour.

Items shown in red are to be carefully removed.

 Annotations highlighting works to be undertaken. For further details refer to Scope of Works.

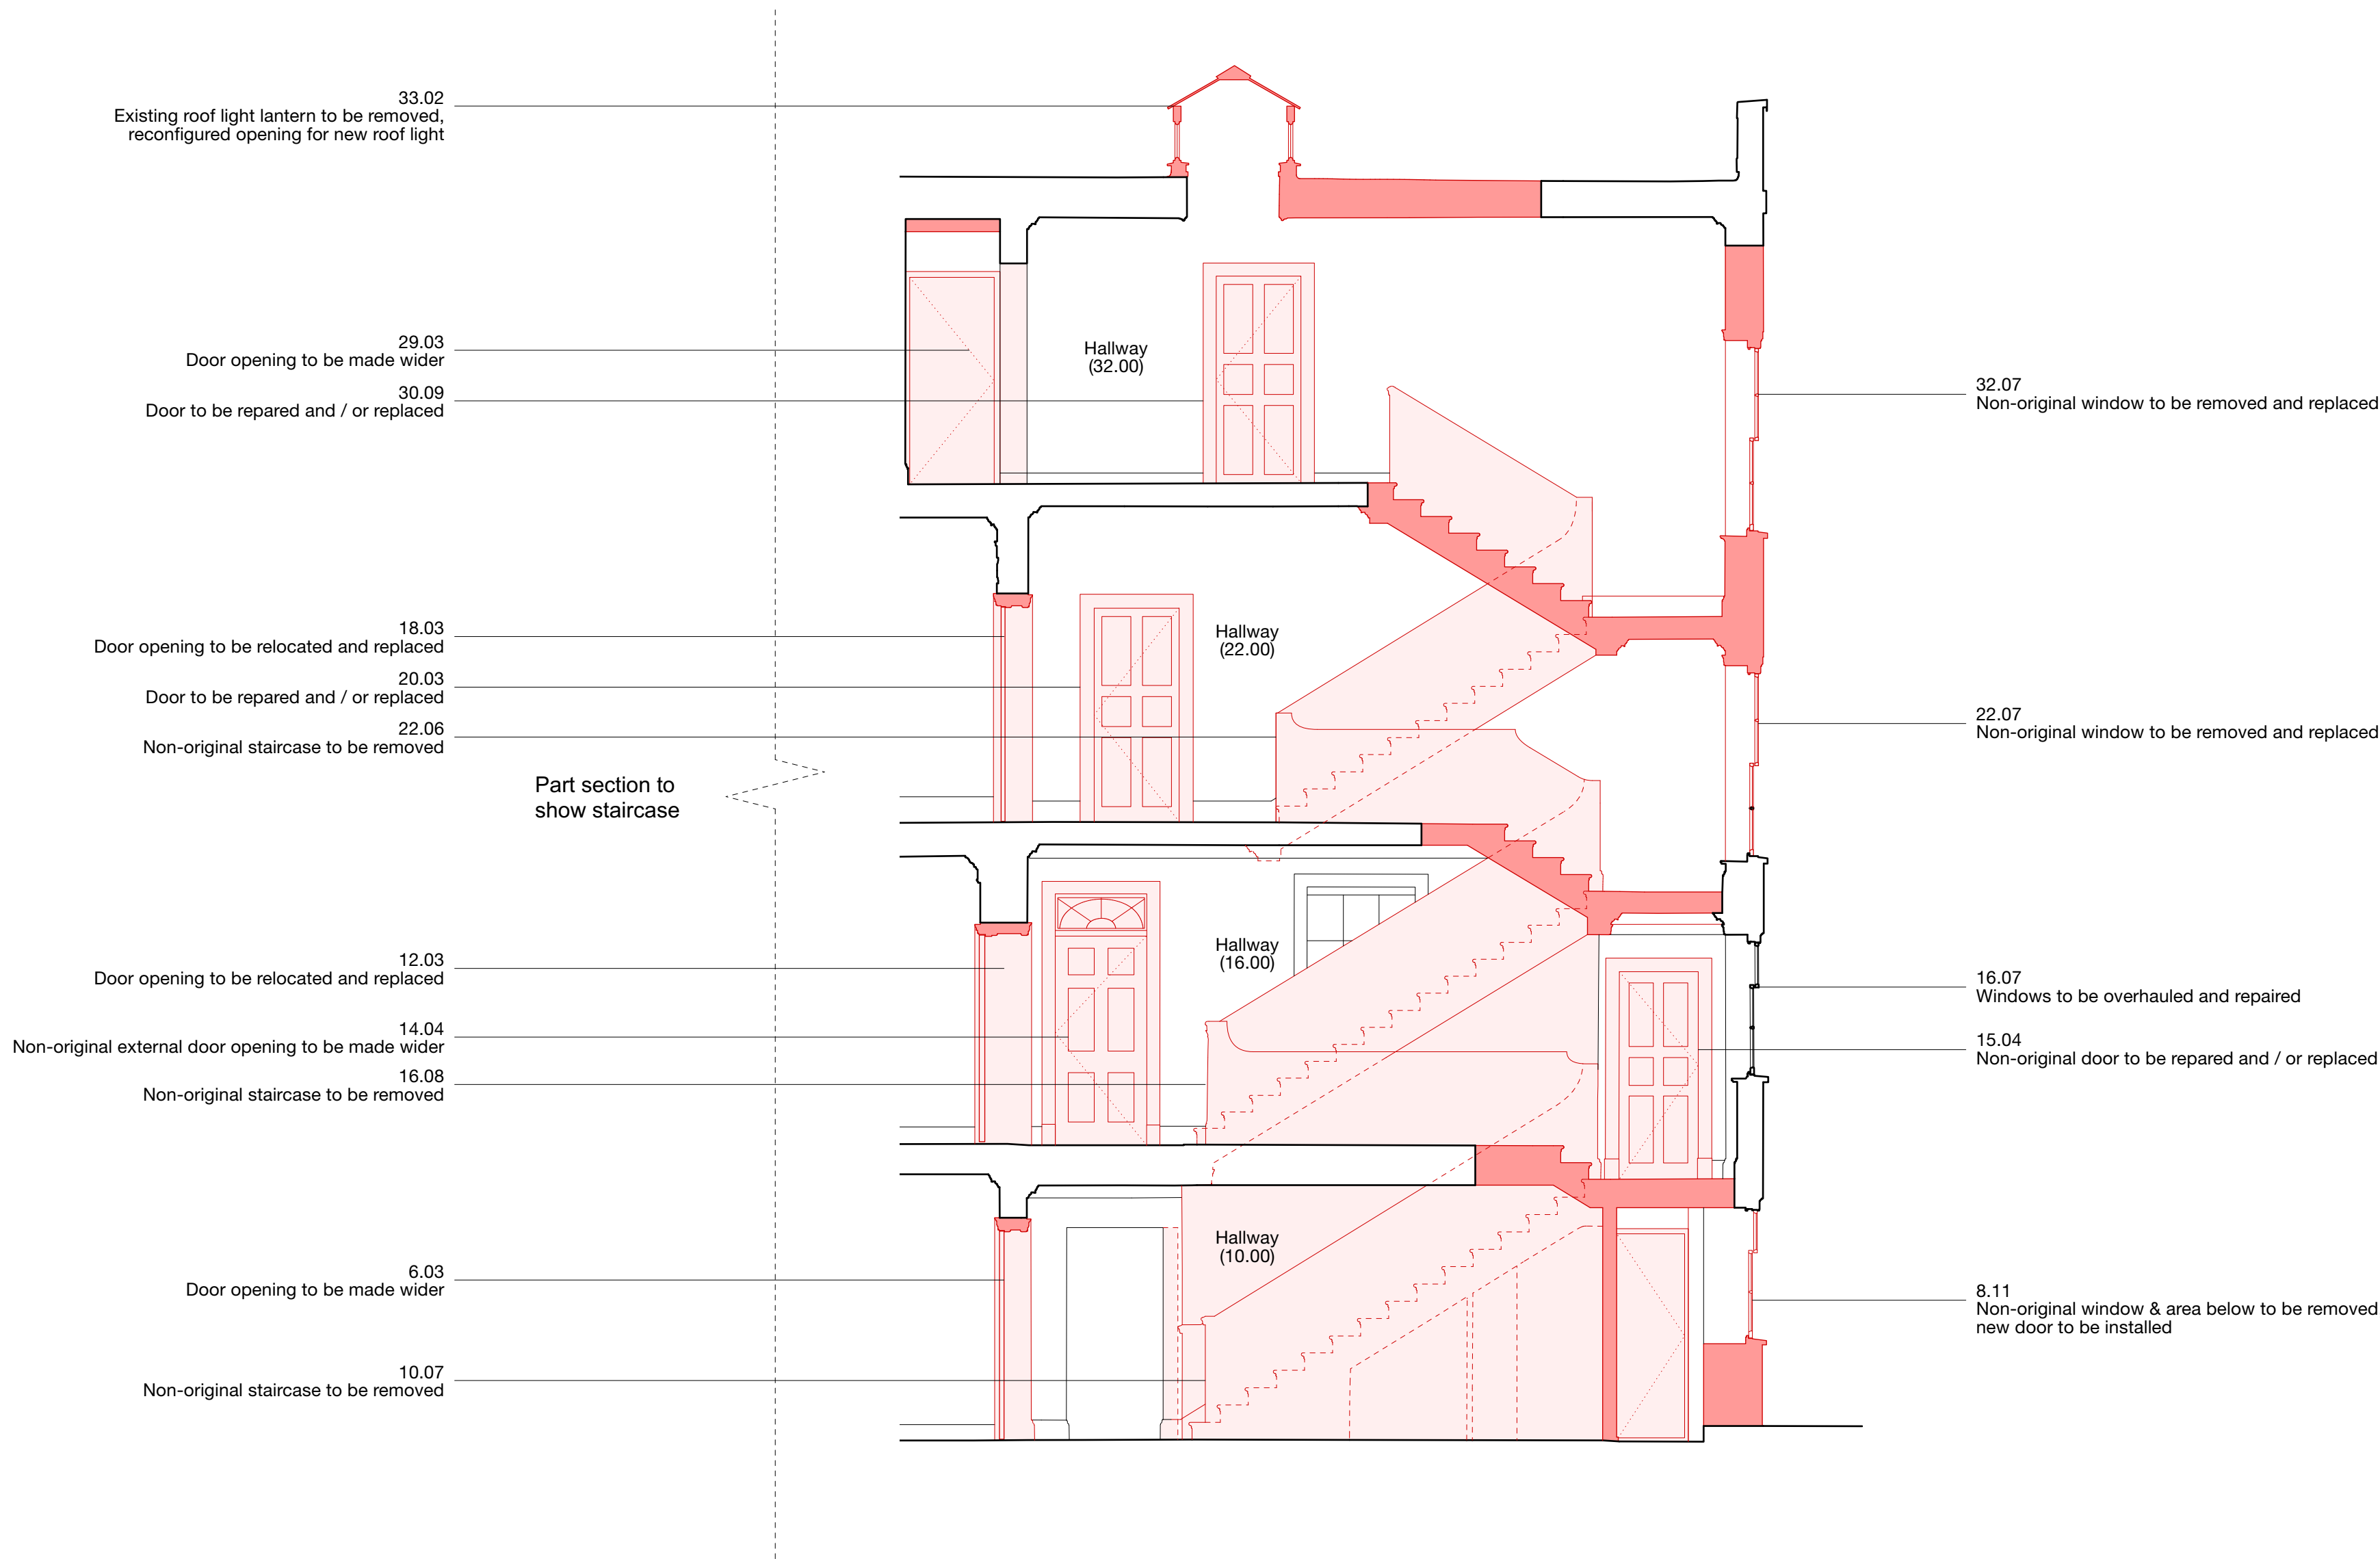

31/44
Architects

6 Osborn Street
London
E1 6TD
United Kingdom
+44 (0)20 3735 7820
London@
3144architects.com

Client
No. 5 The Grove

Project
The Grove

Date
06/05/2021

Drawing name
Demolition Section BB


Drawing number
44/2022/PL 1011

Status

Drawn	Checked
FG	SD
Scale / Format	
1:50 / A1	1:100 / A3

Rev.	Date	Description	Drawn / Checked

© 31/44 Architects
Do not scale from this drawing.
All dimensions to be verified on site.
This drawing is to be read in conjunction with all consultants information.
Any discrepancies to be reported immediately to the Architect.
Drawing may be scaled for planning purposes.

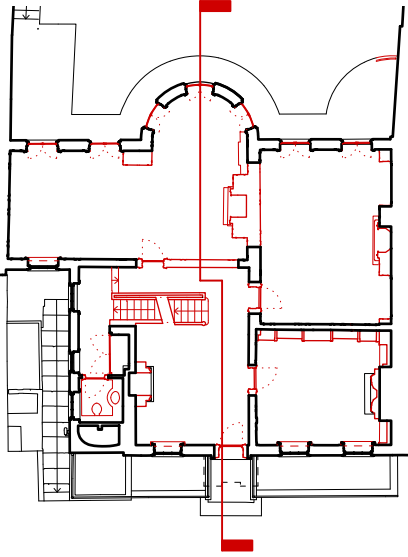


Demolition Notes:

Drawings to be viewed / printed in colour.

Items shown in red are to be carefully removed.

Annotations highlighting works to be undertaken. For further details refer to Scope of Works.

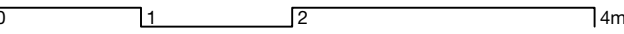

31/44
Architects

6 Osborn Street
London
E1 6TD
United Kingdom
+44 (0)20 3735 7820
London@
3144architects.com

Client
No. 5 The Grove

Project
The Grove

Date
06/05/2021

Drawing name
Demolition Section CC

Drawing number
44/2022/PL 1012

Status

Drawn Checked
FG SD

Scale / Format
1:50 / A1
1:100 / A3

Rev.	Date	Description	Drawn / Checked
------	------	-------------	-----------------

© 31/44 Architects
Do not scale from this drawing.
All dimensions to be verified on site.
This drawing is to be read in conjunction with all consultants information.
Any discrepancies to be reported immediately to the Architect.
Drawing may be scaled for planning purposes.