


boundary

boundary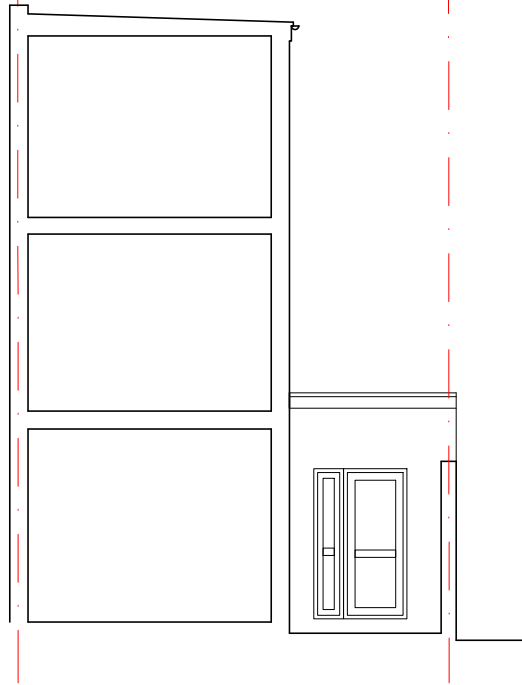

SOUTH ELEVATION





WEST ELEVATION

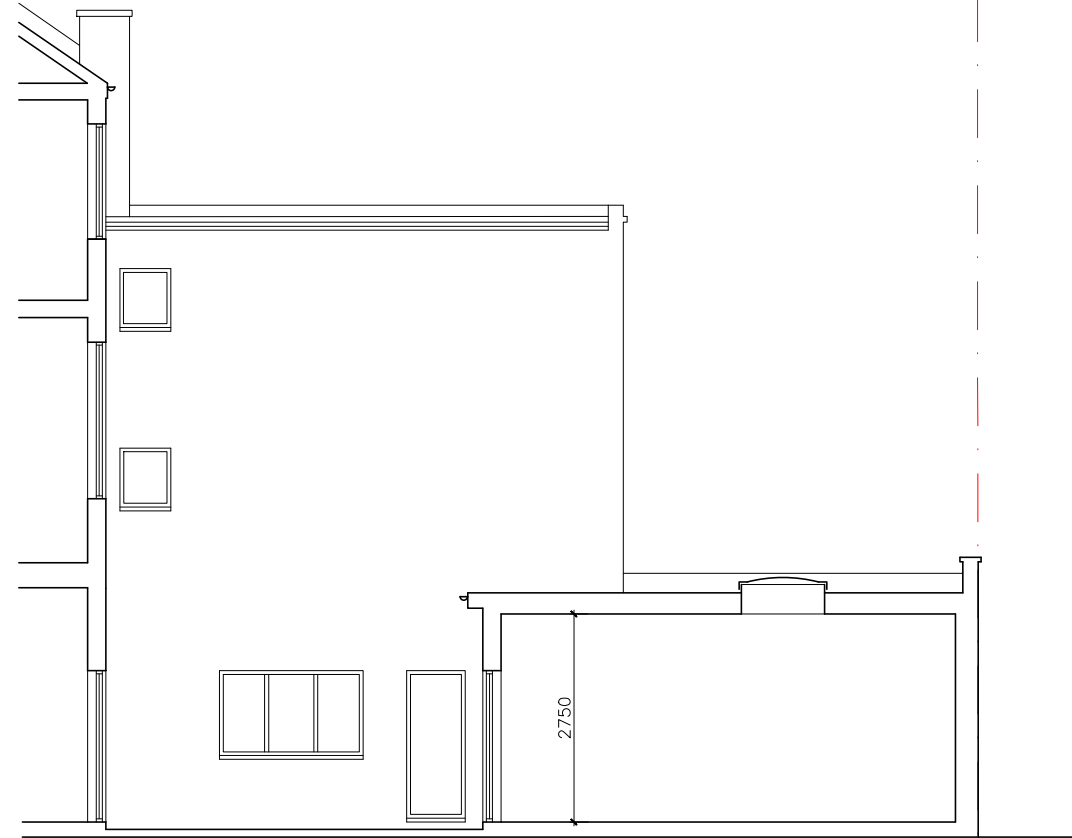


NORTH ELEVATION

Copyright notice:
 This and all other documents authored by VMA and all information and concepts both depicted and implied therein are the sole property of VMA. Reproduction or transmission in any form is strictly forbidden unless prior permission is obtained in writing from VMA. Construction based on the depicted information at any time or location not related to this project is strictly forbidden unless prior permission is obtained in writing from VMA.

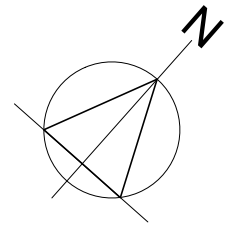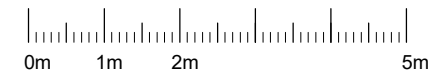

- HMO UNIT 03**
Gross internal area 55.0 m²
- SHOP AREA**
Gross internal area 42.0 m²

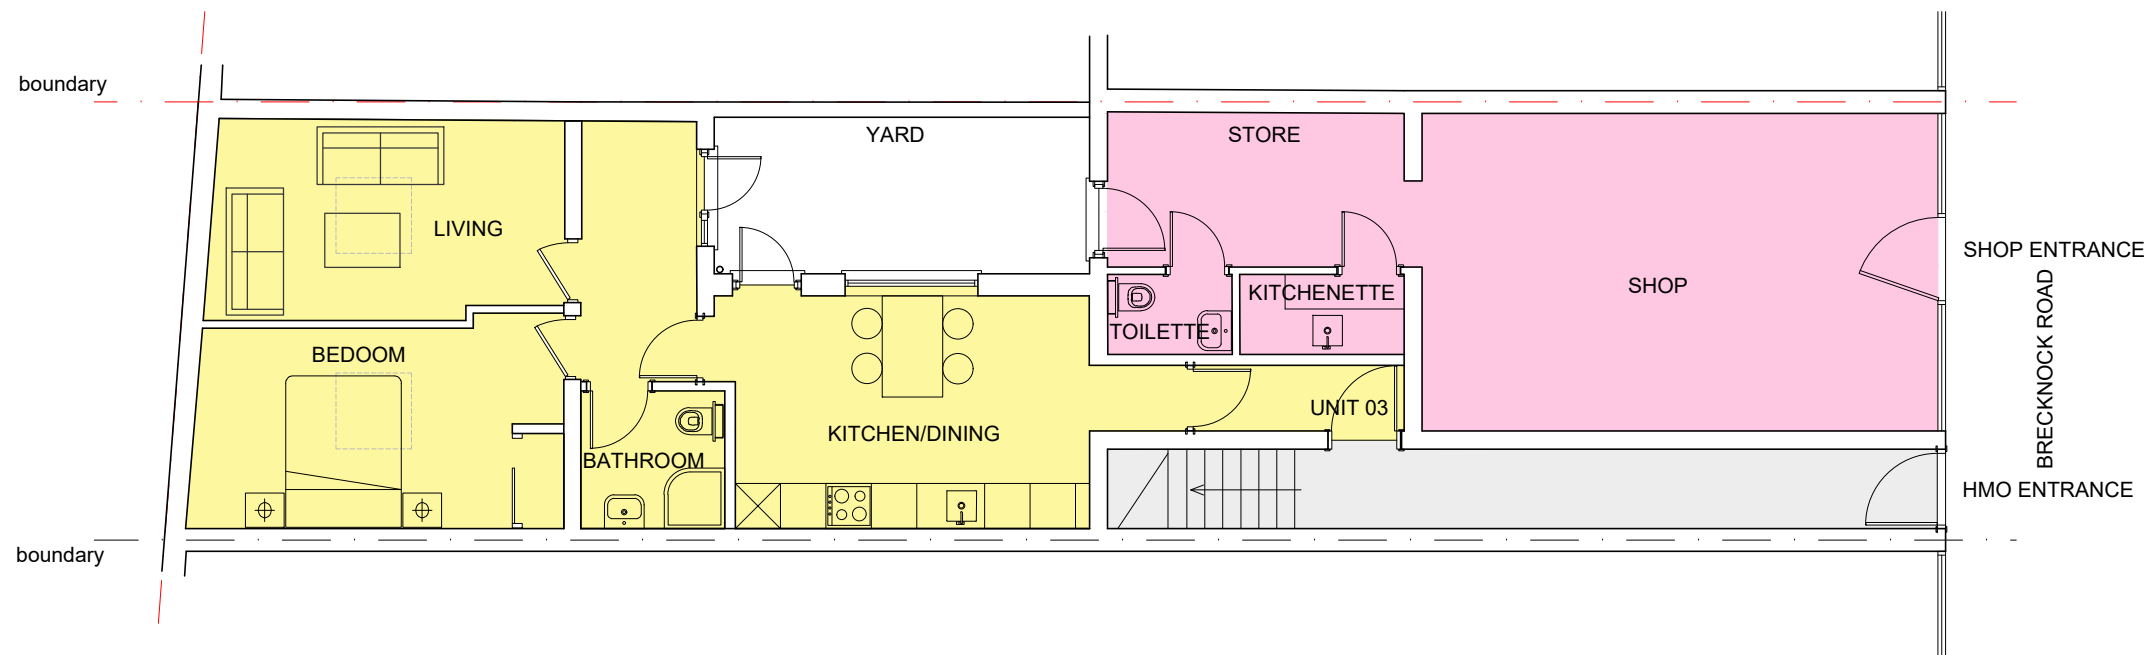

**GROUND FLOOR PLAN
AS BUILT**

00	10.05.21	PLANNING
----	----------	----------

VMA rchitects

21 Sunningfields Road DDI: 020 7936 4222
 London NW4 4QR office@vm-arch.com

Job title
**5 BRECKNOCK ROAD
 LONDON - N7 0BL**

Drawing title
**PLAN, SECTIONS AND ELEVATIONS
 AS BUILT**

Scale	Date	Drawn	Checked
1:100@ A3	May 21	SB	VM
Drawing No.		Rev. No.	
380 - 110		00	