

GENERAL NOTES.

All dimensions to be checked on site prior to commencement of any works, and/or preparation of any shop drawings.

Sizes of and dimensions to any structural elements are indicative only. See structural engineers drawings for actual sizes / dimensions.

Sizes of and dimensions to any service elements are indicative only. See service engineers drawings for actual sizes and dimensions.

This drawing to be read in conjunction with all other Architect's drawings, specifications and other Consultants' information.

All proprietary systems shown on this drawing are to be installed strictly in accordance with the Manufacturers/Suppliers recommended details.


Any discrepancies between information shown on this drawing and any other contract information or manufacturers/suppliers recommendations is to be brought to the attention of the Architect

DO NOT SCALE FROM THIS DRAWING.

NOTES.

1	STAGE 4 ISSUED FOR TENDER	07/05/21
REVISION		DATE
Buckley Gray Yeoman		
Studio 4.04 The Tea Building 56 Shoreditch High Street London E1 6JJ T: 020 7033 9913 F: 020 7033 9914		
CLIENT		SPAN GROUP
PROJECT		SHORT'S GARDENS
DRAWING		Existing Section DD
SCALE 1:100 @ A1 (1:200 @ A3)		
DATE	MAY 2021	DRAWN BY AHI
DWG No.	1087_ES-04	REVISION T1
DRAWING STATUS		STAGE 4

Information contained on this drawing is the sole copyright of Buckley Gray Yeoman and is not to be reproduced without their permission.

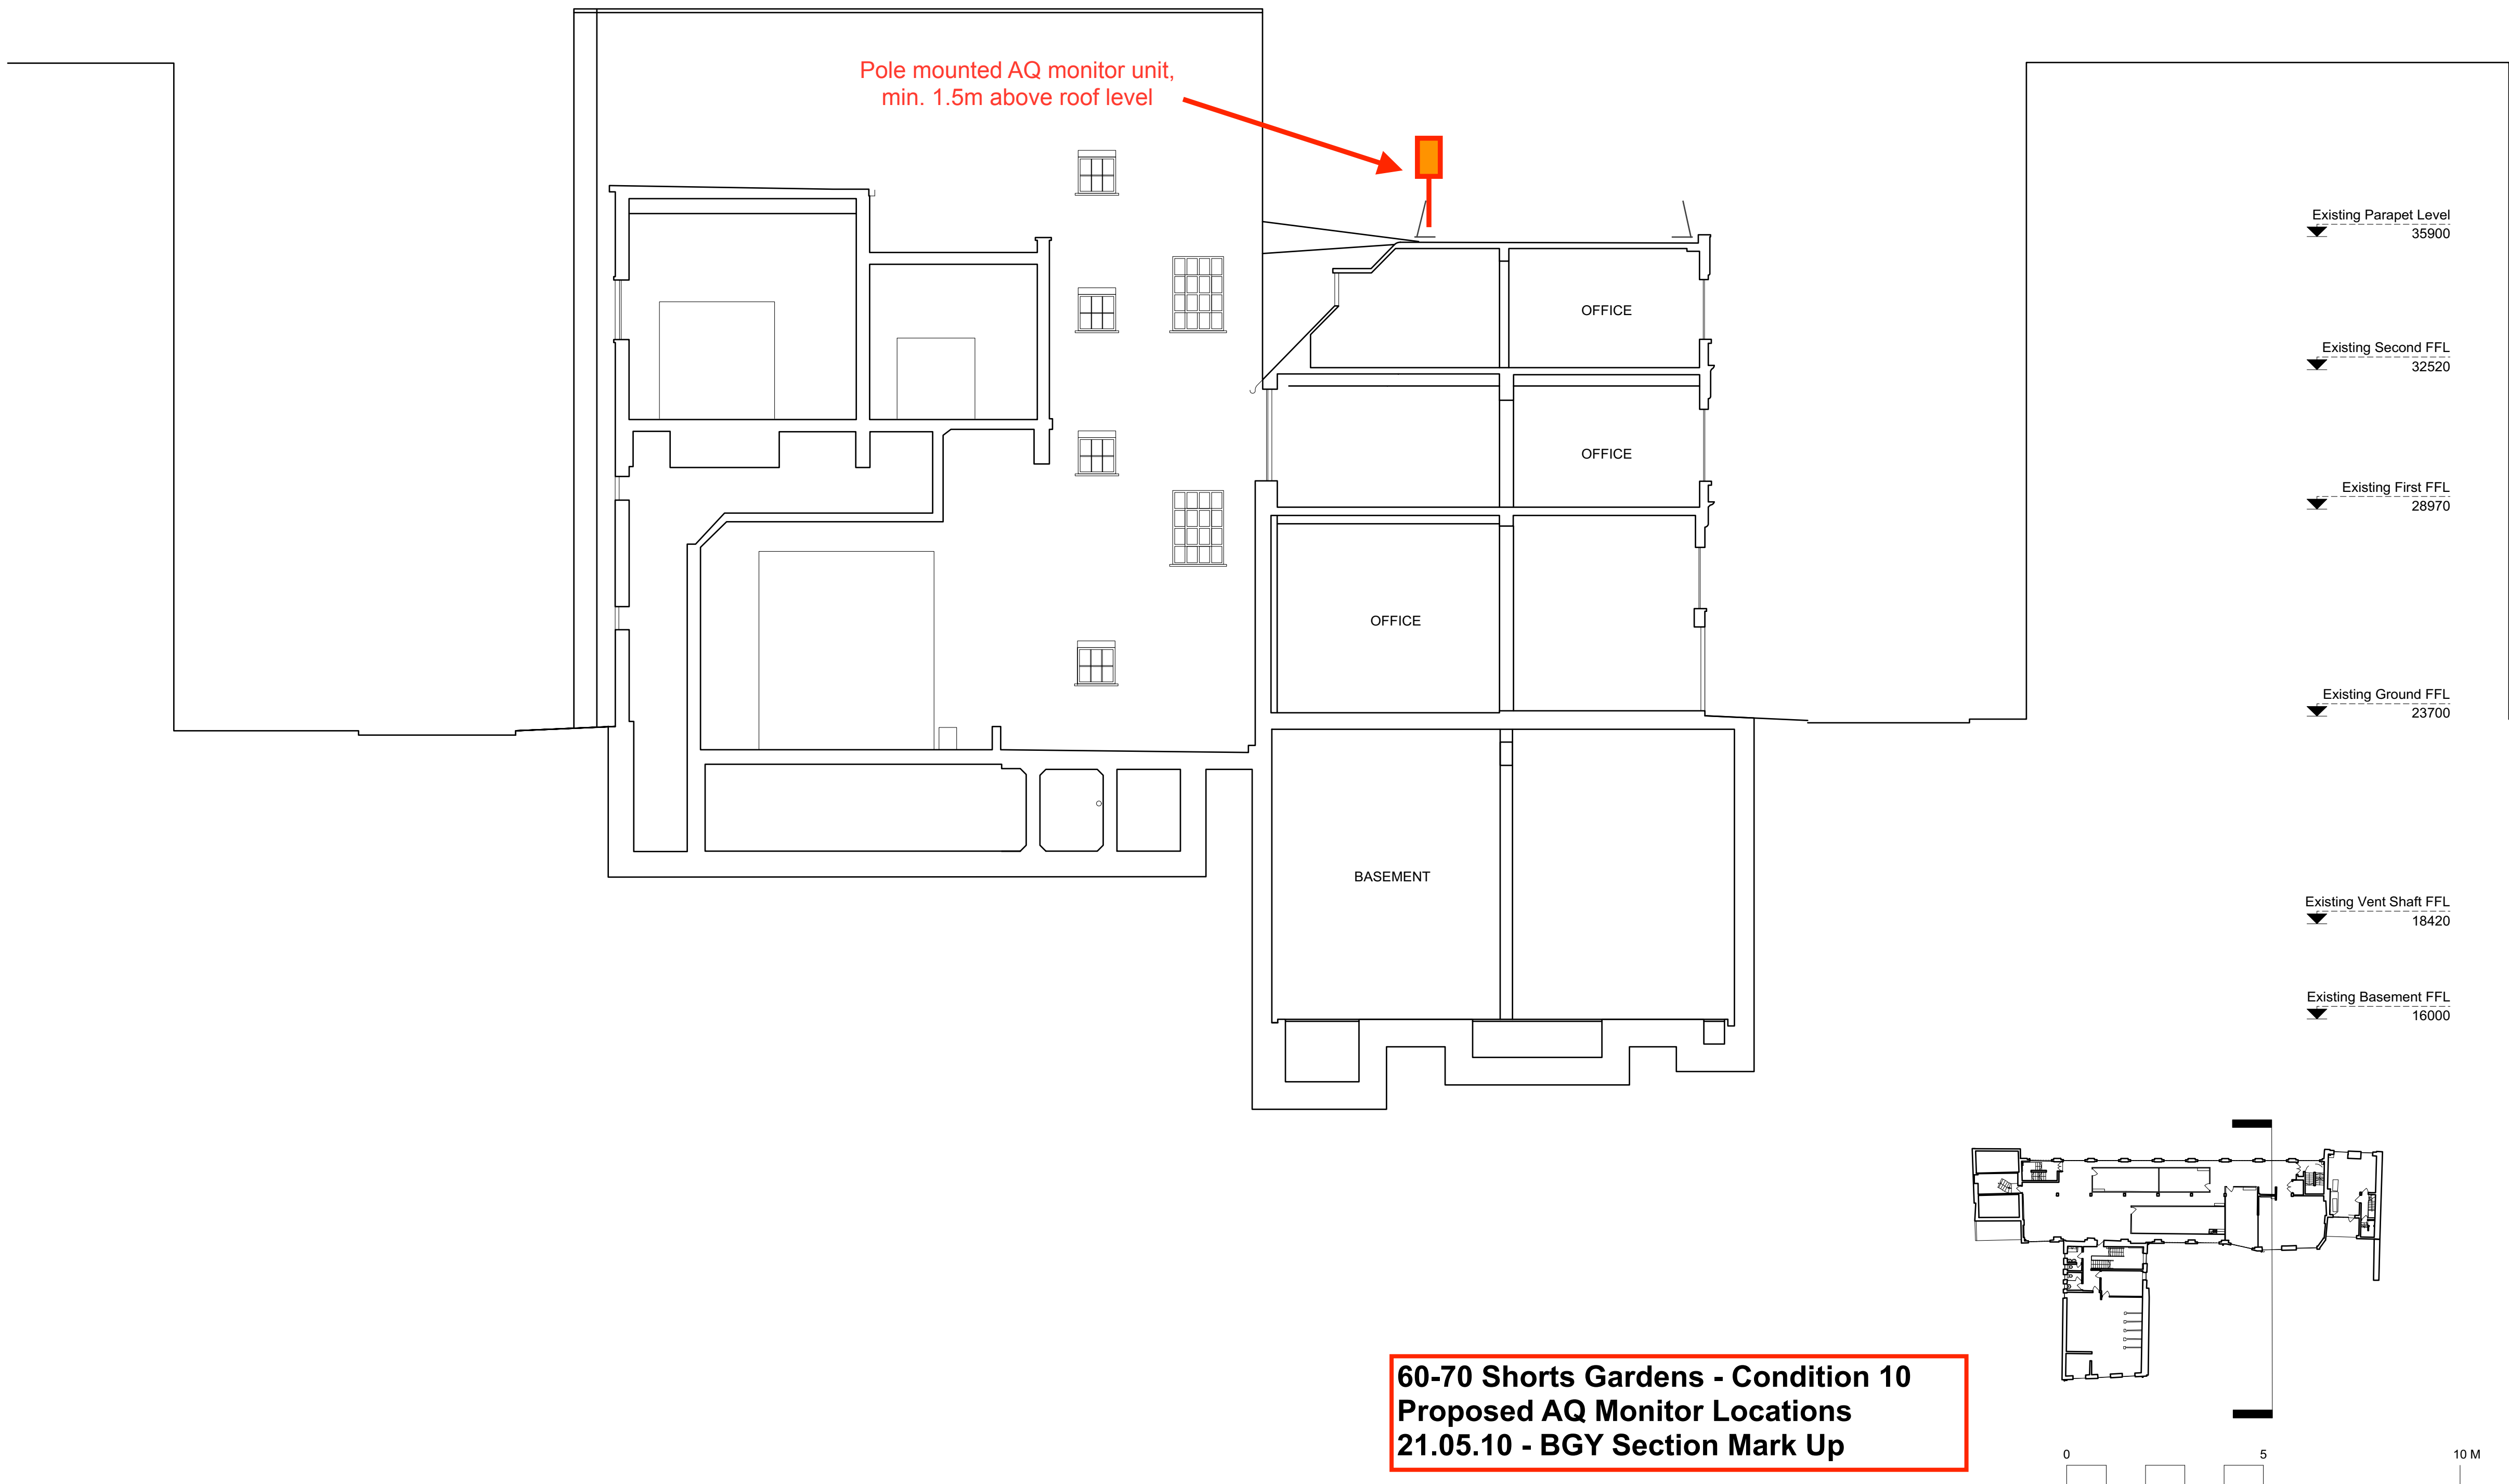

60-70 Shorts Gardens - Condition 10  
Proposed AQ Monitor Locations  
21.05.10 - BGY Section Mark Up