


3BM Ltd. are the copyright owner of the design shown on this drawing. It may not be edited or reproduced without their prior written consent. All levels and dimensions to be checked on site. This drawing is to be read in conjunction with all other relevant drawings and specifications. Any discrepancies to be reported immediately. Do not scale from this drawing.


3BM Limited, Lilla Huset, 191 Talgarth Road, London, W6 8BJ, T: 0345270 8260



NOTES
Drawings procured from record drawings
Dimensions to be checked on site

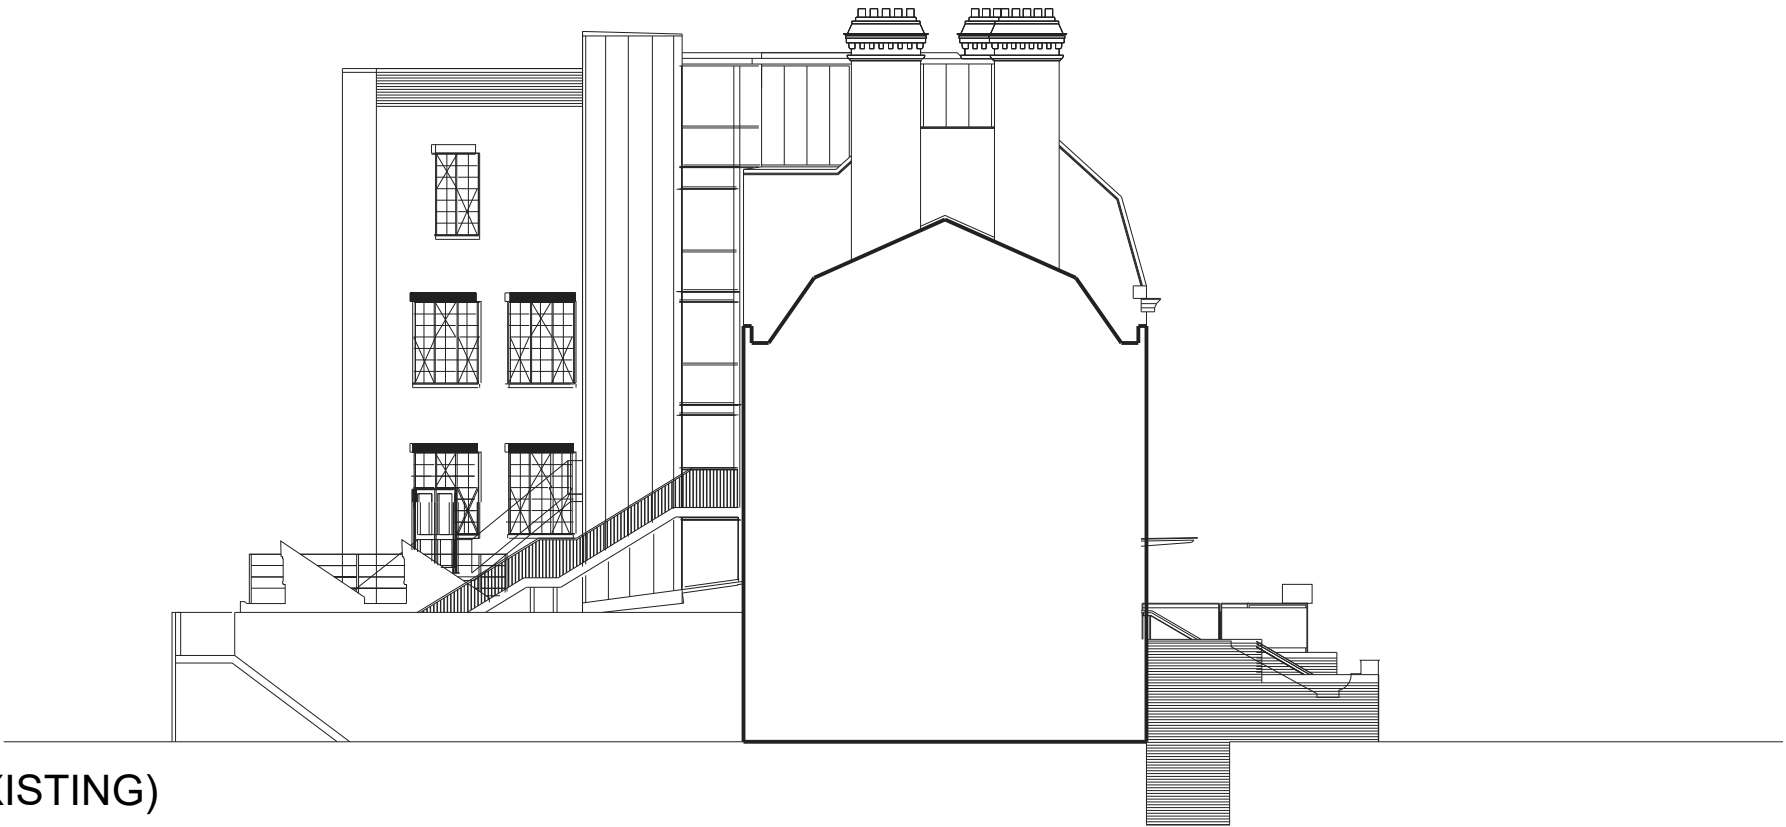

WEST ELEVATION (EXISTING)

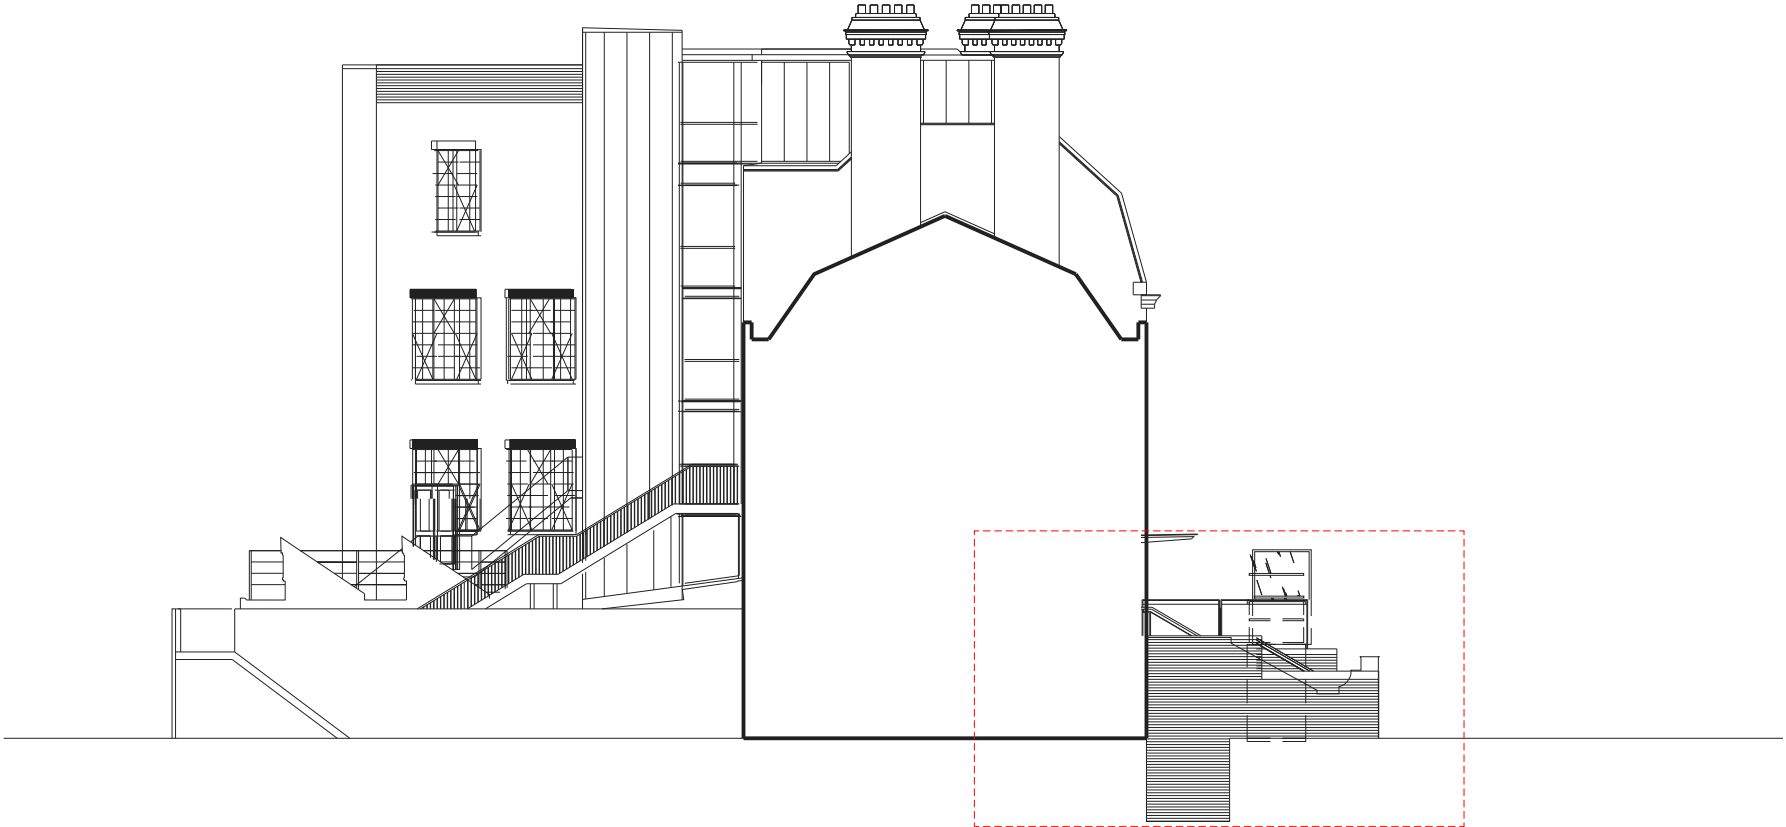

WEST ELEVATION (PROPOSED)



Rev	Date	Description	Initials
-----	------	-------------	----------

Client

WORKING MEN'S COLLEGE

Project Name

LIFT REPLACEMENT

Drawing Title

EXISTING AND PROPOSED WEST ELEVATION

Issue Status

PLANNING

Scale & Paper Size		Date Originated		Drawn	
1:200@A3		12/2020		VP	
Project No.	Stage	No.	Rev.		
P404	3	201	00		

