


1 AS BUILT PASSAGEWAY ELEVATION
1:50 @ A1

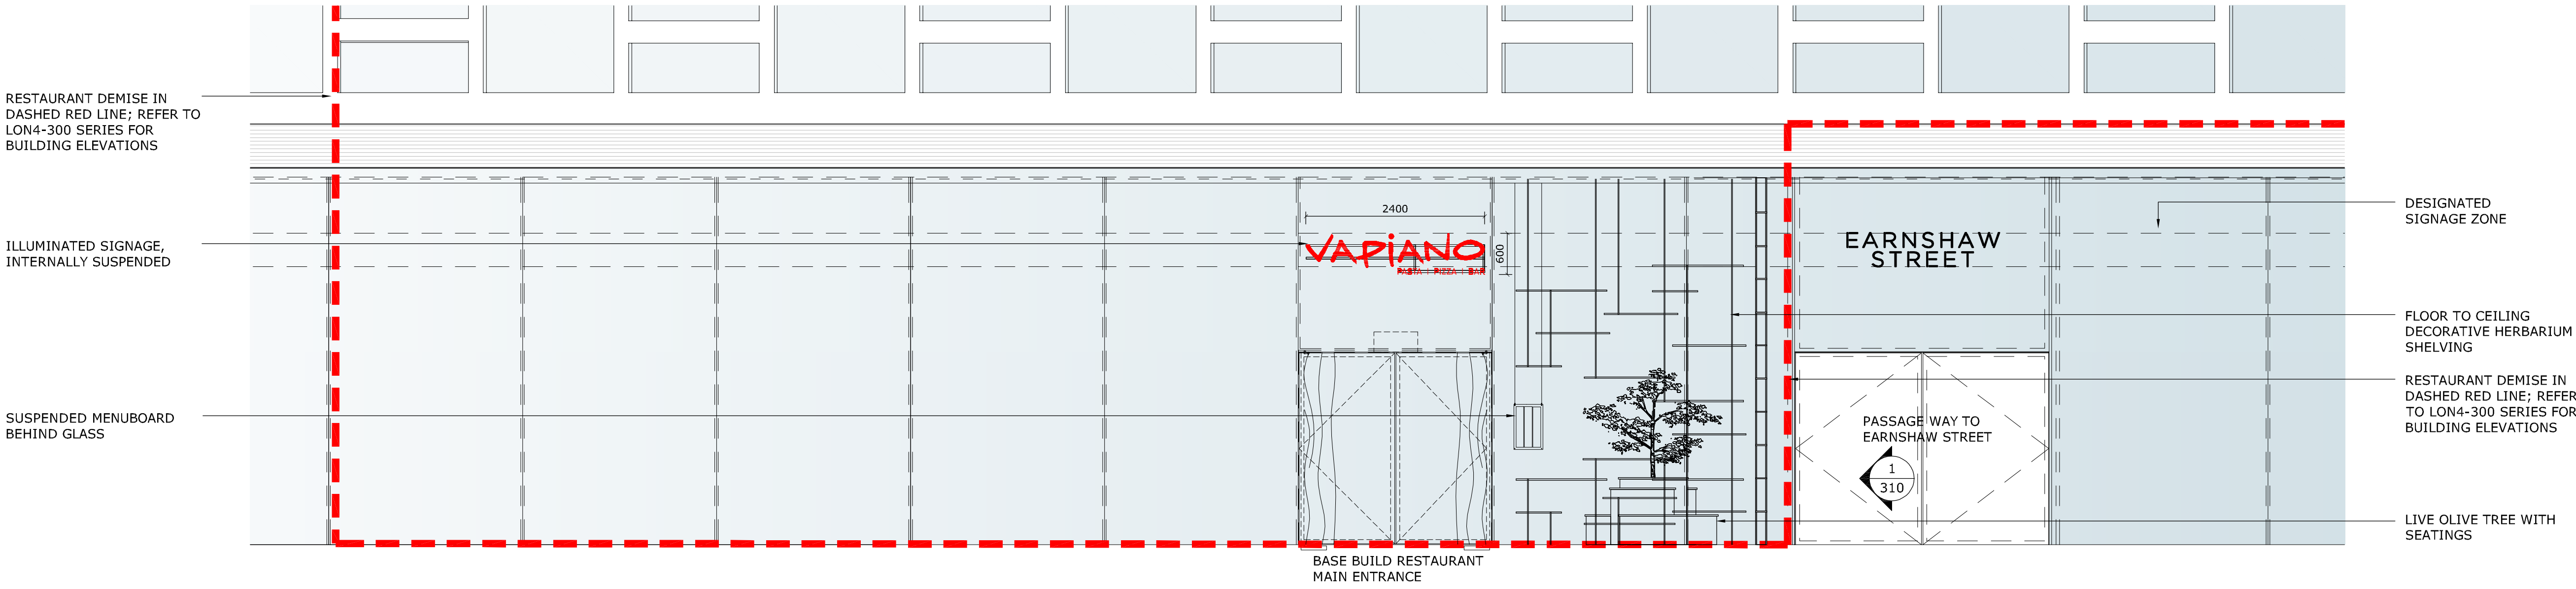

2 AS BUILT SHOPFRONT ELEVATION
1:50 @ A1

GENERAL NOTES:

DO NOT SCALE FROM THIS DRAWING
ALL DIMENSIONS TO BE CHECKED ON SITE
ANY OMISSIONS OR DISCREPANCIES TO BE
REPORTED TO THE ARCHITECT IMMEDIATELY
IF IN DOUBT ASK

P3	06.07.21	LISTED BUILDING CONSENT	FG
P2	23.04.21	ADVERTISEMENT	FG
T1	16.04.21	TENDER	FG
P1	16.03.21	LISTED BUILDING CONSENT	FG
REV	DATE	NOTES	DR

DRAWING STATUS

PLANNING

CLIENT

ARCHITECT

FINKERNAGEL ROSS

Third Floor
Unicorn House
221–222 Shoreditch High
Street
London E1 6PJ
Tel: 020 7377 5114
info@finkernagelross.com
www.finkernagelross.com

PROJECT

VAPIANO LONDON 4
CENTRE POINT
LONDON WC2H

DRAWING TITLE

EXISTING SHOPFRONT
& PASSAGEWAY ELEVATIONS

DRAWN	DR. DATE	CHECKED	CH. DATE
FG	03.03.21	FF	06.07.21

SCALE	SHEET SIZE
1:50 @ A1	A1

DRAWING NO	REVISION
VAP-LON4-310	P3