

No. Of Piles	
Pile Size	Count
600	159

FOR TYPICAL NOTES, PLEASE REFER TO DRAWING 01001



Project
BEDFORD PASSAGE DEVELOPMENT

UK & IRELAND
 Client

MIDDLESEX ANNEXE LLP

Consultant


AECOM
 Aldgate Tower
 2 Leman Street
 London E1 8FA
 United Kingdom
 Tel +44 (0) 20 7061 7000
 www.aecom.com

Notes

- Do not scale from this drawing. Work to figured dimensions only.
- This drawing is to be read in conjunction with:
 - AECOM Structural Specifications
 - Design reports
 - Survey and Interpretative Reports
 - Project Specifications and Performance Specifications
 - Health and Safety Hazard Register
 - Relevant drawings and documentation issued by the architect, engineers and specialists.
 - Basement Sequencing Drawings
 - Movements and Tolerances Report
- All dimensions are in mm except levels which are in metres and relate to [ordance datum].
- Any discrepancies shall be referred to the Designer before work commences.

Legend:

- As-Built site coordinates of contractor's steel king post piles (installed in 2020) used for temporary works. KP piles that impact fully on the permanent works structure (in location and level) need to be removed. To be reviewed.
- Indicates piles installed in August 2020

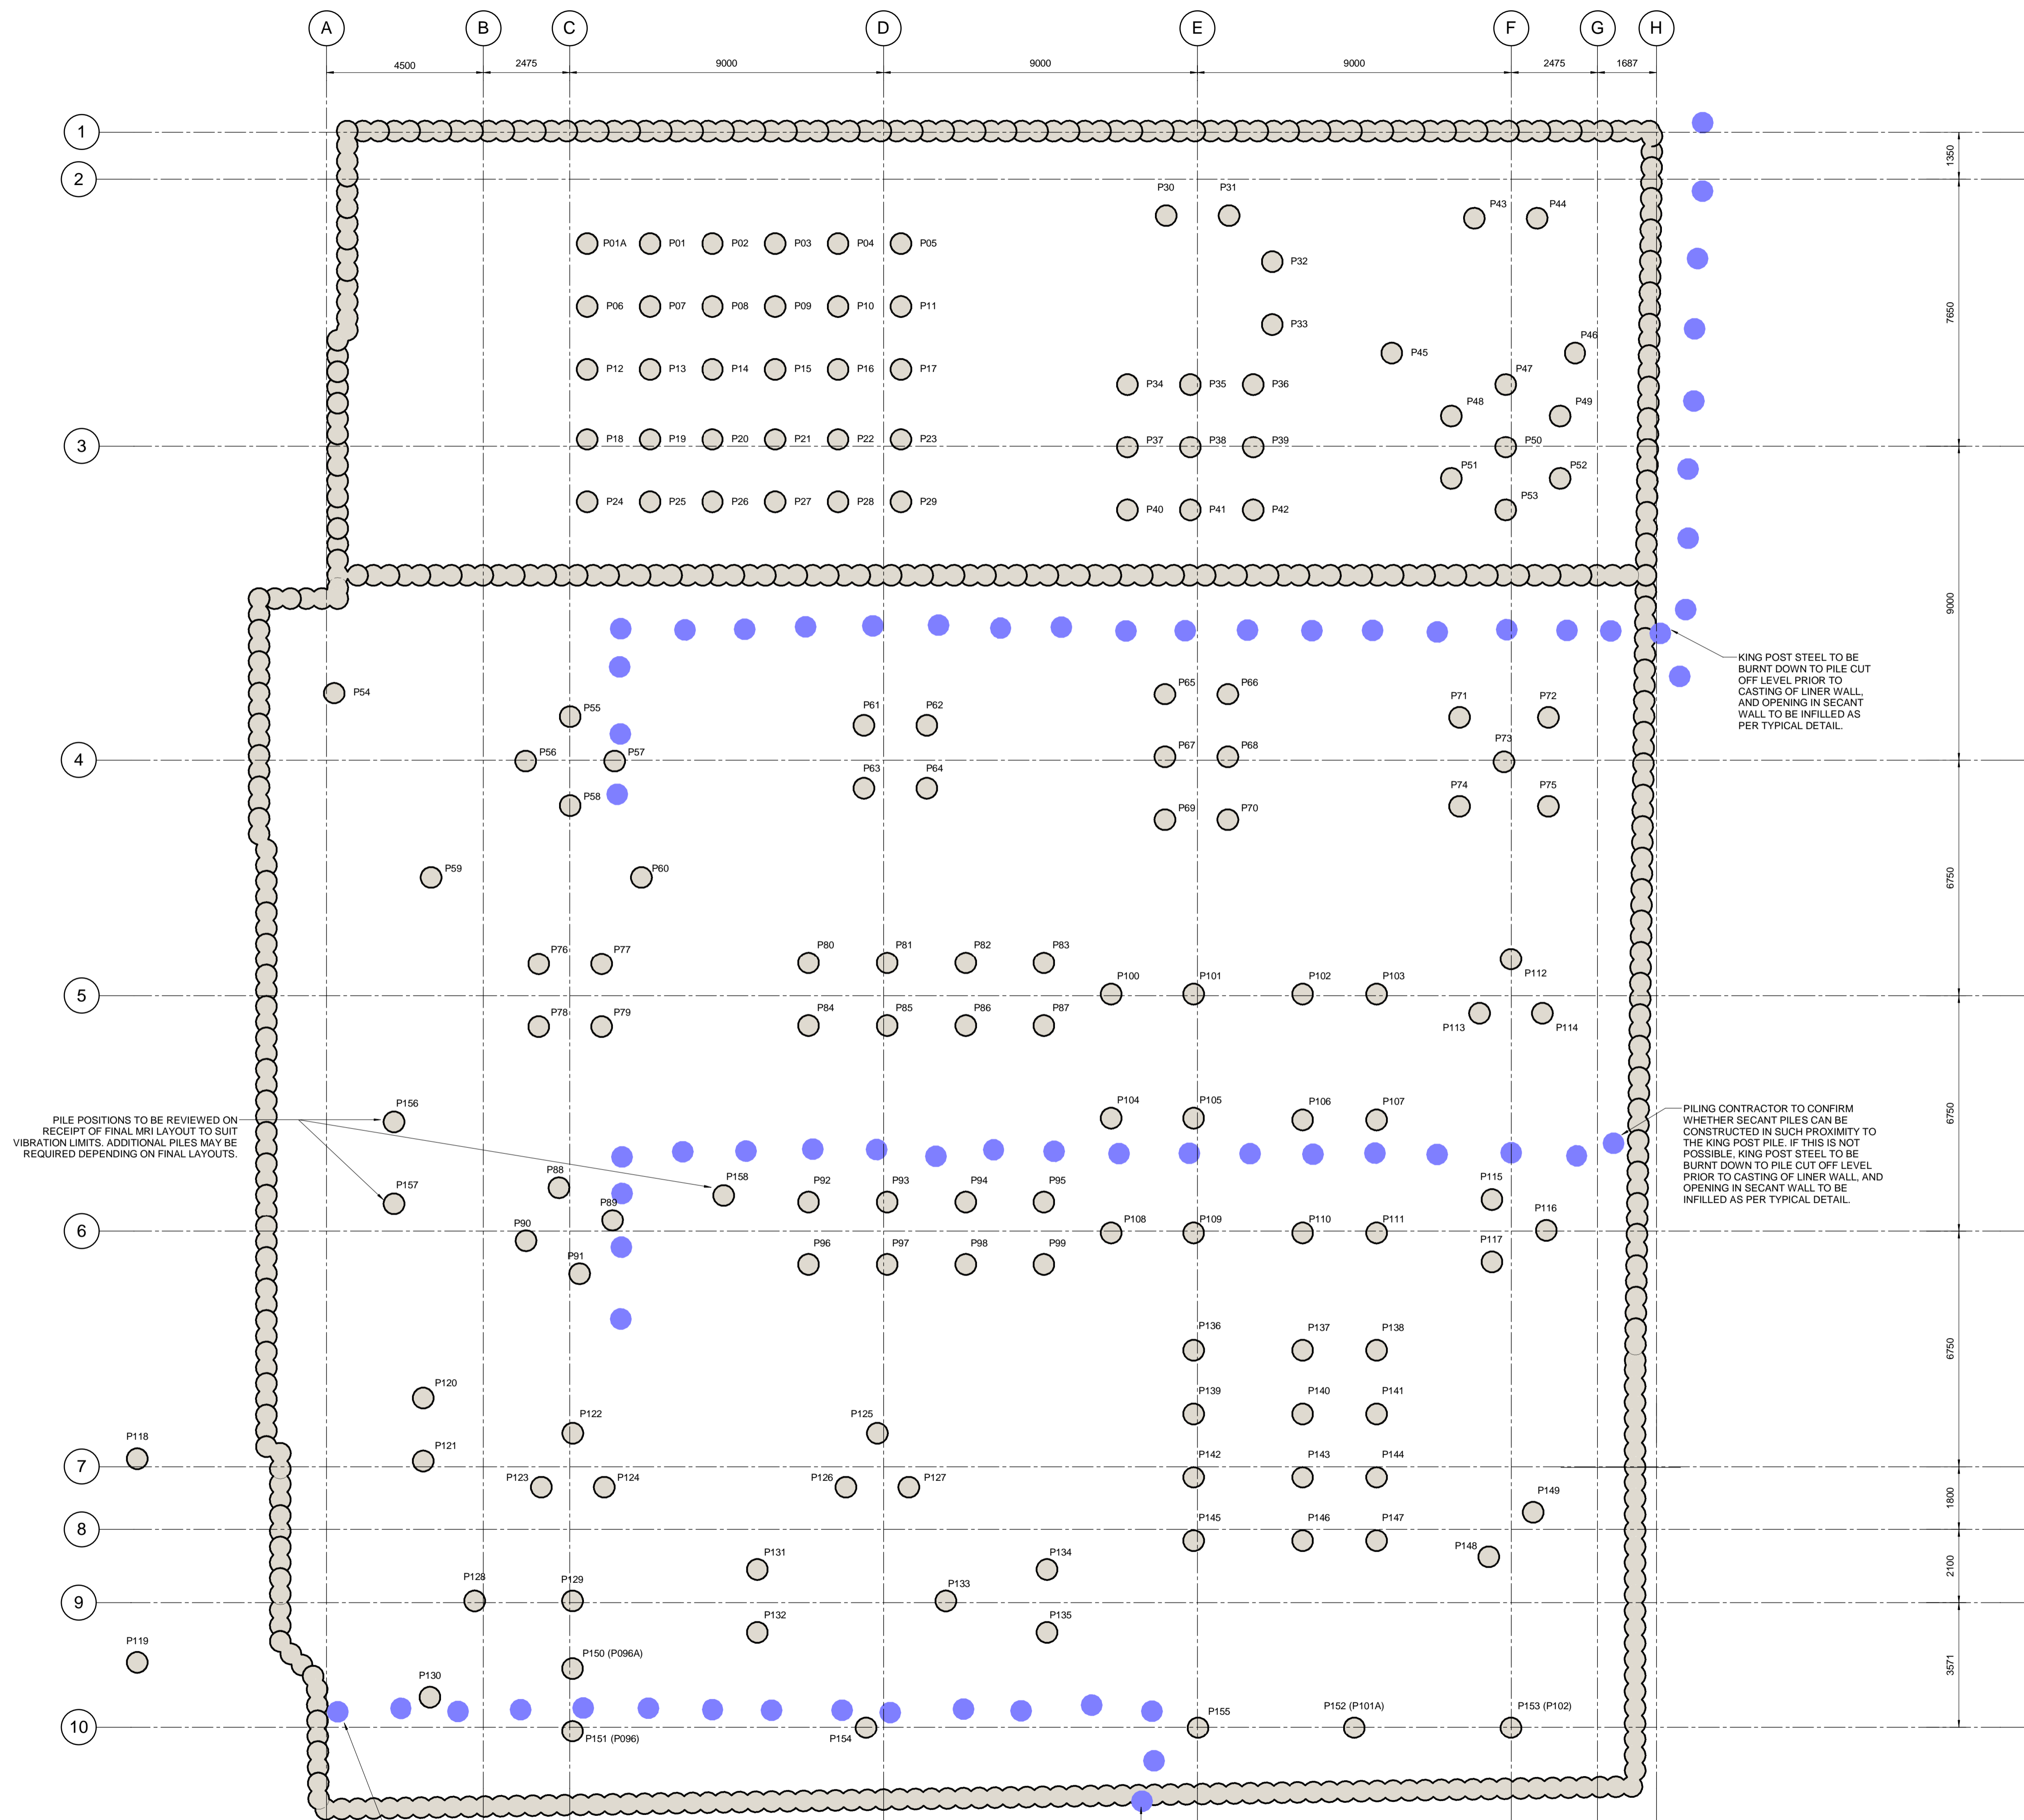

PILE POSITIONS TO BE REVIEWED ON RECEIPT OF FINAL MRI LAYOUT TO SUIT VIBRATION LIMITS. ADDITIONAL PILES MAY BE REQUIRED DEPENDING ON FINAL LAYOUTS.

PILING CONTRACTOR TO CONFIRM WHETHER SECANT PILES CAN BE CONSTRUCTED IN SUCH PROXIMITY TO THE KING POST PILE. IF THIS IS NOT POSSIBLE, KING POST STEEL TO BE BURNT DOWN TO PILE CUT OFF LEVEL PRIOR TO CASTING OF LINER WALL, AND OPENING IN SECANT WALL TO BE INFILLED AS PER TYPICAL DETAIL.

PILING CONTRACTOR TO CONFIRM WHETHER SECANT PILES CAN BE CONSTRUCTED IN SUCH PROXIMITY TO THE KING POST PILE. IF THIS IS NOT POSSIBLE, KING POST STEEL TO BE BURNT DOWN TO PILE CUT OFF LEVEL PRIOR TO CASTING OF LINER WALL, AND OPENING IN SECANT WALL TO BE INFILLED AS PER TYPICAL DETAIL.

Pile Layout
 1 : 100

Issue/Revision

Rev.	Date	Description	Dr/Chk/Apr
T8	23.10.20	ISSUED FOR TENDER	RH/KSF/DW
		STAGE 4 REDESIGN	
T7	02.09.20	PILE LOCATION REVISED	RH/KSF/DW
T6	24.08.20	PILE P098 REMOVED. PILES P098A & P101A ADDED. PILE ORIENTATION REVISED WHERE CLOUDED	RH/DB/DB
T5	03.07.20	STAGE 4 (PCSA STAGE 1 DESIGN REVIEW)	RH/CL/DW
T4	28.10.18	TENDER - STAGE 1	MN/DW/DW
T3	19.06.18	STAGE 4 TENDER (2)	MN/DW/DW
T2	01.05.18	STAGE 4 TENDER	MN/DW/DW
T1	29.03.18	STAGE 4 TENDER (DRAFT)	MN/DW/DW
A	23.01.18	STAGE 3 ISSUE_WIP	MN/DW/DW

Purpose Of Issue

STAGE 4 TENDER

Project Number

60516144

Sheet Title

New Build
 Pile Layout

Sheet Number

MHA-ACM-00-B1-DR-SE-01012

Scale: 1 : 100@A1

Rev: T8

This drawing has been prepared for the use of AECOM's client. It may not be used, modified, reproduced or relied upon by third parties, except as agreed by AECOM or as required by law. AECOM accepts no responsibility, and denies any liability whatsoever, to any party that uses or relies on this drawing without AECOM's express written consent. Do not scale this document. All measurements must be obtained from the scaled dimensions.