

Concrete (RC) - Ground Beam Schedule		
Beam Ref	Beam Dimensions	
	Depth	Width
CGB1	900 mm	900 mm
CGB2	750 mm	900 mm
CGB3	1200 mm	900 mm
CGB4	1310 mm	900 mm
CGB5	1410 mm	750 mm
CGB6	1410 mm	900 mm

TO BE READ IN CONJUNCTION WITH DRAWINGS:

01000 - BASEMENT B2  
 01001 - BASEMENT B1  
 01012 - PILE LAYOUT  
 01014 - PILE SCHEDULE  
 01106 - SECANT PILING  
 05003 - PILECAP DETAILS  
 05006 - PILECAP DETAILS (NON-STANDARD)

PILECAPS ARE INTEGRAL WITH THE BASEMENT SLAB CONSTRUCTION. REFER TO ALL BASEMENT DRAWINGS.

FOR TYPICAL NOTES, PLEASE REFER TO DRAWING 01001



**Project**  
**BEDFORD PASSAGE DEVELOPMENT**

UK & IRELAND  
**Client**  
**MIDDLESEX ANNEXE LLP**

**Consultant**  
**AECOM**  
 Aldgate Tower  
 2 Leman Street  
 London E1 8FA  
 United Kingdom  
 Tel +44 (0) 20 7061 7000  
 www.aecom.com

- Notes**
- Do not scale from this drawing. Work to figured dimensions only.
  - This drawing is to be read in conjunction with:
    - AECOM Structural Specifications
    - Design reports
    - Survey and Interpretative Reports
    - Project Specifications and Performance Specifications
    - Health and Safety Hazard Register
    - Relevant drawings and documentation issued by the architect, engineers and specialists.
    - Basement Sequencing Drawings
    - Movements and Tolerances Report
  - All dimensions are in mm except levels which are in metres and relate to [ordance datum].
  - Any discrepancies shall be referred to the Designer before work commences.

- Legend:**
- As-Built site coordinates of contractor's steel king post piles (installed in 2020) used for temporary works. KP piles that impact fully on the permanent works structure (in location and level) need to be removed. To be reviewed.
  - Indicates piles installed in August 2020

**Issue/Revision**

Rev	Date	Description	Dr/Chk/Apr
T6	23.10.20	ISSUED FOR TENDER	RH/KSF/DW
T5	03.07.20	STAGE 4 REDESIGN	
T4	26.10.18	TENDER - STAGE 1 DESIGN (REVIEW)	RH/C/DW
T3	19.06.18	TENDER - STAGE 1	MNDW/DW
T2	01.05.18	STAGE 4 TENDER (2)	MNDW/DW
T1	29.03.18	STAGE 4 TENDER (DRAFT)	MNDW/DW
A	23.01.18	STAGE 3 ISSUE_WIP	MNDW/DW


**Purpose Of Issue**  
**STAGE 4 TENDER**

**Project Number**  
 60516144

**Sheet Title**  
 New Build Foundation Plan

**Sheet Number**  
 MHA-ACM-00-B1-DR-SE-01013

**Scale:** 1 : 100@A1 **Rev:** T6

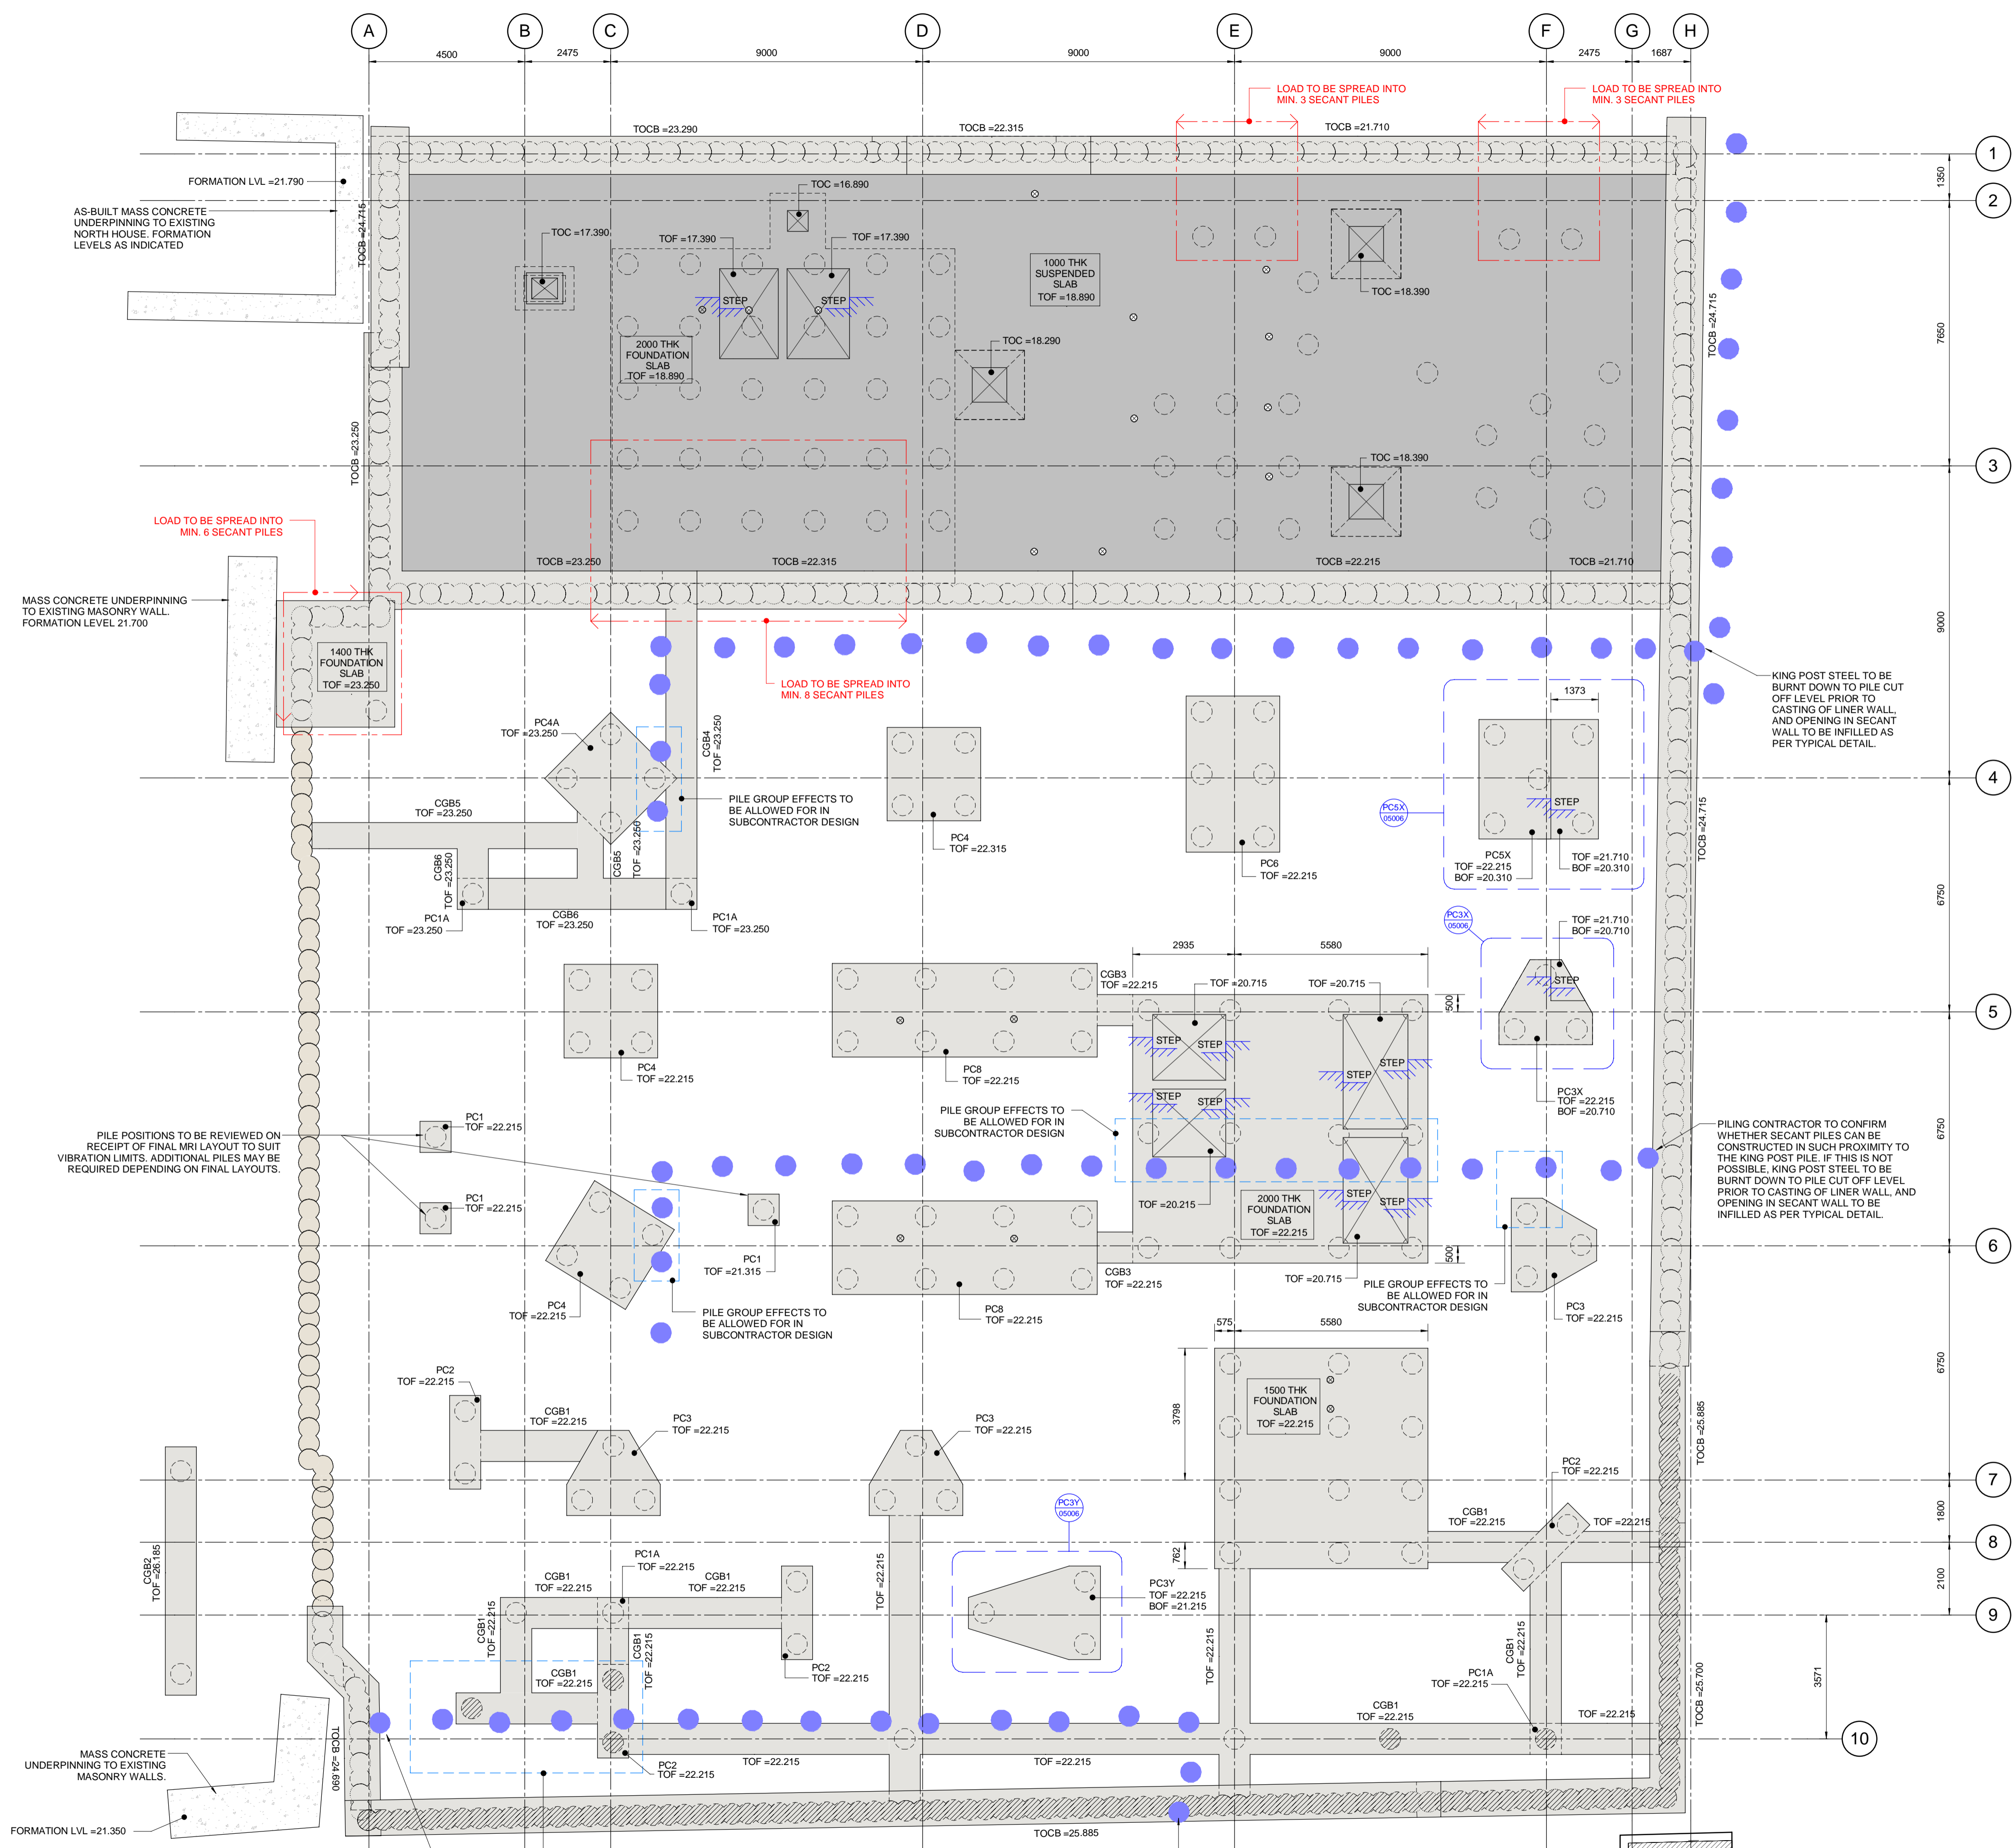

**Foundation Plan**  
 1 : 100

This drawing has been prepared for the use of AECOM's client. It may not be used, modified, reproduced or relied upon by third parties, except as agreed by AECOM or as required by law. AECOM accepts no responsibility, and denies any liability whatsoever, to any party that uses or relies on this drawing without AECOM's express written consent. Do not scale this document. All measurements must be obtained from the scaled dimensions.