

**GENERAL NOTES**

All work to be carried out in strict accordance with the current Building Regulations and its latest amendments, and to the complete satisfaction of the Local Authorities Building Control.

Contractors are responsible for complying with all relevant BS etc., and check that Building Control and Environmental Health Departments are satisfied with the scope and content of all work on completion and obtain any necessary certificates.

All existing construction levels and dimensions to be checked prior to construction, especially where new construction levels and dimensions are to match existing.


All site dimensions and site levels must be checked on site.

This drawing must not be used for construction unless issued for construction.

This drawing should be read in conjunction with all relevant Engineer's and specialist drawings.

**KEY**

- Site Boundary Line
- Proposed Application

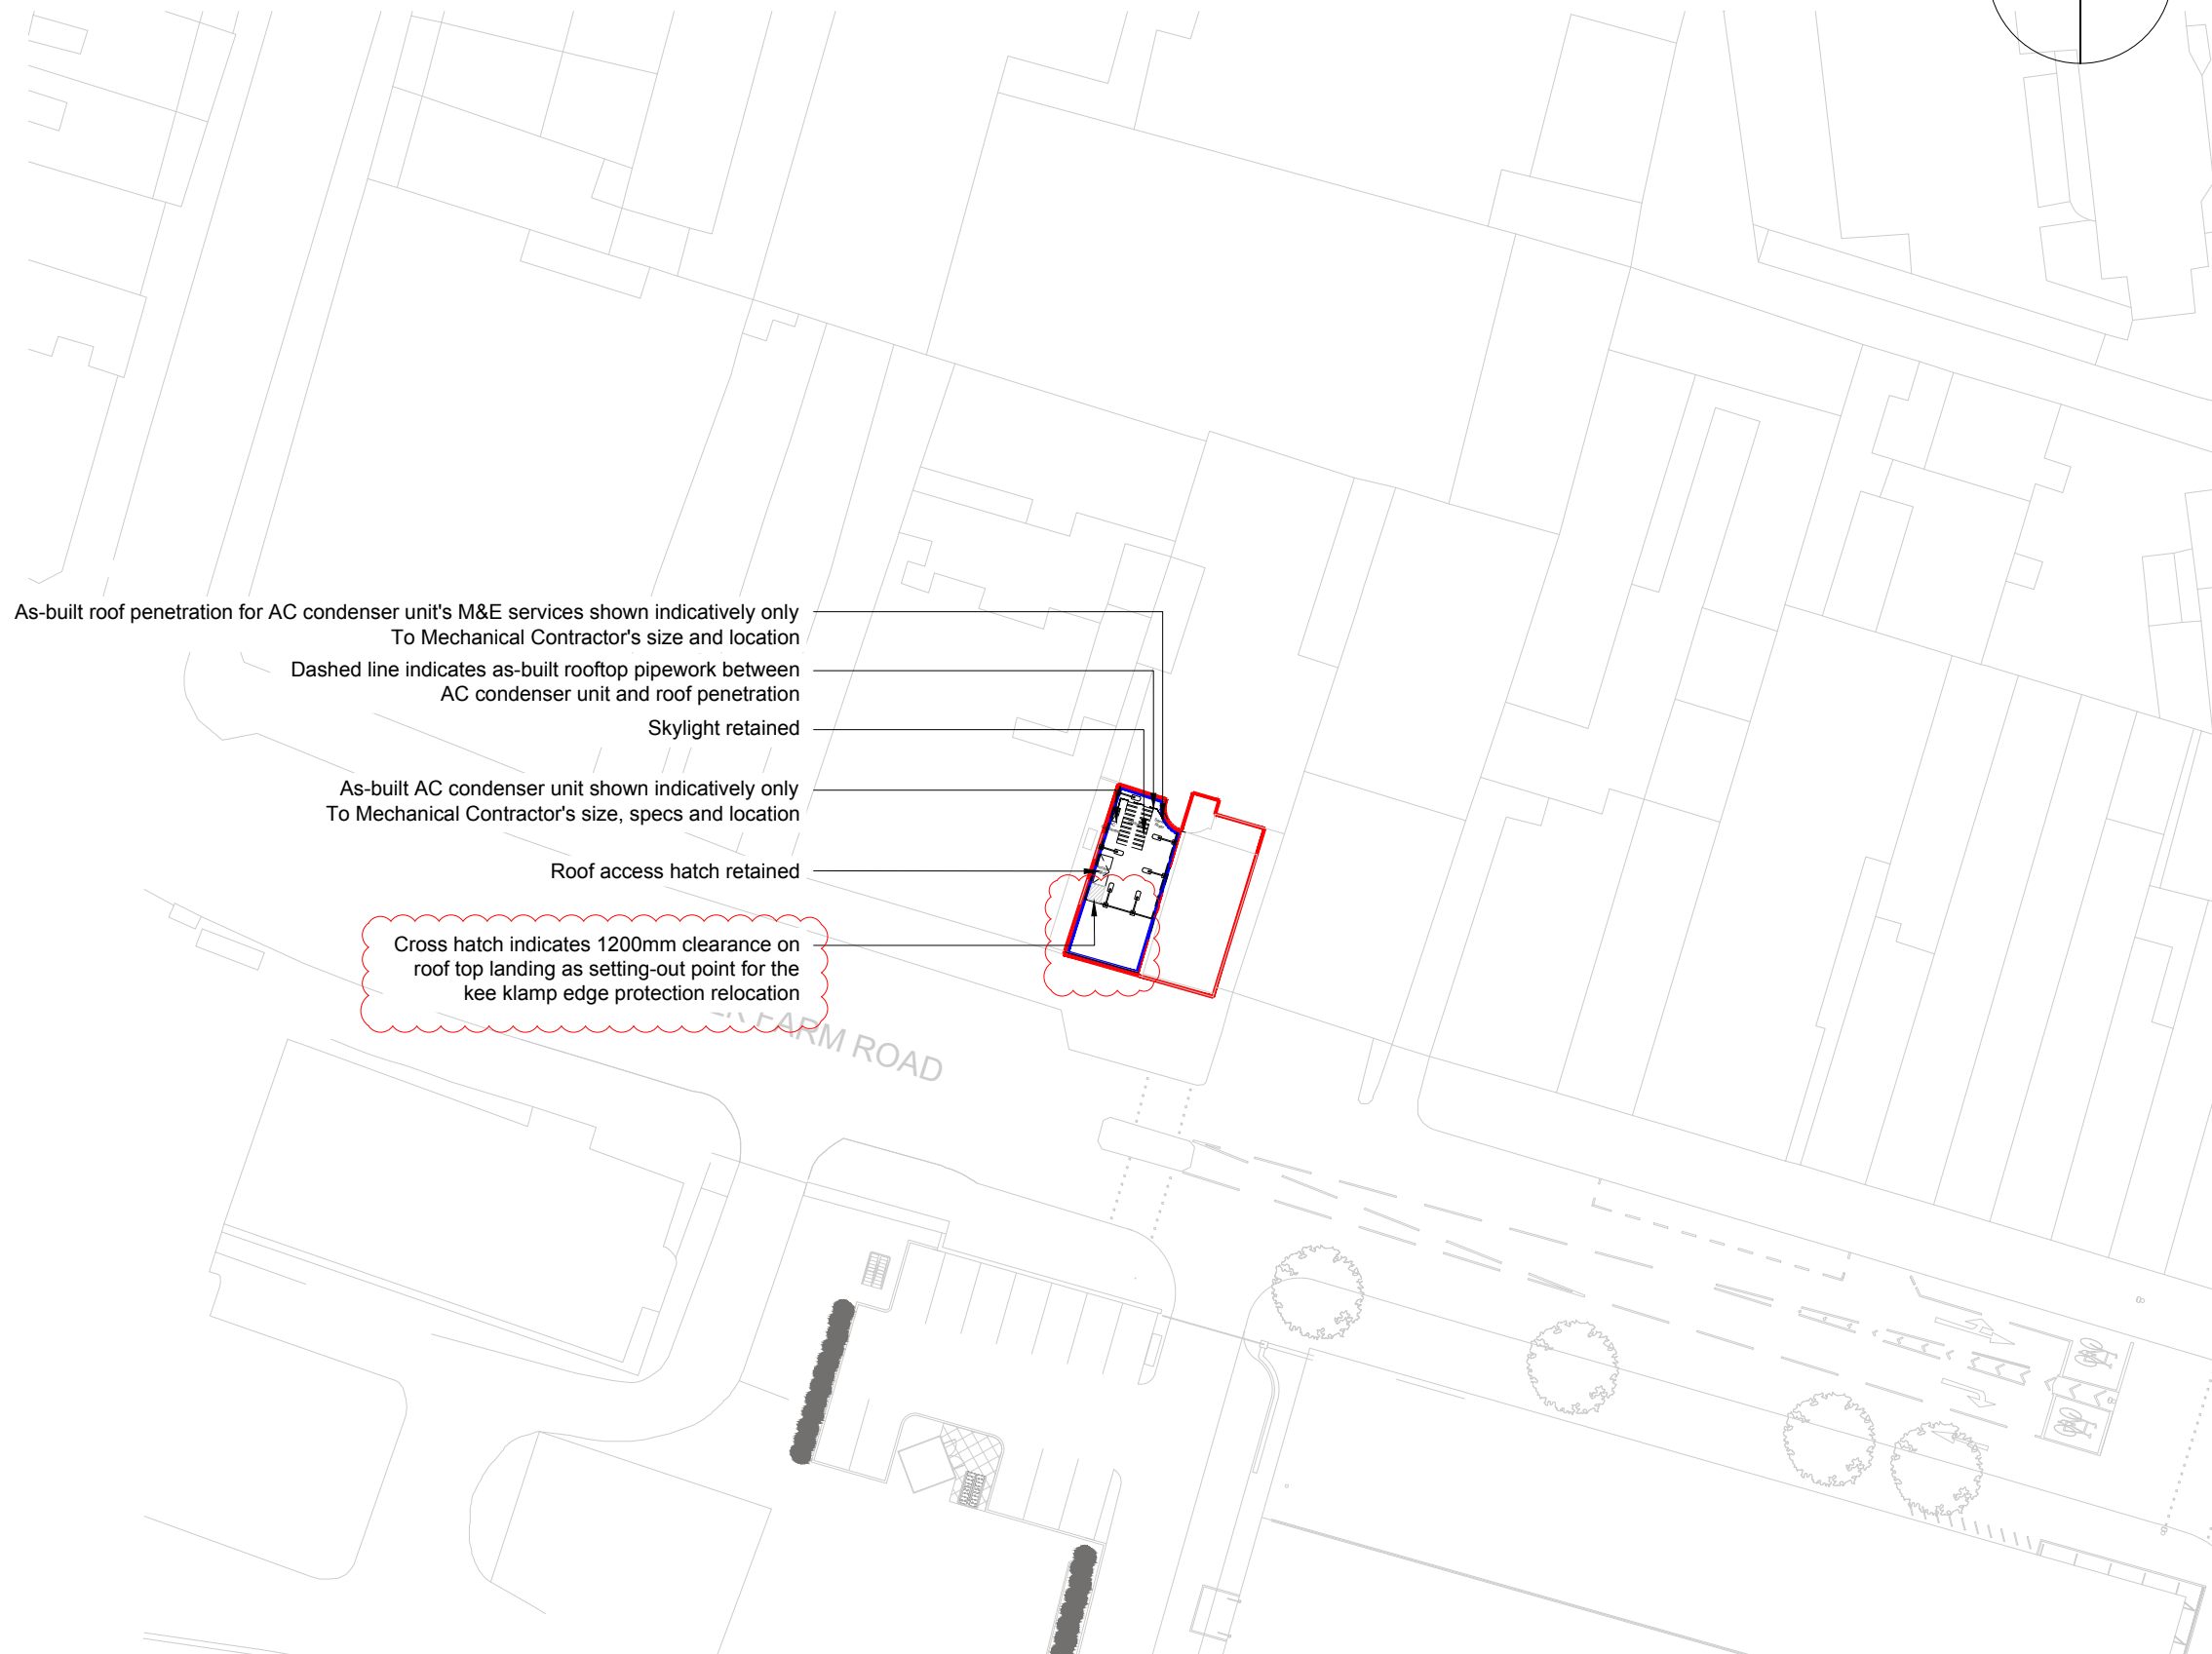

As-built roof penetration for AC condenser unit's M&E services shown indicatively only  
To Mechanical Contractor's size and location

Dashed line indicates as-built rooftop pipework between  
AC condenser unit and roof penetration

Skylight retained

As-built AC condenser unit shown indicatively only  
To Mechanical Contractor's size, specs and location

Roof access hatch retained

Cross hatch indicates 1200mm clearance on  
roof top landing as setting-out point for the  
kee klamp edge protection relocation

REV	DATE	DESCRIPTION	DR	CH
H	16.07.21	PLANNING ISSUE: issued to LPA for approval following feedback/ comments.	FH	VG
G	24.03.21	RECORD ISSUE: issued to ICON for Record.	FH	VG
F	01.02.21	CONSTRUCTION ISSUE: issued to ICON for Construction	FH	VG
E	06.01.21	Roof plant updated following comments by the landlord and coordination with the project team; site boundary updated following information provided by Landlord. Issued to WMS for landlord approval.	FH	VG
D	04.01.21	Issued to BMDC as part of Building Regulations application.	FH	VG
C	04.01.21	FULL PLANNING APPLICATION SUBMISSION TO LA - External Signage	FH	VG
B	14.12.20	FULL PLANNING APPLICATION SUBMISSION TO LA	FH	VG
A	11.12.20	Uploaded to ICON for information.	FH	VG

**PLANNING ISSUE**

**DB3 ARCHITECTURE AND DESIGN**

LONDON  
84 Great Suffolk Street, London, SE1 0BE.  
T: 0207 689 1434 www.darntonb3.com

---

CLIENT

**Morrisons**

---

PROJECT  
WMS 5K STORE  
#303 WMS CAMDEN (66 CHALK FARM ROAD)

DRAWING  
GENERAL ARRANGEMENT  
PROPOSED SITE PLAN

---

SCALE @ A3	DRAWN	CHECKED
1:500	FH	VG

---

CREATION DATE	REVISION
DECEMBER 2020	H

---

DARNTONB3 DRAWING NO.  
14648 - DB3 - 303 - 66 - DR - A - 90002

PROJECT NO - COMPANY - ZONE - LEVEL - TYPE - ROLE - NUMBER

© COPYRIGHT: ALL RIGHTS RESERVED.

THIS DRAWING MUST BE READ IN CONJUNCTION WITH ALL OTHER RELEVANT DRAWINGS AND INFORMATION.


DO NOT SCALE OFF DRAWINGS USE DISPLAYED DIMENSIONS ONLY.

THE DRAWING OR INFORMATION MUST NOT BE USED FOR CONSTRUCTION UNLESS EXPRESSLY ISSUED FOR CONSTRUCTION.

ANY DISCREPANCIES MUST BE REPORTED TO DARNTONB3 IMMEDIATELY.

DARNTONB3 LTD WORK TO A MANAGEMENT SYSTEM WHICH IS APPROVED TO ISO-9001 BY LQA - CERTIFICATE NUMBER LQA-0947162

**1 Proposed Site Plan**  
1:500 @ A3

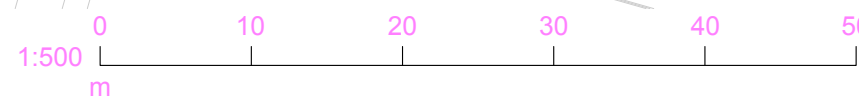

LONDON  
 LEEDS  
 CARDIFF  
 GLASGOW  
 ABERYSTWYTH  
 MANCHESTER  
 LOUGHBOROUGH