


Proposed Exterior Seating Plan

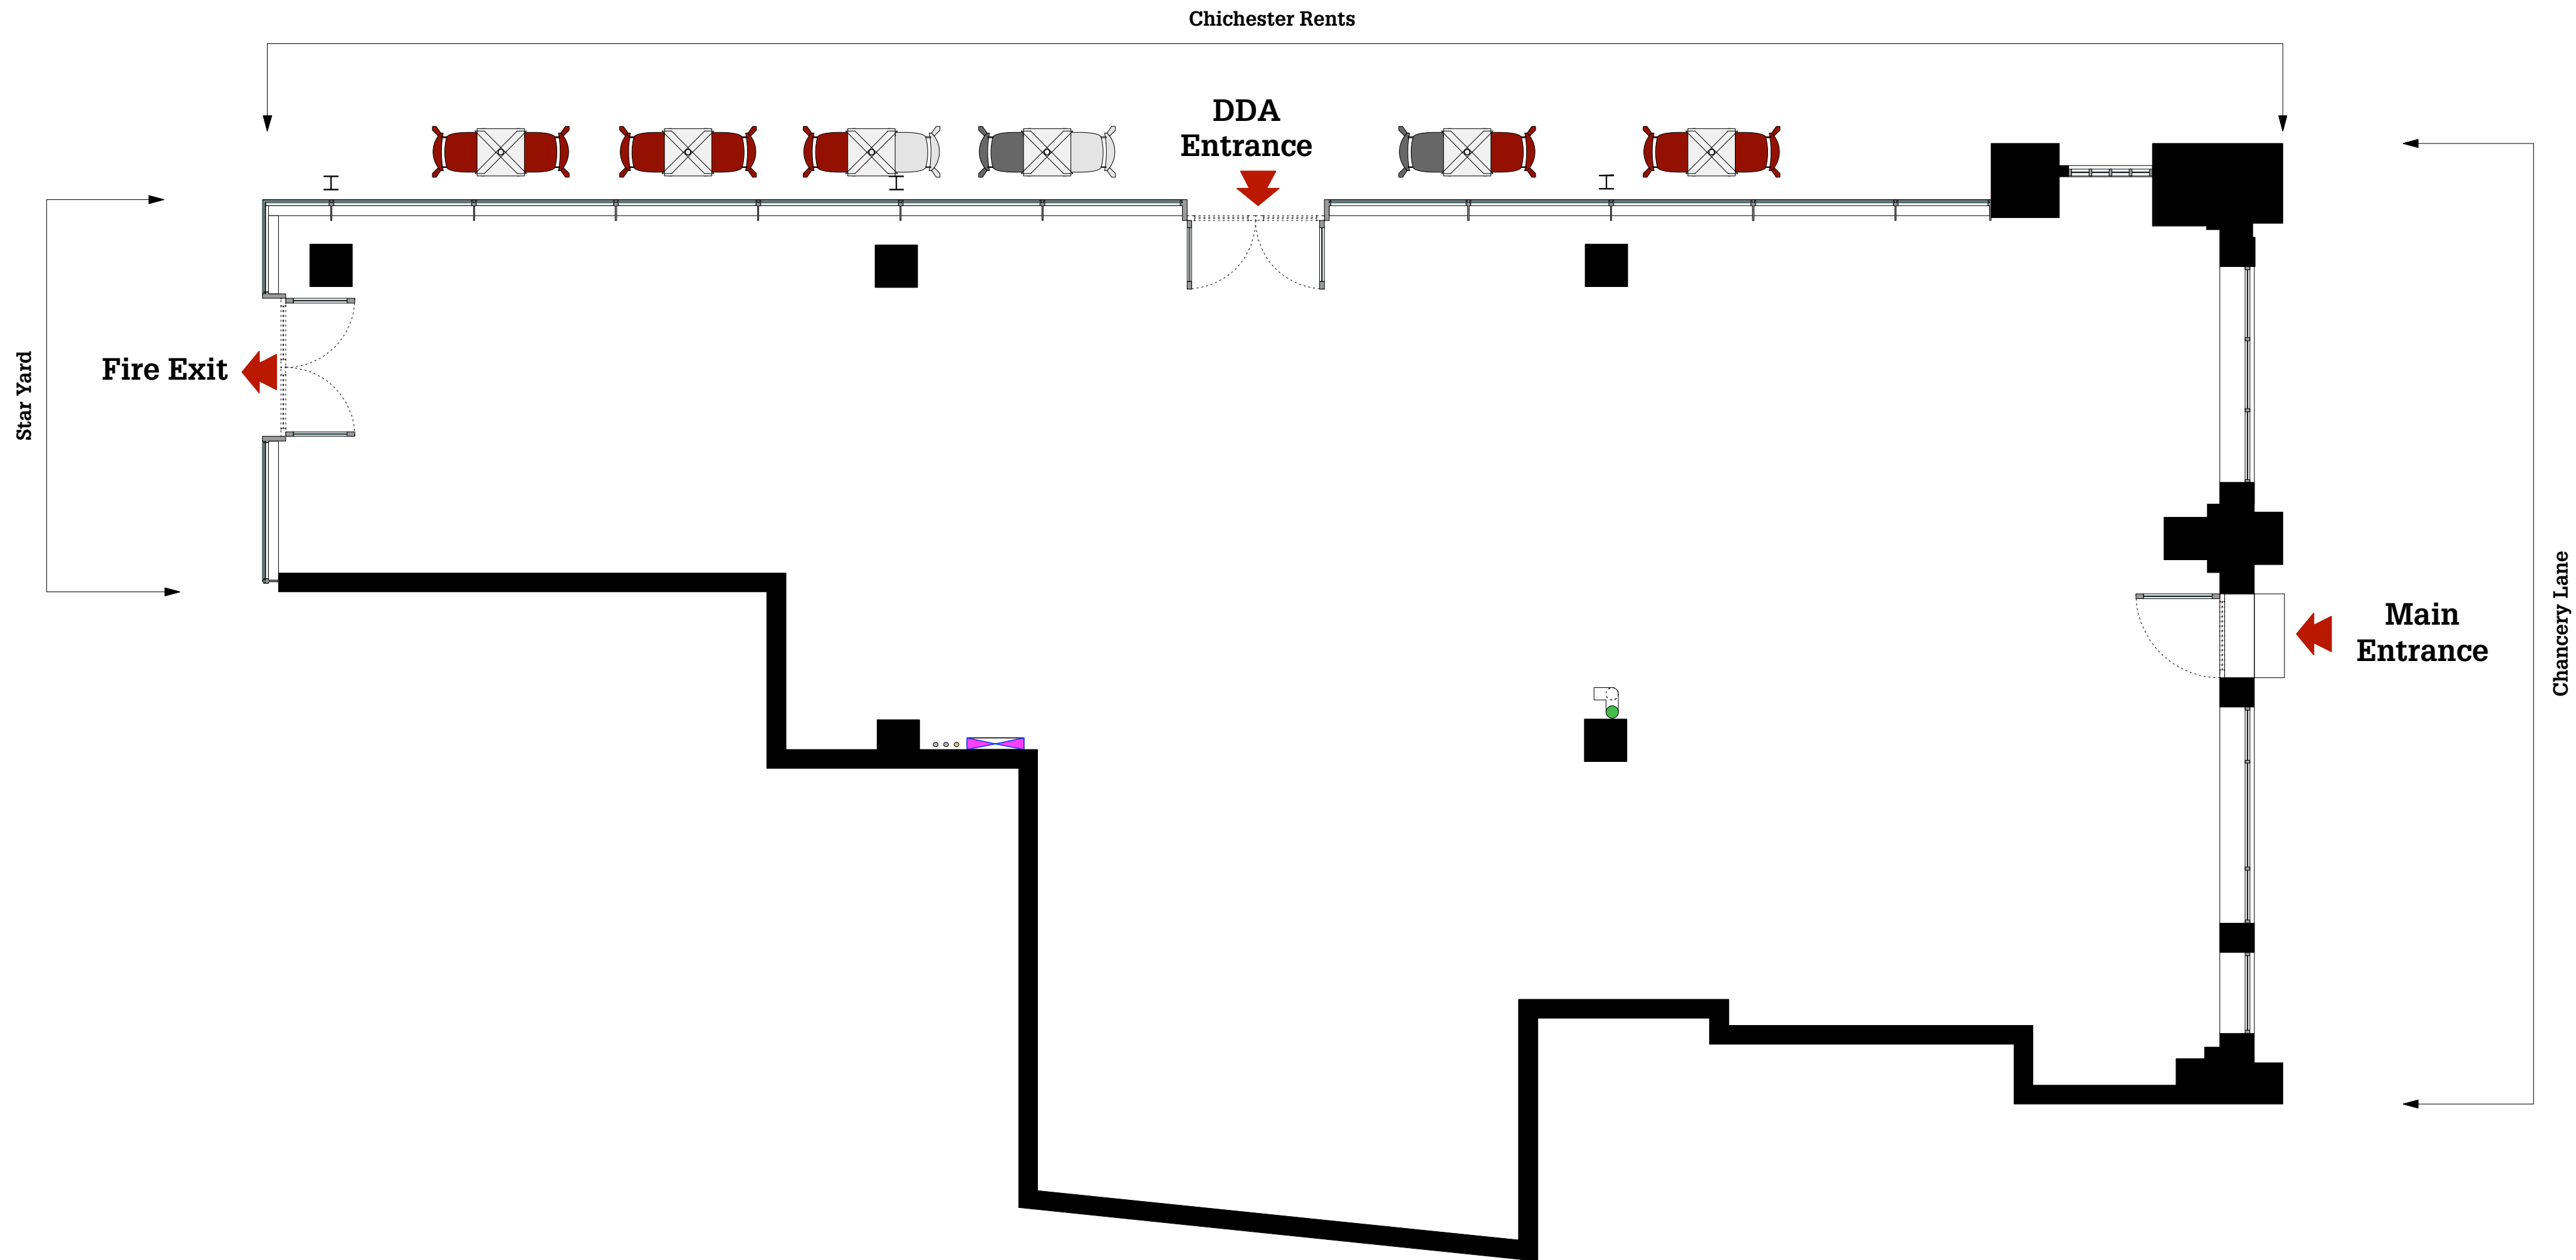

Proposed Exterior Seating Plan

Scale 1:50 @ A1

Furniture Legend	
	500 x 500mm Table- 6no.
	Red Exterior Chair- 8no. Rio Chair - Pret Red Ral 3004
	Dark Grey Exterior Chair- 2no. Rio Chair - Pret Black Grey Ral 7021
	Light Grey Exterior Chair- 2no. Rio Chair - Pret Light Grey Ral 7030
Total External Covers: 12	

★ PRET A MANGER ★

Important Note:
This drawing is copyright of Studio Fox Ltd and no portion should be used without consent. All dimensions and levels on this drawing are to be checked on site by the contractor and any discrepancies reported to Studio Fox Ltd, prior to commencement of any work. If in doubt ask!

Drawing Scales:
0 1000 2000 3000 4000
Scale 1:50 @ A1

Drawing Status:
AS BUILT

Revision:	Date:	By:	Description:
A	30.03.16	GMC	Legend revised
B	28.07.16	GMC	Plans revised to As Built

studio
fox

Client:
Pret a Manger

Project:
Retail Unit 6,
84 Chancery Lane, WC2A 1DD

Title:
Proposed Exterior Seating Plan

Drawn By:	Scale:	Drawn Date:	Revised Date:
GMC	1:50 (A1)	14.03.16	25.07.16

Drawing No:	Revision:
16-PRET-CL15	B

Studio Fox Ltd
58 Broad Street, Lyme Regis
Dorset, DT7 3QF
T: 01297 445 322
E: gary@studiofox.co.uk