


Residential Areas

- Private Residential
- Intermediate Housing
- Social Rented

Commercial & Communal Area

- Commercial Area
- Communal Areas
- Sub Station
- Site Boundary
- Red Line Boundary

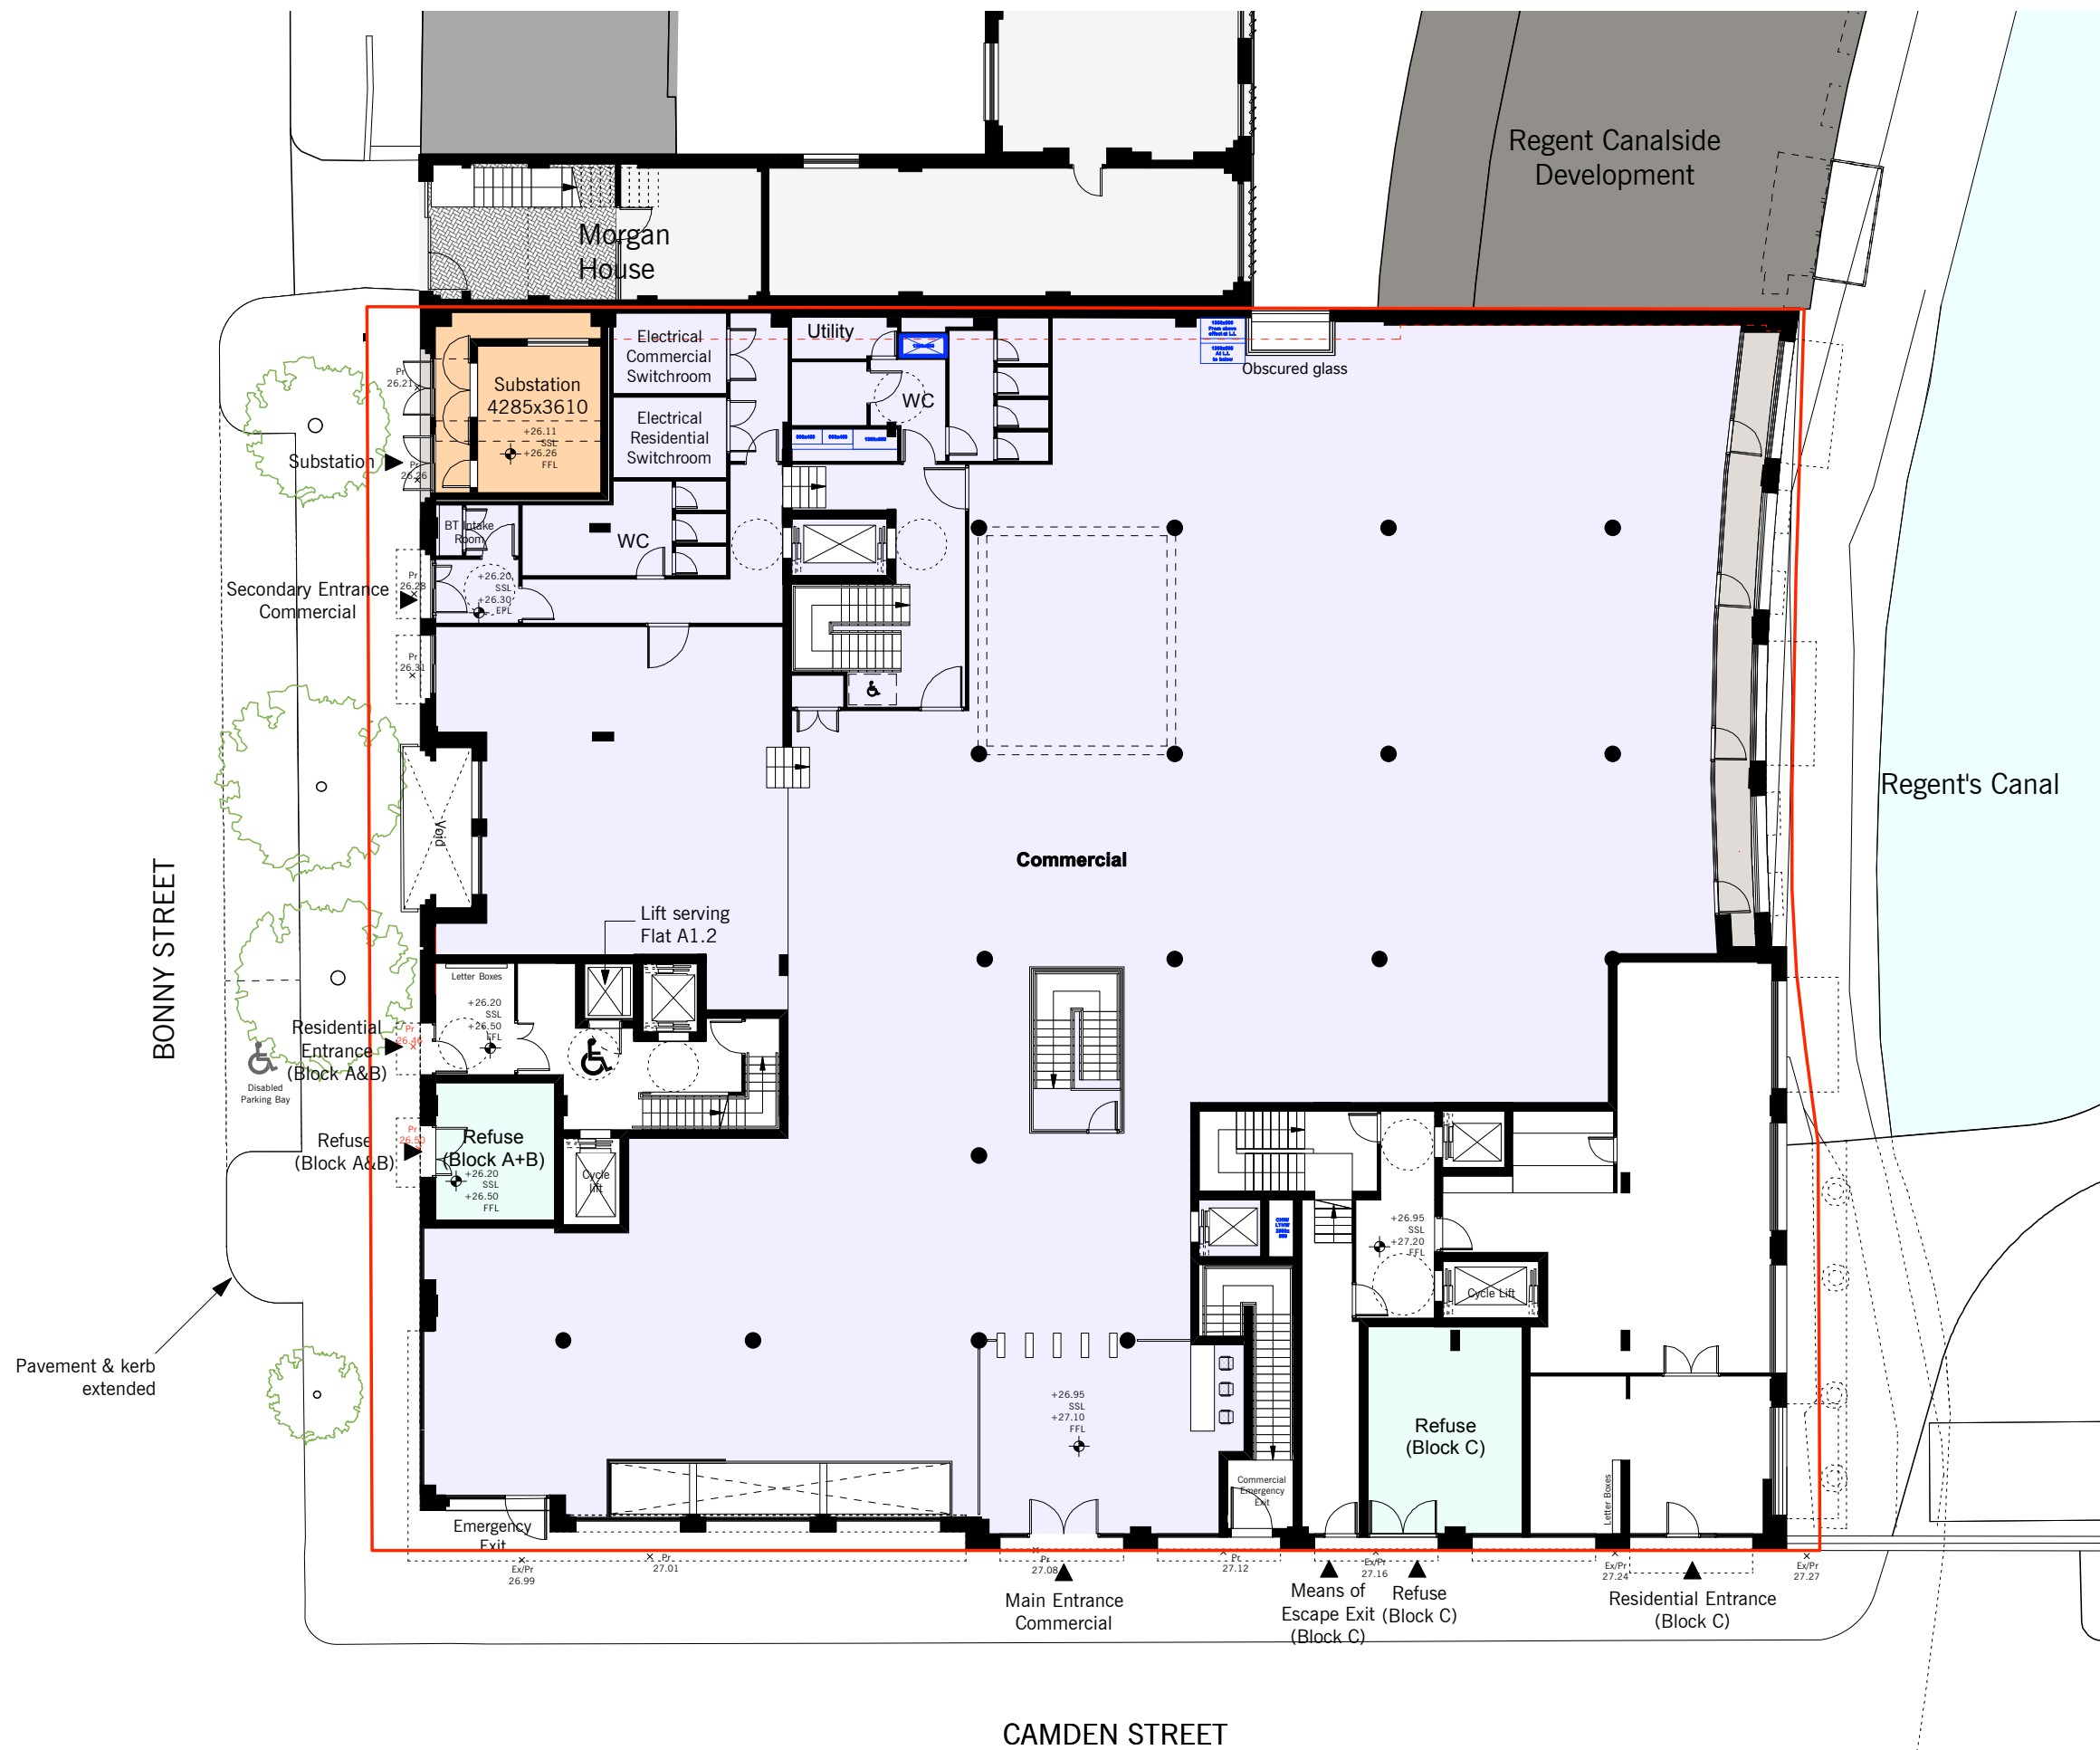

- Rev.L 01/08/2019:**
- 1.RESIDENTIAL:
R.1) Entrance/means of escape doors revised.
 - 2.COMMERCIAL:
C.1) Emergency exit doors and secondary entrance door revised.
- Rev.M 17/01/2020:**
- 1. Sub-station relocated.
- Rev.N 15/05/2020:**
- 1. Outline of projecting balconies to the floors above facing the canal amended.
 - 2. Canopy to sub-station and commercial secondary entrance amended.

PLANNING APPROVED DRAWING REF: 2020/3219/P