

Furniture Legend



Bench Seats:
Timber bench seats @ 1300x358mm (WxD) with black powder coated metal frame. 2no. in total



Tables:
550mm Ø tables with black metal pedestal and Terrazo top. 2no. in total



Chairs:
'Harbour' Chairs. Timber seat and back rest with black powder coated frames. 2no. in total



Planters:
Cedar planter box with castors and replica planting. 300mm deep and 1000mm high overall, width as noted on plan. 2no. planter boxes in total




A-Board:
700x660x1190mm (DxWxH). Black metal frame with replaceable graphic panel. Position as shown on plan. 1no. in total

NOTE: All external furniture is free standing and stored within shop during non trading hours

TOTAL COVERS: 4no.

SCALE - 1:50 @ A3

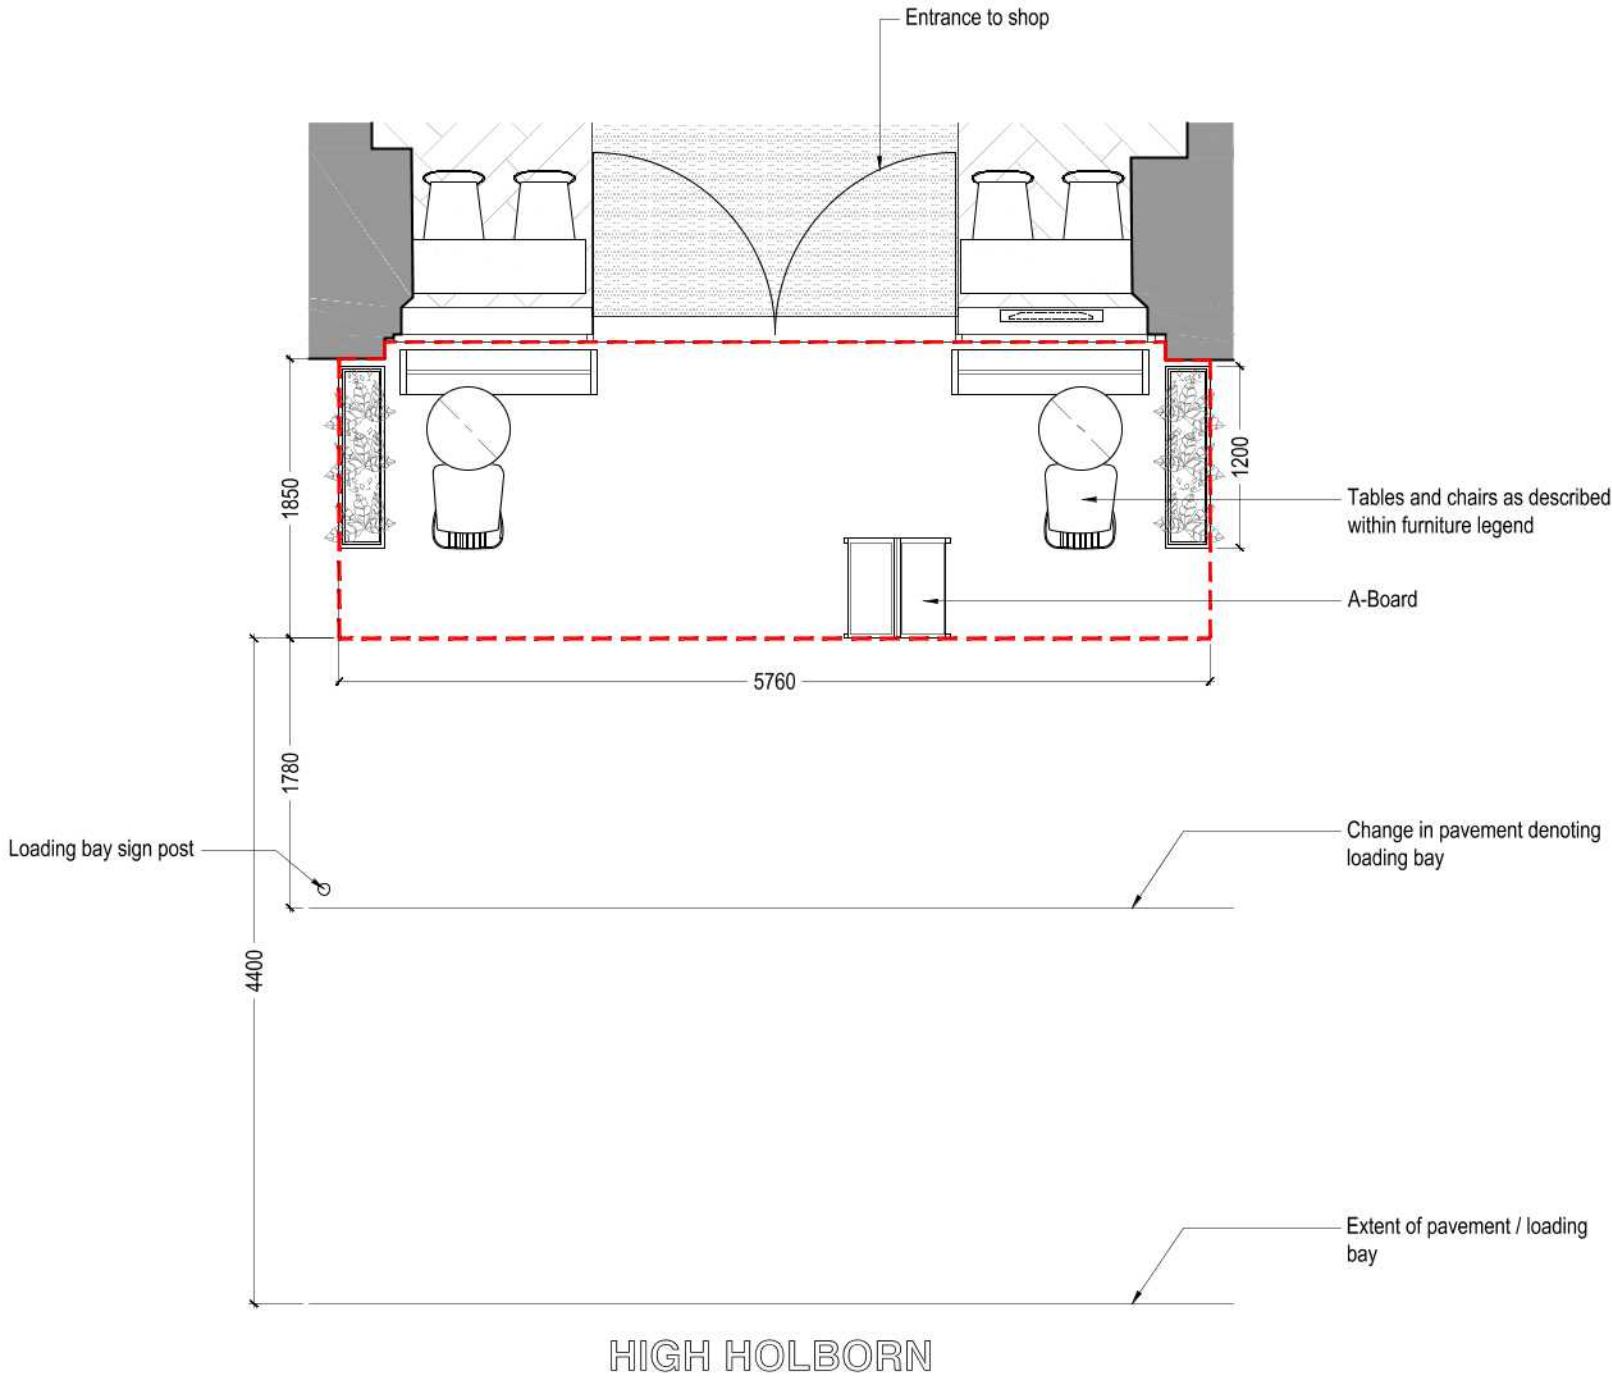

Proposed External Seating

DO NOT SCALE FROM THIS DRAWING. THE AUTHOR OF THIS DRAWING TAKES NO RESPONSIBILITY FOR ANY DIMENSIONS OBTAINED BY MEASURING OR SCALING FROM THIS DRAWING AND NO RELIANCE MAY BE PLACED ON SUCH DIMENSIONS. ALL DIMENSIONS MUST BE CHECKED AND VERIFIED ON SITE BY THE CONTRACTOR BEFORE COMMENCING ANY WORK OR PRODUCING DRAWINGS. RML ARCHITECTURE MUST BE NOTIFIED IMMEDIATELY OF ANY ERRORS OR DISCREPANCIES PRIOR TO THE COMMENCEMENT OF WORK.

THIS DRAWING AND ALL INFORMATION CONTAINED WITHIN IS THE SOLE PROPERTY OF RML ARCHITECTURE LTD AND MAY NOT BE REPRODUCED IN WHOLE OR PART WITHOUT WRITTEN PERMISSION FROM RML ARCHITECTURE LTD.

REV	DESCRIPTION	DATE	BY
A	Revised to 'As Built' status.	30-01-20	RML
B	Revised to suit social distancing rules, A-Board added.	17-05-21	RML



CLIENT

COCO
DI MAMA

PROJECT
COCO HOLBORN
124 HIGH HOLBORN
HOLBORN, LONDON
WC1V 6AN

DRAWING TITLE
PROPOSED EXTERNAL SEATING

PROJECT No. 5560 DRAWN BY RML

SCALE 1:50 @ A3 DATE NOV '19

DRAWING NO. 5560-P-07 REVISION B

DRAWING STATUS
APPROVAL

RMLArchitecture

12 Albion Street Brighton BN2 9NE
07973 151 494