


Pre-Existing

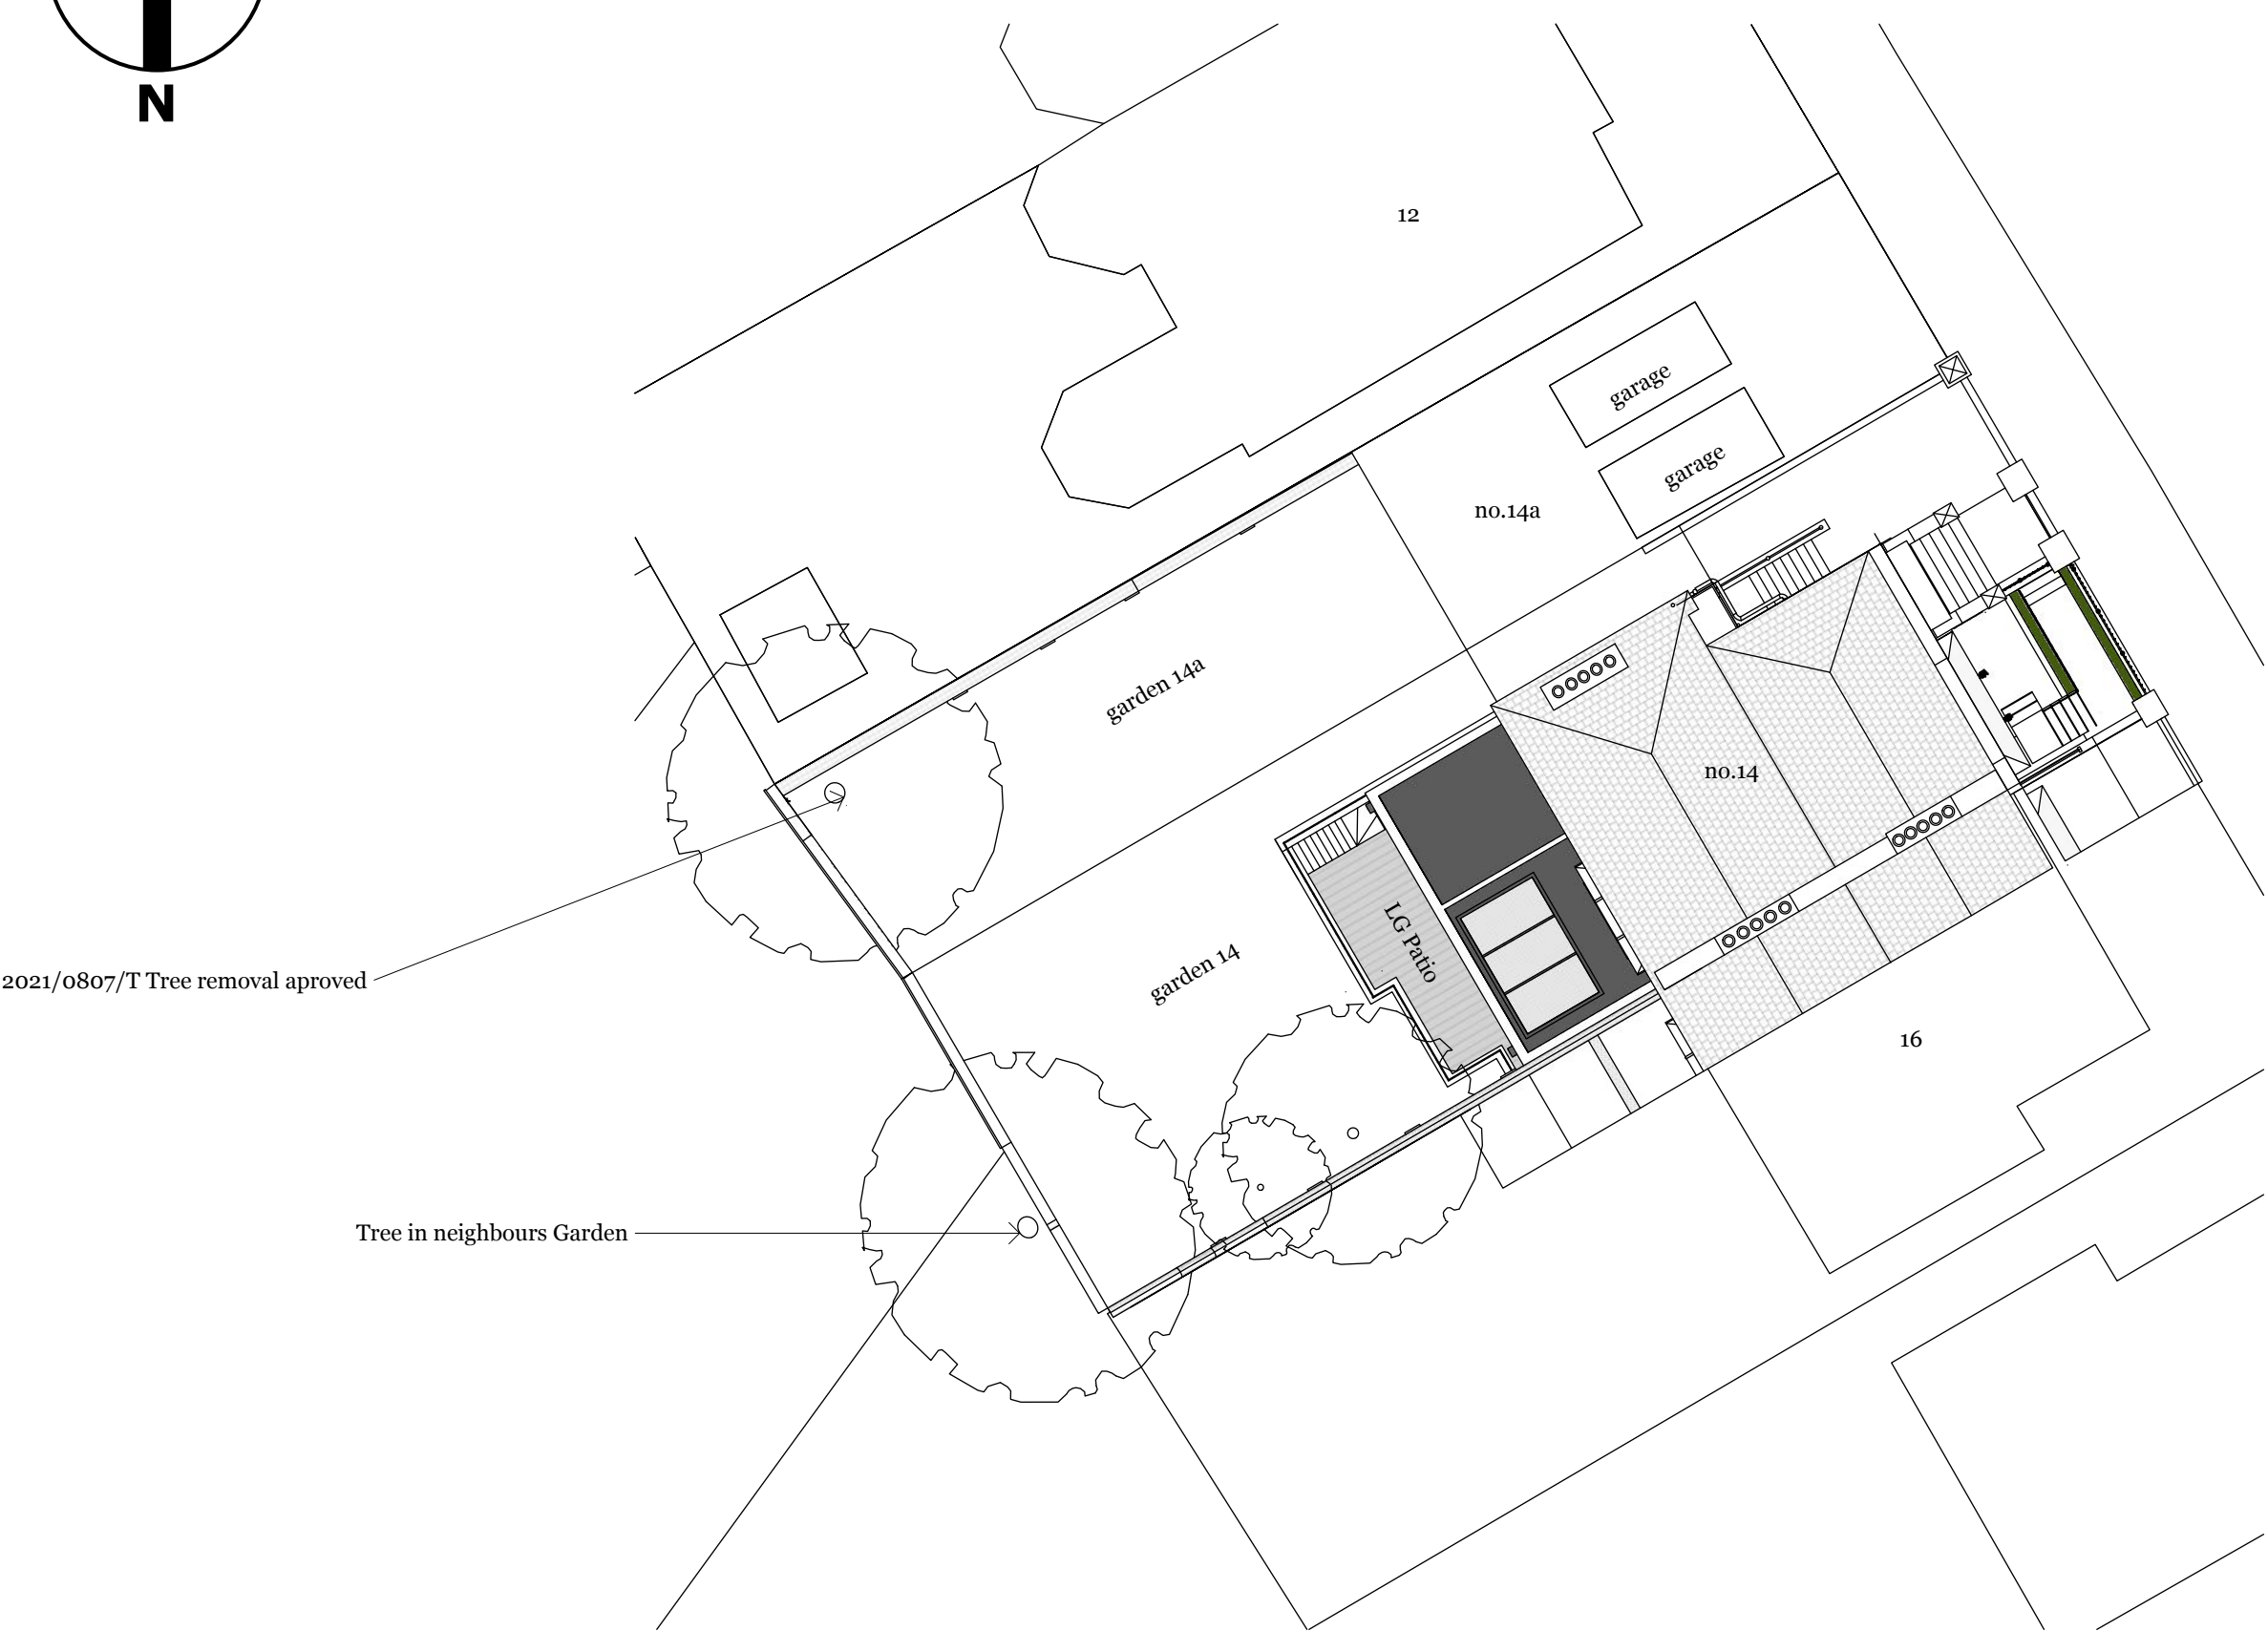

SITE ADDRESS
14 & 14A HAMPSTEAD HILL
GARDENS
HAMPSTEAD
LONDON
NW3 2PL


CLIENT
LONDON RESIDENTIAL HOUSING LTD
14 HAMPSTEAD HILL GARDENS
HAMPSTEAD
LONDON
NW3 2PL

PROJECT
LANDSCAPING HHG

ISSUE
09/11/2020






RE-ISSUE
17/07/2021

DESCRIPTION
Pre Existing Area Plan

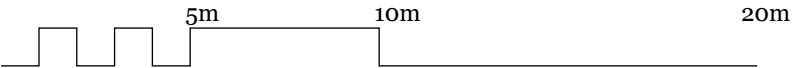

Scale 1 : 200 on A3

Pre-Existing

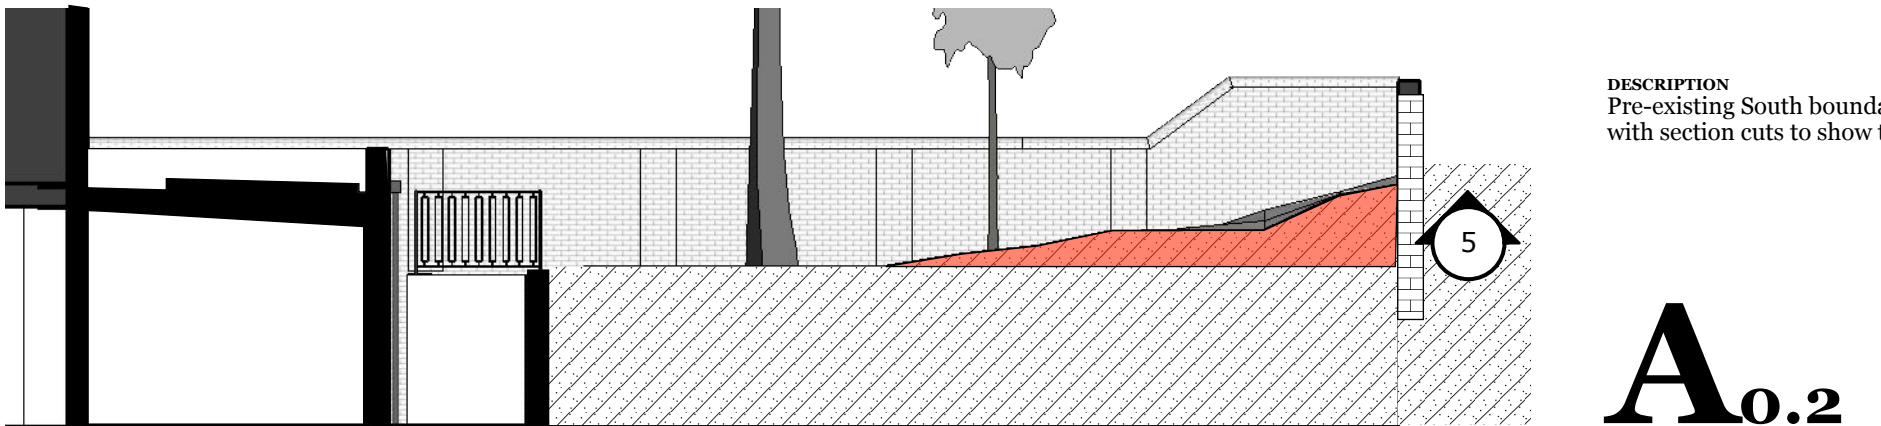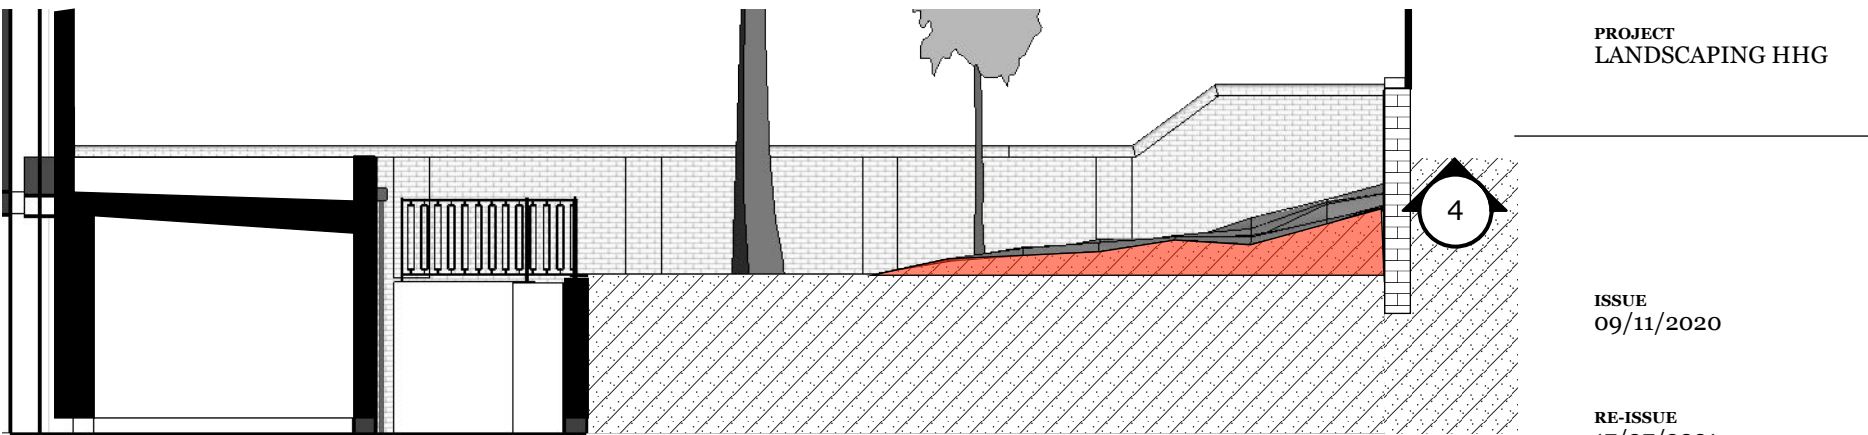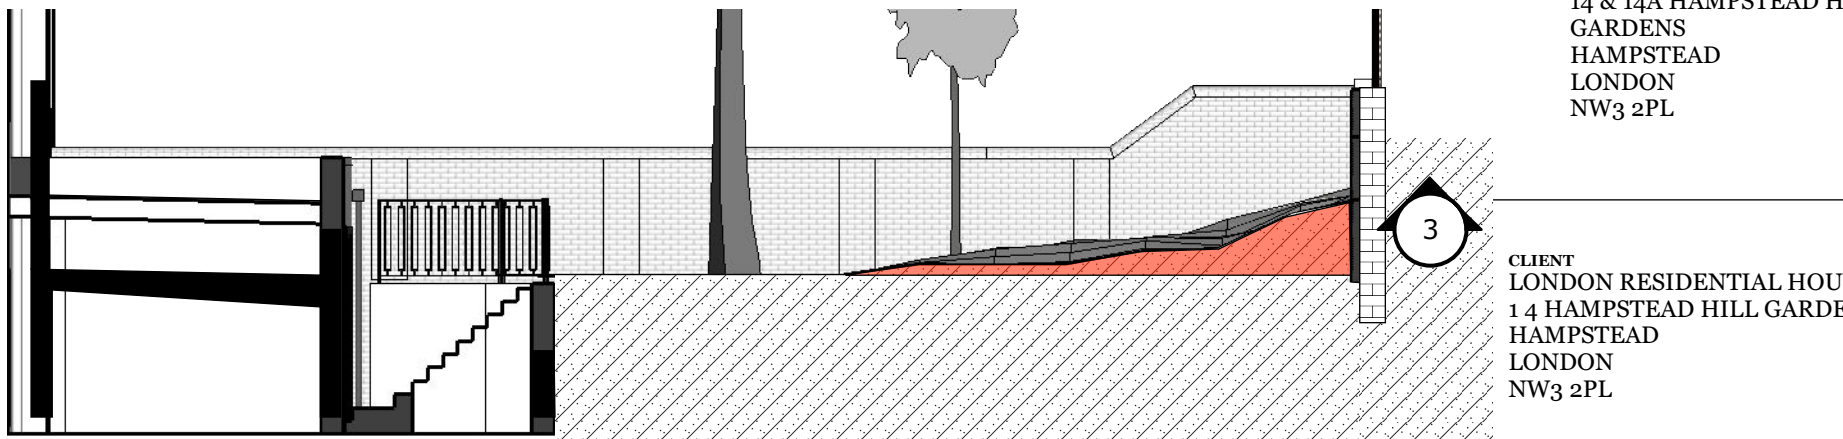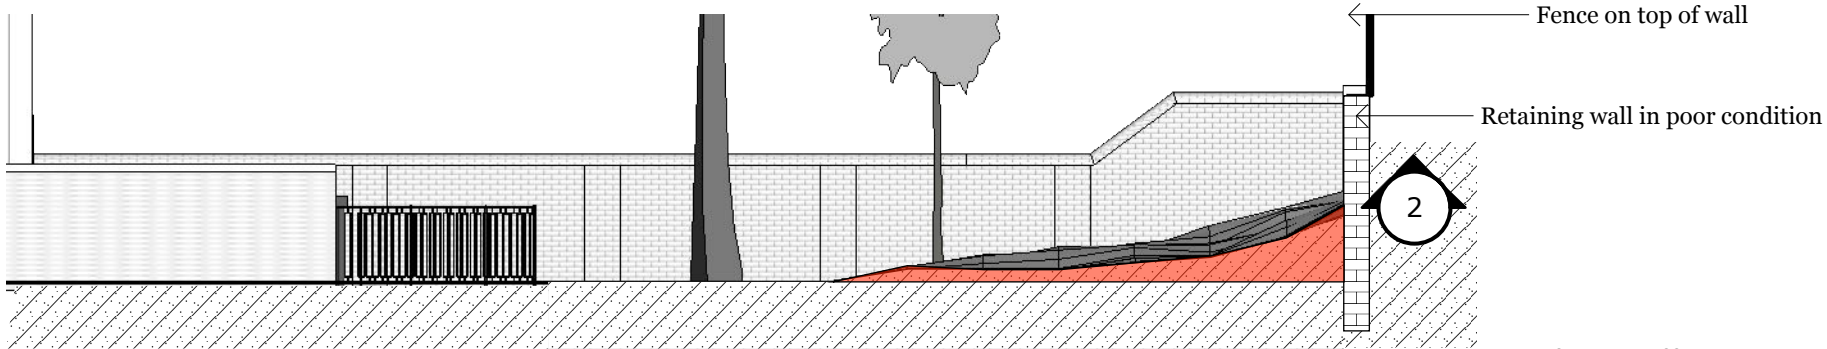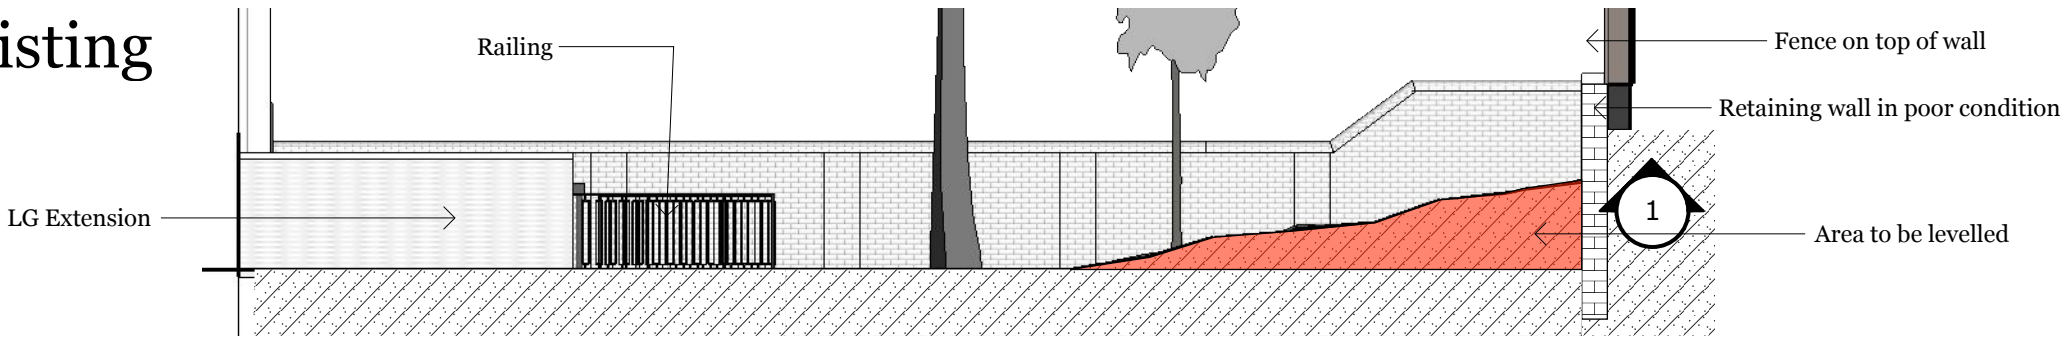

SITE ADDRESS
14 & 14A HAMPSTEAD HILL
GARDENS
HAMPSTEAD
LONDON
NW3 2PL



CLIENT
LONDON RESIDENTIAL HOUSING LTD
14 HAMPSTEAD HILL GARDENS
HAMPSTEAD
LONDON
NW3 2PL

PROJECT
LANDSCAPING HHG

ISSUE
09/11/2020


RE-ISSUE
17/07/2021

DESCRIPTION
Pre-existing South boundary wall
with section cuts to show topography

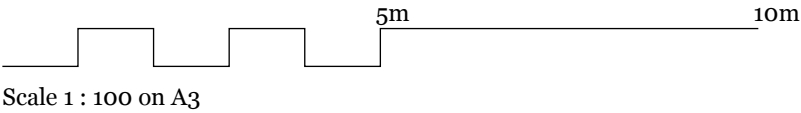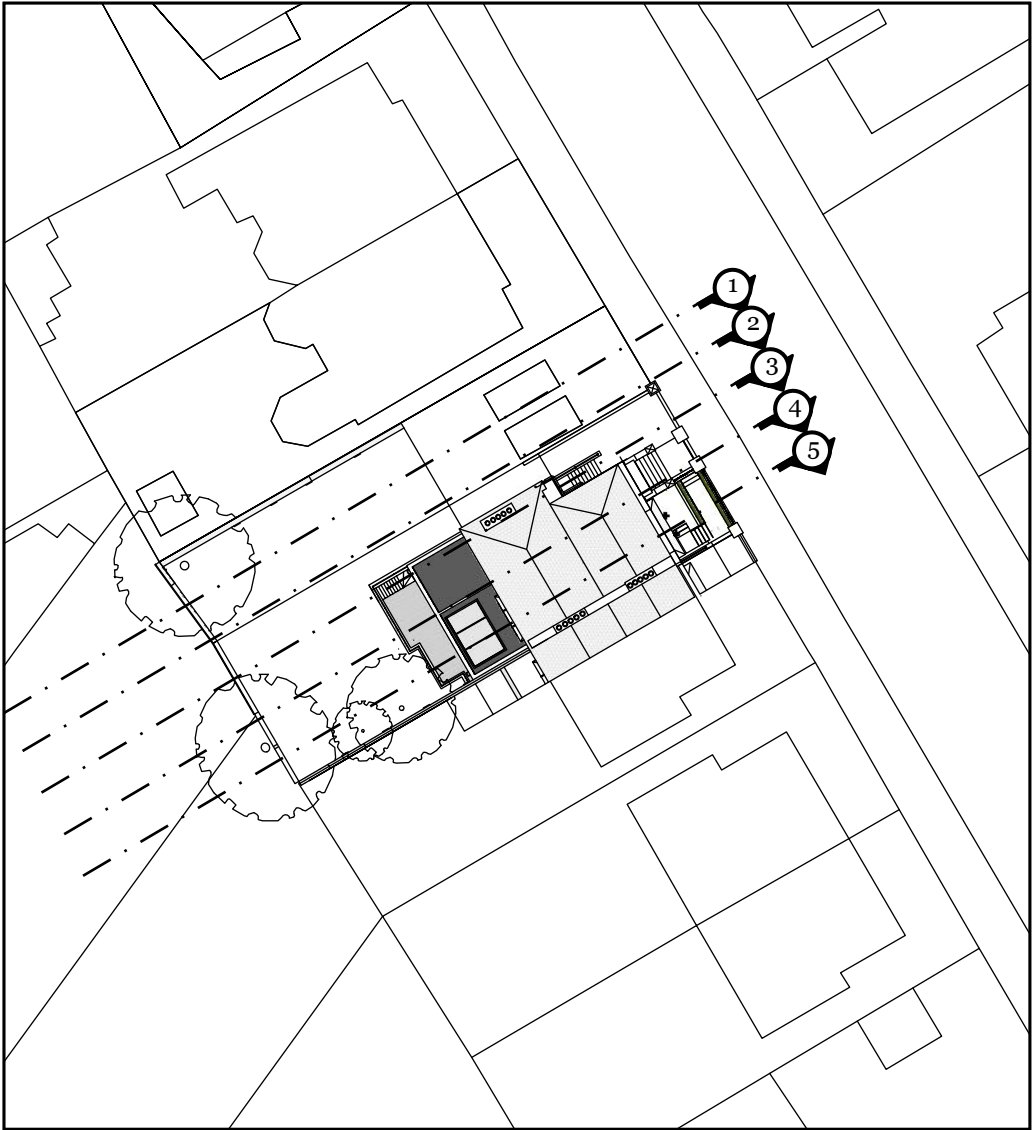

A_{0.2}

Pre-Existing

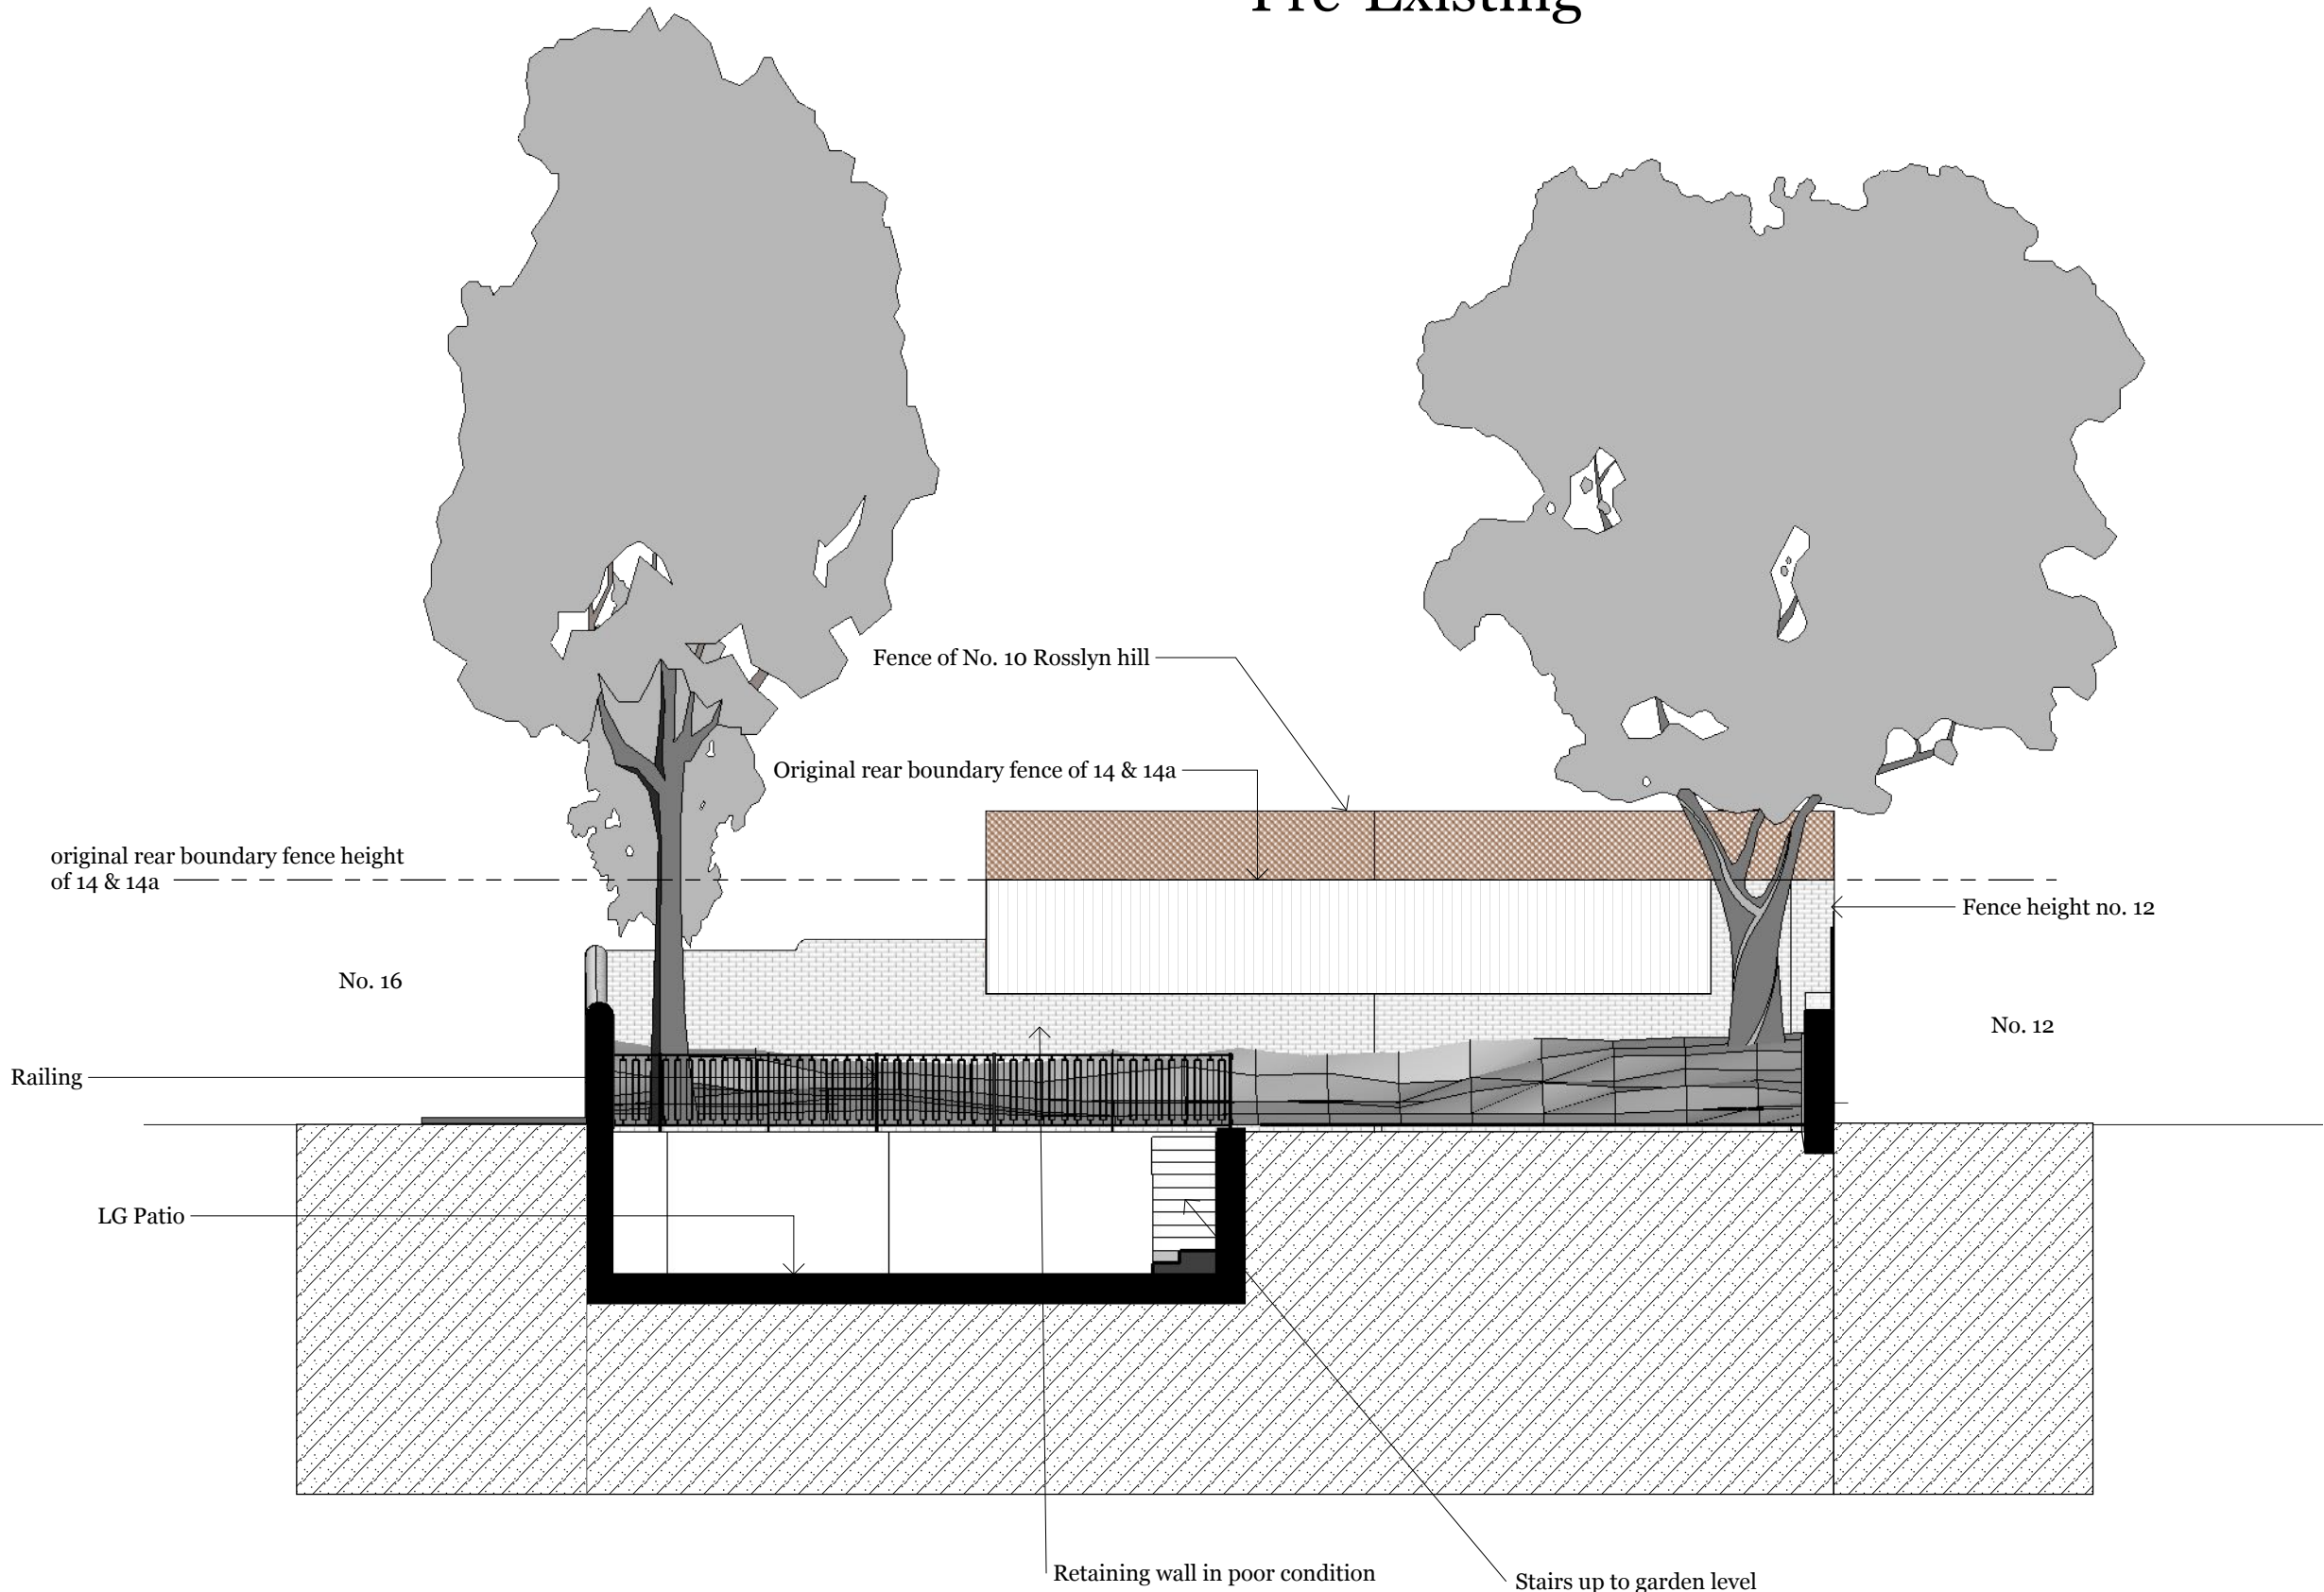

SITE ADDRESS
14 & 14A HAMPSTEAD HILL
GARDENS
HAMPSTEAD
LONDON
NW3 2PL


CLIENT
LONDON RESIDENTIAL HOUSING LTD
14 HAMPSTEAD HILL GARDENS
HAMPSTEAD
LONDON
NW3 2PL

PROJECT
LANDSCAPING HHG

ISSUE
09/11/2020

RE-ISSUE
17/07/2021

DESCRIPTION
Pre-existing West boundary

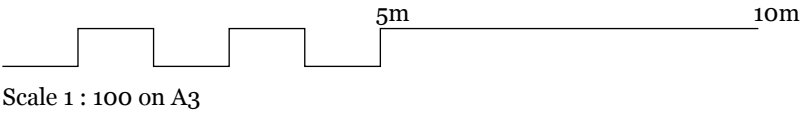

Pre-Existing



SITE ADDRESS
14 & 14A HAMPSTEAD HILL
GARDENS
HAMPSTEAD
LONDON
NW3 2PL

CLIENT
LONDON RESIDENTIAL HOUSING LTD
14 HAMPSTEAD HILL GARDENS
HAMPSTEAD
LONDON
NW3 2PL

PROJECT
LANDSCAPING HHG


ISSUE
09/11/2020

RE-ISSUE
17/07/2021

DESCRIPTION
Pre-existing East boundary

5m 10m
Scale 1 : 100 on A3

Pre-Existing

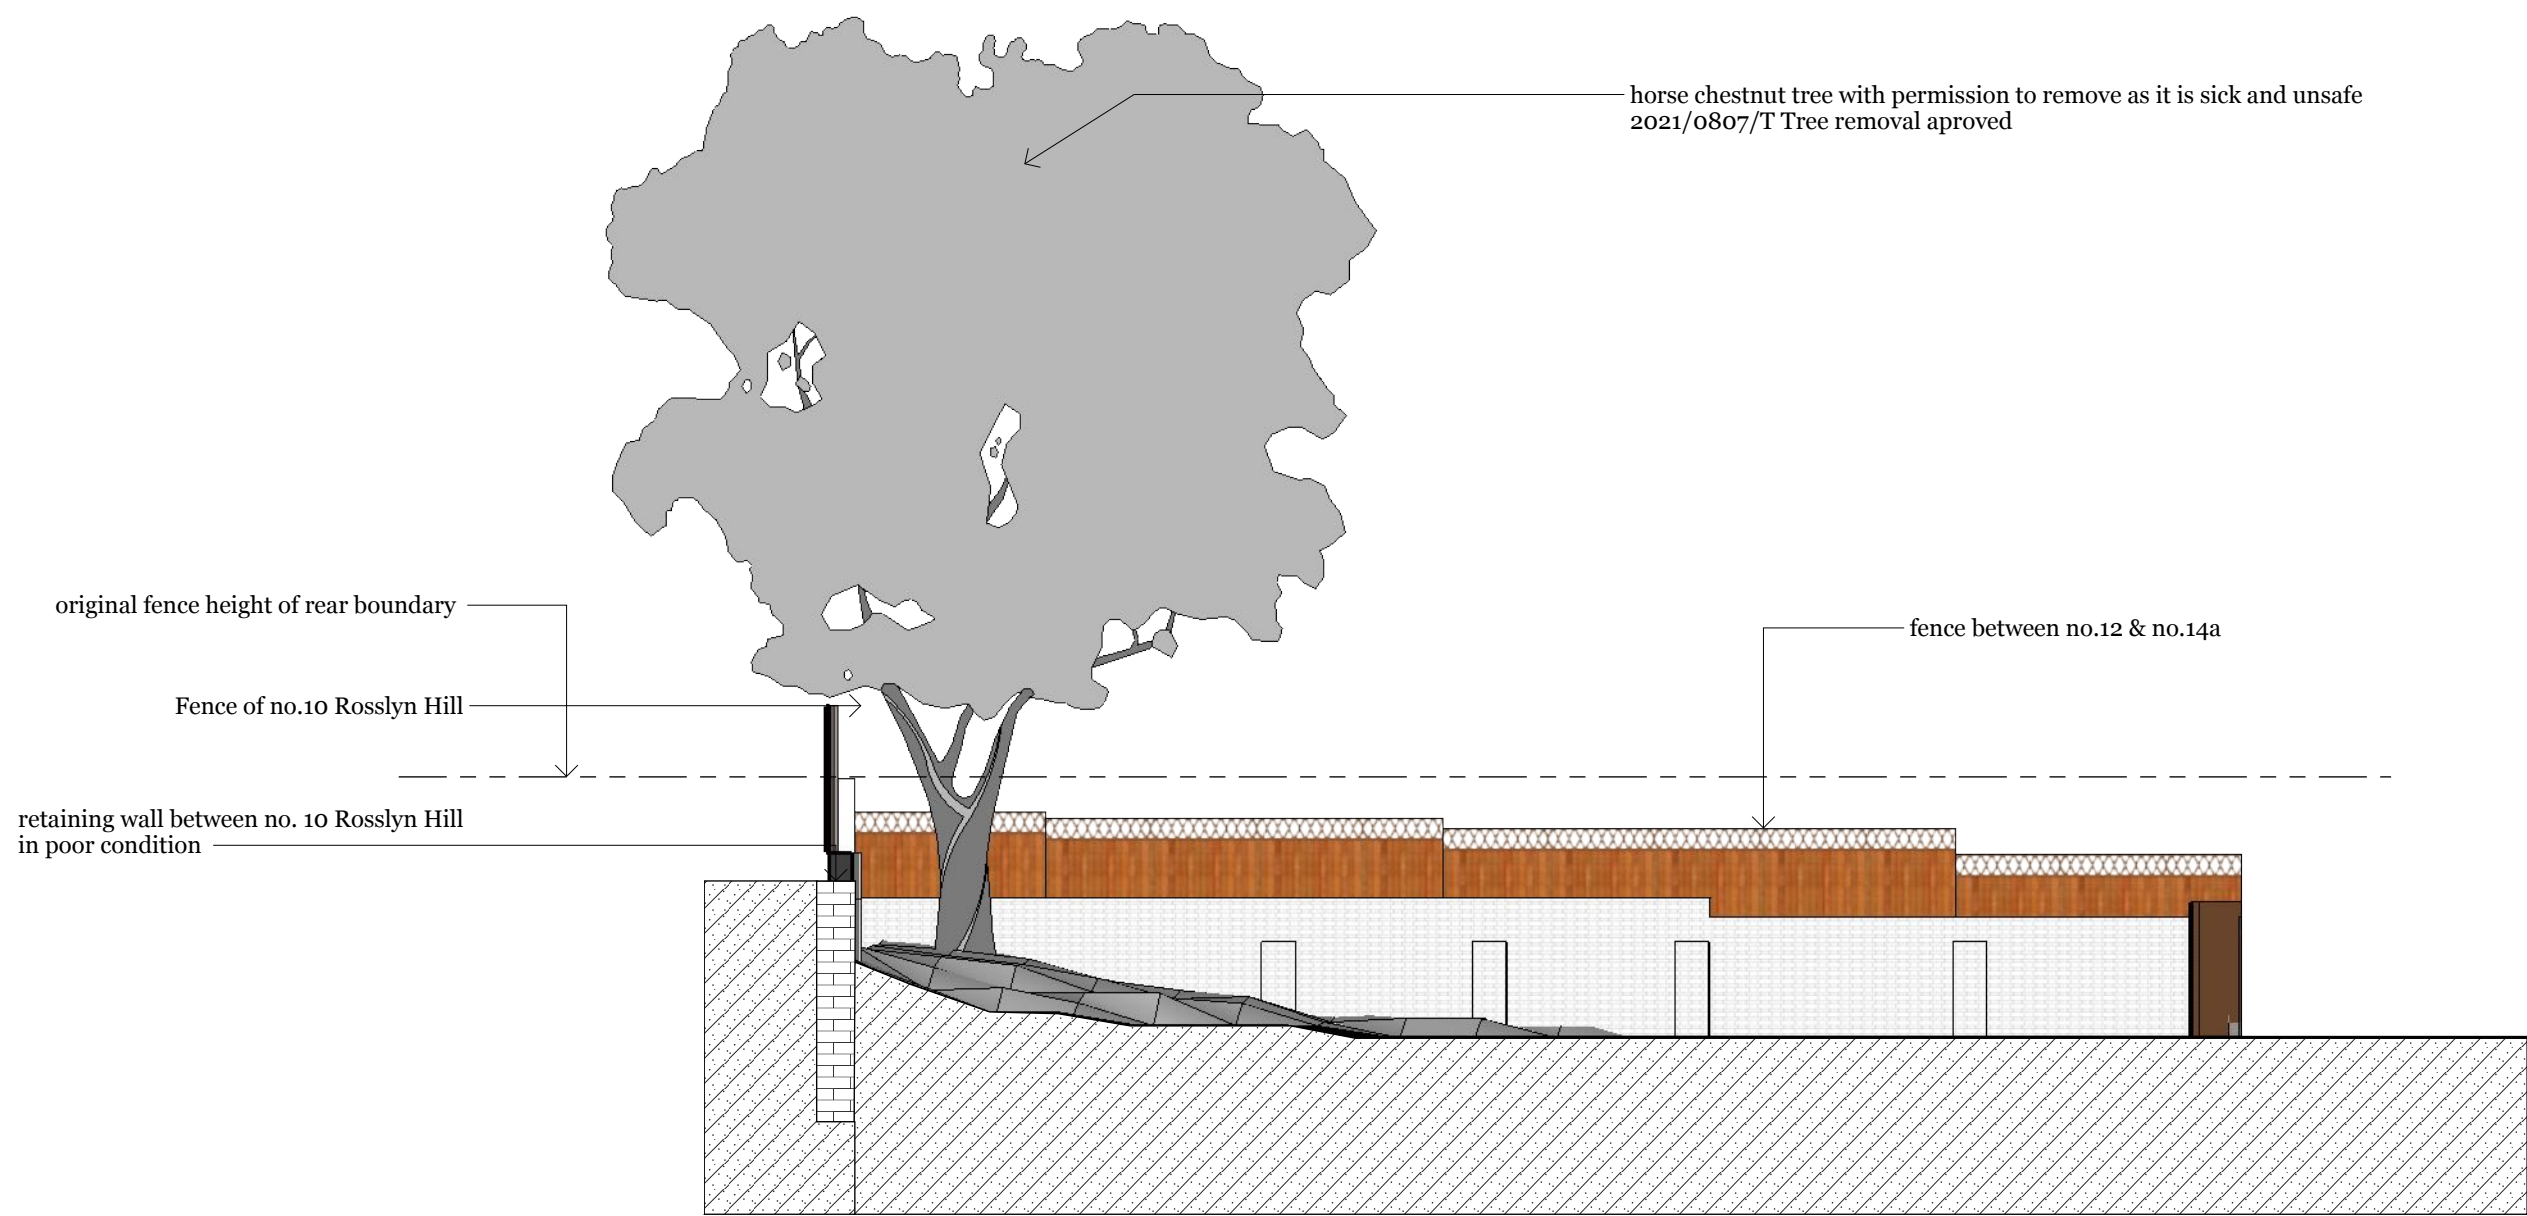

SITE ADDRESS
14 & 14A HAMPSTEAD HILL
GARDENS
HAMPSTEAD
LONDON
NW3 2PL


CLIENT
LONDON RESIDENTIAL HOUSING LTD
14 HAMPSTEAD HILL GARDENS
HAMPSTEAD
LONDON
NW3 2PL

PROJECT
LANDSCAPING HHG


ISSUE
09/11/2020

RE-ISSUE
17/07/2021

DESCRIPTION
Pre-existing North boundary

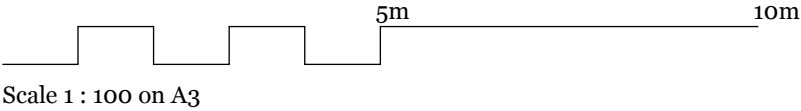

A_{0.5}

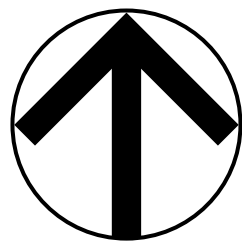

N

flower planting beds with diverse species planted

As Built



SITE ADDRESS
14 & 14A HAMPSTEAD HILL
GARDENS
HAMPSTEAD
LONDON
NW3 2PL

CLIENT
LONDON RESIDENTIAL HOUSING LTD
14 HAMPSTEAD HILL GARDENS
HAMPSTEAD
LONDON
NW3 2PL


PROJECT
LANDSCAPING HHG

ISSUE
09/11/2020

RE-ISSUE
17/07/2021

DESCRIPTION
As Built Area Plan


no. 10

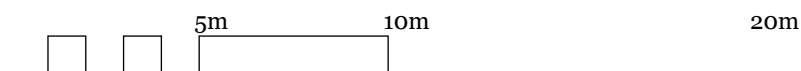

Scale 1 : 200 on A3

A_{0.6}

As Built

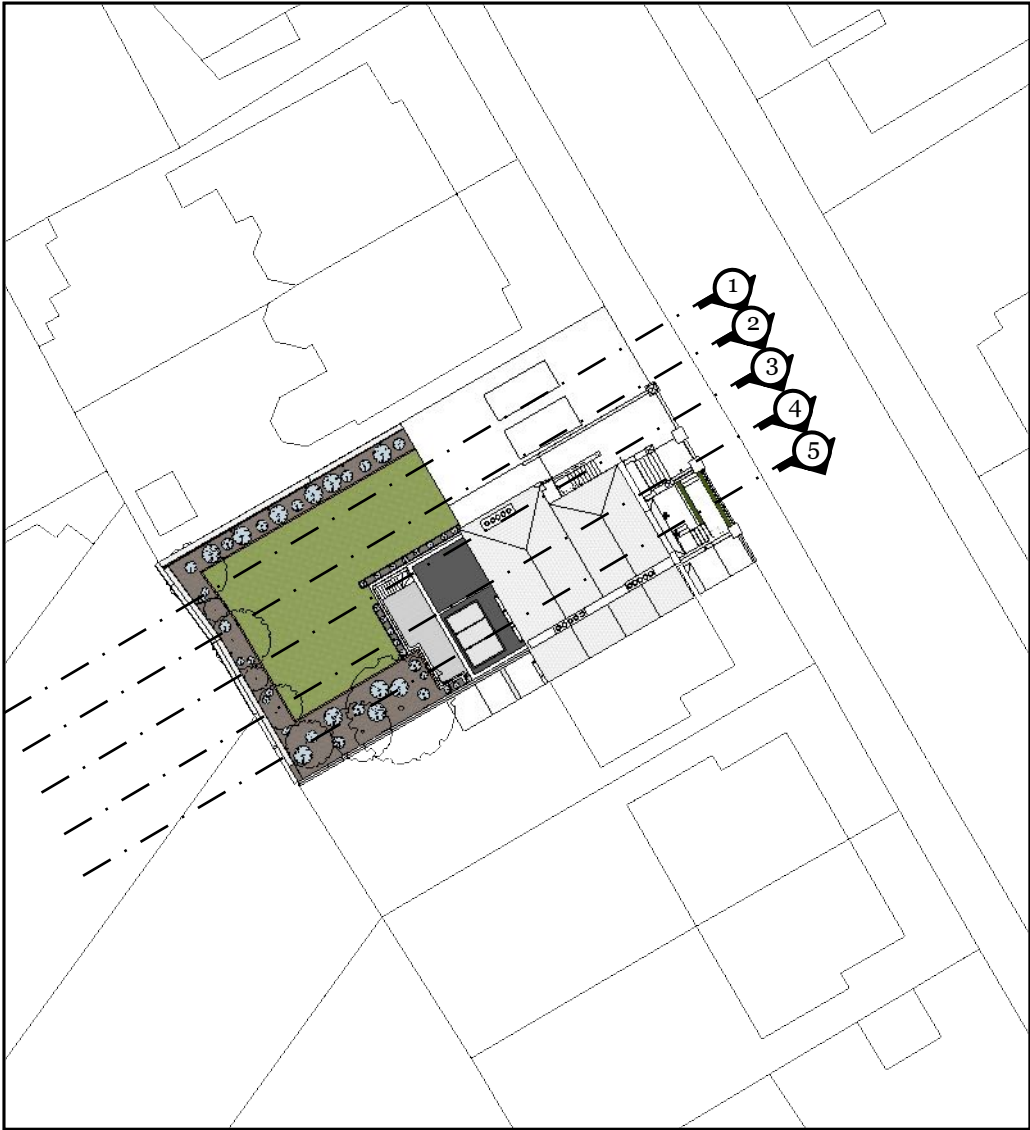

5m 10m
Scale 1 : 100 on A3



existing fence height rear boundary
new fence covering the retaining wall
existing retaining wall
1
new reinforced- concrete retaining wall as the existing wall was damaged and in poor condition

SITE ADDRESS
14 & 14A HAMPSTEAD HILL
GARDENS
HAMPSTEAD
LONDON
NW3 2PL

CLIENT
LONDON RESIDENTIAL HOUSING LTD
14 HAMPSTEAD HILL GARDENS
HAMPSTEAD
LONDON
NW3 2PL

PROJECT
LANDSCAPING HHG


ISSUE
09/11/2020

RE-ISSUE
17/07/2021

DESCRIPTION
Existing South boundary with
section cuts to show topography

A_{0.7}

As Built

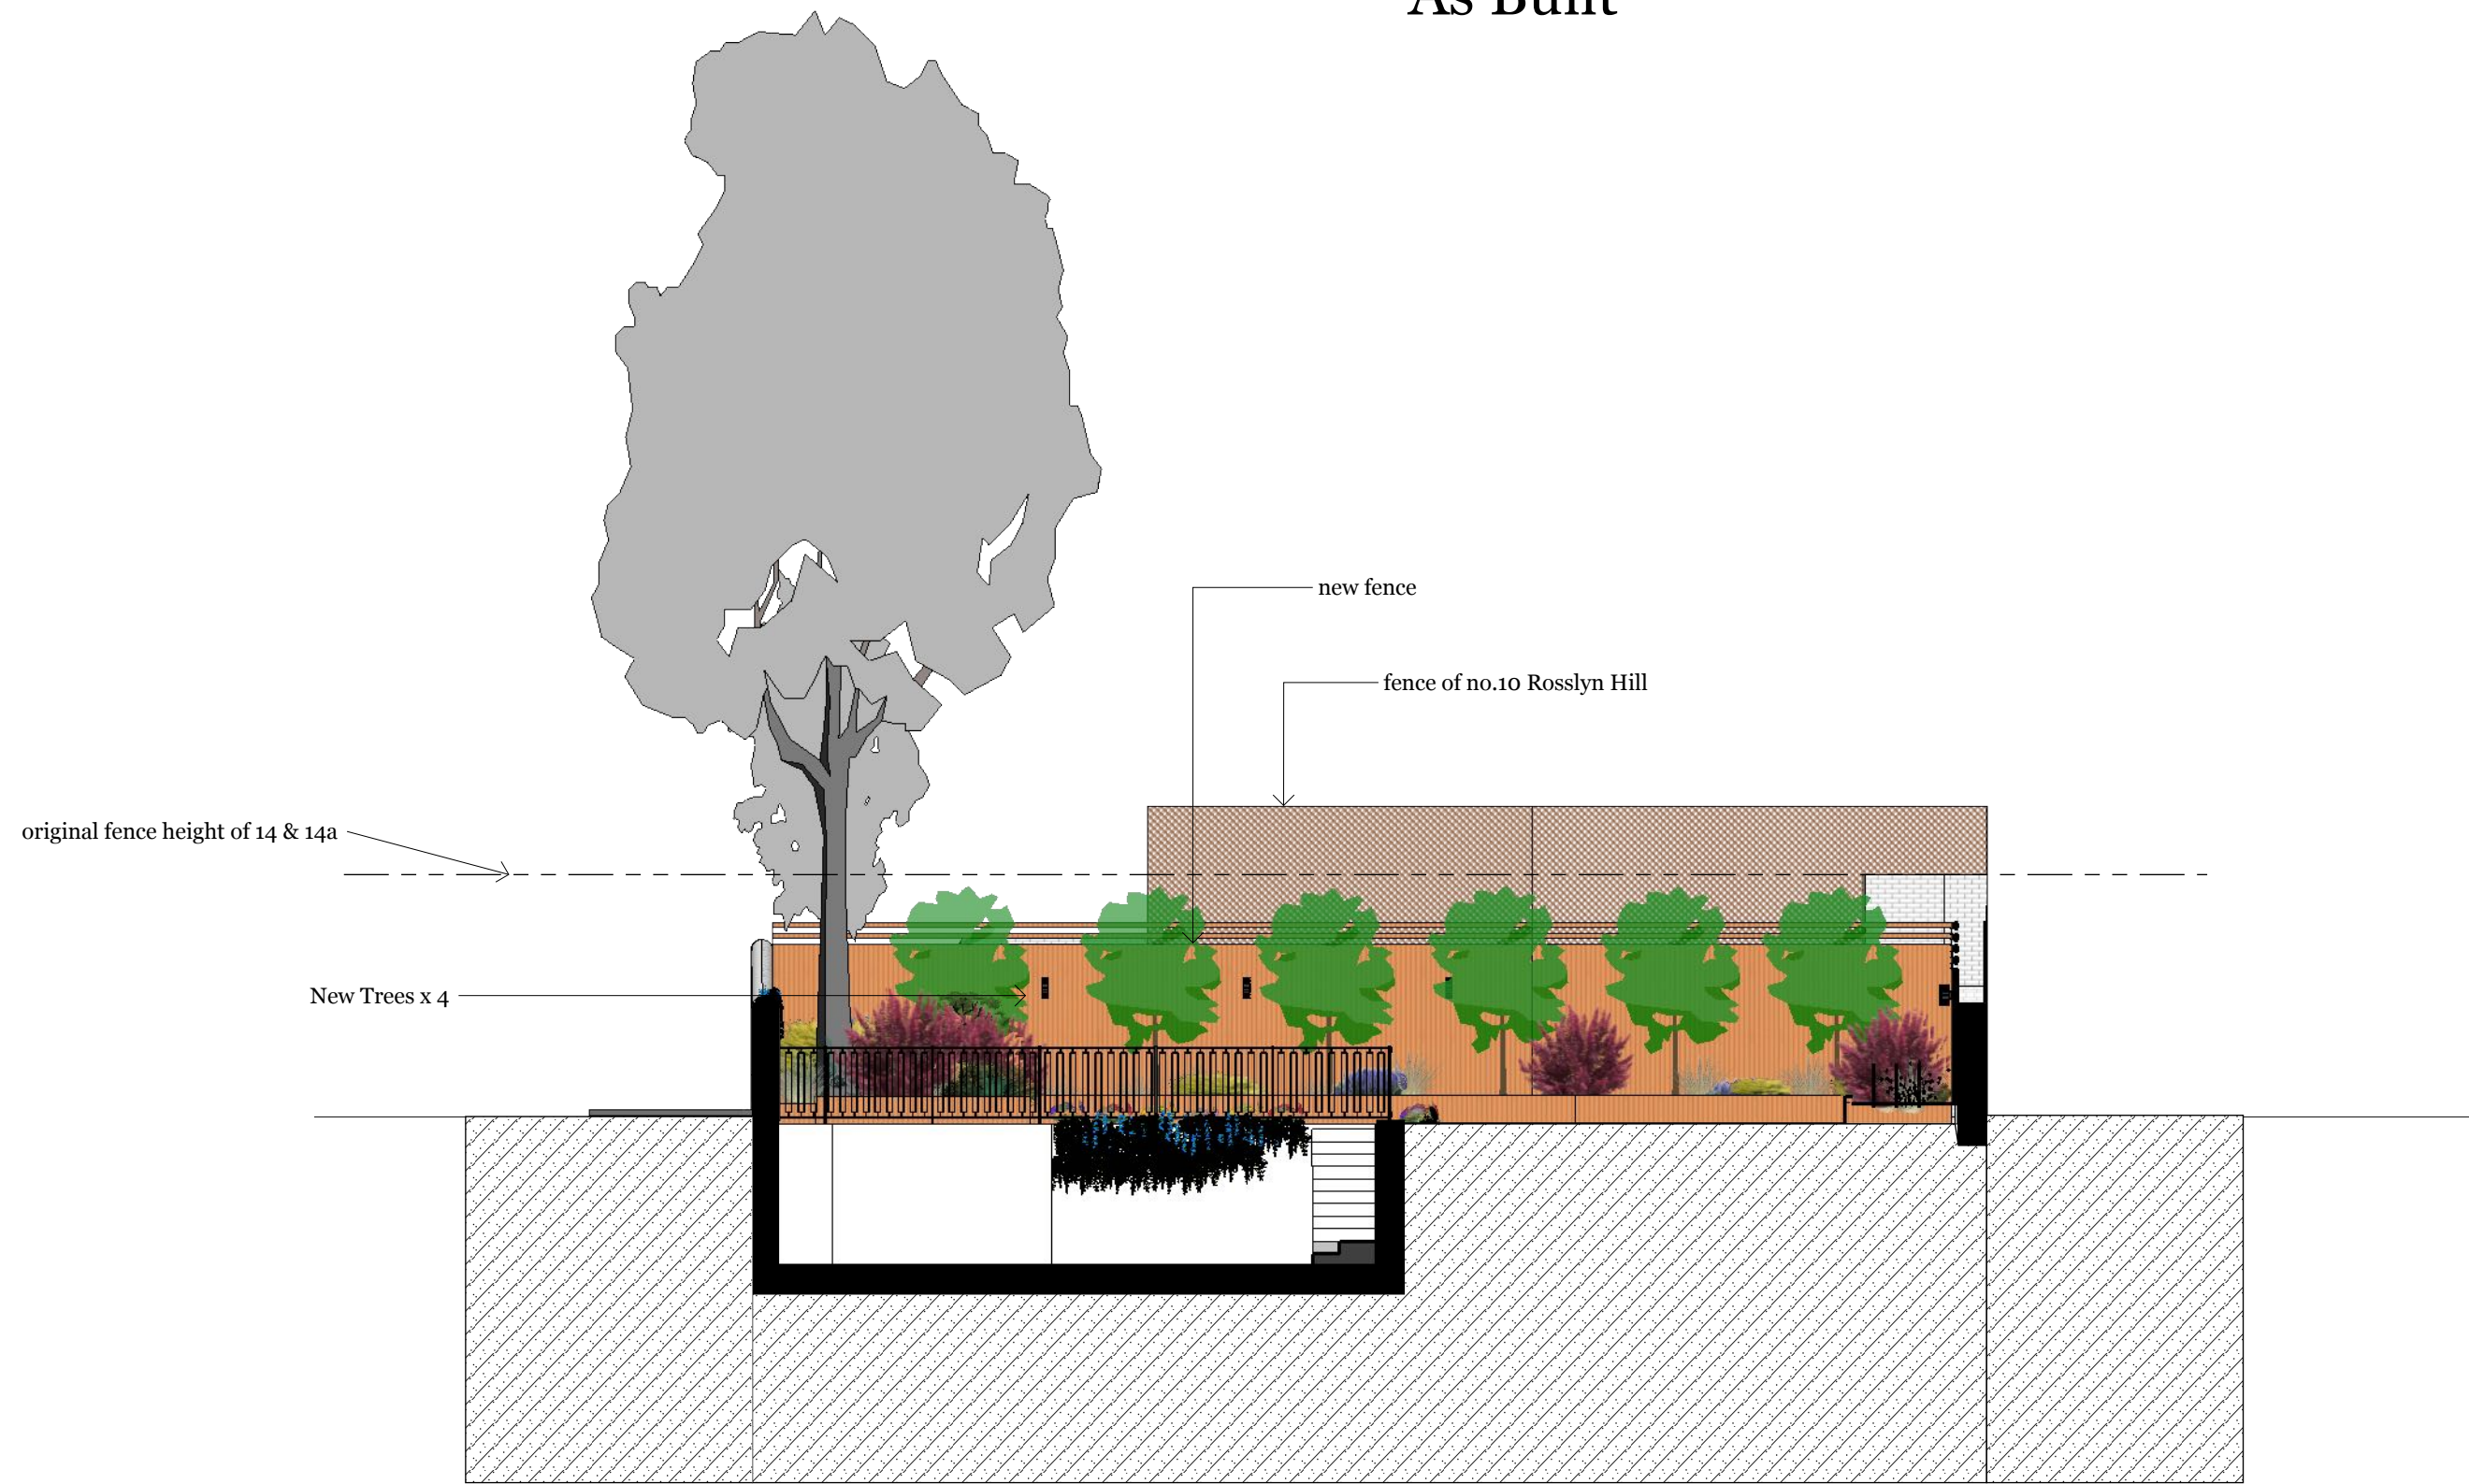

SITE ADDRESS
14 & 14A HAMPSTEAD HILL
GARDENS
HAMPSTEAD
LONDON
NW3 2PL


CLIENT
LONDON RESIDENTIAL HOUSING LTD
14 HAMPSTEAD HILL GARDENS
HAMPSTEAD
LONDON
NW3 2PL

PROJECT
LANDSCAPING HHG


ISSUE
09/11/2020

RE-ISSUE
17/07/2021

DESCRIPTION
As Built West boundary

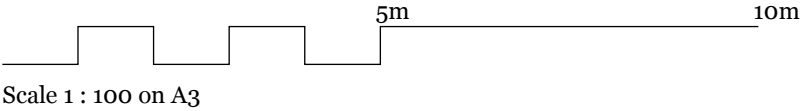

As Built

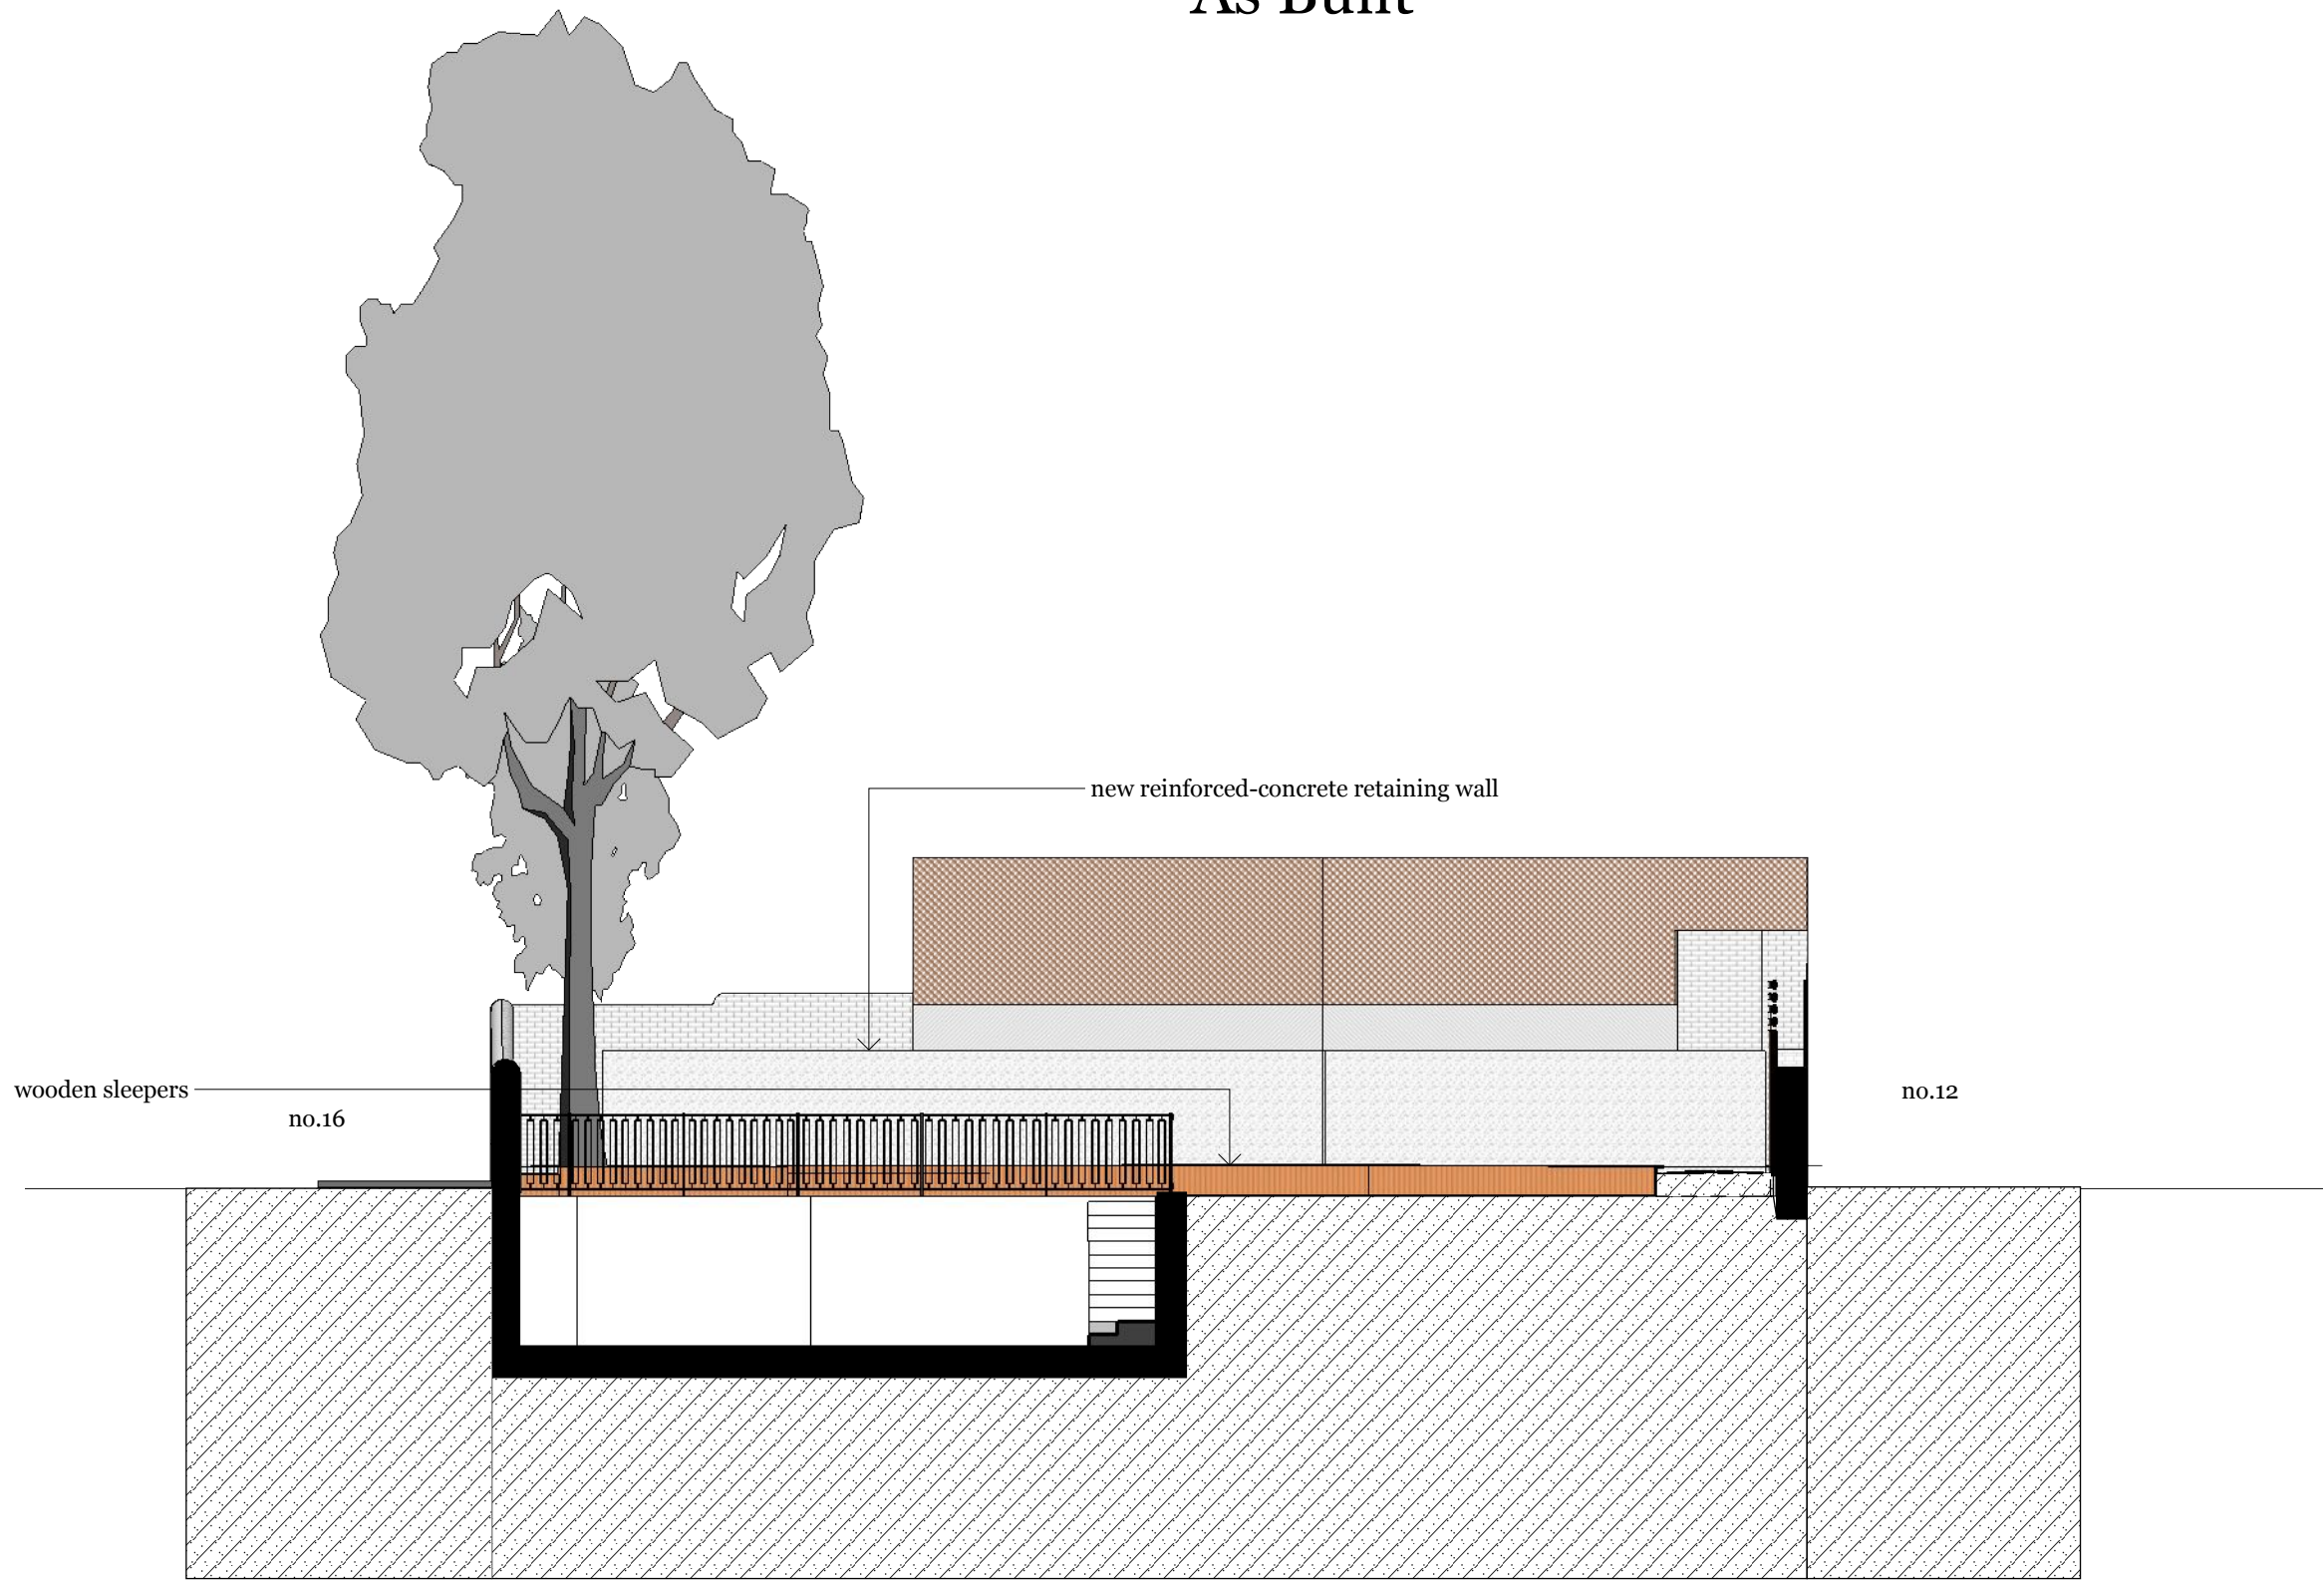

SITE ADDRESS
14 & 14A HAMPSTEAD HILL
GARDENS
HAMPSTEAD
LONDON
NW3 2PL

CLIENT
LONDON RESIDENTIAL HOUSING LTD
14 HAMPSTEAD HILL GARDENS
HAMPSTEAD
LONDON
NW3 2PL

PROJECT
LANDSCAPING HHG

ISSUE
09/11/2020

RE-ISSUE
17/07/2021

DESCRIPTION
As Built West boundary
(with reinforced-concrete retaining
wall)

Scale 1 : 100 on A3

A_{0.9}

As Built



SITE ADDRESS
14 & 14A HAMPSTEAD HILL
GARDENS
HAMPSTEAD
LONDON
NW3 2PL

CLIENT
LONDON RESIDENTIAL HOUSING LTD
14 HAMPSTEAD HILL GARDENS
HAMPSTEAD
LONDON
NW3 2PL

PROJECT
LANDSCAPING HHG


ISSUE
09/11/2020

RE-ISSUE
17/07/2021

DESCRIPTION
As Built East boundary

5m 10m
Scale 1 : 100 on A3

As Built

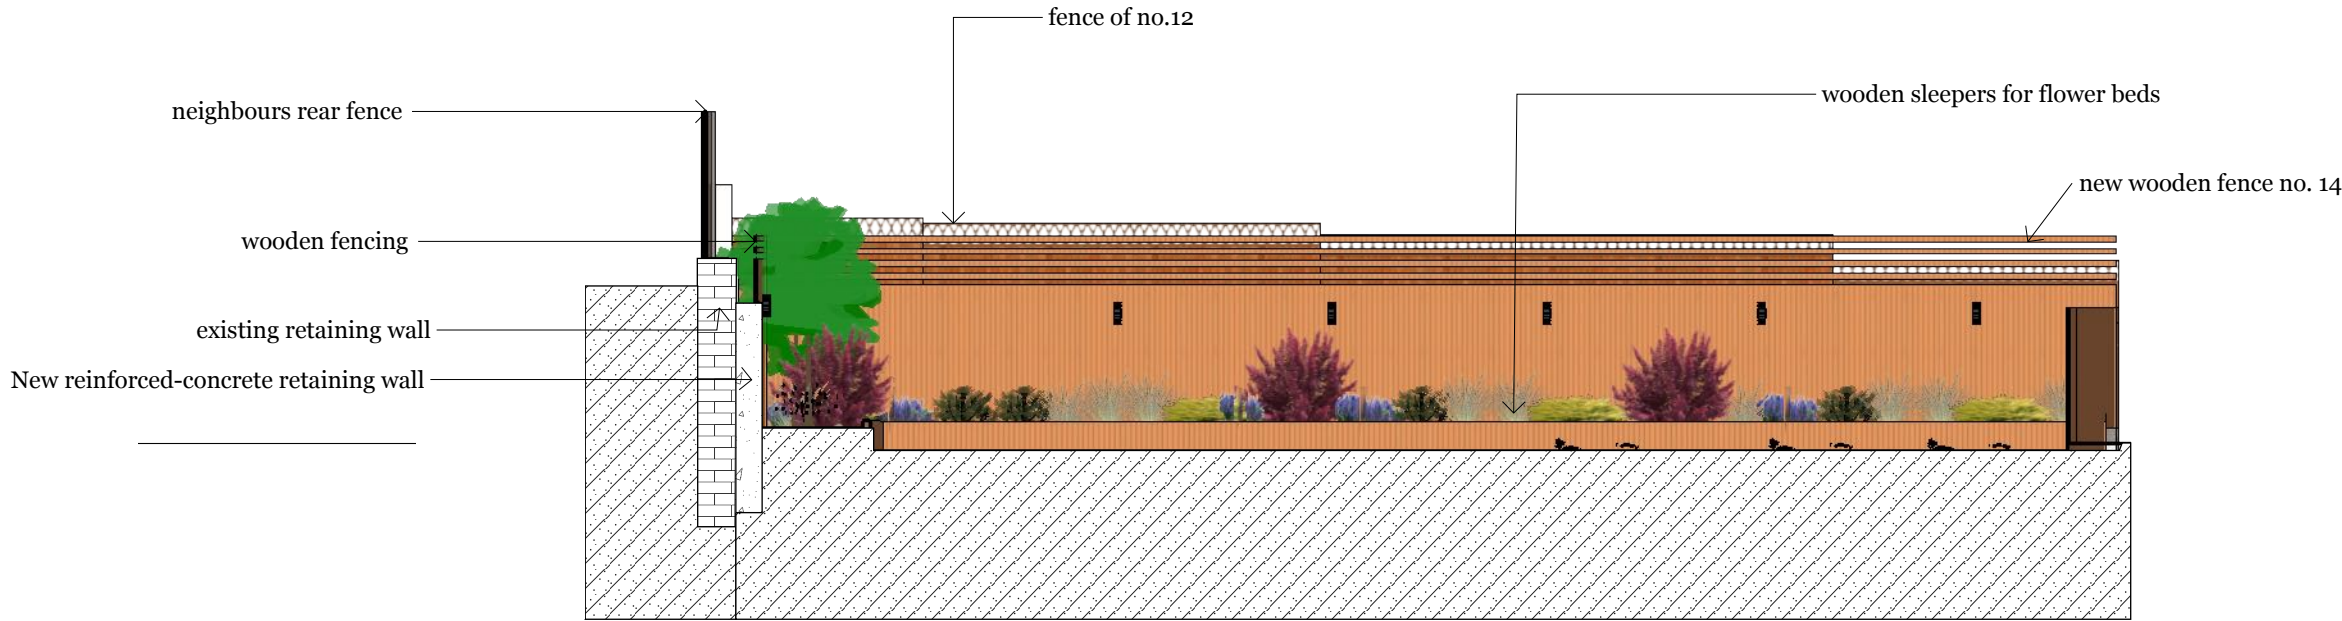

SITE ADDRESS
14 & 14A HAMPSTEAD HILL
GARDENS
HAMPSTEAD
LONDON
NW3 2PL

CLIENT
LONDON RESIDENTIAL HOUSING LTD
14 HAMPSTEAD HILL GARDENS
HAMPSTEAD
LONDON
NW3 2PL

PROJECT
LANDSCAPING HHG

ISSUE
09/11/2020

RE-ISSUE
17/07/2021

DESCRIPTION
As Built North Facing

5m 10m
Scale 1 : 100 on A3